



BUILDING CODE COMPLIANCE OFFICE
METRO-DADE FLAGLER BUILDING
140 WEST FLAGLER STREET, SUITE 1603
MIAMI, FLORIDA 33130-1563
(305) 375-2901 FAX (305) 375-2908

CONTRACTOR LICENSING SECTION
(305) 375-2527 FAX (305) 375-2558

CONTRACTOR ENFORCEMENT DIVISION
(305) 375-2966 FAX (305) 375-2908

PRODUCT CONTROL DIVISION
(305) 375-2902 FAX (305) 372-6339

PRODUCT CONTROL NOTICE OF ACCEPTANCE

Wayne Dalton Corporation
14512 Lincoln Way East
Dalton ,OH 44618

Your application for Notice of Acceptance (NOA) of:

Wayne Mark 8000 Garage Door

under Chapter 8 of the Code of Miami-Dade County governing the use of Alternate Materials and Types of Construction, and completely described herein, has been recommended for acceptance by the Miami-Dade County Building Code Compliance Office (BCCO) under the conditions specified herein.

This NOA shall not be valid after the expiration date stated below. BCCO reserves the right to secure this product or material at any time from a jobsite or manufacturer's plant for quality control testing. If this product or material fails to perform in the approved manner, BCCO may revoke, modify, or suspend the use of such product or material immediately. BCCO reserves the right to revoke this approval, if it is determined by BCCO that this product or material fails to meet the requirements of the South Florida Building Code.

The expense of such testing will be incurred by the manufacturer.

Raul Rodriguez
Chief Product Control Division

ACCEPTANCE NO.: 01-0813.03
EXPIRES: 12/13/2006

THIS IS THE COVERSHEET, SEE ADDITIONAL PAGES FOR SPECIFIC AND GENERAL
CONDITIONS
BUILDING CODE & PRODUCT REVIEW COMMITTEE

This application for Product Approval has been reviewed by the BCCO and approved by the Building Code and Product Review Committee to be used in Miami-Dade County, Florida under the conditions set forth above.

Francisco J. Quintana, R.A.
Director
Miami-Dade County
Building Code Compliance Office

APPROVED: 12/13/2001

NOTICE OF ACCEPTANCE: SPECIFIC CONDITIONS

1. SCOPE

- 1.1 This approves a Sectional Steel Door as described in Section 2 of this Notice of Acceptance. And it is designed to comply with the South Florida Building Code, 1994 Edition for Miami-Dade County (SFBC) for the locations where the pressure requirements, as determined by SFBC Chapter 23, do not exceed the design pressure rating values indicated in the approved drawings.

2. PRODUCT DESCRIPTION

- 2.1 The **Waynemark 8000 & 8100 raised panel door** and its components shall be constructed in strict compliance with the following documents: Drawing No. 0113, titled "Waynemark 8000 & 8100 Raised Panel Design Pressure: 37 psf." prepared by Wayne-Dalton Corporation, dated 06/28/2001 with latest revision on 10/18/01, Sheet 1 to 2 of 2. It bears the Miami-Dade County Product Control Approval stamp with the Notice of Acceptance number and approval date by Miami-Dade Product Control Division. These documents shall hereinafter be referred to as the approved drawings.

3. LIMITATIONS

- 3.1 Units with dimensions equal to or smaller than those shown on the approved drawings shall qualify under this approval, as long as all components are exactly as described in this approval.
- 3.2 This approval requires the manufacturer to do testing of all coils used to fabricate door panels under this Notice of Acceptance. A minimum of 2 specimens shall be cut from each coil and tensile tested according to ASTM E-8 by a Dade County Approved Laboratory selected and paid by the manufacturer. Every 3 months, 4 times a year the manufacturer shall mail to this office a copy of the Test Reports with confirmation that the specimens were selected from coils at the manufacturer's production facilities. And a notarized statement from the manufacturer that only coils with yield strength of 40,000 PSI or more shall be used to make door panels for Dade County under this Notice of Acceptance.

4. INSTALLATION

- 4.1 The Sectional Door and its components shall be constructed in strict compliance with the approved drawings.
- 4.2 The installation of this door **does not require** a Hurricane Protection System

5. LABELING

- 5.1 Each door shall bear a permanent label with the manufacturer's name or logo, city, state and the following statement: "Miami-Dade County Product Control Approved"

6. BUILDING PERMIT

- 6.1 Building Permit shall be accompanied by copies of the following:
- 6.1.1 This Notice of Acceptance, including two copies of the approved drawings as identified in Section 2.
- 6.1.2 Any other document required by the Building Official or the SFBC in order to properly evaluate the installation of this system.



Candido Font, PE, Sr. Product Control Examiner
Product Control Division

Wayne-Dalton Corporation.

ACCEPTANCE NO: 01-0813.03

APPROVED: DEC 13 2001

EXPIRES: DEC 13 2006


NOTICE OF ACCEPTANCE STANDARD CONDITIONS

1. Renewal of this Acceptance (approval) shall be considered after a renewal application has been filed and the original submitted documentation, including test-supporting data, engineering documents, are no older than eight (8) years.
2. Any and all approved products shall be permanently labeled with the manufacturer's name, city, state, and the following statement: "Miami-Dade County Product Control Approved", or as specifically stated in the specific conditions of this Acceptance.
3. Renewals of Acceptance will not be considered if:
 - a) There has been a change in the South Florida Building Code affecting the evaluation of this product and the product is not in compliance with the code changes;
 - b) The product is no longer the same product (identical) as the one originally approved;
 - c) If the Acceptance holder has not complied with all the requirements of this acceptance, including the correct installation of the product;
 - d) The engineer who originally prepared, signed and sealed the required documentation initially submitted is no longer practicing the engineering profession.
4. Any revision or change in the materials, use, and/or manufacture of the product or process shall automatically be cause for termination of this Acceptance, unless prior written approval has been requested (through the filing of a revision application with appropriate fee) and granted by this office.
5. Any of the following shall also be grounds for removal of this Acceptance:
 - a) Unsatisfactory performance of this product or process.
 - b) Misuse of this Acceptance as an endorsement of any product, for sales, advertising or any other purpose.
6. The Notice of Acceptance number preceded by the words Miami-Dade County, Florida, and followed by the expiration date may be displayed in advertising literature. If any portion of the Notice of Acceptance is displayed, then it shall be done in its entirety.
7. A copy of this Acceptance as well as approved drawings and other documents, where it applies, shall be provided to the user by the manufacturer or its distributors and shall be available for inspection at the job site at all time. The engineer need not reseal the copies.
8. Failure to comply with any section of this Acceptance shall be cause for termination and removal of Acceptance.
9. This Notice of Acceptance consists of pages 1, 2 and this last page 3.



Candido Font, PE, Sr. Product Control Examiner
Product Control Division

END OF THIS ACCEPTANCE

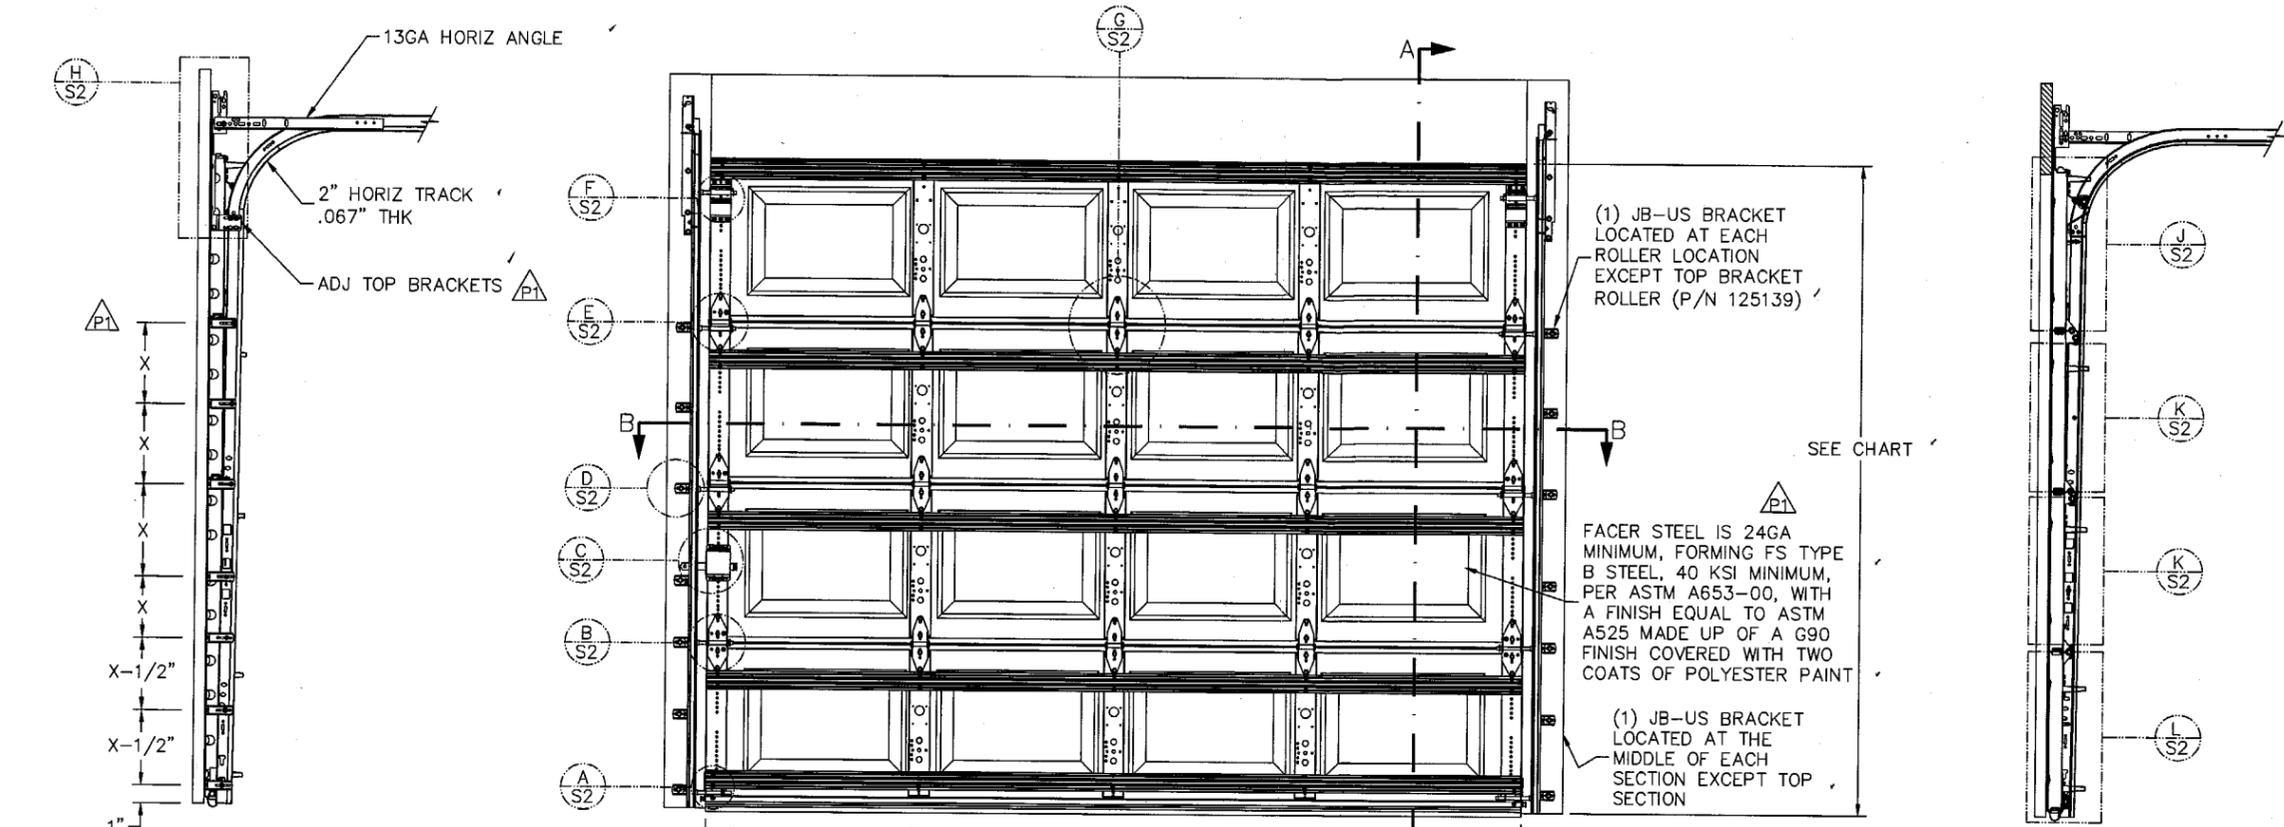

X = SECTION HEIGHT / 2

VINYL OR WOOD DOOR STOP (NAILED ON 6\"/>


(1) JB-US BRACKET LOCATED AT EACH ROLLER LOCATION EXCEPT TOP BRACKET ROLLER (P/N 125139)

SEE CHART

FACER STEEL IS 24GA MINIMUM, FORMING FS TYPE B STEEL, 40 KSI MINIMUM, PER ASTM A653-00, WITH A FINISH EQUAL TO ASTM A525 MADE UP OF A G90 FINISH COVERED WITH TWO COATS OF POLYESTER PAINT

(1) JB-US BRACKET LOCATED AT THE MIDDLE OF EACH SECTION EXCEPT TOP SECTION

SECTION A-A

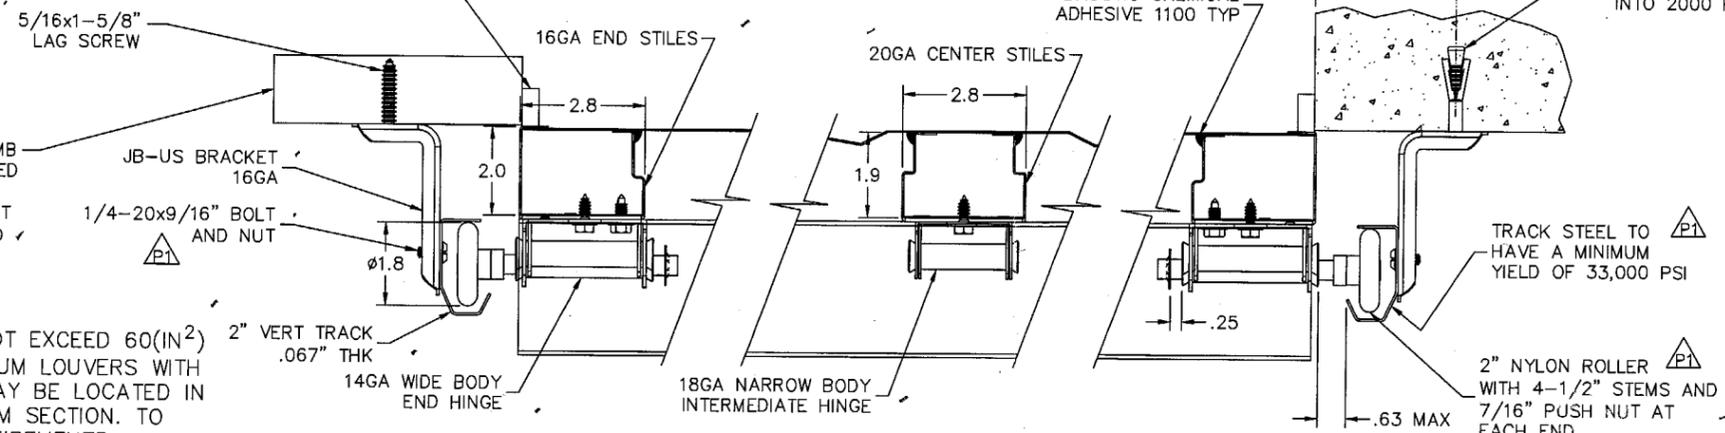

SECTION B-B

NOTE: TOTAL AREA OF LOUVERS CANNOT EXCEED 60(IN²) OPTIONAL - .080\"/>

DOOR HEIGHT	U-BARS	SECTION HEIGHTS								JB-US BRACKETS
		BOTTOM	#2	#3	#4	#5	#6	#7	TOP	
6'-6"	5	21"	18"	18"					21"	7
7'-0"	5	21"	21"	21"					21"	7
7'-6"	7	18"	18"	18"	18"				18"	9
8'-0"	7	21"	18"	18"	18"				21"	9
9'-0"	8	18"	18"	18"	18"	18"			18"	11
10'-0"	8	21"	21"	21"	18"	18"			21"	11
11'-0"	9	21"	18"	18"	18"	18"	18"		21"	13
12'-0"	9	21"	21"	21"	21"	21"	21"		18"	13
13'-0"	10	21"	21"	21"	18"	18"	18"	18"	21"	15
14'-0"	10	21"	21"	21"	21"	21"	21"	21"	21"	15














Approved: *[Signature]*
 W.S. Wilson, P.E.
 3395 ADDISON DR., PENSACOLA, FL 32514
 FLORIDA CERTIFICATION NO. 0048489
 GEORGIA CERTIFICATION NO. 018519
 NORTH CAROLINA CERTIFICATION NO. 023838
 Date: 11-7-01

DADE COUNTY USE ONLY

APPROVED AS COMPLYING WITH THE SOUTH FLORIDA BUILDING CODE
 DATE DEC 13 2001
 BY *[Signature]*
 PRODUCT CONTROL DIVISION
 BUILDING CODE COMPLIANCE OFFICE
 ACCEPTANCE NO. 01-0813.03

PART NO. 294823
 R & D RELEASE TO PRODUCT DATE ENGINEERING
 BY:
 CHANGES
 P1 REV NOTES AND DESCR PER DADE CNTY MARK UPS. 10/18/01 DCC

	3395 ADDISON DRIVE PENSACOLA, FLORIDA 32514 (850) 474-9890		DATE 6/28/2001	NAME K. HART	SHEET 1 OF 2
	DRAWN	CHECKED	APPR.	PROJECT WINDLOAD\WMK8000	
	WAYNEMARK 8000 & 8100 RAISED PANEL				
DESIGN PRESSURE: ±37 PSF				SIZE C	REV P1

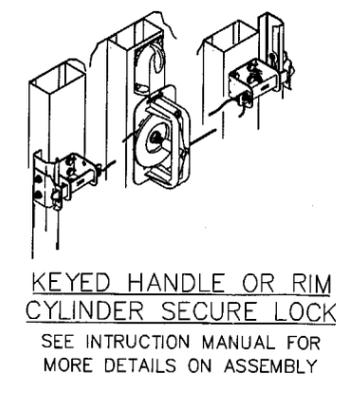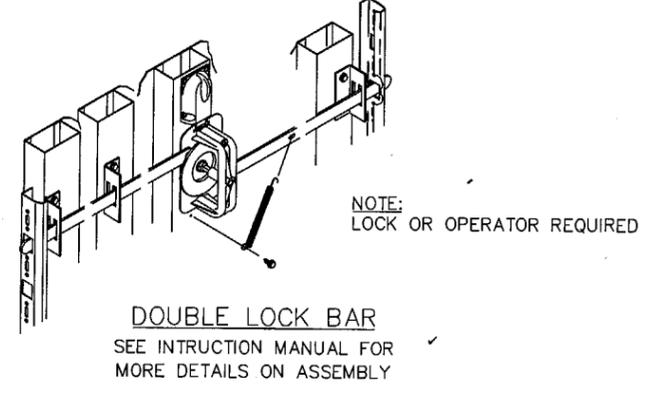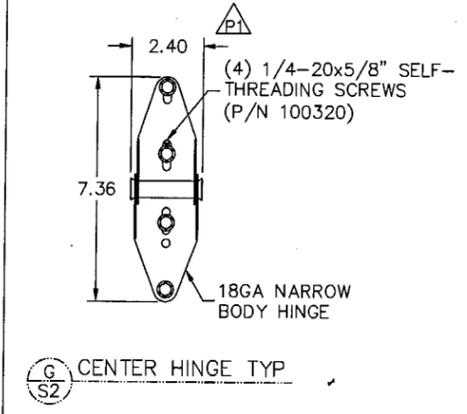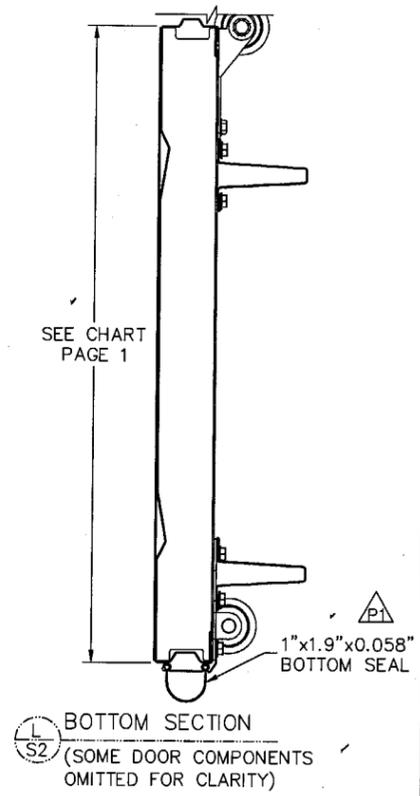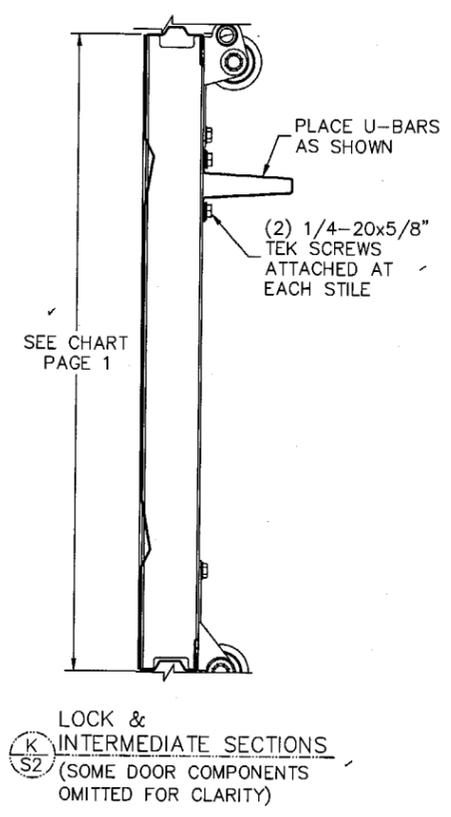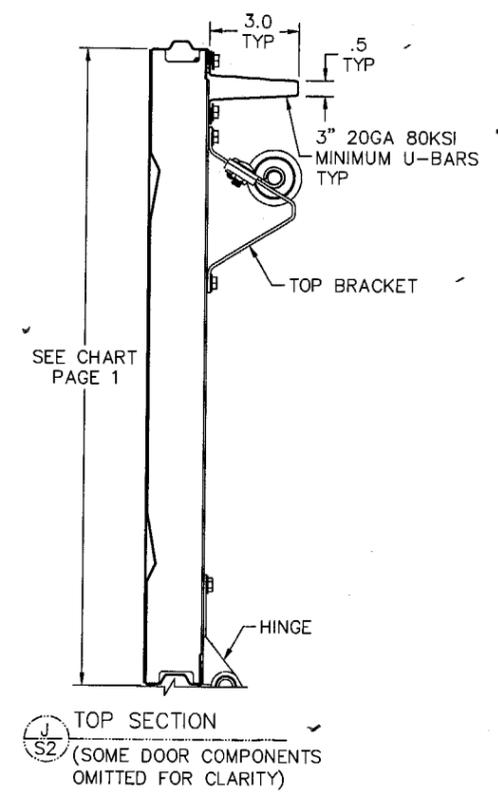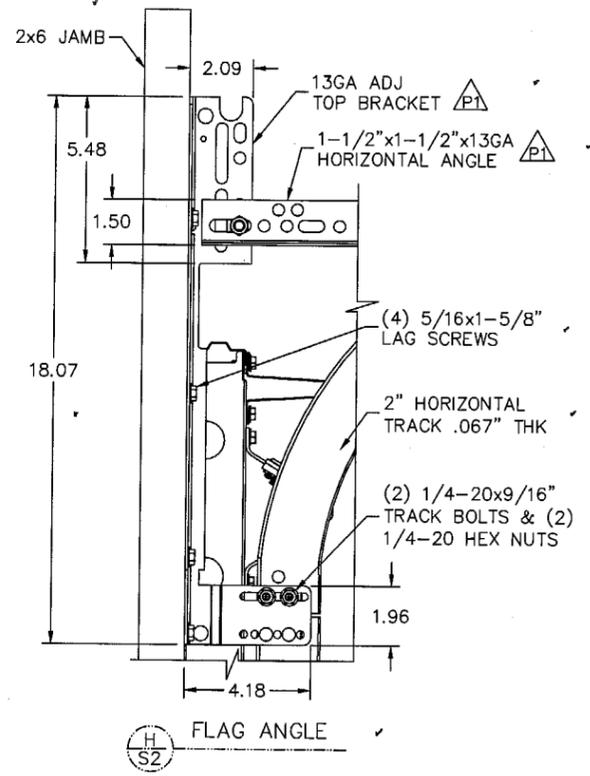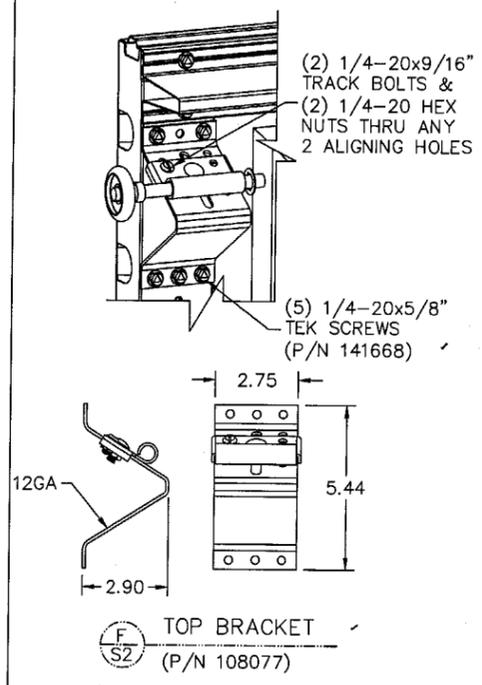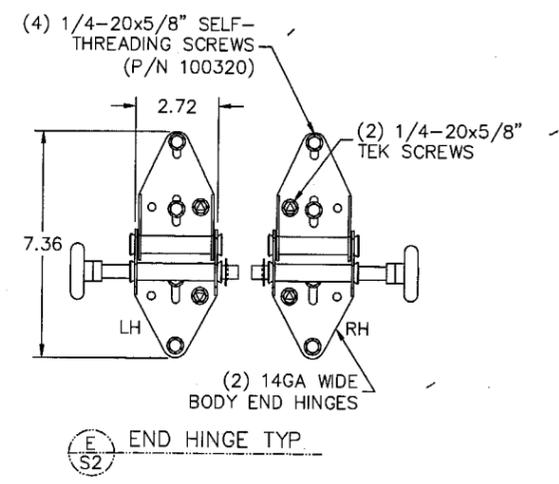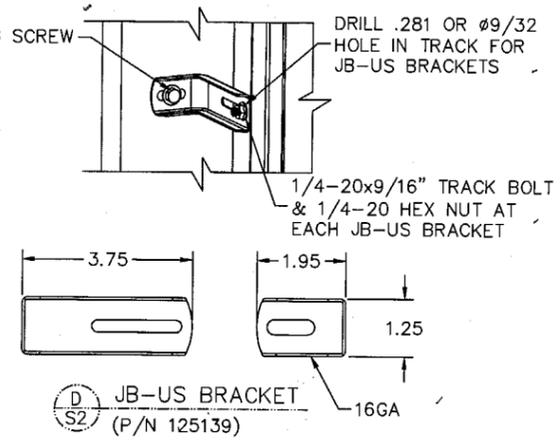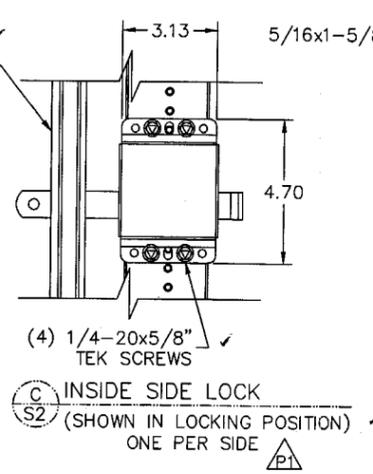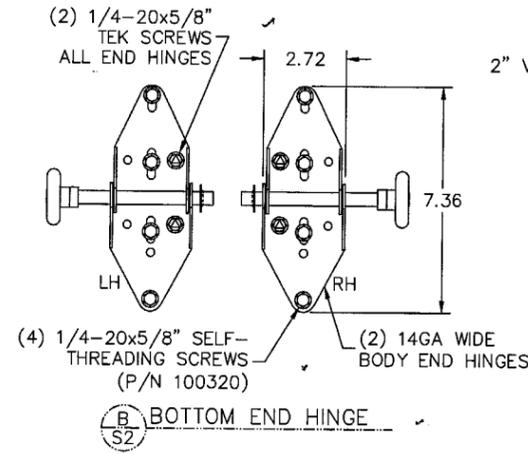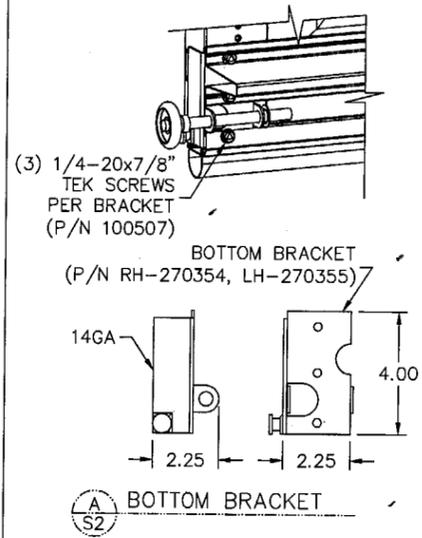

PART NO.	294823
R & D RELEASE TO PRODUCT ENGINEERING	DATE
BY:	
(P) CHANGES	
P1 REV NOTES AND DESCR PER DADE CNTY MARK UPS.	
10/18/01 DCC	

Approved: *[Signature]*
 W.S. Wilson, P.E.
 3395 ADDISON DR., PENSACOLA, FL 32514
 FLORIDA CERTIFICATION NO. 0048489
 GEORGIA CERTIFICATION NO. 018519
 NORTH CAROLINA CERTIFICATION NO. 023836
 Date: 11-7-01

DADE COUNTY USE ONLY

APPROVED AS COMPLYING WITH THE SOUTH FLORIDA BUILDING CODE
 DATE DEC 13 2001
 BY *[Signature]*
 PRODUCT CONTROL DIVISION
 BUILDING CODE COMPLIANCE OFFICE
 ACCEPTANCE NO. 01-0813.03

Wayne Dalton	3395 ADDISON DRIVE PENSACOLA, FLORIDA 32514 (850) 474-9890	DATE	NAME	SHEET 2 of 2	
		DRAWN	6/28/2001		K. HART
		CHECKED			
WAYNE MARK 8000 & 8100 RAISED PANEL				PROJECT	
DESIGN PRESSURE: ±37 PSF				WINDLOAD\WMK8000	
SIZE	C	OPTION CODE	REV		
		0113	P1		