



**BUILDING CODE COMPLIANCE OFFICE (BCCO)  
PRODUCT CONTROL DIVISION**

**MIAMI-DADE COUNTY, FLORIDA  
METRO-DADE FLAGLER BUILDING  
140 WEST FLAGLER STREET, SUITE 1603  
MIAMI, FLORIDA 33130-1563  
(305) 375-2901 FAX (305) 375-2908**

**NOTICE OF ACCEPTANCE (NOA)**

**Moulding Associates Incorporated  
933 Hensley Lane  
Wylie, TX 75098**

**SCOPE:**

This NOA is being issued under the applicable rules and regulations governing the use of construction materials. The documentation submitted has been reviewed by Miami-Dade County Product Control Division and accepted by the Board of Rules and Appeals (BORA) to be used in Miami Dade County and other areas where allowed by the Authority Having Jurisdiction (AHJ).

This NOA shall not be valid after the expiration date stated below. The Miami-Dade County Product Control Division (In Miami Dade County) and/or the AHJ (in areas other than Miami Dade County) reserve the right to have this product or material tested for quality assurance purposes. If this product or material fails to perform in the accepted manner, the manufacturer will incur the expense of such testing and the AHJ may immediately revoke, modify, or suspend the use of such product or material within their jurisdiction. BORA reserves the right to revoke this acceptance, if it is determined by Miami-Dade County Product Control Division that this product or material fails to meet the requirements of the applicable building code.

This product is approved as described herein, and has been designed to comply with the High Velocity Hurricane Zone of the Florida Building Code.

**DESCRIPTION: Series "Elan, St. Charles or Delta" Glazed Inswing Wood Door w/ & w/out Sidelites**

**APPROVAL DOCUMENT:** Drawing No. S-2247, titled "Stile & Rail 6'8 or 8'0 Opaque Wood Door In-Swing Unit", sheets 1 through 10 of 10, prepared by R.W. Building Consultants, Inc., Inc., dated 5/16/02, with revision "LRL" dated 01/27/03, bearing the Miami-Dade County Product Control Approval stamp with the Notice of Acceptance number and approval date by the Miami-Dade County Product Control Division.

**MISSILE IMPACT RATING: None**

**LABELING:** Each unit shall bear a permanent label with the manufacturer's name or logo, city, state and following statement: "Miami-Dade County Product Control Approved", unless otherwise noted herein.

**RENEWAL** of this NOA shall be considered after a renewal application has been filed and there has been no change in the applicable building code negatively affecting the performance of this product.

**TERMINATION** of this NOA will occur after the expiration date or if there has been a revision or change in the materials, use, and/or manufacture of the product or process. Misuse of this NOA as an endorsement of any product, for sales, advertising or any other purposes shall automatically terminate this NOA. Failure to comply with any section of this NOA shall be cause for termination and removal of NOA.

**ADVERTISEMENT:** The NOA number preceded by the words Miami-Dade County, Florida, and followed by the expiration date may be displayed in advertising literature. If any portion of the NOA is displayed, then it shall be done in its entirety.

**INSPECTION:** A copy of this entire NOA shall be provided to the user by the manufacturer or its distributors and shall be available for inspection at the job site at the request of the Building Official.

This NOA consists of this page 1 as well as approval document mentioned above.

The submitted documentation was reviewed by **Theodore Berman, P.E.**



**NOA No 02-0927.04  
Expiration Date: March 06, 2008  
Approval Date: March 06, 2003  
Page 1**

**Moulding Associates Incorporated**

**NOTICE OF ACCEPTANCE: EVIDENCE SUBMITTED**

(For File ONLY. Not part of NOA)

**A. DRAWINGS**

1. Manufacturer's die drawings and sections.
2. Drawing No. **S-2247**, titled "Stile & Rail 6'8 or 8'0 Opaque Wood Door In-Swing Unit", sheets 1 through 10 of 10, prepared by R.W. Building Consultants, Inc., Inc., dated 5/16/02.

**B. TESTS**

1. Test reports on 1) Air Infiltration Test, per FBC, TAS 202-94  
2) Uniform Static Air Pressure Test, Loading per FBC, TAS 202-94  
3) Water Resistance Test, per FBC, TAS 202-94  
4) Forced Entry Test, per FBC 2411 3.2.1 and TAS 202-94  
along with marked-up drawings and installation diagram of an inswing wood door, prepared by Hurricane Test Laboratory, Inc., Test Report No. **CCL1-0112**, dated 3/29/02, signed and sealed by Abdoul Rezadad, P.E.

**C. CALCULATIONS**

1. Anchor Calculations and structural analysis, prepared by Lyndon Schmidt, P.E., dated 5/3/02, signed and sealed by Lyndon Schmidt, P.E.

**D. MATERIAL CERTIFICATIONS**


1. None

**E. STATEMENTS**

1. Statement letter of no financial interest, dated 3/28/02, signed by Jeff Cade.

**F. OTHER**


1. Letter from the consultant stating that the product is in compliance with the Florida Building Code (FBC).

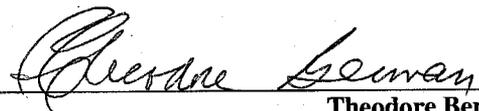


**Theodore Berman, P.E.**  
**Deputy Director, Product Control Division**  
**NOA No 02-0927.04**  
**Expiration Date: March 06, 2008**  
**Approval Date: March 06, 2003**

**MOULDING ASSOCIATES**  
**"ELAN, ST. CHARLES OR DELTA SERIES"**  
 STILE & RAIL OPAQUE WOOD DOOR  
 UP TO 8'4" x 8'0" INSWING WITH & WITHOUT SIDELITES






- GENERAL NOTES**
1. THIS PRODUCT IS DESIGNED TO COMPLY WITH THE FLORIDA BUILDING CODE.
  2. WOOD BUCKS BY OTHERS, MUST BE ANCHORED PROPERLY TO TRANSFER LOADS TO THE STRUCTURE.
  3. PRODUCT ANCHORS SHALL BE AS LISTED AND SPACED AS SHOWN ON DETAILS. ANCHOR EMBEDMENT TO BASE MATERIAL SHALL BE BEYOND WALL DRESSING OR STUCCO.
  4. DESIGNED PRESSURE RATING SEE TABLE PAGE 1.
  5. THIS PRODUCT DOES NOT MEET THE WATER REQUIREMENTS FOR "HIGH VELOCITY HURRICANE ZONES".
  6. THIS SYSTEM REQUIRES WINDBORNE DEBRIS EXTERNAL PROTECTION AS PRESCRIBED IN SECTION 2413 OF THE FLORIDA BUILDING CODE.

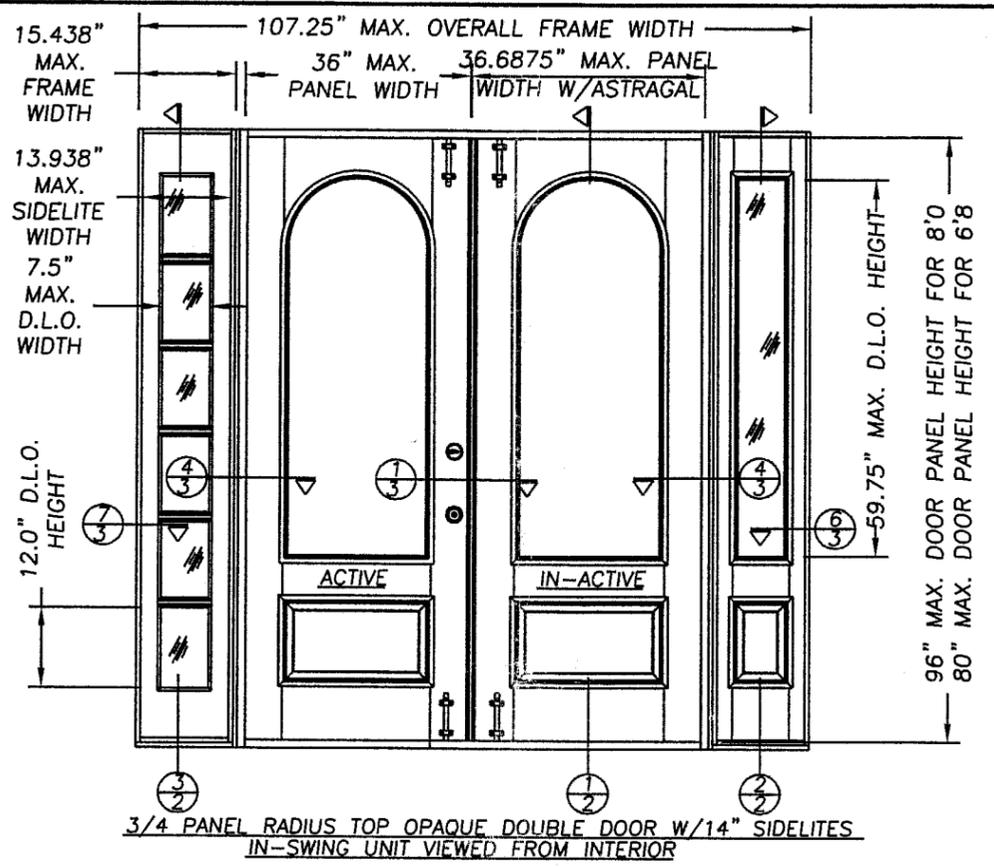

3/4 PANEL RADIUS TOP OPAQUE DOUBLE DOOR W/1/4" SIDELITES  
 IN-SWING UNIT VIEWED FROM INTERIOR

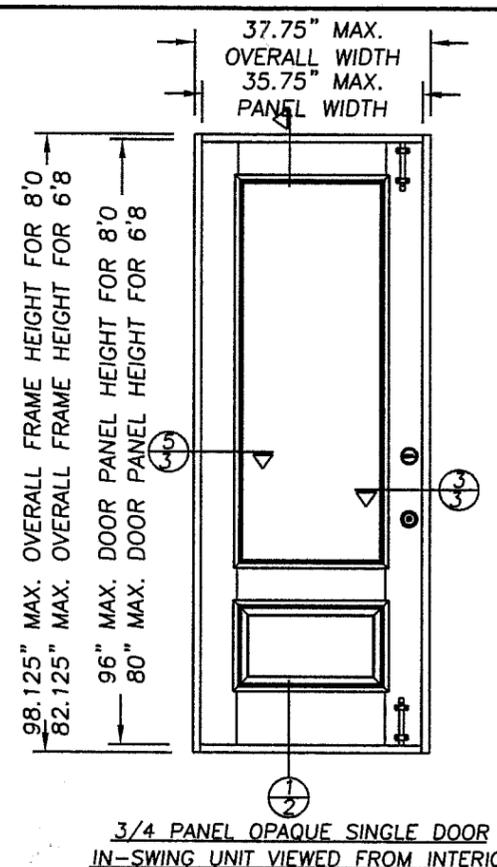

3/4 PANEL OPAQUE SINGLE DOOR  
 IN-SWING UNIT VIEWED FROM INTERIOR

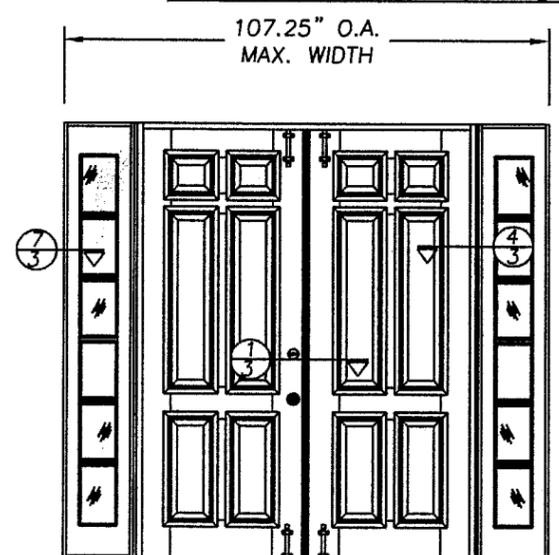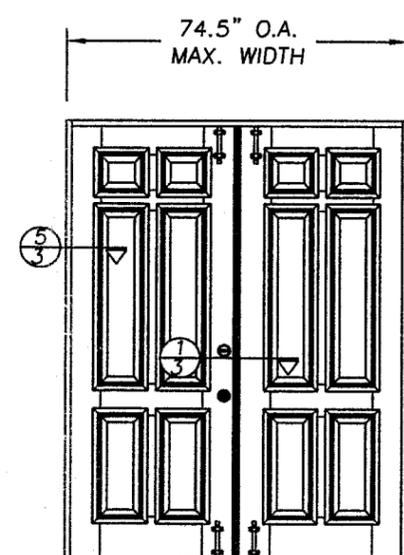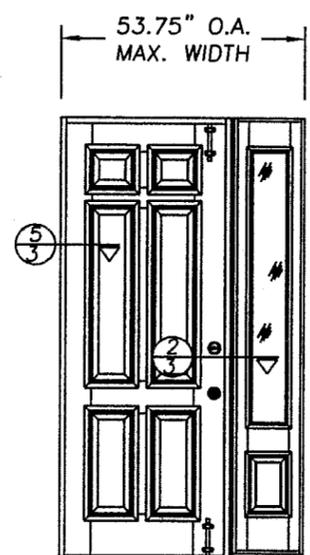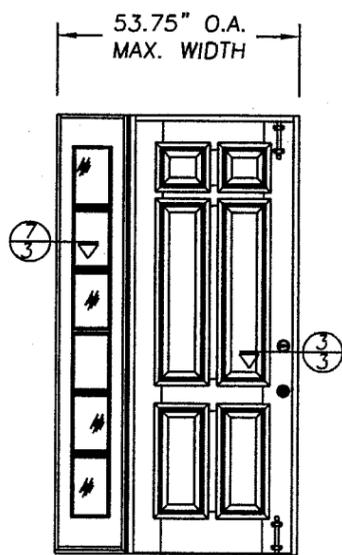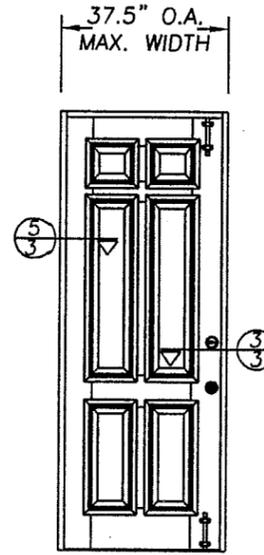

X

O X

X O

X X

O X X O

SHEET #	DESCRIPTION
1	TYPICAL ELEVATIONS & GENERAL NOTES
2	VERTICAL CROSS SECTIONS
3	HORIZONTAL CROSS SECTIONS
4	ANCHORING LOCATIONS & DETAILS
5	ANCHORING LOCATIONS & DETAILS
6	3/4 PANEL DOOR STILE & RAIL DETAIL
7	3/4 PANEL RADIUS TOP DOOR STILE & RAIL DETAIL
8	6 PANEL DOOR STILE & RAIL DETAIL
9	SIDELITE STILE & RAIL DETAIL
10	BILL OF MATERIALS, UNIT COMPONENTS & GLAZING DETAILS

DESIGN PRESSURE RATING (WHERE WATER INFILTRATION REQUIREMENT IS NOT NEEDED)

UNIT TYPE	WITH SURFACE BOLTS ON INACTIVE PANEL ONLY	WITH SURFACE BOLTS ON INACTIVE & ACTIVE PANEL
SINGLE	/	+ 67.0 PSF - 67.0 PSF
DOUBLE	+ 47.0 PSF - 47.0 PSF	+ 67.0 PSF - 67.0 PSF
SINGLE & DOUBLE WITH SIDELITES	+ 47.0 PSF - 47.0 PSF	+ 67.0 PSF - 67.0 PSF

**MOULDING ASSOCIATES INCORPORATED**  
 933 HENSLEY LANE  
 WYLIE, TX 75098  
 PHONE: 800.394.6680


PRODUCT: STILE & RAIL 6'8" OR 8'0" OPAQUE WOOD DOOR IN-SWING UNIT  
 PART OR ASSEMBLY:  
 TYPICAL ELEVATIONS & GENERAL NOTES

NO.	DATE	ADD ANCHORS	LRL	BY
1	01/27/03			


**RW BUILDING CONSULTANTS, INC.**  
 813.684.3831

Approved as complying with the Florida Building Code  
 Date 03/06/03  
 NOA# 03-042304  
 Miami State Product Control  
 By: *Maedne Berman*


DATE: 5/19/02  
 SCALE: N.T.S.  
 DWG. BY: WLN  
 CHK. BY: RW  
 DRAWING NO.: S-2247  
 SHEET 1 OF 10

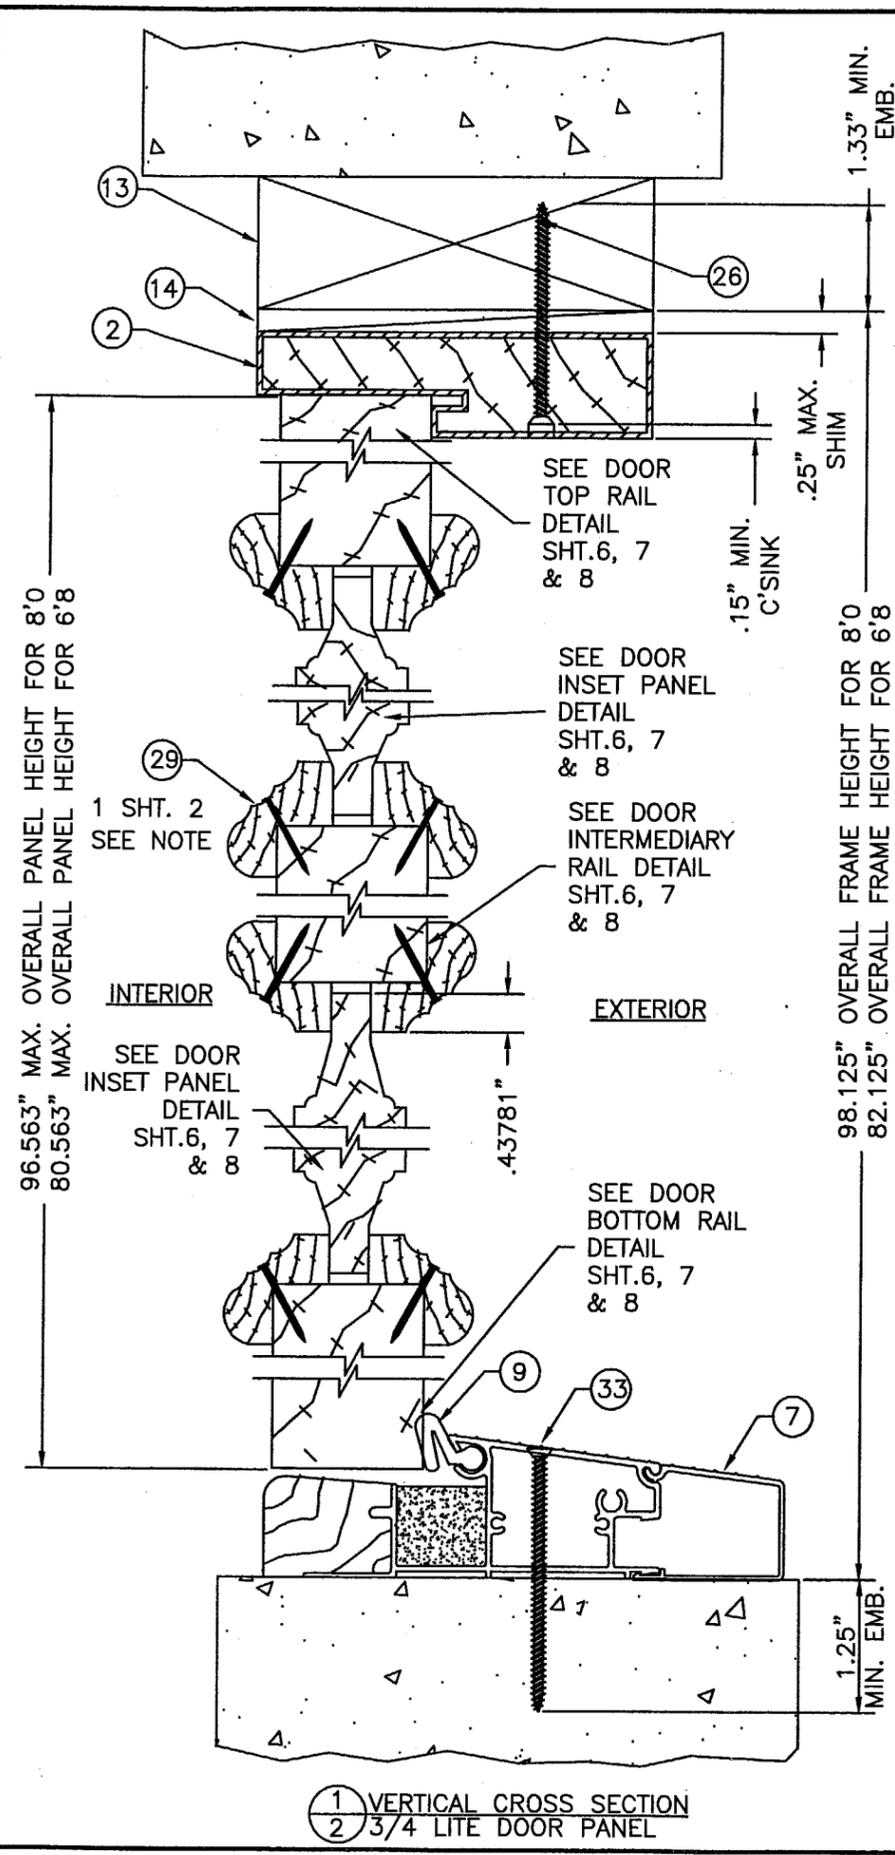

1 VERTICAL CROSS SECTION  
2 3/4 LITE DOOR PANEL

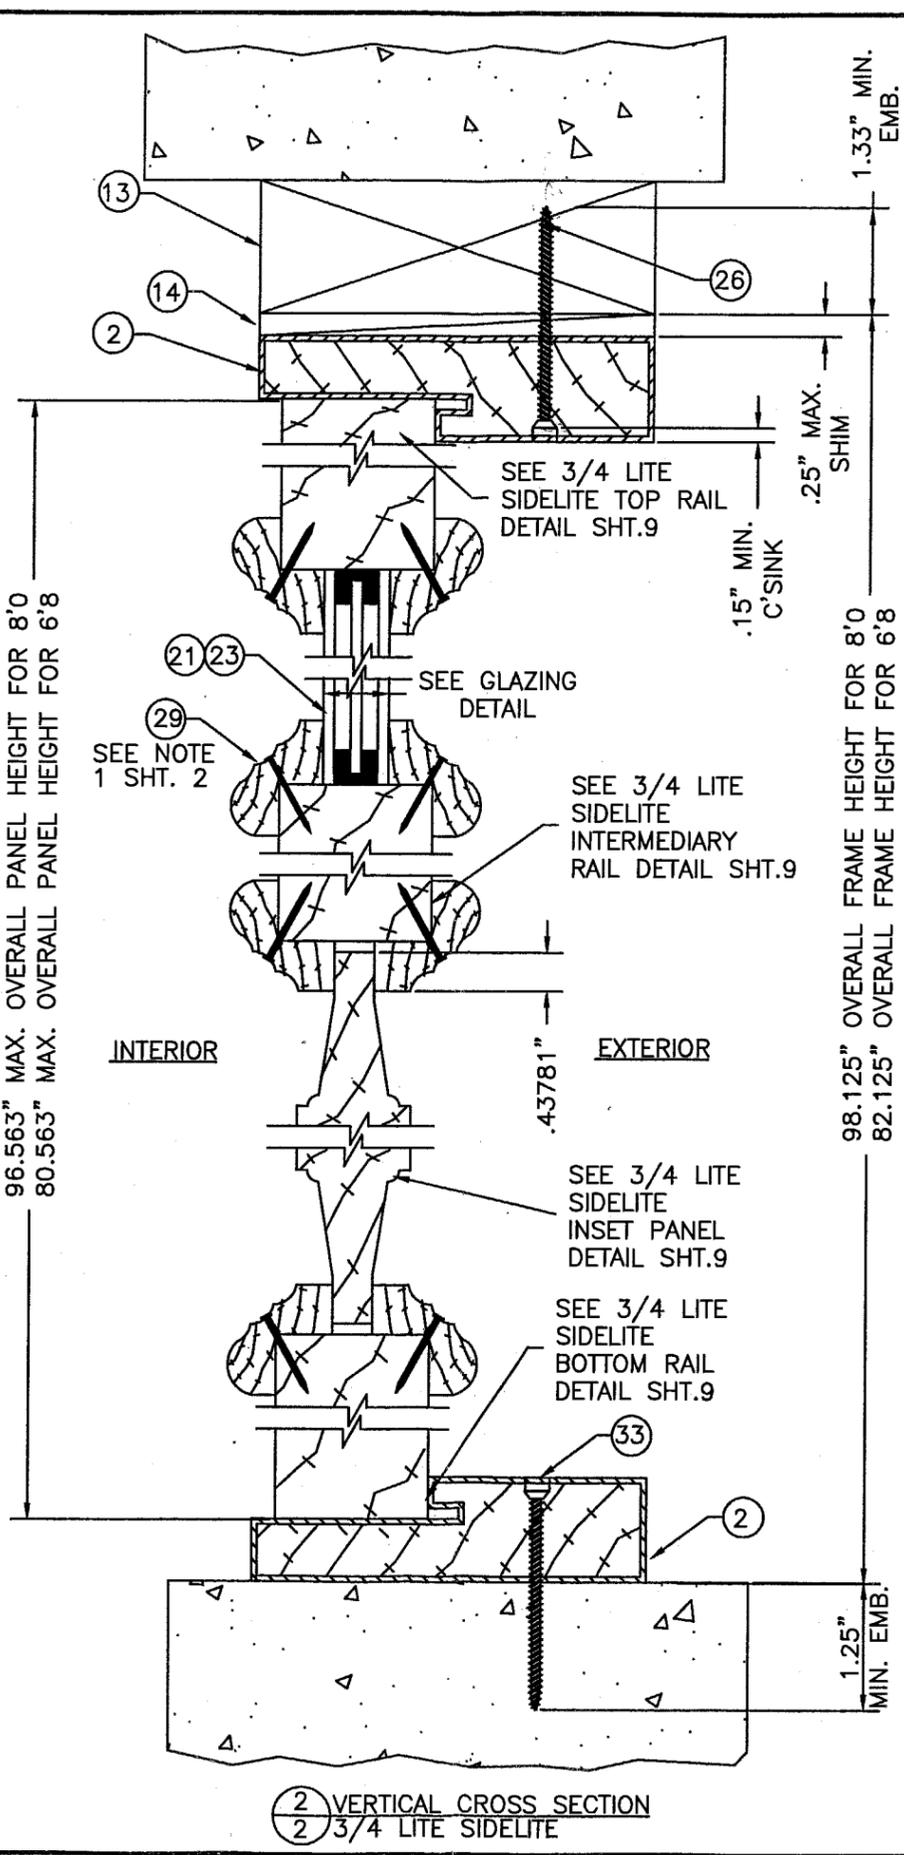

2 VERTICAL CROSS SECTION  
2 3/4 LITE SIDELITE

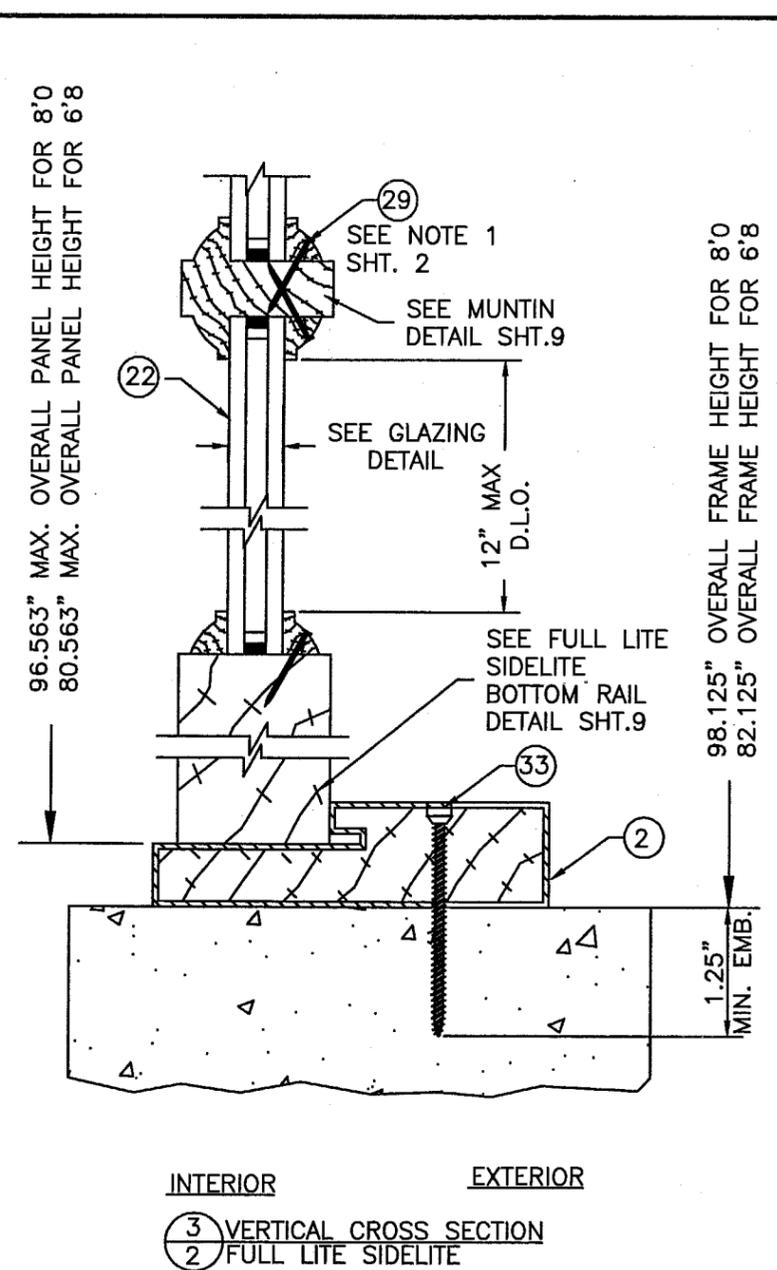

3 VERTICAL CROSS SECTION  
2 FULL LITE SIDELITE

NOTES:  
1. THE DECORATIVE TRIM IS APPLIED TO BOTH SIDES OF THE PANEL WITH ITEM #29 (16 GA. BRAD NAIL 1" L.) LOCATED 1.0" FROM EACH END AN A MAX. 4.0" ON CENTER.

**MOULDING ASSOCIATES INCORPORATED**  
933 HENSLEY LANE  
WYLIE, TX 75098  
PHONE: 800.394.6680


PRODUCT: STILE & RAIL  
6'8 OR 8'0 OPAQUE  
WOOD DOOR IN-SWING UNIT  
PART OR ASSEMBLY:  
VERTICAL  
CROSS SECTIONS

NO.	DATE	ADD ANCHORS	LRL	BY	REVISIONS
1	01/27/03				


**RW** BUILDING CONSULTANTS, INC.  
813.684.3831

DATE: 5/19/02  
SCALE: N.T.S.  
DWG. BY: WLN  
CHK. BY: RW  
DRAWING NO.: S-2247  
SHEET 2 of 10


Approved as complying with the Florida Building Code  
Date 03/06/03  
NOA# 02-0923.04  
Miami Dade Product Control Division  
By *Sherrill Berman*

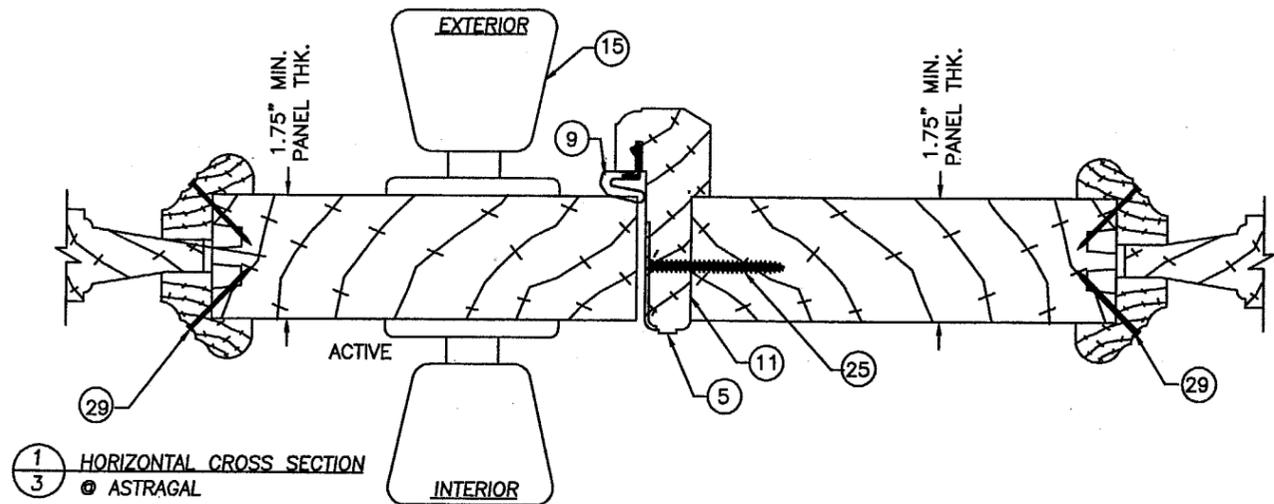


1  
3 HORIZONTAL CROSS SECTION  
① ASTRAGAL

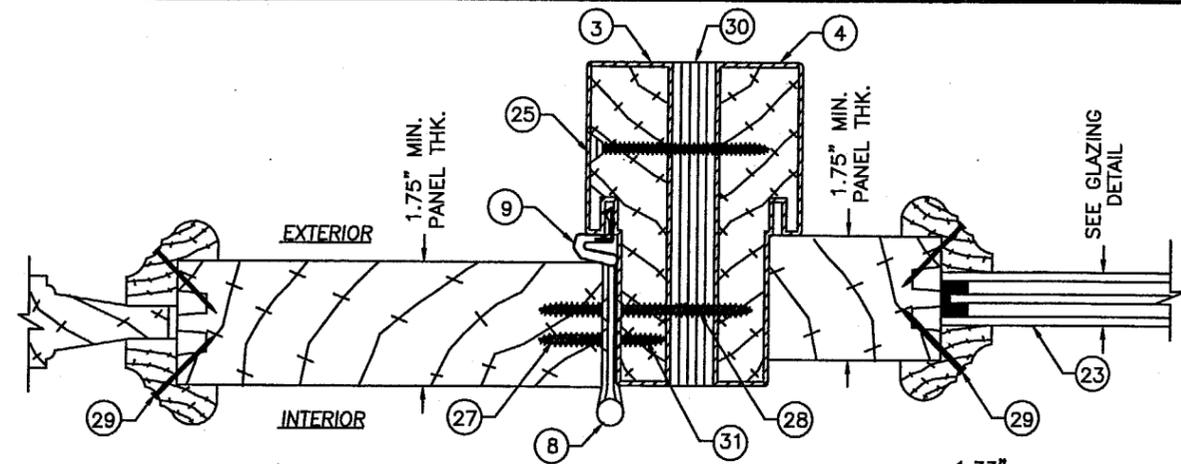


4  
3 HORIZONTAL CROSS SECTION @ MULLION  
(SHOWN WITH 3/4 LITE SIDELITE)

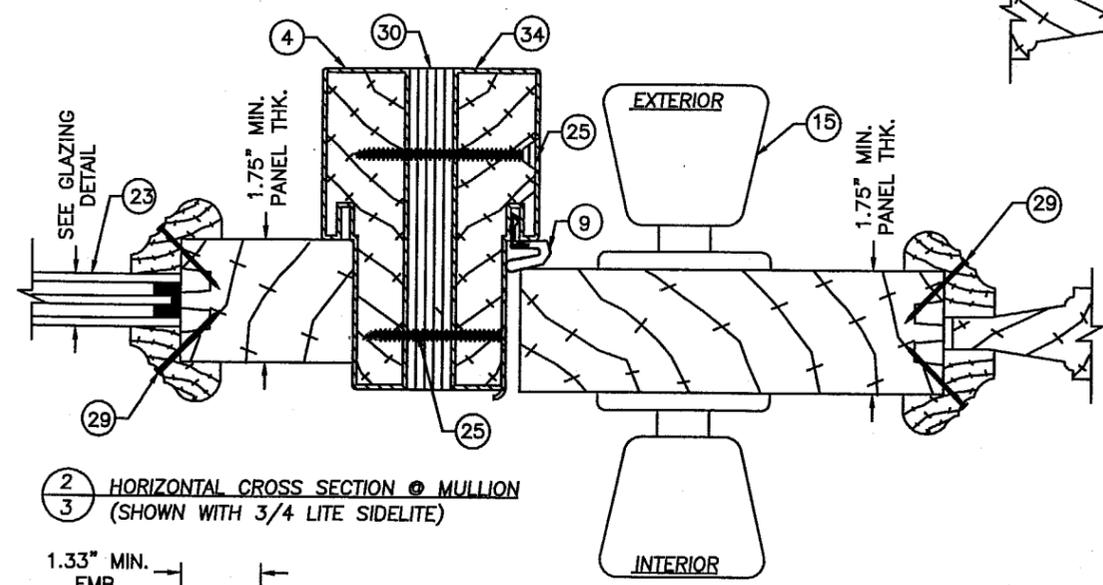


2  
3 HORIZONTAL CROSS SECTION @ MULLION  
(SHOWN WITH 3/4 LITE SIDELITE)

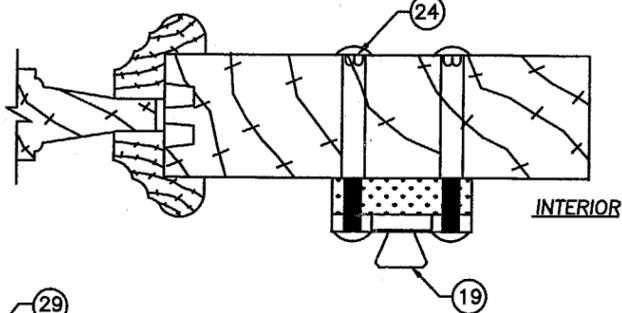


DETAIL "A" SURFACE BOLTS  
REQUIRED ON IN-ACTIVE PANEL  
OPTIONAL FOR ACTIVE PANEL

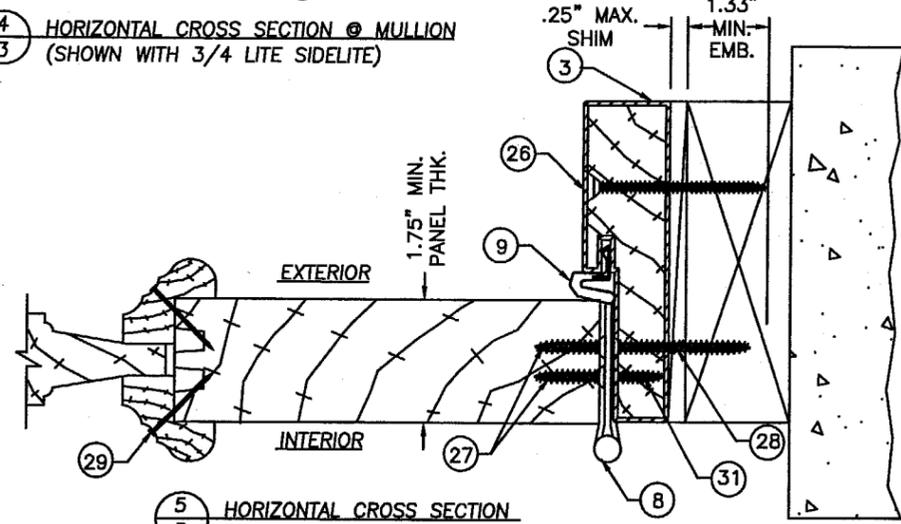


5  
3 HORIZONTAL CROSS SECTION  
① HINGE JAMB TO BUCK

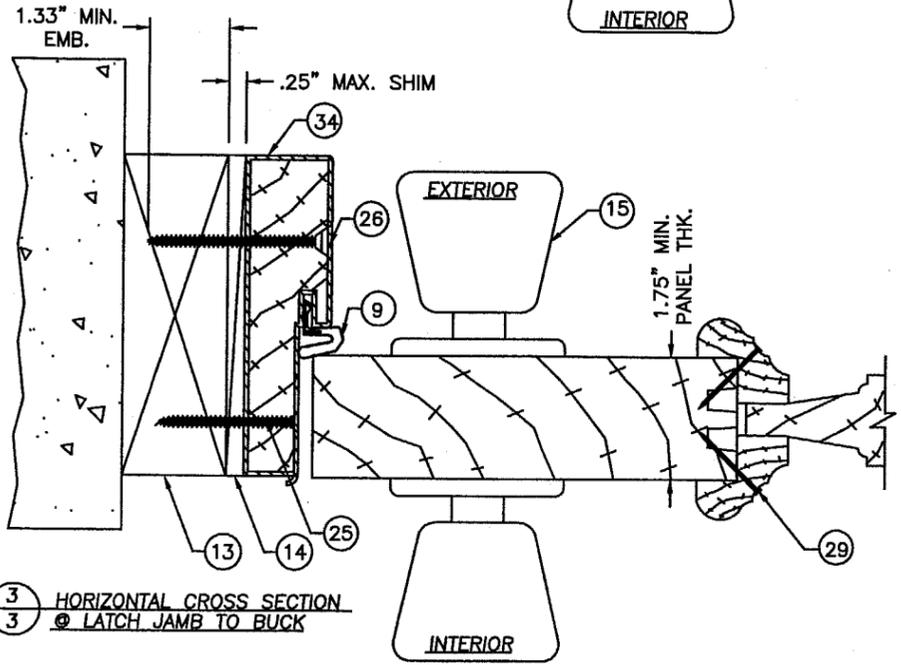

3  
3 HORIZONTAL CROSS SECTION  
① LATCH JAMB TO BUCK

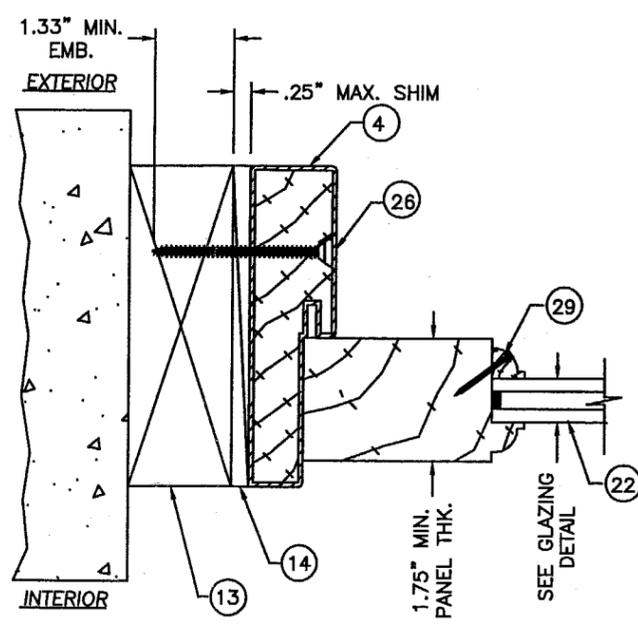

7  
3 HORIZONTAL CROSS SECTION  
① SIDELITE TO BUCK

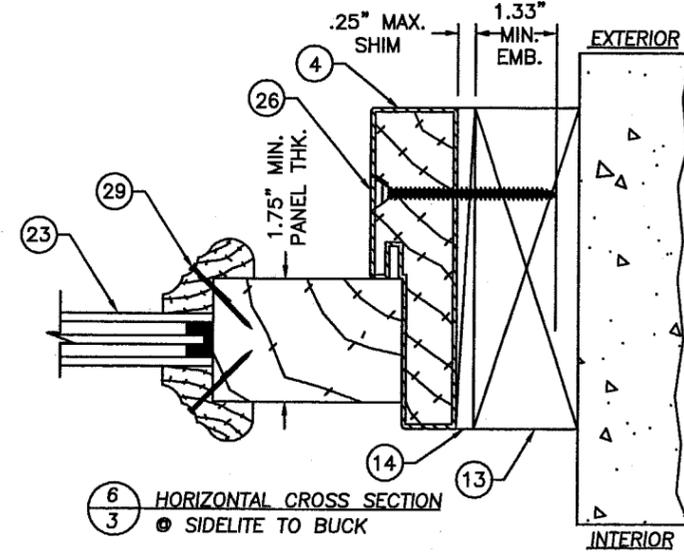

6  
3 HORIZONTAL CROSS SECTION  
① SIDELITE TO BUCK

**MOULDING ASSOCIATES INCORPORATED**  
933 HENSLEY LANE  
WYLIE, TX 75098  
PHONE: 800.394.6680


PRODUCT: STILE & RAIL  
6'8" OR 8'0" OPAQUE  
WOOD DOOR IN-SWING UNIT  
PART OR ASSEMBLY:  
HORIZONTAL  
CROSS SECTION

NO.	DATE	ADD ANCHORS	LR	BY
1	01/27/03			


**RW BUILDING CONSULTANTS, INC.**  
813.684.3831

DATE: 5/19/02  
SCALE: N.T.S.  
DWG. BY: WLN  
CHK. BY: RW  
DRAWING NO.: S-2247  
SHEET 3 OF 10


Approved as complying with the  
Florida Building Code  
Date: 03/06/03  
NOA# 02-0923.04  
Miami Dade Product Control  
Division  
By: *Alfred Bertram*

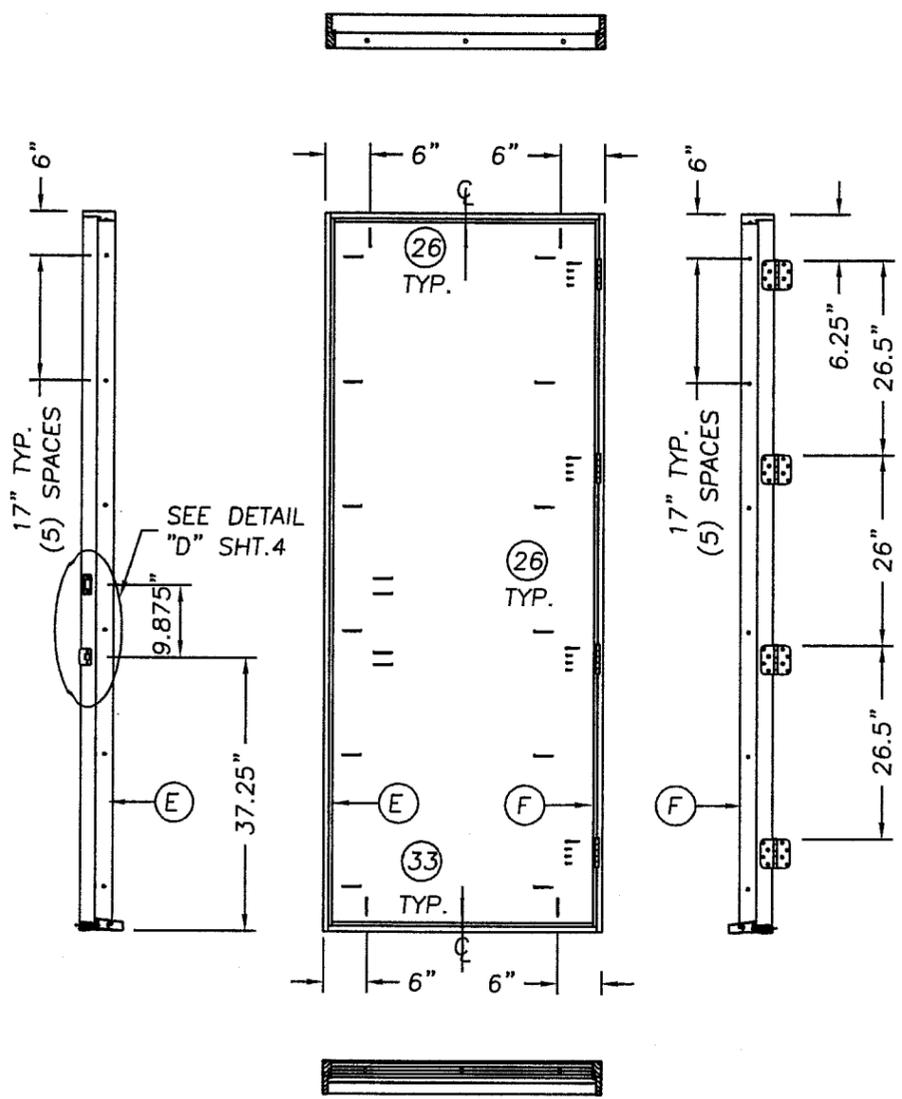


SINGLE DOOR

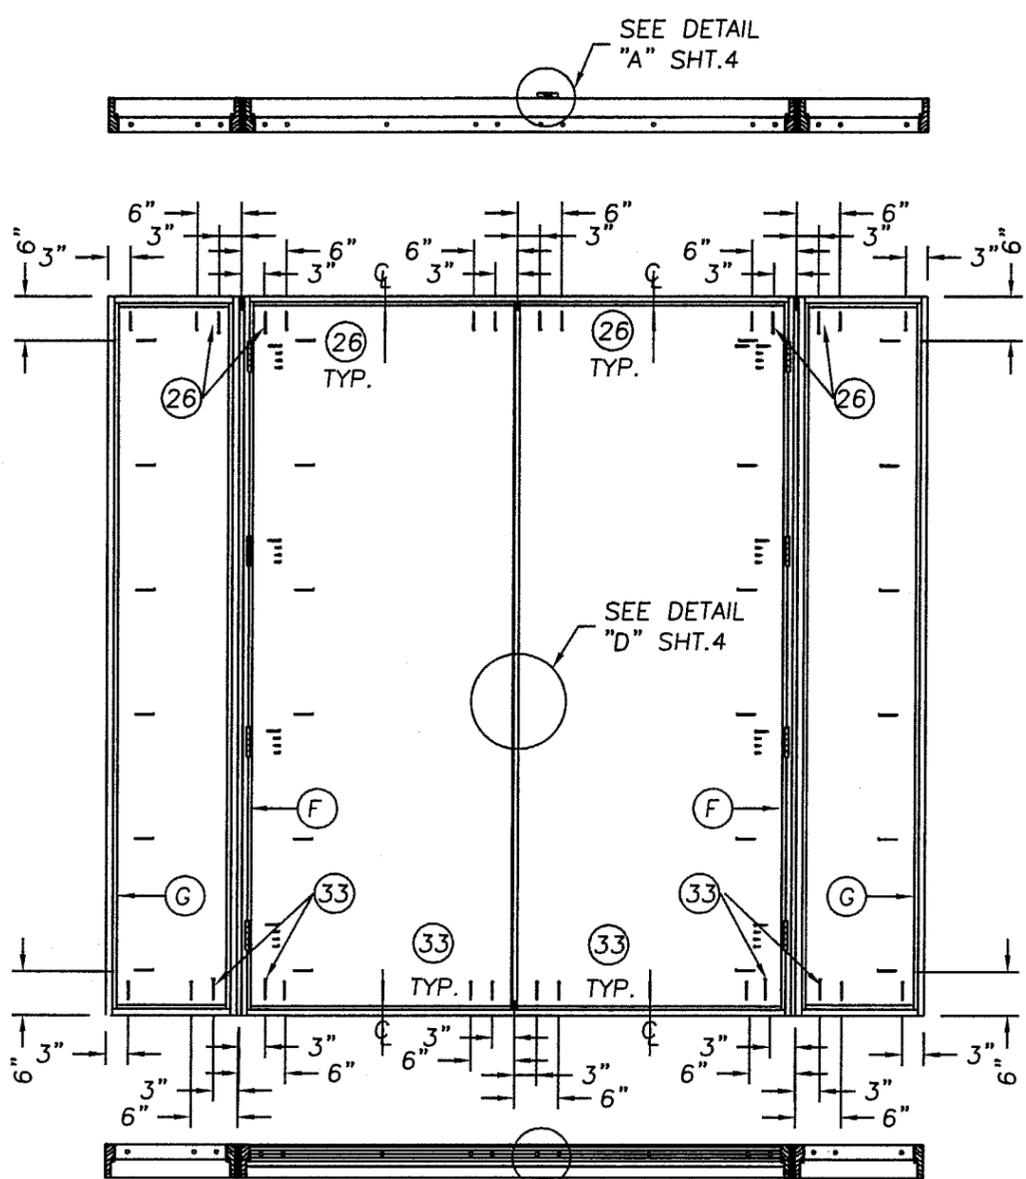


DOUBLE DOOR W/SIDELITES

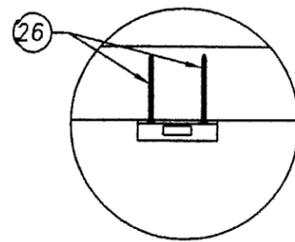


DETAIL "A"  
SURFACE BOLT STRIKE PLATE  
ATTACHED TO THE HEADER

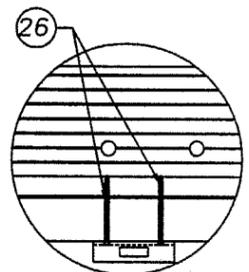

DETAIL "B"  
SURFACE BOLT STRIKE PLATE  
ATTACHED TO THE THRESHOLD

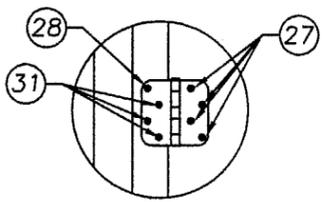

DETAIL "C"

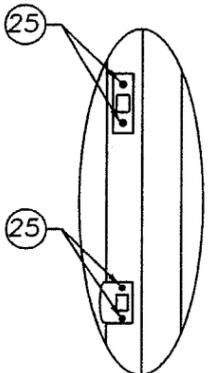

DETAIL "D"

NOTE:  
FOR 6'8" DOOR HINGE LOCATIONS ARE AS FOLLOW:  
FROM TOP OF HINGE JAMB TO TOP OF 1ST HINGE 7",  
2ND & 3RD HINGE TO HAVE 29 1/4" CENTERLINE.  
6'8" & 8'0" LATCH AND DEADBOLT STRIKES ARE THE  
SAME LOCATIONS.

Approved as complying with the  
Florida Building Code  
Date 03/06/03  
NOAR 02-0222.04  
Miami Dade Product Control  
Division  
By *Sheridan*


DATE: 5/19/02  
SCALE: N.T.S.  
DWG. BY: WLN  
CHK. BY: RW  
DRAWING NO.: S-2247  
SHEET 4 OF 10

MOULDING  
ASSOCIATES  
INCORPORATED  
933 HENSLEY LANE  
WYLE, TX 75098  
PHONE: 800.394.6680



PRODUCT: STILE & RAIL  
6'8" OR 8'0" OPAQUE  
WOOD DOOR IN-SWING UNIT  
PART OR ASSEMBLY:  
ANCHORING LOCATIONS  
& DETAILS

NO.	DATE	ADD ANCHORS	LRL	BY
1	01/27/03			

RW BUILDING  
CONSULTANTS, INC.  
813.684.3831

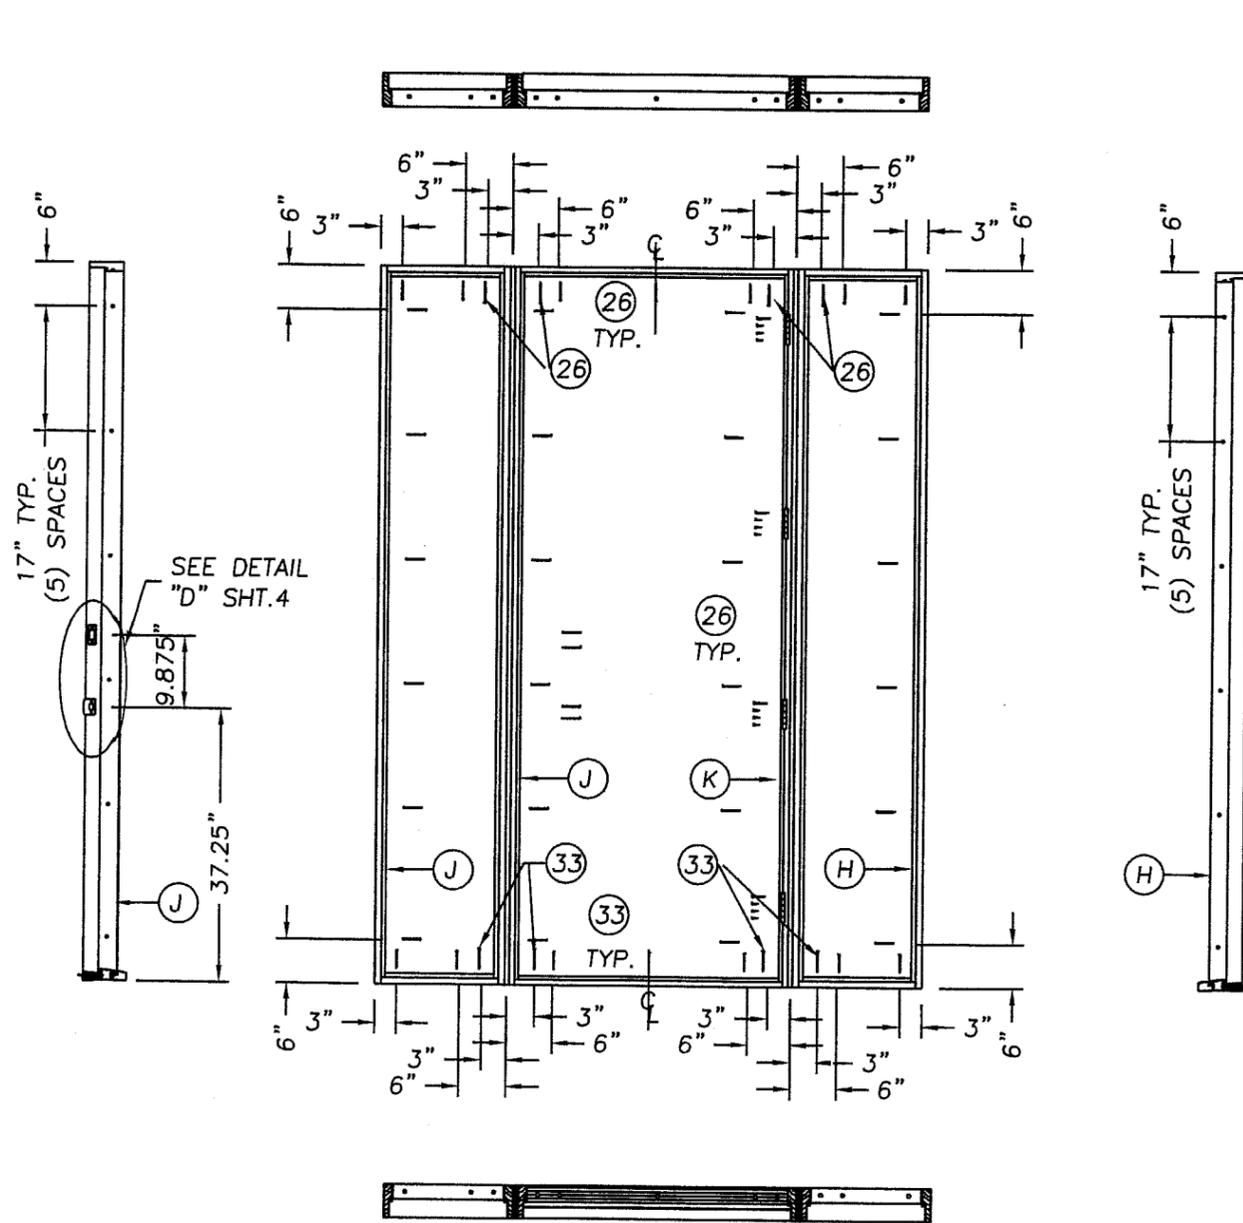

SINGLE DOOR W/SIDELITES

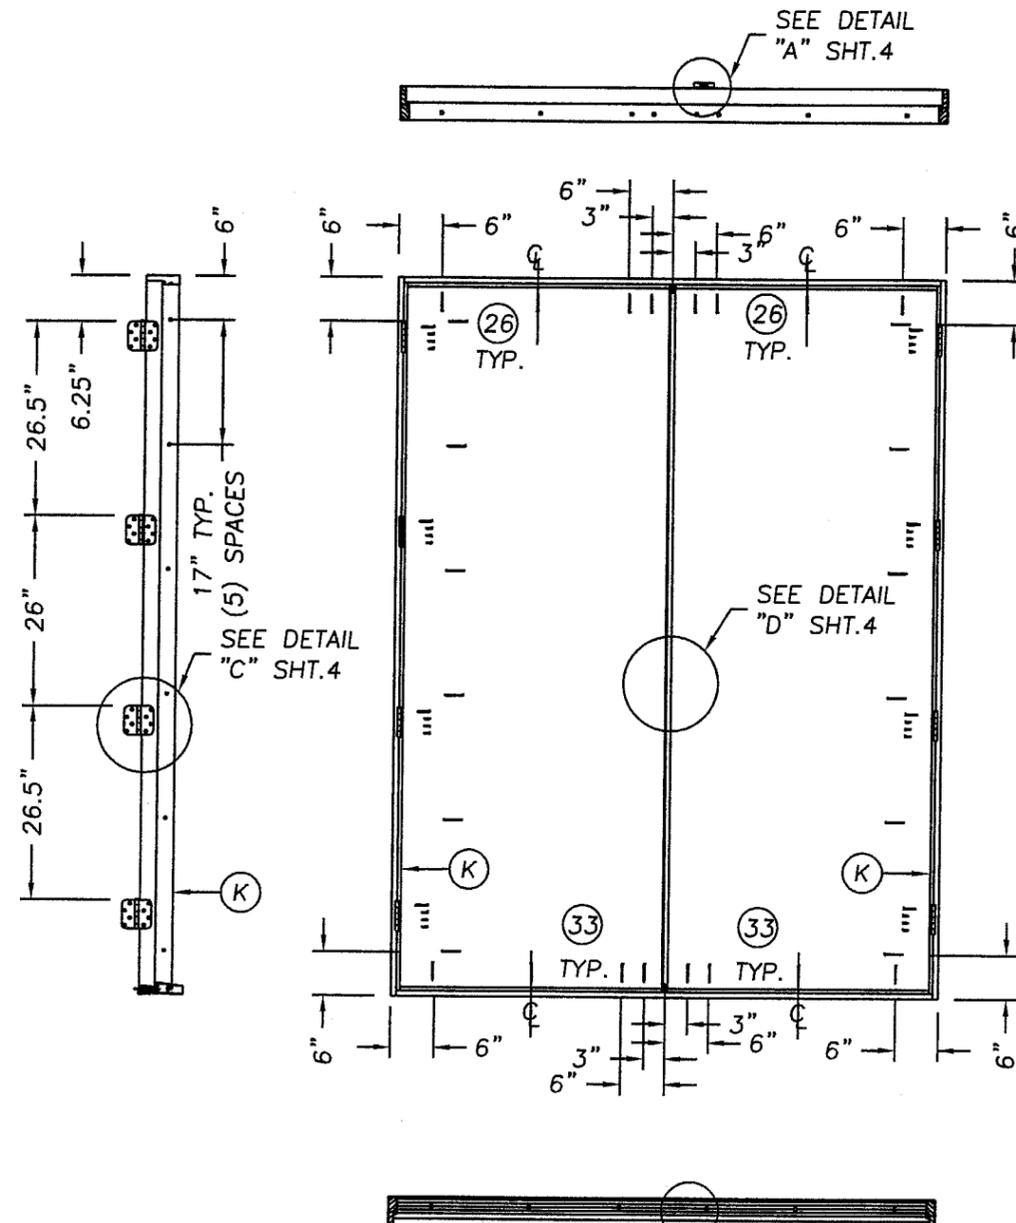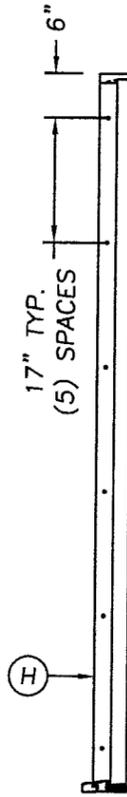

DOUBLE DOOR

**MOULDING ASSOCIATES INCORPORATED**  
 933 HENSLEY LANE  
 WYLE, TX 75098  
 PHONE: 800.394.6680

PRODUCT: STILE & RAIL  
 6/8 OR 8/0 OPAQUE  
 WOOD DOOR IN-SWING UNIT  
 PART OR ASSEMBLY:

ANCHORING LOCATIONS








NO	DATE	ADD ANCHORS	LRL	BY
1	01/27/03			

REVISIONS

**RW** BUILDING CONSULTANTS, INC.  
 813.684.3831

Approved as complying with the Florida Building Code  
 Date 03/06/03  
 NOAH 02-0922.09  
 Miami Code Product Control  
 Division  
 By [Signature]

DATE: 5/19/02  
 SCALE: N.T.S.  
 DWG. BY: WLN  
 CHK. BY: RW  
 DRAWING NO.: S-2247  
 SHEET 5 OF 10

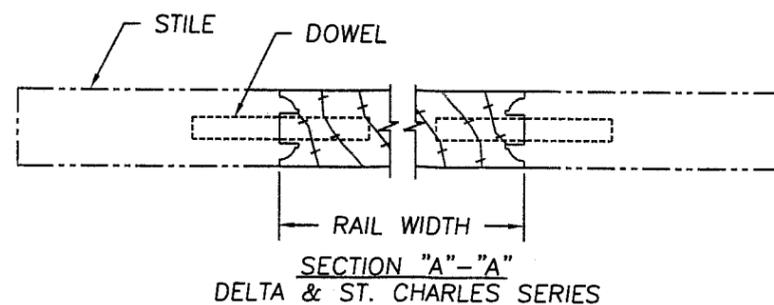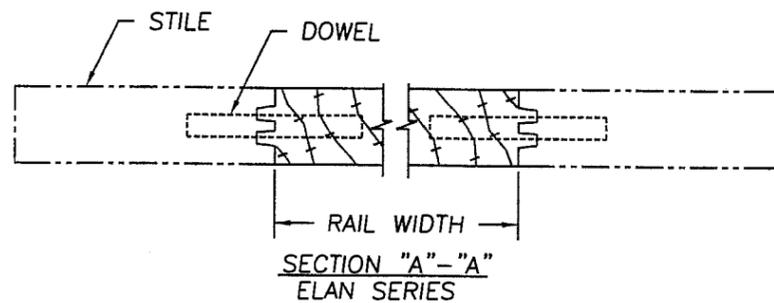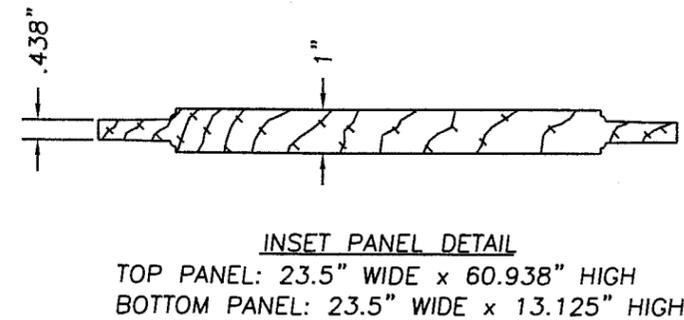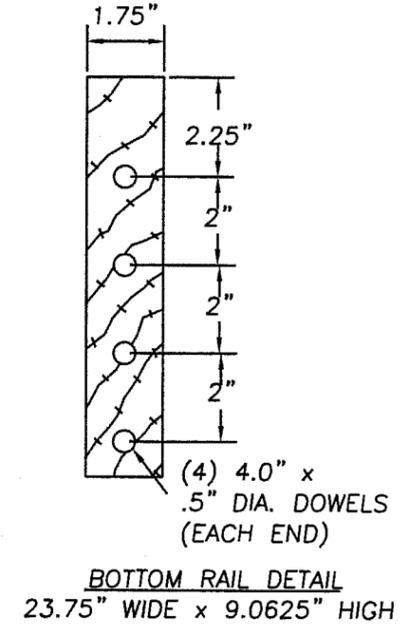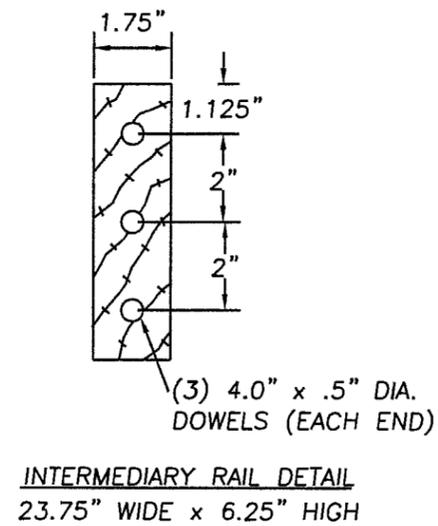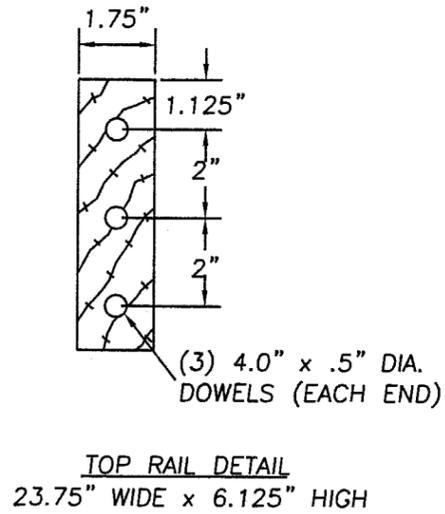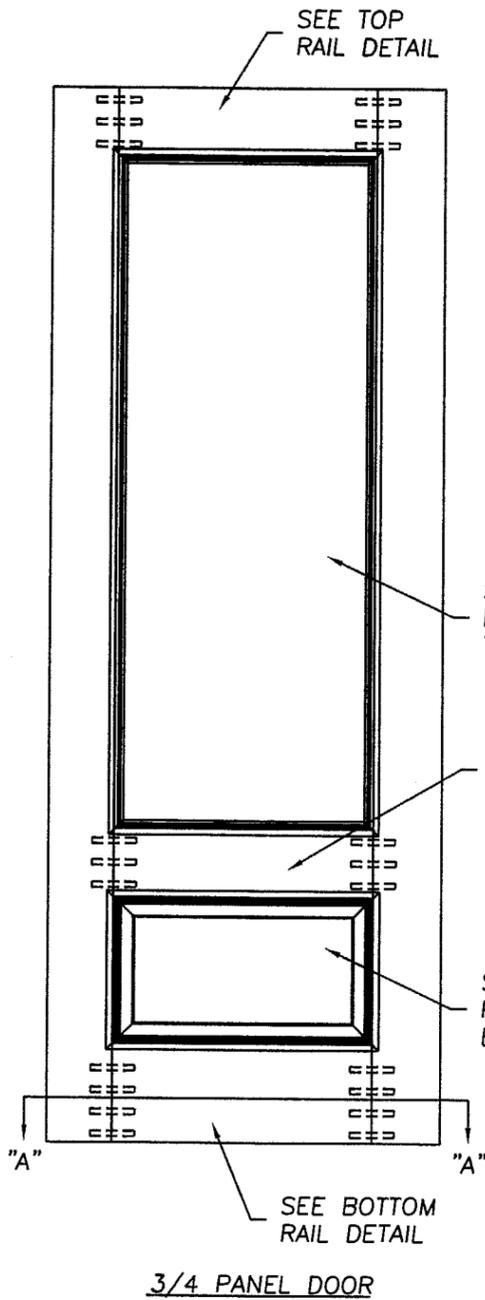

**MOULDING ASSOCIATES INCORPORATED**  
933 HENSLEY LANE  
WYLIE, TX 75098  
PHONE: 800.394.6680


PRODUCT: STILE & RAIL  
6'8 OR 8'0 OPAQUE  
WOOD DOOR IN-SWING UNIT  
PART OR ASSEMBLY:  
3/4 PANEL DOOR  
STILE & RAIL DETAIL

NO.	DATE	ADD ANCHORS	LRL	BY	REVISIONS
1	01/27/03				







**RW** BUILDING CONSULTANTS, INC.  
813.684.3831

DATE: 5/19/02  
SCALE: N.T.S.  
DWG. BY: WLN  
CHK. BY: RW  
DRAWING NO.: S-2247  
SHEET 6 OF 10

Approved as complying with the Florida Building Code  
Date 03/06/03  
NOA# 02-0923.09  
Miami Code Product Council  
By: *Meridith Heumen*

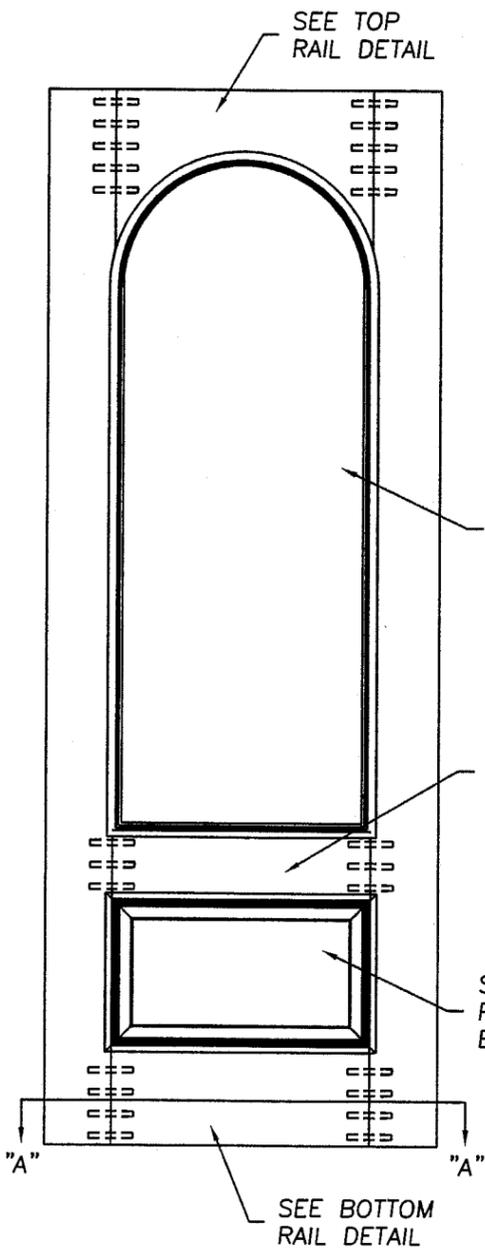

3/4 PANEL RADIUS TOP DOOR

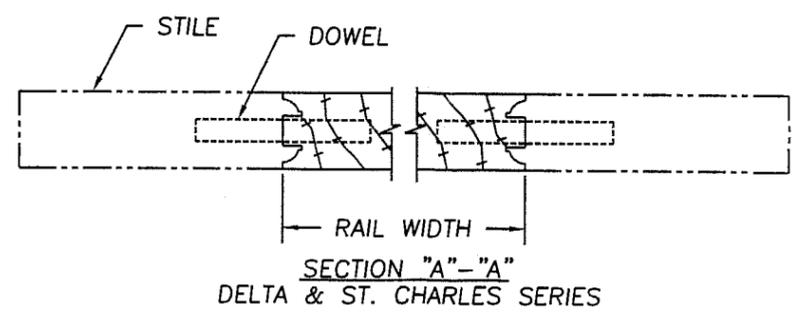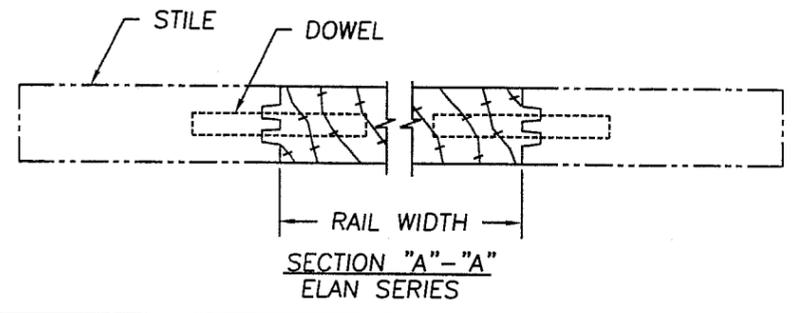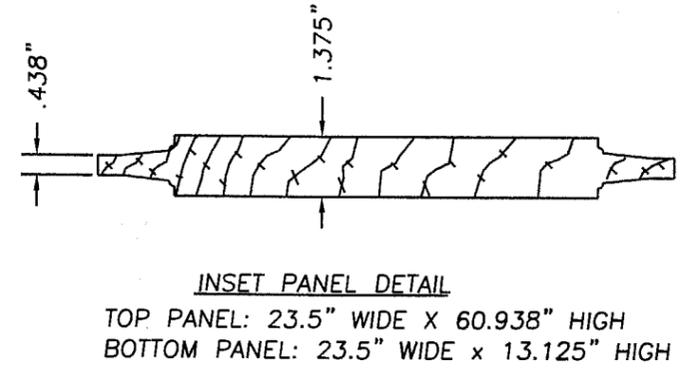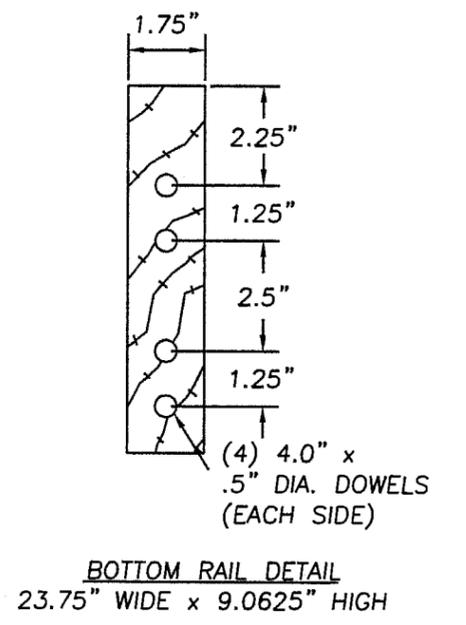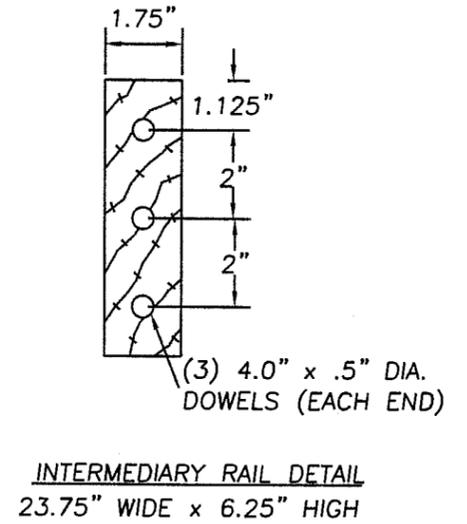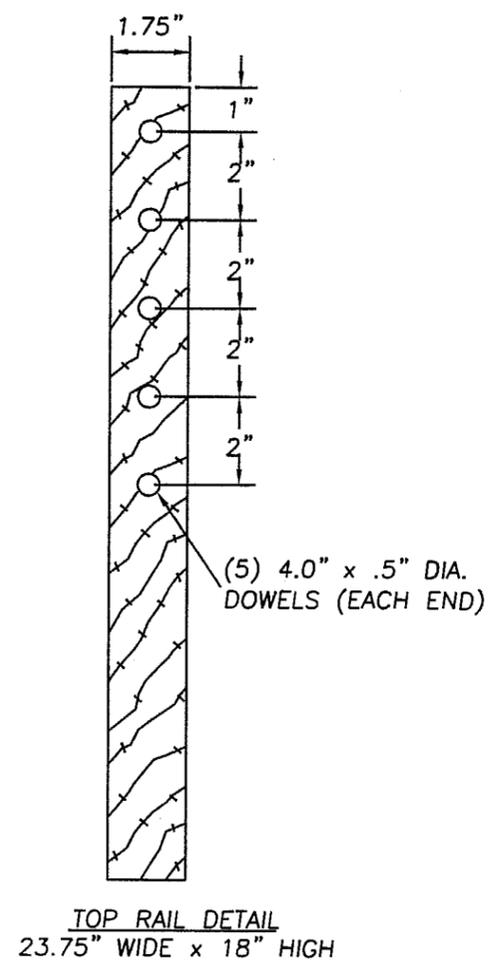

**MOULDING ASSOCIATES INCORPORATED**  
933 HENSLEY LANE  
WYLIE, TX 75098  
PHONE: 800.394.6680

PRODUCT: STILE & RAIL  
6'8 OR 8'0 OPAQUE  
WOOD DOOR IN-WING UNIT  
PART OR ASSEMBLY:  
3/4 PANEL RADIUS TOP DOOR  
STILE & RAIL DETAIL






NO	DATE	ADD ANCHORS	LRL	BY	REVISIONS
1	01/27/03				

**RW BUILDING CONSULTANTS, INC.**  
813.684.3831


DATE: 5/19/02  
SCALE: N.T.S.  
DWG. BY: WLN  
CHK. BY: RW  
DRAWING NO.: S-2247  
SHEET 7 OF 10

Approved as complying with the Florida Building Code  
Date: 03/06/03  
NOA# 02-0923-04  
Miami Dade Product Control  
By: *[Signature]*

MOULDING ASSOCIATES INCORPORATED  
 933 HENSLEY LANE  
 WYLIE, TX 75098  
 PHONE: 800.394.6680

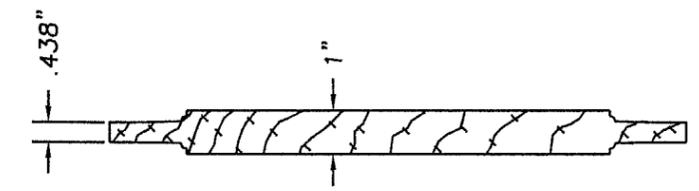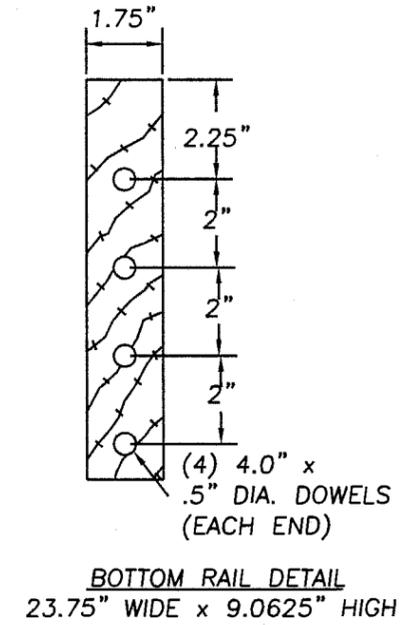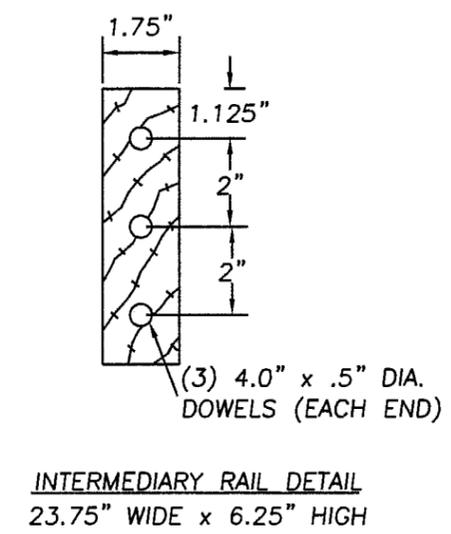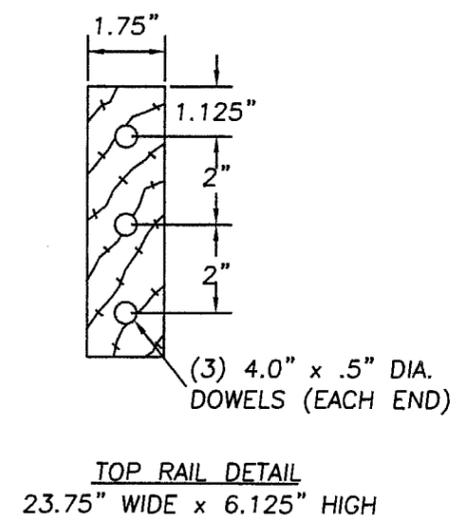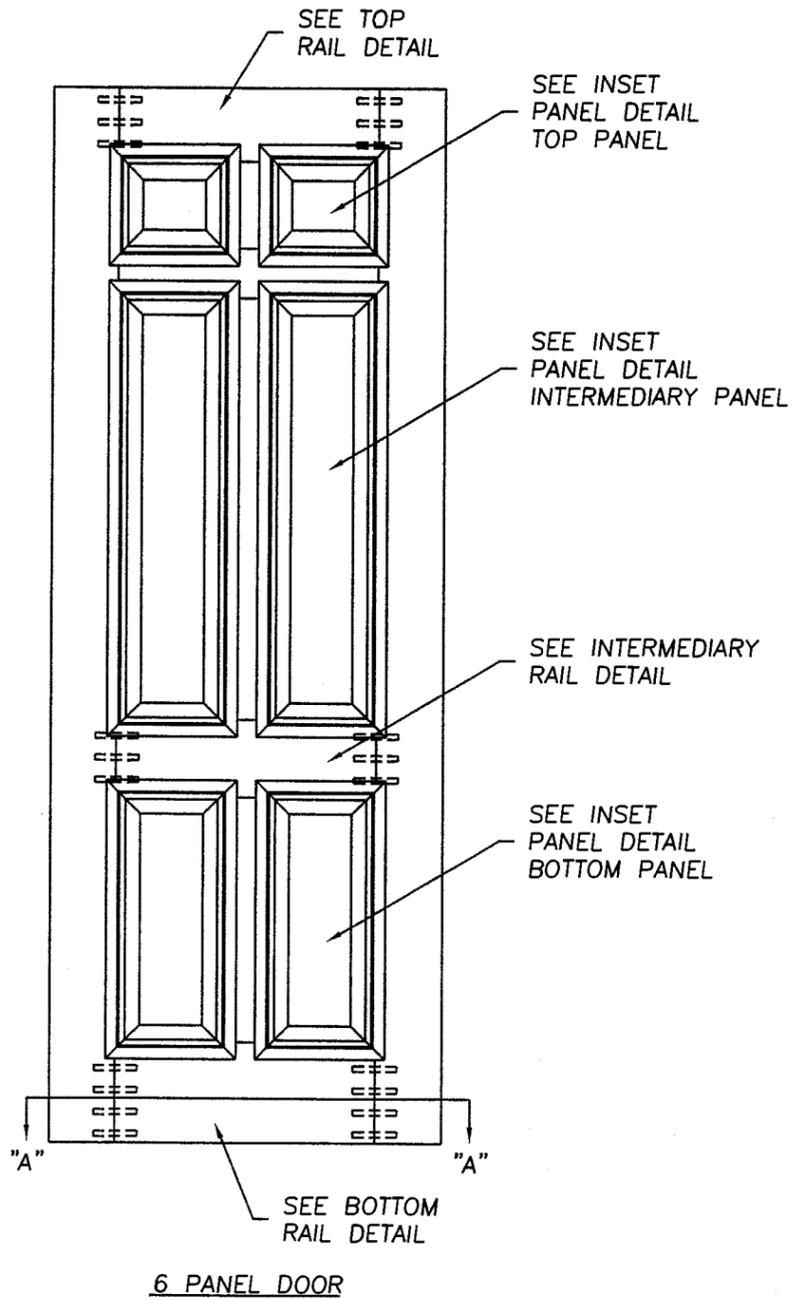

TOP PANEL: 8.781" WIDE x 7.718" HIGH  
 INTERMEDIARY PANEL: 8.781 WIDE x 38.5" HIGH  
 BOTTOM PANEL: 8.781" WIDE x 25.313" HIGH

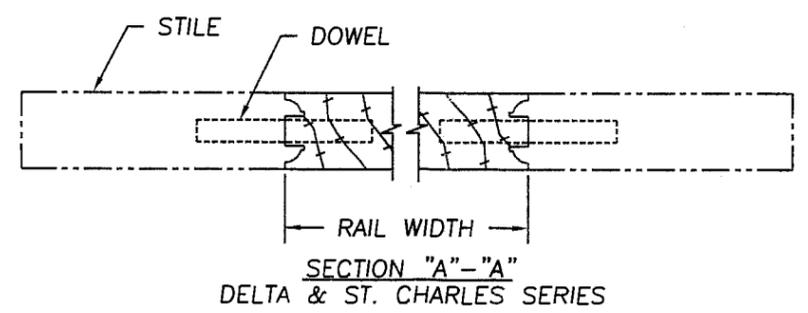


PRODUCT:	STILE & RAIL 6'8 OR 8'0 OPAQUE WOOD DOOR IN-SWING UNIT
PART OR ASSEMBLY:	6 PANEL DOOR STILE & RAIL DETAIL
NO.	1
DATE	01/27/03
ADD ANCHORS	LR
BY	BY
REVISIONS	

RW BUILDING CONSULTANTS, INC.  
 813.684.3831

Approved as complying with the Florida Building Code  
 Date 03/06/03  
 NOA# 02-0923.04  
 Miami Dade Product Control  
 Divided  
 By Alexander Herman


DATE:	5/19/02
SCALE:	N.T.S.
DWG. BY:	WLN
CHK. BY:	RW
DRAWING NO.:	S-2247
SHEET	8 OF 10

**MOULDING ASSOCIATES INCORPORATED**  
 933 HENSLEY LANE  
 WYLIE, TX 75098  
 PHONE: 800.394.6680

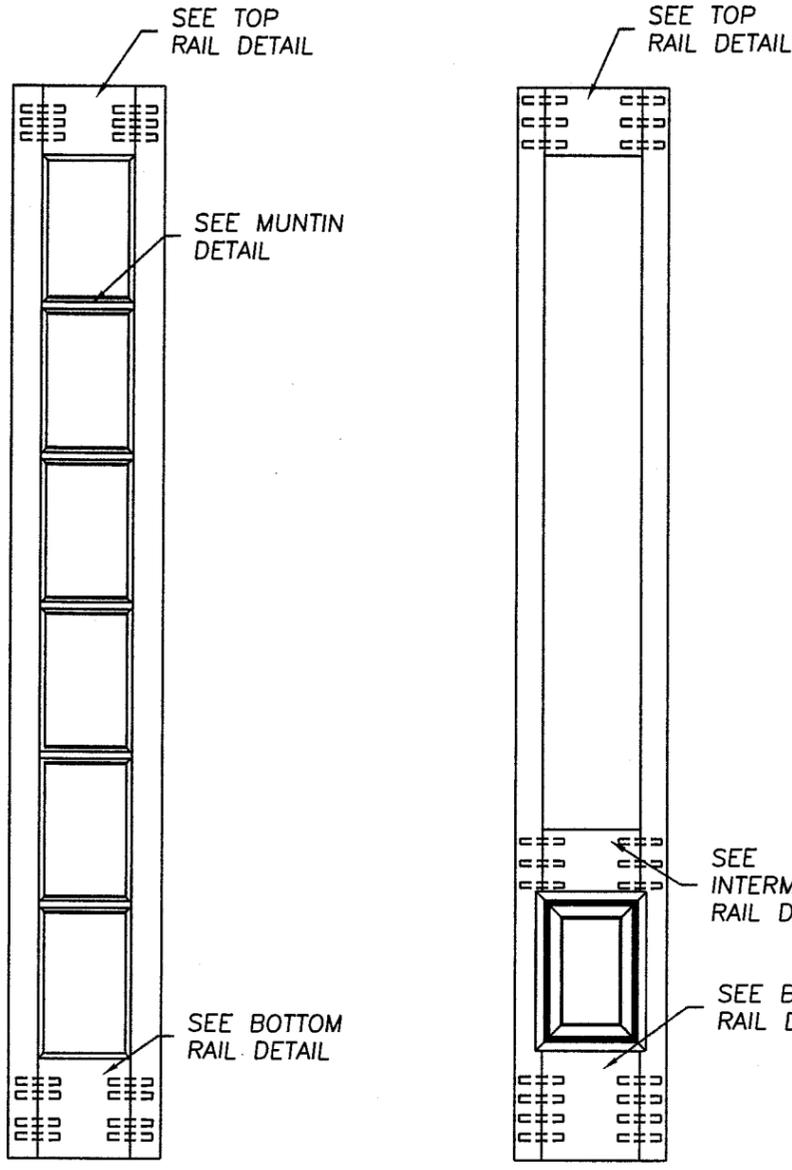


TRUE DIVIDED FULL LITE SIDELITE


3/4 LITE SIDELITE

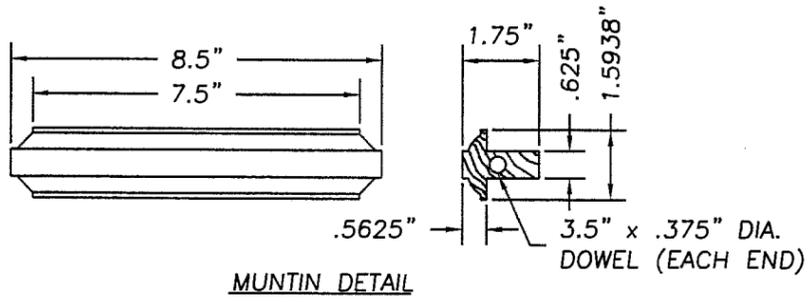


MUNTIN DETAIL

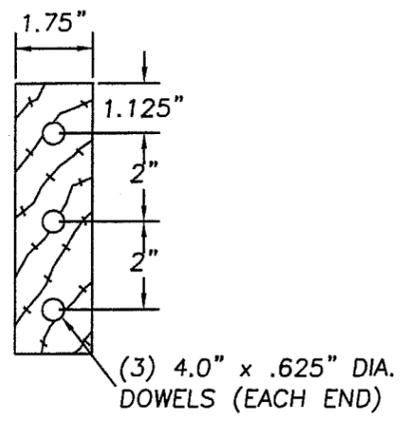


3/4 LITE SIDELITE TOP RAIL DETAIL  
 9.0" WIDE x 6.125" HIGH

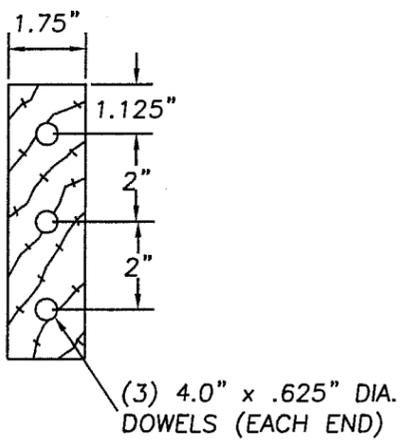


3/4 LITE SIDELITE INTERMEDIARY RAIL DETAIL  
 9.0" WIDE x 6.25" HIGH

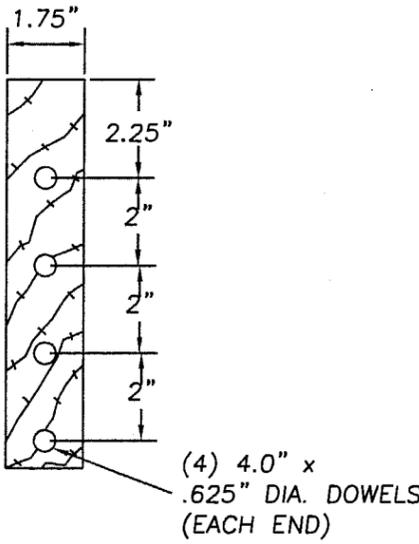


3/4 LITE SIDELITE BOTTOM RAIL DETAIL  
 9.0" WIDE x 9.625" HIGH

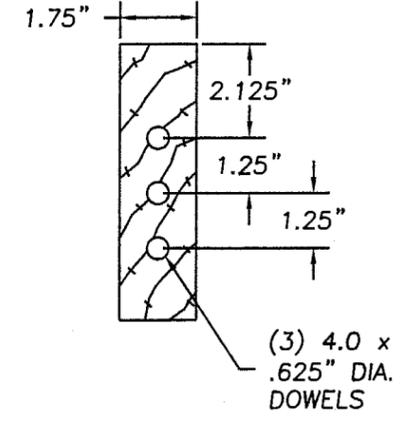

FULL LITE SIDELITE TOP RAIL DETAIL  
 8.5" WIDE x 6.25" HIGH

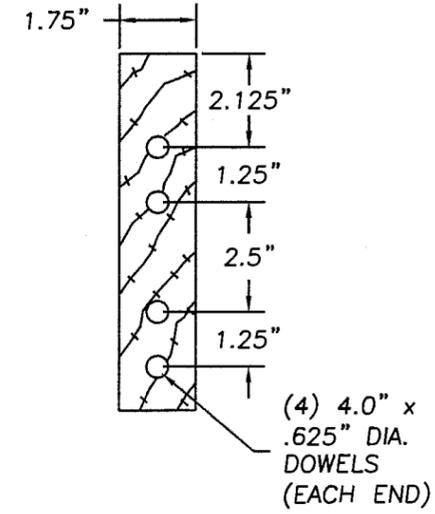

FULL LITE SIDELITE BOTTOM RAIL DETAIL  
 8.5" WIDE x 9.125" HIGH

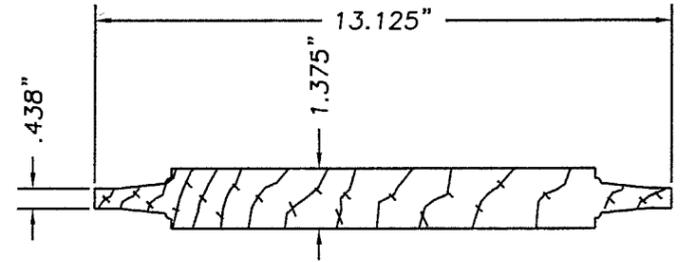

INSET PANEL DETAIL  
 8.75" WIDE x 13.125" HIGH


Approved as complying with the Florida Building Code  
 Date 03/06/03  
 NOAB 02-0923.04  
 Miami Code Product Control  
 Divided  
 By [Signature]

PRODUCT: STILE & RAIL 6'8" OR 8'0" OPAQUE WOOD DOOR IN-SWING UNIT		PART OR ASSEMBLY:	
SIDELITE STILE & RAIL DETAIL		SIDELITE STILE & RAIL DETAIL	
NO.	DATE	ADD ANCHORS	BY
1	01/27/03	LRL	BY
REVISIONS			


**RW BUILDING CONSULTANTS, INC.**  
 813.684.3831

DATE: 5/19/02  
 SCALE: N.T.S.  
 DWG. BY: WLN  
 CHK. BY: RW  
 DRAWING NO.: S-2247  
 SHEET 9 OF 10


ITEM	DESCRIPTION	MATERIAL
1	STYLE & RAIL 8-0 WOOD DOOR (MAHOGANY & OAK)	WOOD
2	HEAD JAMB FINGER JOINTED MAHOGANY WITH .0625 CLEAR MAHOGANY VENEER	MAHOGANY
3	HINGE JAMB FINGER JOINTED MAHOGANY WITH .0625 CLEAR MAHOGANY VENEER	MAHOGANY
4	SIDELITE BLANK JAMB FINGER JOINTED MAHOGANY WITH .0625 CLEAR MAHOGANY VENEER	MAHOGANY
5	1 PIECE WOOD ASTRAGAL	WOOD
6	NOT USED	-
7	INSWING SCHLEGEL HYDRO SILL THRESHOLD	ALUM.
8	4" X 4" BUTT RADIUS HINGE	STEEL
9	ENDURA FORCE 5 COMPRESSION WEATHERSTRIPPING	FOAM
10	SILICON CAULK	SILICONE
11	PL CONSTRUCTION ADHESIVE	-
12	NOT USED	-
13	2x INNER WOOD TEST BUCK	WOOD
14	MAX. 1/4" SHIM MATERIAL	WOOD
15	KWIKSET TITAN SERIRES LATCH BOLT (ANSI GRADE II)	-
16	KWIKSET TITAN SERIRES DEAD BOLT (ANSI GRADE II)	-
17	SCHLAGE ULTIMA SERIRES LATCH BOLT (ANSI GRADE II)	-
18	SCHLAGE ULTIMA SERIRES DEAD BOLT (ANSI GRADE II)	-
19	IVES NO. 454 SURFACE BOLT	STEEL
20	NOT USED	-
21	1/2" INSULATED GLASS	GLASS
22	5/8" INSULATED GLASS	GLASS
23	3/4" INSULATED GLASS	GLASS
24	10-24 SEX BOLT	STEEL
25	#8 x 2.5" PFH WOOD SCREW	STEEL
26	#10 x 3.0" PFH WOOD SCREW	STEEL
27	#10 x 1.0" PFH WOOD SCREW	STEEL
28	#10 x 2.0 PFH WOOD SCREW	STEEL
29	BRAD TRIM NAIL 1" L.	STEEL
30	.6875" X 4.625" WOOD REINFORCEMENT	LVL
31	#10 x .75" PFH WOOD SCREW	STEEL
32	#10 x 2.5" PFH WOOD SCREW	STEEL
33	3/16" TAPCON ANCHOR	STEEL
34	LATCH JAMB FINGER JOINTED MAHOGANY WITH .0625 CLEAR MAHOGANY VENEER	MAHOGANY

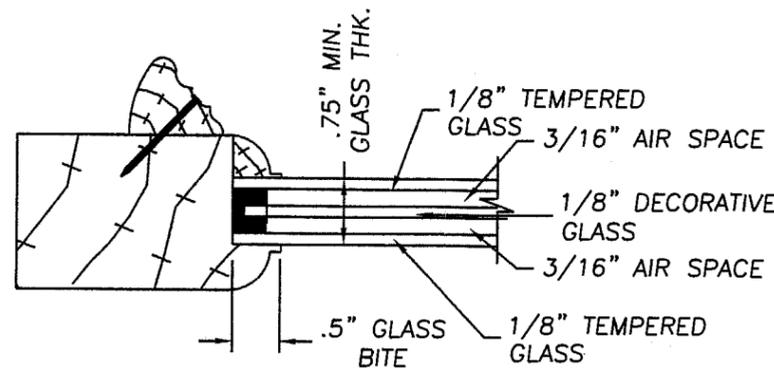


ST. CHARLES 3/4 LITE GLAZING DETAIL  
3/4" INSULATED GLASS

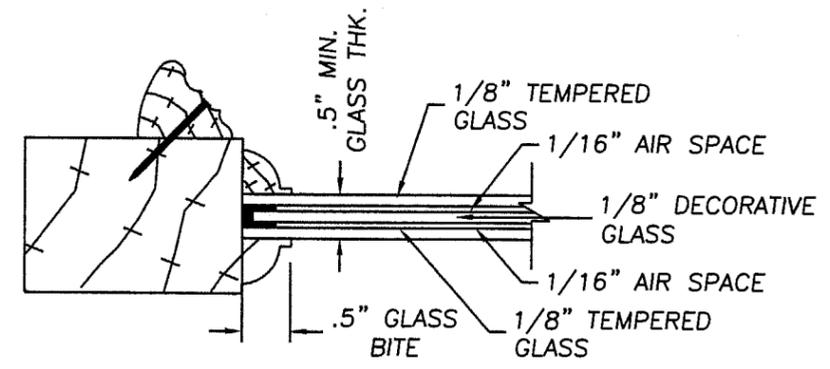


DELTA 3/4 LITE GLAZING DETAIL  
1/2" INSULATED GLASS

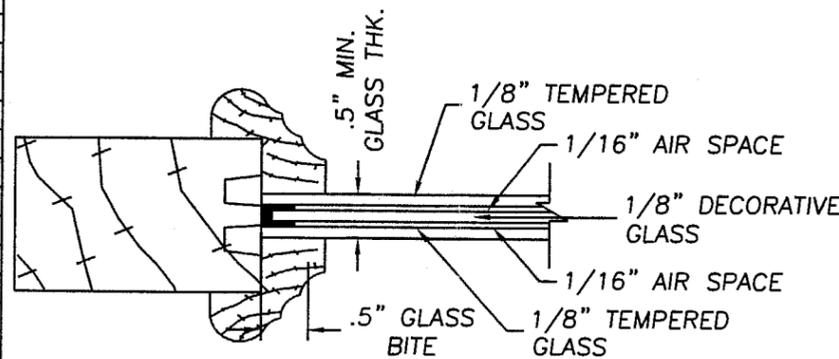


ELAN 3/4 LITE GLAZING DETAIL  
1/2" INSULATED GLASS

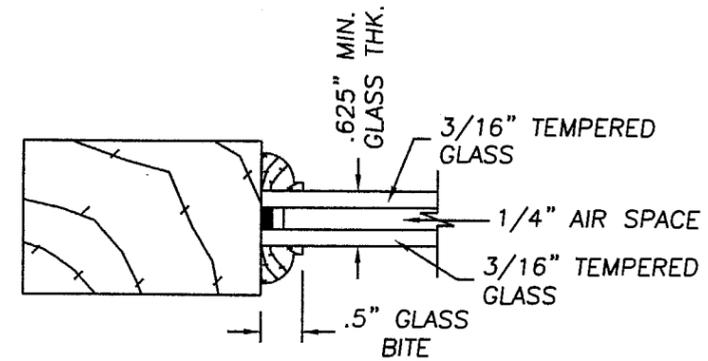


TRUE DIVIDED FULL LITE GLAZING DETAIL  
5/8" INSULATED GLASS

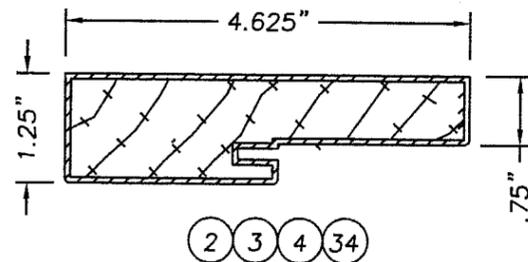

WOOD JAMB FINGER JOINTED MAHOGANY  
WITH .0625 CLEAR MAHOGANY VENEER

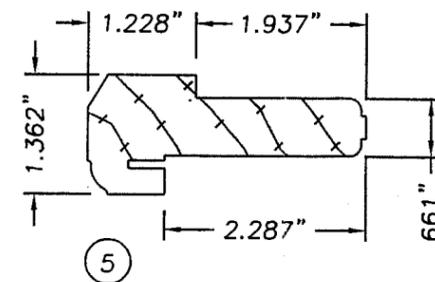


(1) PIECE WOOD ASTRAGAL  
(USE PL CONSTRUCTION ADHESIVE TO  
ADHERE TO THE INACTIVE DOOR PANEL)

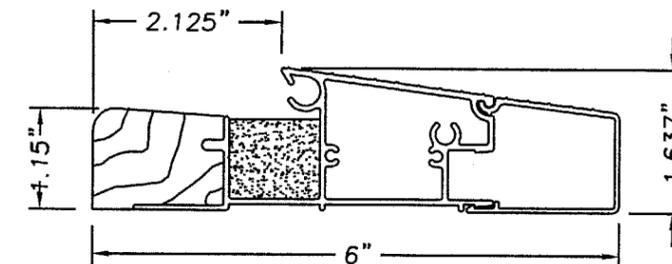


(7) SCHLEGEL HYDRO SILL  
ALUMINUM THRESHOLD

(ATTACH THRESHOLD TO JAMB WITH (2) #8 x 3" DECK  
SCREWS FROM THE THRESHOLD UP INTO THE STOP AND  
(4) 16 GA. x 1.75" LONG 0.5" CROWN STAPLES.)

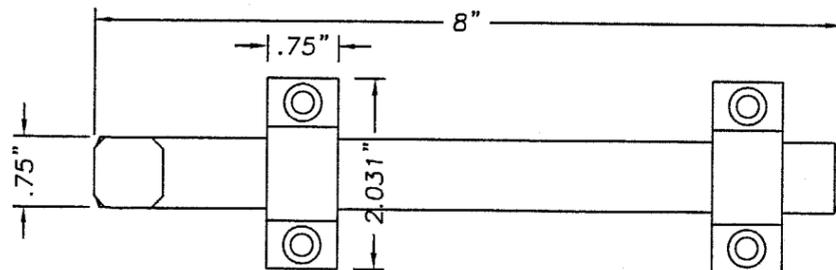

(19) SURFACE BOLT (IVES, MODEL 455 .25" STEEL)

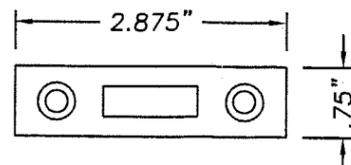

SURFACE BOLT STRIKE (IVES .125" STEEL)

MOULDING  
ASSOCIATES  
INCORPORATED  
933 HENSLEY LANE  
WYLIE, TX 75098  
PHONE: 800.394.6680

PRODUCT: STILE & RAIL  
6'8" OR 8'0" OPAQUE  
WOOD DOOR IN-SWING UNIT  
PART OR ASSEMBLY:  
UNIT COMPONENTS, BILL OF  
MATERIAL & GLAZING DETAILS

NO.	DATE	ADD ANCHORS	LRL	BY
1	01/27/03			

RW BUILDING  
CONSULTANTS, INC.  
813.684.3831

Approved as complying with the  
Florida Building Code  
Date 03/06/03  
NOAS 02-0922.04  
Miami Dade Product Control  
Division  
By [Signature]

DATE: 5/19/02  
SCALE: N.T.S.  
DWG. BY: WLN  
CHK. BY: RW  
DRAWING NO.: S-2247  
SHEET 10 OF 10