



**BUILDING CODE COMPLIANCE OFFICE (BCCO)
PRODUCT CONTROL DIVISION**

**MIAMI-DADE COUNTY, FLORIDA
METRO-DADE FLAGLER BUILDING
140 WEST FLAGLER STREET, SUITE 1603
MIAMI, FLORIDA 33130-1563
(305) 375-2901 FAX (305) 375-2908**

NOTICE OF ACCEPTANCE (NOA)

**Fenestra America, LLC
5300 Kings Highway
Brooklyn, NY 11234**

SCOPE:

This NOA is being issued under the applicable rules and regulations governing the use of construction materials. The documentation submitted has been reviewed by Miami-Dade County Product Control Division and accepted by the Board of Rules and Appeals (BORA) to be used in Miami Dade County and other areas where allowed by the Authority Having Jurisdiction (AHJ).

This NOA shall not be valid after the expiration date stated below. The Miami-Dade County Product Control Division (In Miami Dade County) and/or the AHJ (in areas other than Miami Dade County) reserve the right to have this product or material tested for quality assurance purposes. If this product or material fails to perform in the accepted manner, the manufacturer will incur the expense of such testing and the AHJ may immediately revoke, modify, or suspend the use of such product or material within their jurisdiction. BORA reserves the right to revoke this acceptance, if it is determined by Miami-Dade County Product Control Division that this product or material fails to meet the requirements of the applicable building code.

This product is approved as described herein, and has been designed to comply with the Florida Building Code, including the High Velocity Hurricane Zone.

DESCRIPTION:..Series Outswing Wood French doors w/ wo sidelites-LMI

APPROVAL DOCUMENT: Drawing No. **W04-28**, titled "Open Out Wood Patio Door- L.M.I.", sheets 1 through 8 of 8, prepared, by AL-Farooq Corporation, dated 03/24/04 with revision "A" on 08/20/04, signed and sealed by Dr. Humayoun Farooq, P.E. bearing the Miami-Dade County Product Control Approval stamp with the Notice of Acceptance number and approval date by the Miami-Dade County Product Control Division.

MISSILE IMPACT RATING: Large and Small Missile Impact Resistant

LABELING: Each unit shall bear a permanent label with the manufacturer's name or logo, city, state (**Pinus PPHU, Skarbimierz-k/Brzegu, Poland or Vertaglia, Infissi, Santarcangelo di Romagna, Italy**) and following statement: "Miami-Dade County Product Control Approved", unless otherwise noted herein.

RENEWAL of this NOA shall be considered after a renewal application has been filed and there has been no change in the applicable building code negatively affecting the performance of this product.

TERMINATION of this NOA will occur after the expiration date or if there has been a revision or change in the materials, use, and/or manufacture of the product or process. Misuse of this NOA as an endorsement of any product, for sales, advertising or any other purposes shall automatically terminate this NOA. Failure to comply with any section of this NOA shall be cause for termination and removal of NOA.

ADVERTISEMENT: The NOA number preceded by the words Miami-Dade County, Florida, and followed by the expiration date may be displayed in advertising literature. If any portion of the NOA is displayed, then it shall be done in its entirety.

INSPECTION: A copy of this entire NOA shall be provided to the user by the manufacturer or its distributors and shall be available for inspection at the job site at the request of the Building Official.

This NOA consists of this page 1 and evidence pages E-1, as well as approval document mentioned above. The submitted documentation was reviewed by **Ishaq I. Chanda, P.E.**



**NOA No 04-0722.04
Expiration Date: October 28, 2009
Approval Date: October 28, 2004
Page 1**

10/6/04

Fenestra America, LLC

NOTICE OF ACCEPTANCE: EVIDENCE SUBMITTED

A. DRAWINGS

1. Manufacturer's die drawings and sections.
2. Drawing No. **W04-28**, titled "Open Out Wood Patio Door- L.M.I.", sheets 1 through 8 of 8, prepared, by AL-Farooq Corporation, dated 03/24/04 with revision "A" on 08/20/04, signed and sealed by Dr. Humayoun Farooq, P.E.

B. TESTS

1. Test reports on 1) Air Infiltration Test, per FBC, TAS 202-94
2) Uniform Static Air Pressure Test, Loading per FBC, TAS 202-94
3) Water Resistance Test, per FBC, TAS 202-94
4) Large Missile Impact Test per FBC, TAS 201-94
5) Cyclic Wind Pressure Loading per FBC, TAS 203-94
6) Forced Entry Test, per FBC 2411.3.2.1 (b) and TAS 202-94

Along with marked-up drawings and installation diagram of Outswing double wood glazed doors w/wo sidelites, prepared by Architectural Testing Inc., Test Report No. **01-47566.01** (ATI-03060), re-issued on 10-07-04, signed and sealed by Steven M. Urich, P.E. (The test report has been revised on 09-23-04 and 10-06-04 by addendum letters, issued by Architectural Testing lab, signed and sealed by Steven M. Urich, P.E.)

C. CALCULATIONS

1. Anchor Verification Calculations and structural analysis, prepared by Al-Farooq, dated 04/15/04, signed and sealed by Dr. Humayoun Farooq, P.E.

D. QUALITY ASSURANCE

1. Miami Dade Building Code Compliance Office (BCCO).

E. MATERIAL CERTIFICATIONS

1. Notice of Acceptance No. **01-0205.02**, issued to Solutia, Inc. for "Saflex/Keepsafe Maximum", expiring on 05/21/06.

F. STATEMENTS

1. Statement letter of conformance and "No financial interest" dated April 15, 2004, signed and sealed by Dr. Humayoun Farooq, P.E.
2. Laboratory compliance statement, as part of the above referenced test report.
3. Statement letter issued by Zeluck, Inc, clarifying distributor agreement and ownership of Fenestra America, LLC, signed by James M. Sztuk, V.P. Fenestra America and V.P. Zeluck, Hurricane Impact division.

G. OTHER

1. Letter of recommendation from consultant upon review of the product, stating that the product is in compliance with the Florida Building Code (FBC).
2. Test Proposal No. **02-0602**, approved by BCCO on 9-9-2003.
3. Distributor agreement between Fenestra America, LLC, signed by James M. Sztuk, V.P. Executive MGR, Fenestra America and Zeluck Inc., signed by James M. Sztuk, V.P. Zeluck, Hurricane Impact division.

Ishaq I. Chanda



Ishaq I. Chanda, P.E.

Product Control Examiner

NOA No 04-0722.04

Expiration Date: October 28, 2009

Approval Date: October 28, 2004

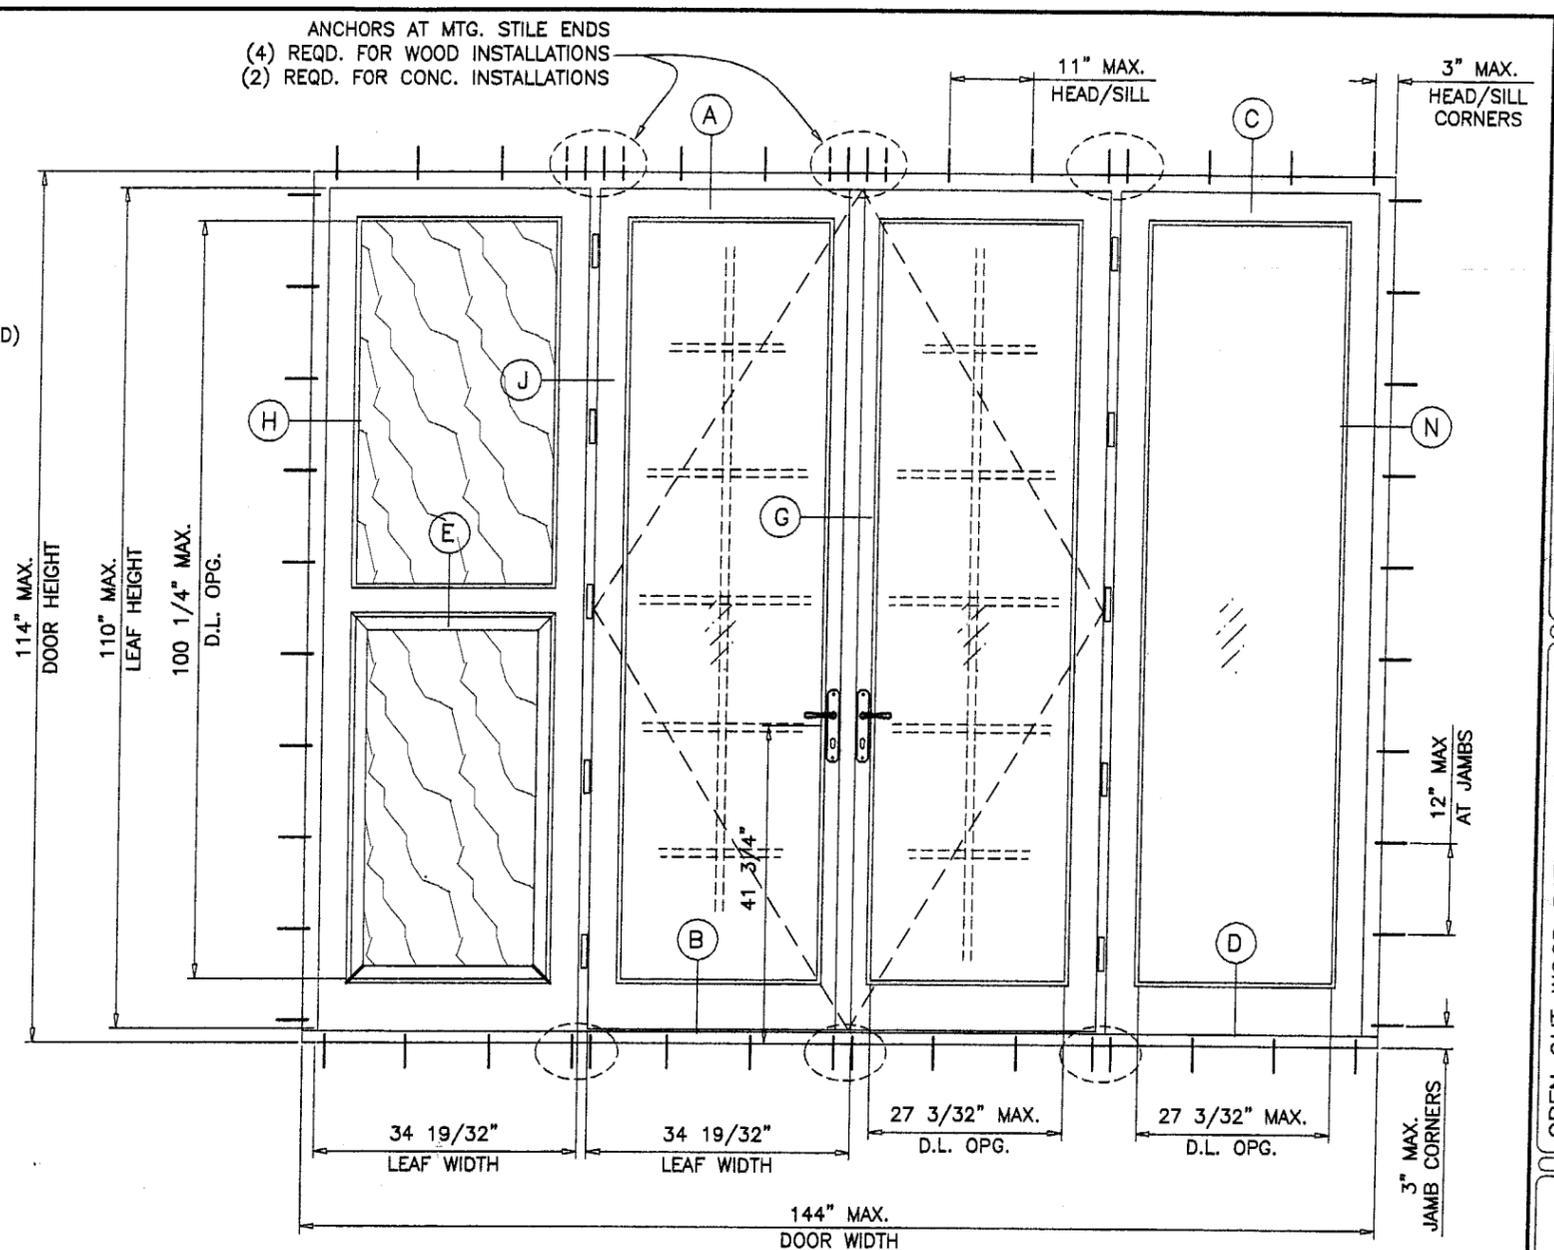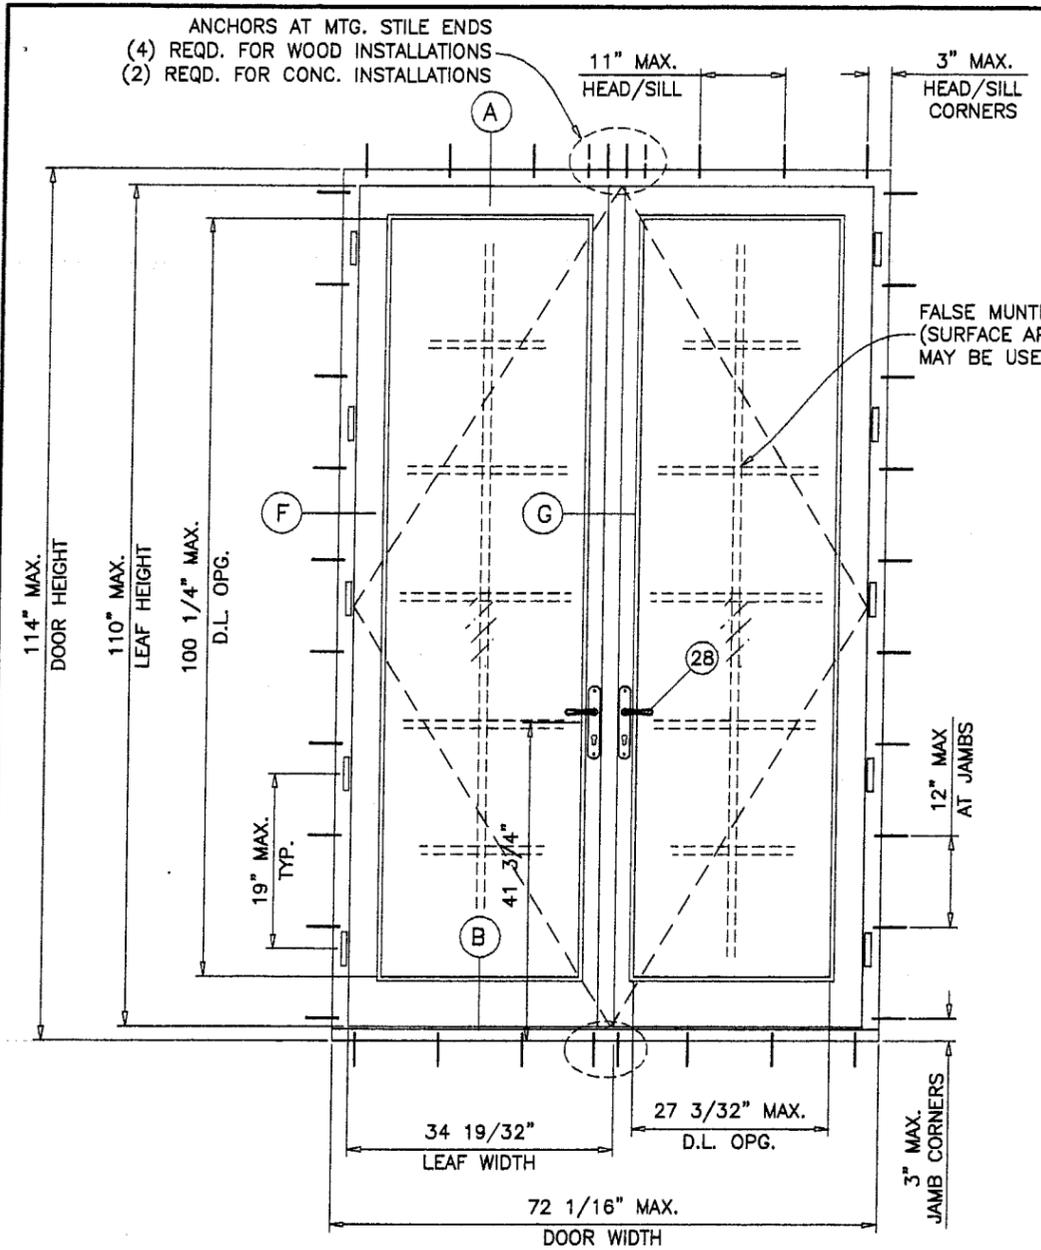

TYPICAL ELEVATIONS

TESTED UNITS

OPEN OUT WOOD PATIO DOOR

THESE PRODUCTS GLAZED WITH LAMINATED GLASS RATED FOR LARGE MISSILE IMPACT AND REQUIRE NO SHUTTERS.

APPROVAL APPLIES TO SINGLE (X) AND DOUBLE (XX) LEAF DOORS WITH OR WITHOUT TRANSOMS.

ALSO SINGLE (X) AND DOUBLE (XX) DOORS WITH SIDELITES, SIDE LITES CAN BE ON ONE OR BOTH SIDES OF DOOR.

THIS PRODUCT HAS BEEN DESIGNED AND TESTED TO COMPLY WITH THE REQUIREMENTS OF THE FLORIDA BUILDING CODE INCLUDING HIGH VELOCITY HURRICANE ZONE.

WOOD BUCKS BY OTHERS, MUST BE ANCHORED PROPERLY TO TRANSFER LOADS TO THE STRUCTURE.

ANCHORS SHALL BE AS LISTED, SPACED AS SHOWN ON DETAILS. ANCHOR EMBEDMENT TO BASE MATERIAL SHALL BE BEYOND WALL DRESSING OR STUCCO.

ANCHORING OR LOADING CONDITIONS NOT SHOWN IN THESE DETAILS ARE NOT PART OF THIS APPROVAL.


A 33% INCREASE IN ALLOWABLE STRESS WAS USED IN DESIGN OF ANCHORS.

**MAXIMUM DESIGN LOAD RATING = + 60.0 PSF
(FOR SIZES SHOWN OR SMALLER) - 65.0 PSF**

Approved as complying with the Florida Building Code
Date **OCTOBER 28, 2004**
NOA# **04-0722-04**
Miami Dade Product Control Division
By **Shag I. Chanda**

Engr: DR. HUMAYOUN FAROOQ
STRUCTURES
FLA. PE # 16557
C.A.N. 3538

[Signature]
AUG 30 2004

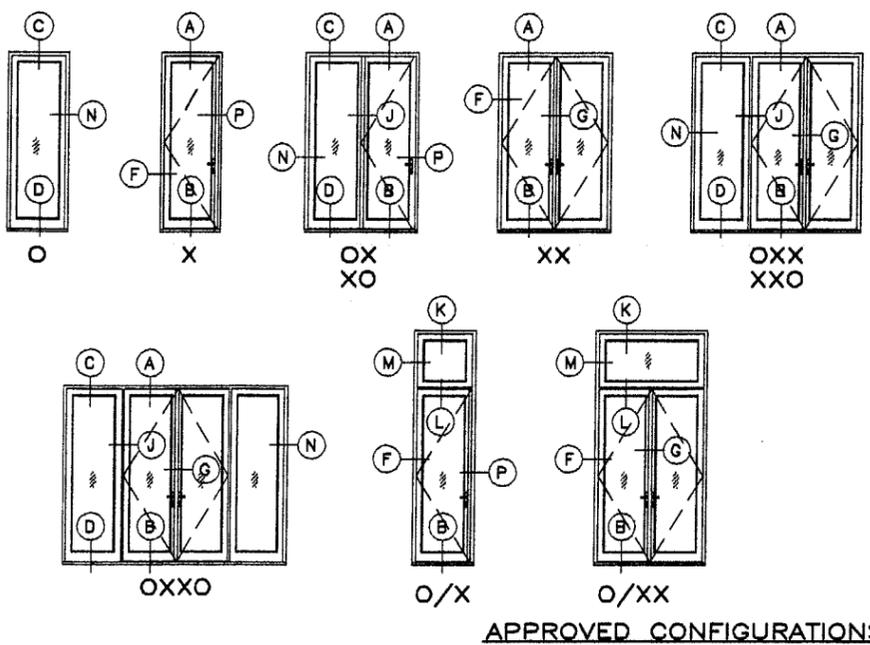

APPROVED CONFIGURATIONS


AL-FAROOQ CORPORATION
ENGINEERS, PLANNERS & PRODUCT DESIGN
1235 SW 87 AVE
MIAMI, FLORIDA 33174
TEL. (305) 264-8100 FAX. (305) 262-6978
COMP-ANL\W04-28FA

FENESTRA-AMERICA
25 PRESTON COURT
BROOKLYN, NY 11234
TEL (718) 251-7387 FAX. (718) 531-2564

no.	date	description	REV. PER	COMMENTS
A	08.20.04			

date: 03-24-04
scale: 1/2"=1'-0"
dr. by: HAMID
chk. by:

drawing no.
W04-28
sheet 1 of 8

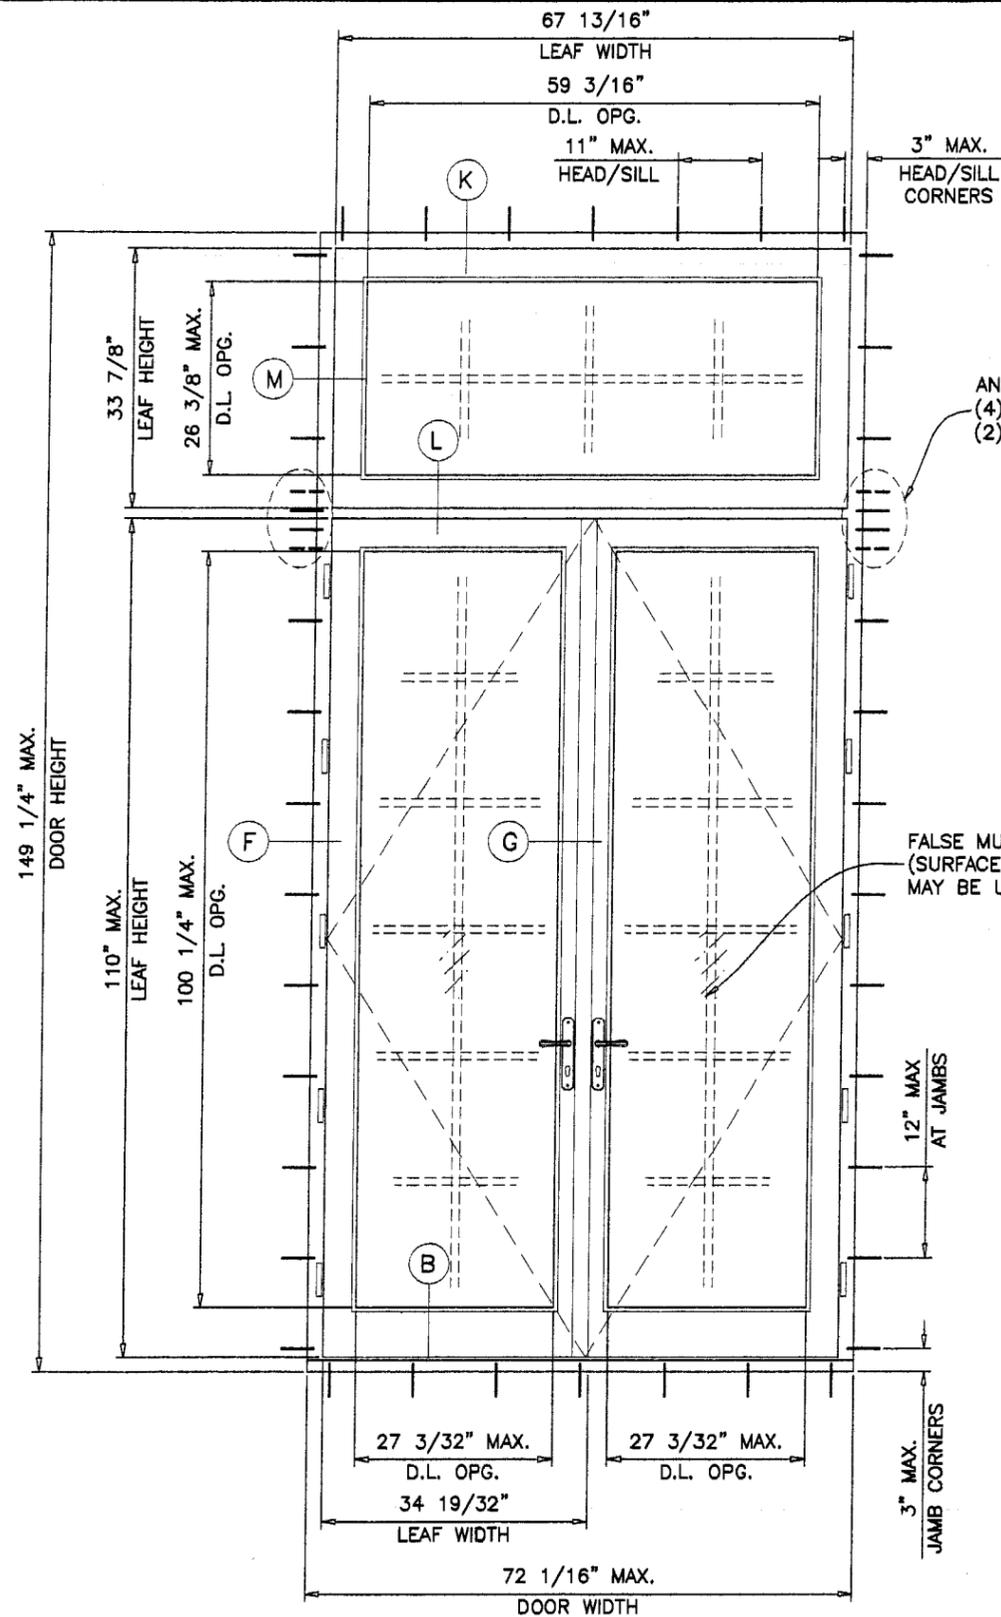


TYPICAL ELEVATION
TESTED UNIT


MAXIMUM DESIGN LOAD RATING = + 60.0 PSF
(FOR SIZES SHOWN OR SMALLER) - 65.0 PSF

ANCHORS AT MTG. STILE ENDS
(4) REQD. FOR WOOD INSTALLATIONS
(2) REQD. FOR CONC. INSTALLATIONS

FALSE MUNTINS
(SURFACE APPLIED)
MAY BE USED

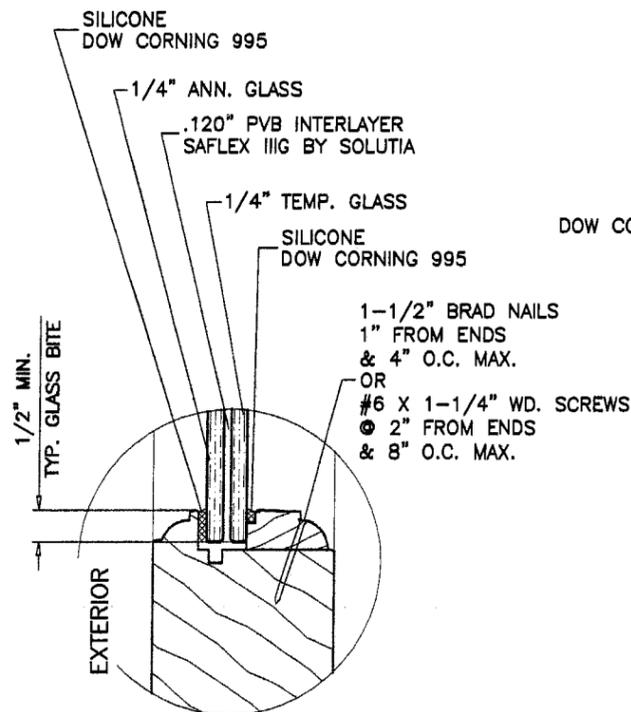

GLAZING OPTIONS

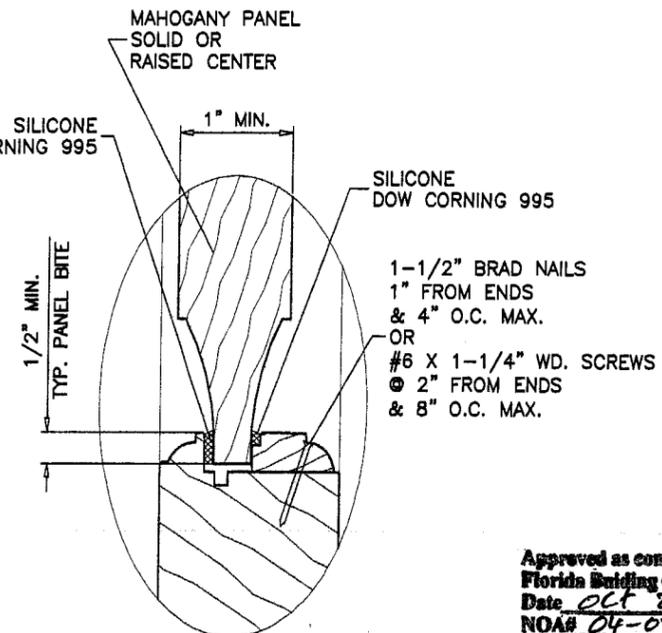

TYPICAL ANCHORS:

- A- **1/4" TAPCONS**
INTO 2BY WOOD BUCKS OR WOOD STRUCTURE
1-1/4" MIN. PENETRATION INTO WOOD

THRU 1BY WOOD BUCKS INTO MASONRY OR DIRECTLY INTO MASONRY
1-1/2" MIN. EMBED INTO CONC. AT SILL
1-1/4" MIN. EMBED INTO MASONRY AT HEAD AND JAMBS
- B- **#14 SMS**
INTO 2BY WOOD BUCKS OR WOOD STRUCTURE
1-1/2" MIN. PENETRATION INTO WOOD

TYPICAL EDGE DISTANCE

INTO CONCRETE AND MASONRY = 3" MIN.
INTO WOOD STRUCTURE = 3/4" MIN.

SEALANTS:

INTERIOR AND ENDS OF THRESHOLD AND INTERIOR AND EXTERIOR OF GLAZING SEALED WITH SILICONE.

LOCKS:

5 POINT LOCKING SYSTEM WITH SHOOT BOLTS LOCATED AT TOP AND BOTTOM OF ACTIVE/INACTIVE LEAF.
LOCKING MECHANISM ATTACHED TO LOCK STILE WITH (15) #8 X 2" SCREWS.

Engr: DR. HUMAYOUN FAROOQ
STRUCTURES
FLA. PE # 18557
C.A.N. 3538

AUG 30 2004

Approved as complying with the
Florida Building Code
Date Oct 28, 2004
NOA# 04-0722-04
Miami Dade Product Control
Division
By Shaq I. Chaudhry

AL-FAROOQ CORPORATION
ENGINEERS, PLANNERS & PRODUCT DESIGN
1235 SW 87 AVE
MIAMI, FLORIDA 33174
TEL. (305) 264-8100 FAX. (305) 262-6978

OPEN OUT WOOD PATIO DOOR (L.M.I.)
FENESTRA-AMERICA
25 PRESTON COURT
BROOKLYN, NY 11234
TEL. (718) 251-7387 FAX. (718) 531-2564

no	date	description	by
A	08.20.04	REV. PER BCCO COMMENTS	

date: 03-24-04
scale: 1/2"=1'-0"
dr. by: HAMID
chk. by:


drawing no.
W04-28

sheet 2 of 8


af

COMP-ANL\W04-28FA


WOOD BUCKS NOT BY FENESTRA-AMERICA, MUST SUSTAIN LOADS IMPOSED BY GLAZING SYSTEM AND TRANSFER THEM TO THE BUILDING STRUCTURE.

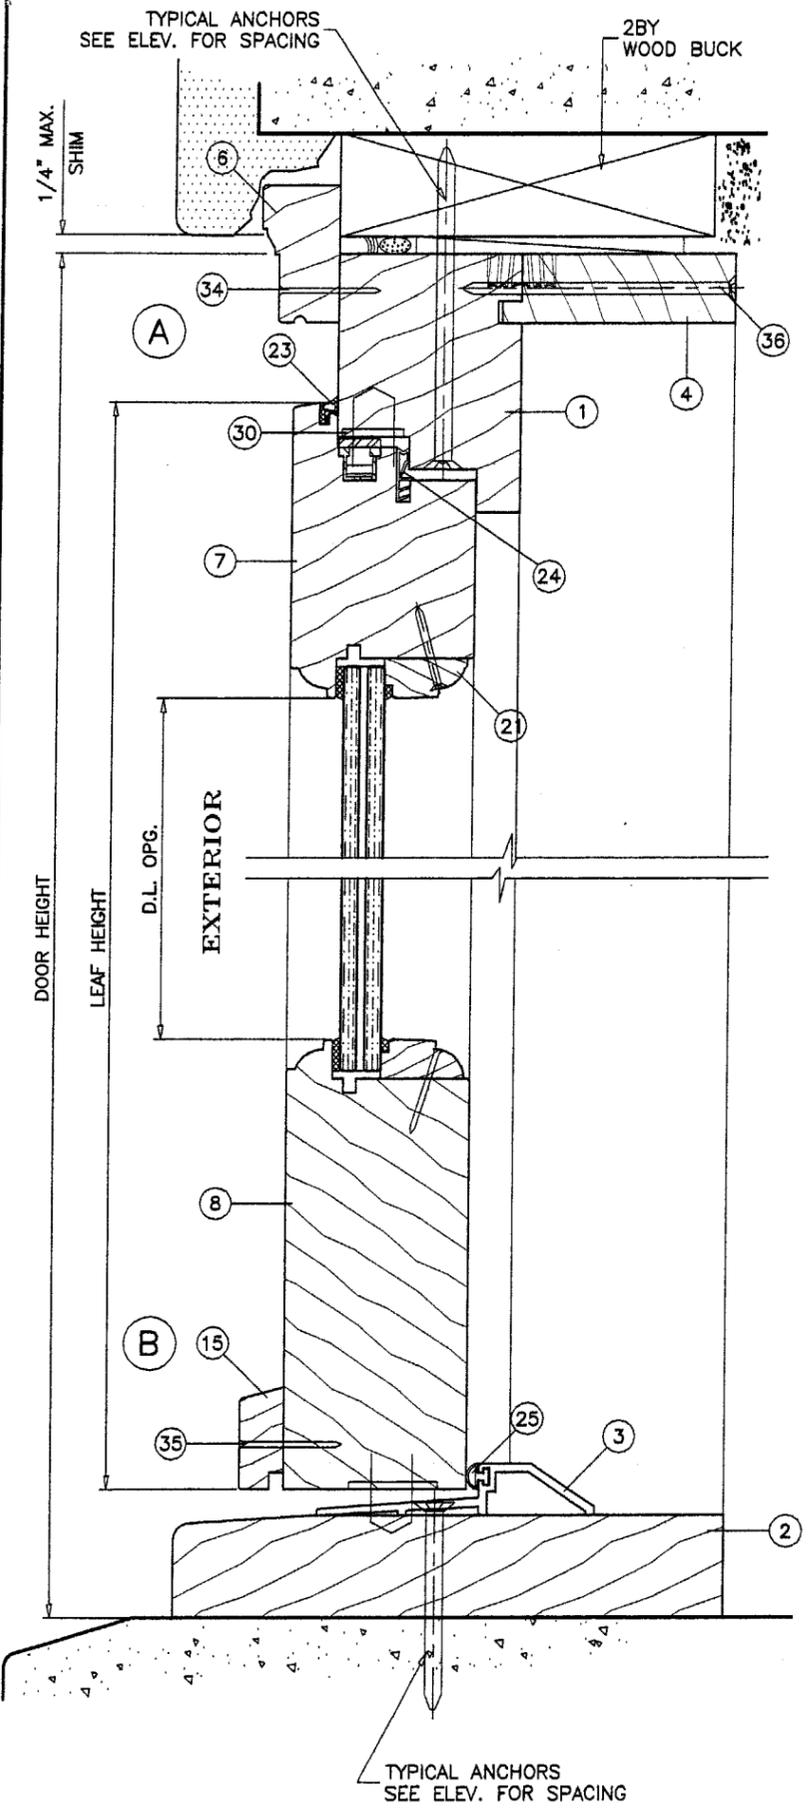

ACTIVE UNITS

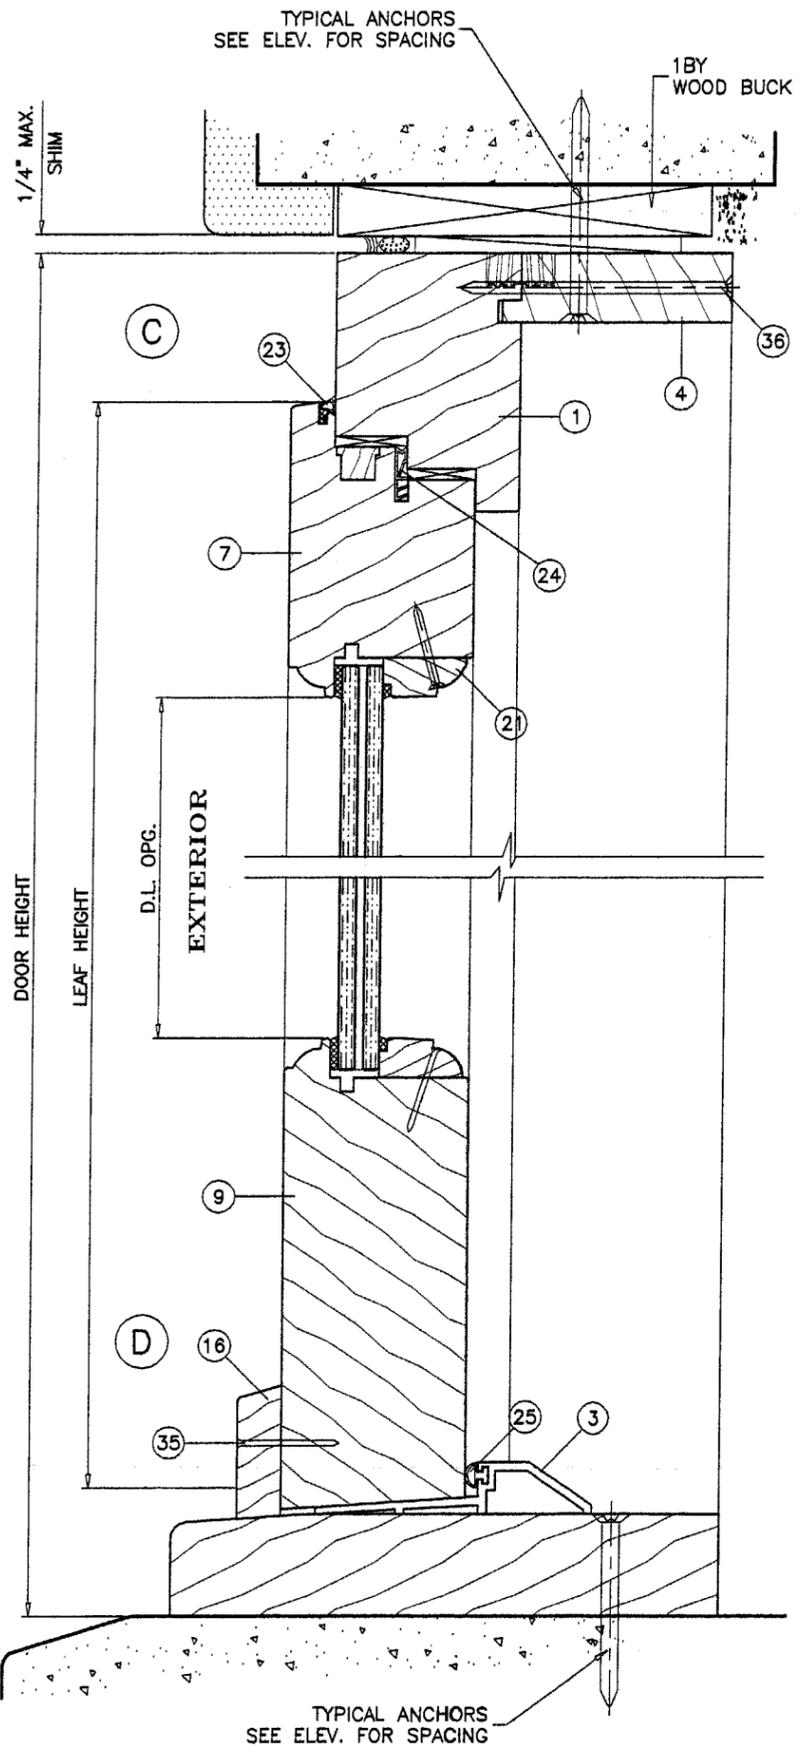

STATIONARY UNITS

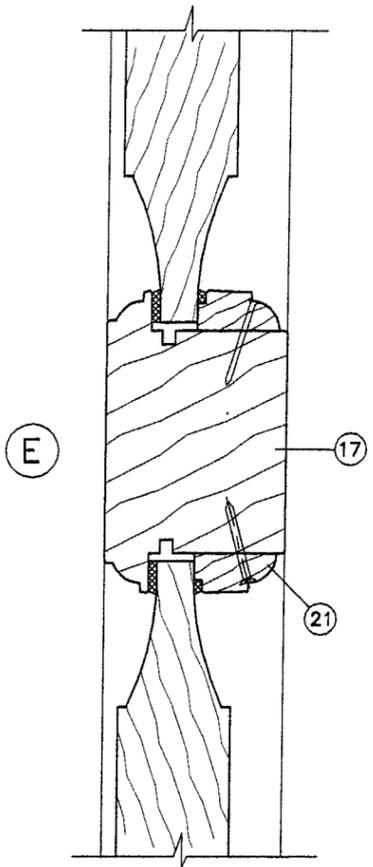

Approved as complying with the Florida Building Code
 Date Oct 28, 2004
 NOA# 04-0722-04
 Miami Dade Product Control Division
 By Greg J. Claude

Engr: DR. HUMAYOUN FAROOQ
 STRUCTURES
 FLA. PE # 16557
 C.A.N. 3538
 AUG 30 2004

AL-FAROOQ CORPORATION
 ENGINEERS, PLANNERS & PRODUCT DESIGN
 1235 SW 87 AVE
 MIAMI, FLORIDA 33174
 TEL. (305) 264-8100 FAX. (305) 262-6978

OPEN OUT WOOD PATIO DOOR (L.M.I.)
FENESTRA-AMERICA
 25 PRESTON COURT
 BROOKLYN, NY 11234
 TEL. (718) 251-7387 FAX. (718) 531-2564

no	date	description	by
A	08.20.04	REV. PER BCCO COMMENTS	

date: 03-24-04
 scale: 3/8" = 1"
 dr. by: HAMID
 chk. by:

drawing no.
W04-28

sheet 3 of 8


COMP-ANL/W04-28FA

no	date	by	description
A	08.20.04		REV. PER BCCO COMMENTS

date:	03-24-04
scale:	3/8" = 1"
dr. by:	HAMID
chk. by:	


TYPICAL ANCHORS
 SEE ELEV. FOR SPACING

18Y
 WOOD BUCK
 TYPICAL ANCHORS
 SEE ELEV. FOR SPACING

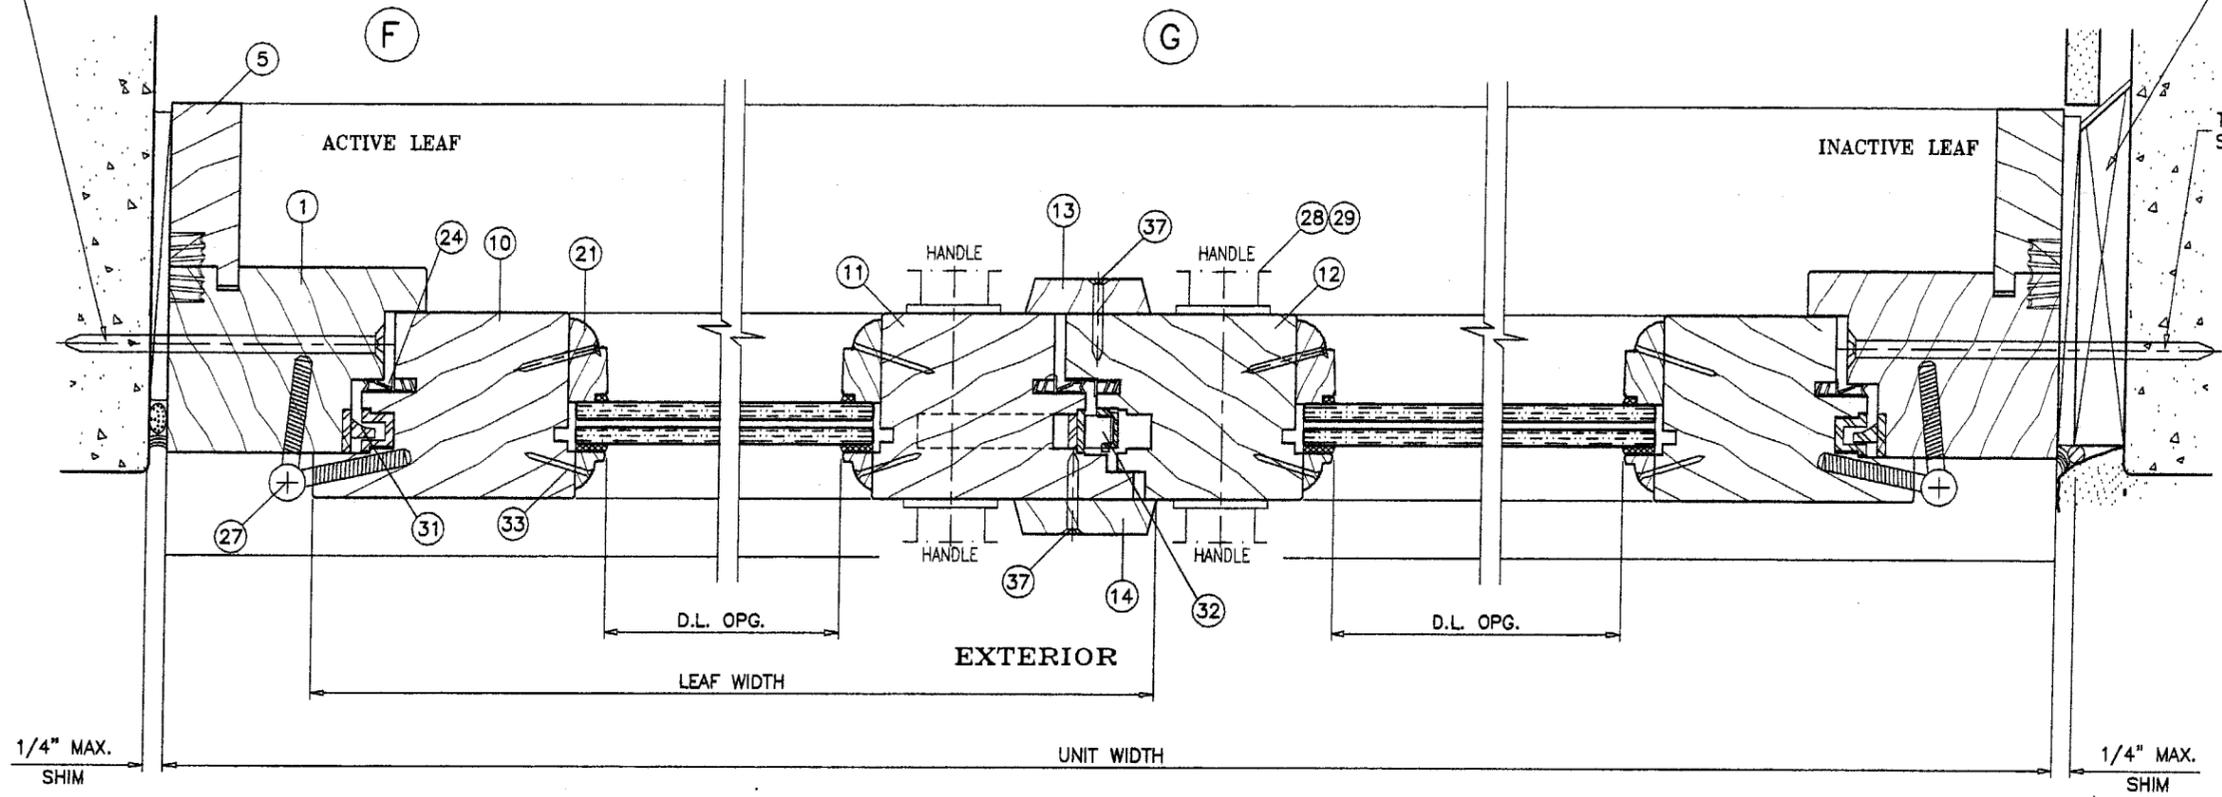


TYPICAL ANCHORS
 SEE ELEV. FOR SPACING

Approved as complying with the
 Florida Building Code
 Date Oct 28, 2004
 NOA# 04-0722-04
 Miami Dade Product Control
 Division
 By Isaac I. Chauda

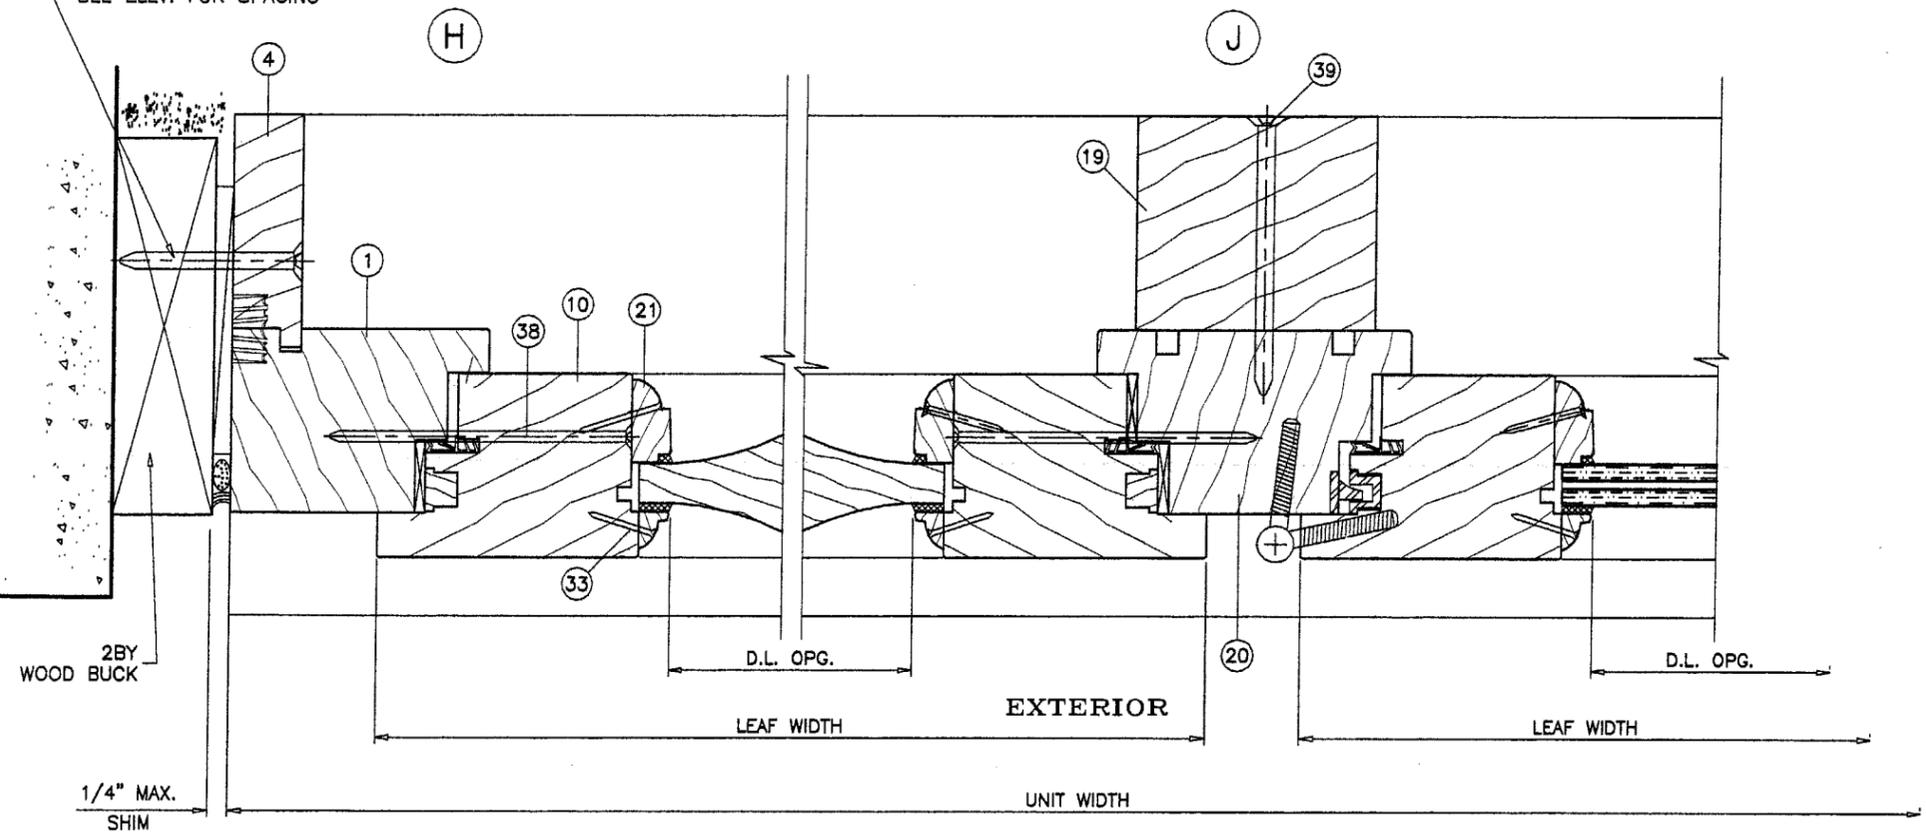



Engr: DR. HUMAYOON FAROOQ
 STRUCTURES
 FLA. PE # 16537
 C.A.N. 3538
 AUG 30 2004

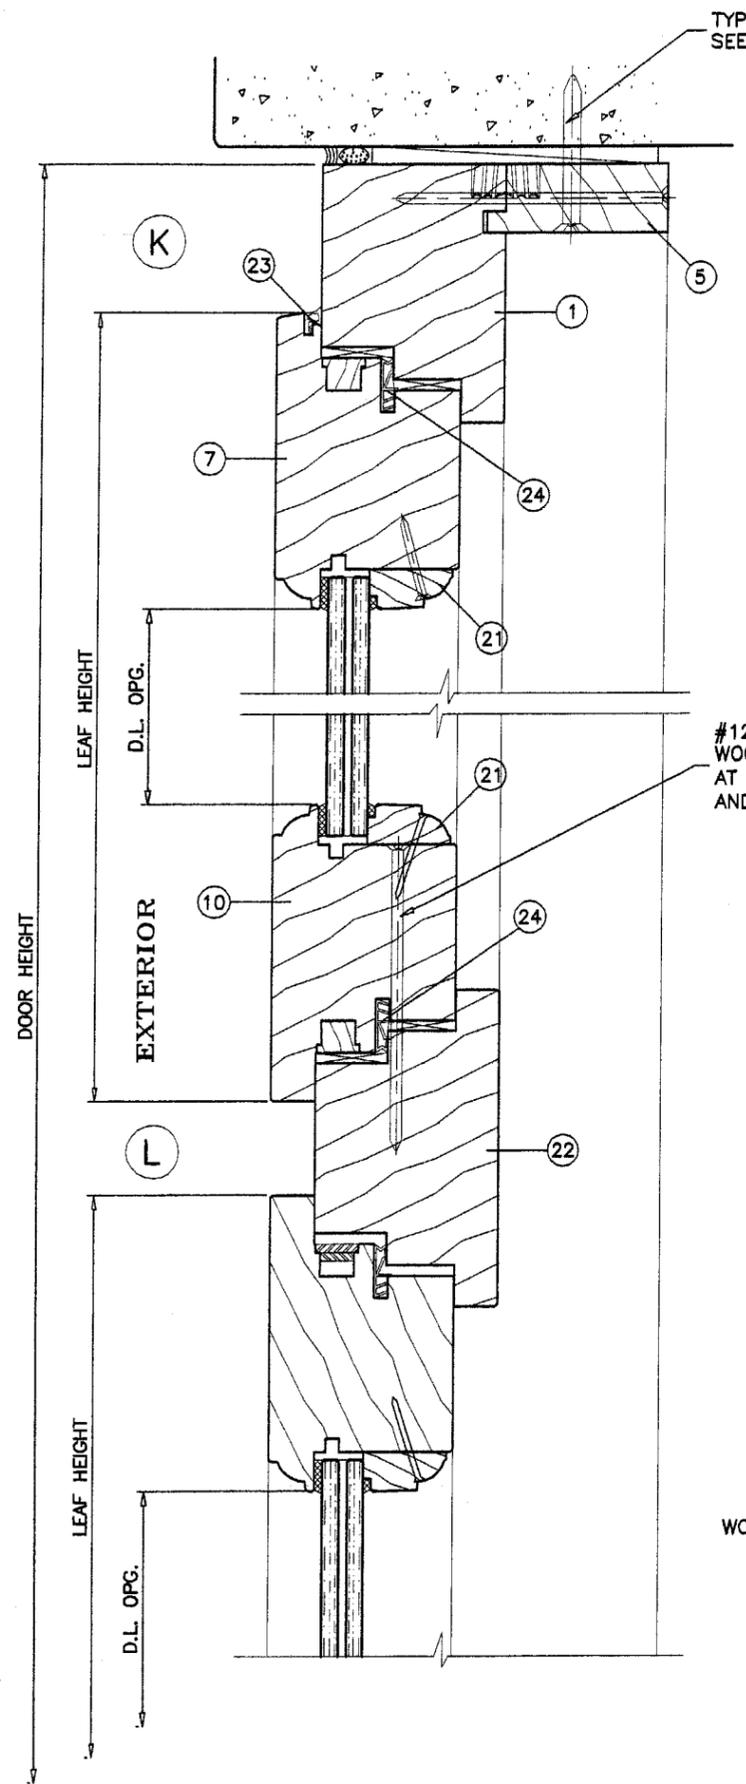


TYPICAL ANCHORS
SEE ELEV. FOR SPACING

#12 X 4-1/2"
WOOD SCREWS
AT 7" FROM ENDS
AND 17" O.C. MAX.

TYPICAL ANCHORS
SEE ELEV. FOR SPACING

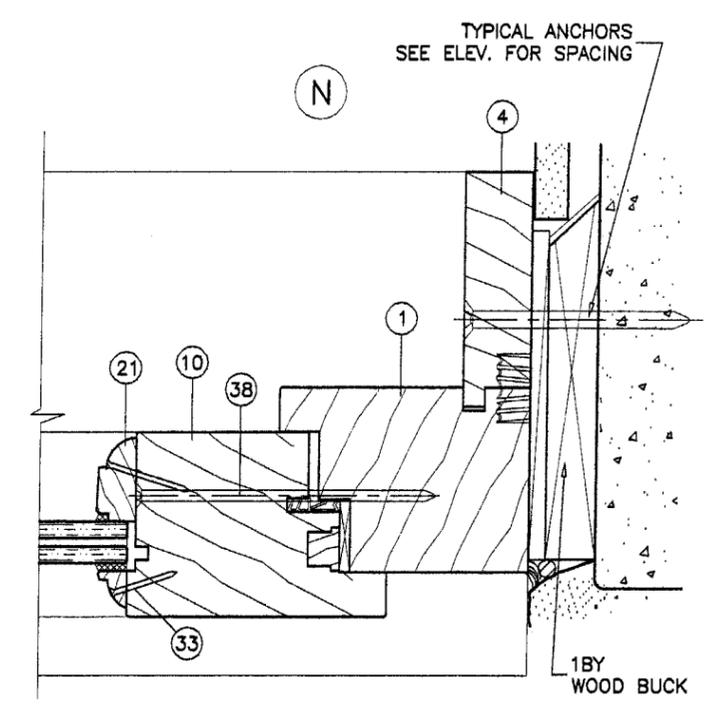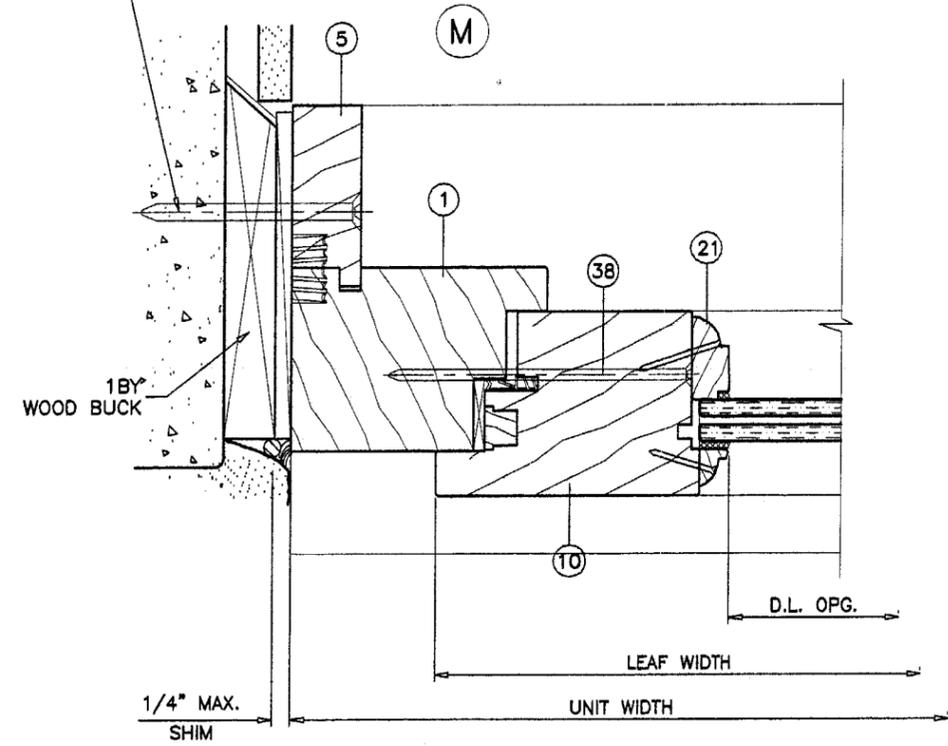

TYPICAL ANCHORS
SEE ELEV. FOR SPACING

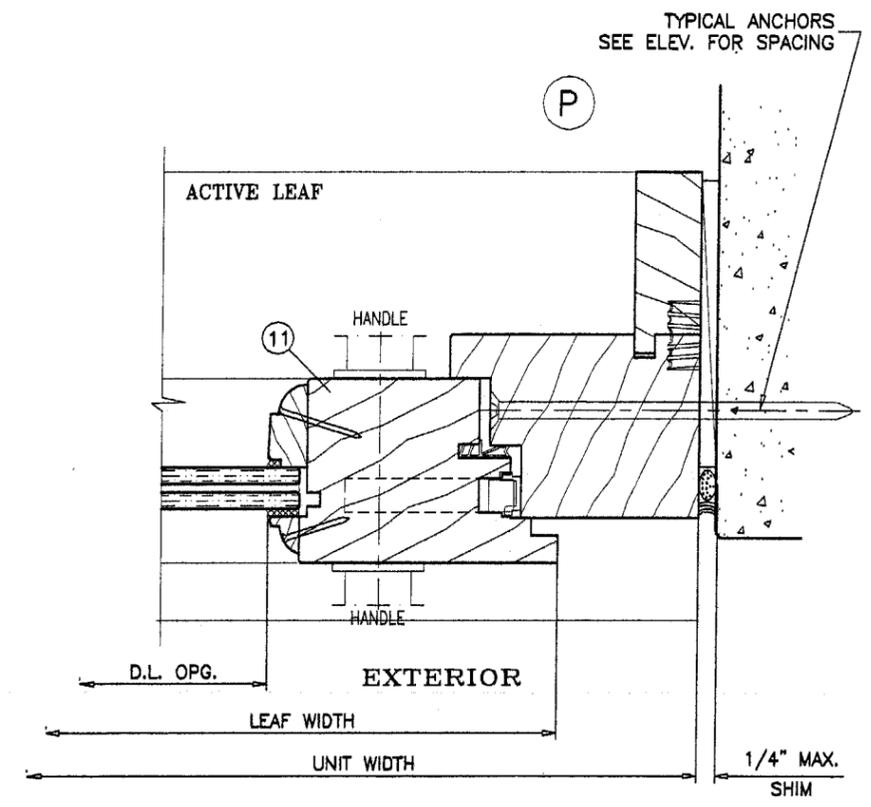

TYPICAL ANCHORS
SEE ELEV. FOR SPACING

Engr: DR. HUMAYOON FAROOQ
STRUCTURES
FLA. PE # 18657
C.A.N. 3538

AUG 30 2004

Approved as complying with
Florida Building Code
Date Oct 29, 2004
NOA# 04-0722-04
Miami Dade Product Control
Division
By Isaac I. Clouds

AL-FAROOQ CORPORATION
ENGINEERS, PLANNERS & PRODUCT DESIGN
1235 SW 87 AVE
MIAMI, FLORIDA 33174
TEL. (305) 264-8100 FAX. (305) 262-6978

FENESTRA-AMERICA
25 PRESTON COURT
BROOKLYN, NY 11234
TEL. (718) 251-7387 FAX. (718) 531-2564

OPEN OUT WOOD PATIO DOOR (L.M.I.)

no.	date	by	description	REV. PER	BCCO COMMENTS
A	08.20.04				


date: 03-24-04
scale: 3/8" = 1"
dr. by: HAMID
chk. by:

drawing no.
W04-28


sheet 5 of 8

afjc


COMP-ANL\W04-28FA

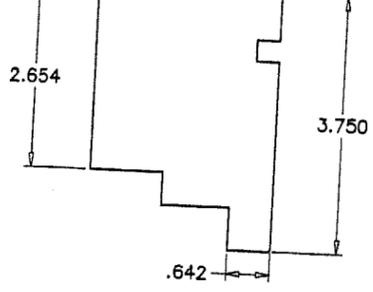


FRAME HEAD/JAMB

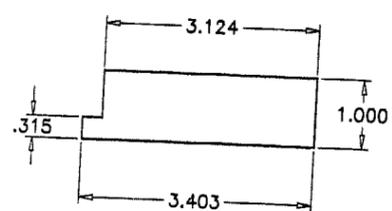


INTERIOR STOP DOOR HEAD

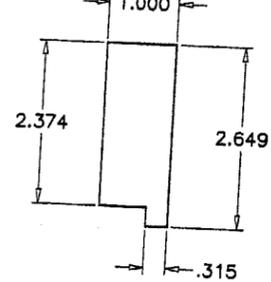


INTERIOR STOP JAMB/TRANSOM

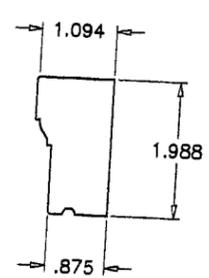


BRICK MOULDING (OPTIONAL)

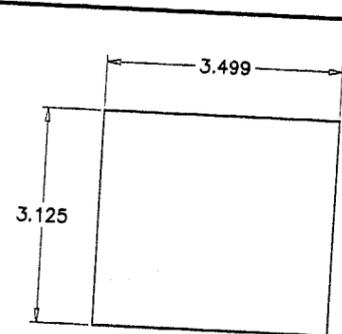


MULLION INTERIOR COVER

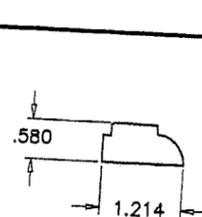


INTERIOR GLAZING STOP

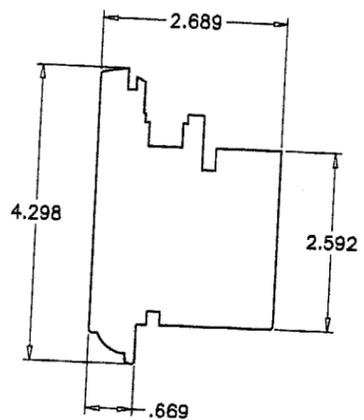


TOP RAIL

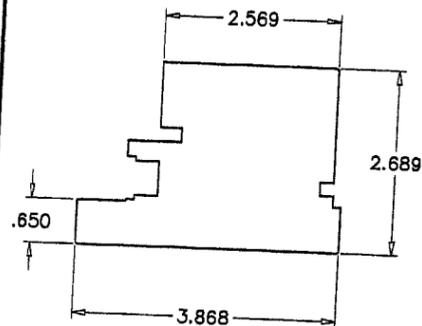


JAMB STILE/TRANSOM BOT. RAIL

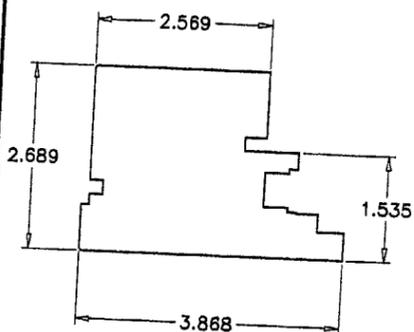


ACTIVE LEAF LOCK STILE

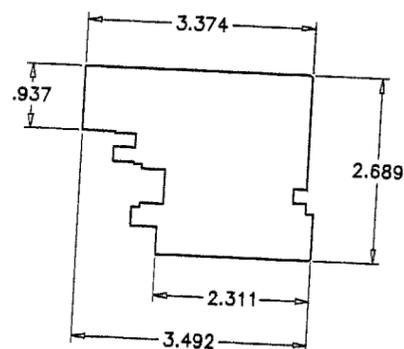


INACTIVE LEAF LOCK STILE

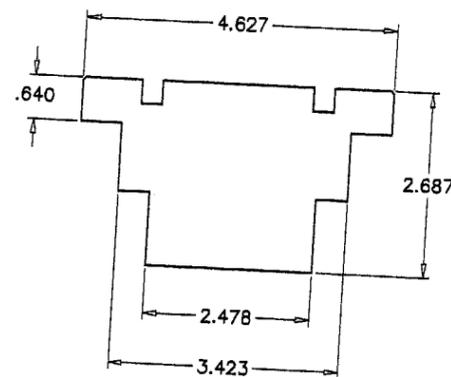


MULLION

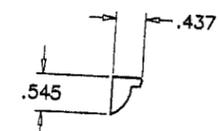


EXTERIOR GLAZING STOP

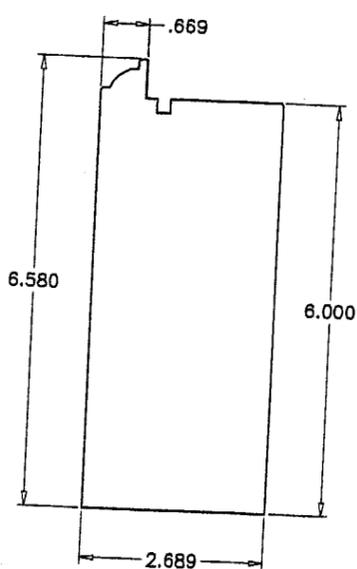


BOTTOM RAIL (OPERATING)

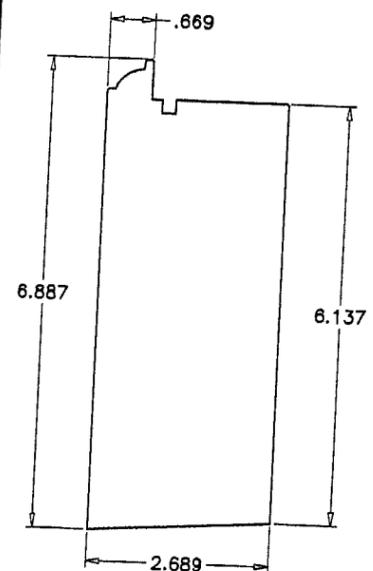


BOTTOM RAIL (FIXED)

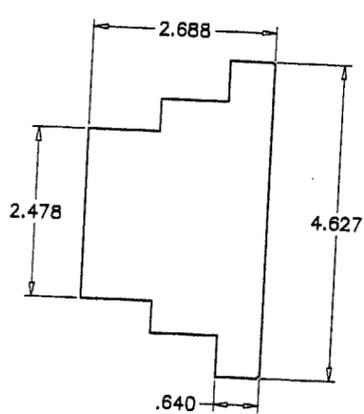


TRANSOM

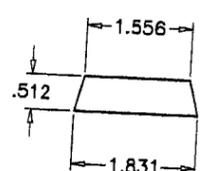


ASTRAGAL INTERIOR

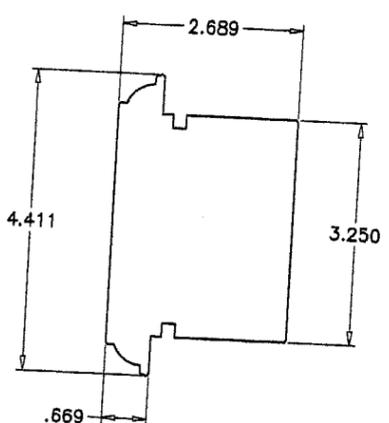


IMPOST

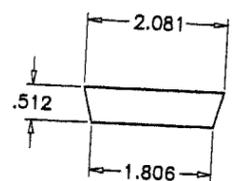


ASTRAGAL EXTERIOR

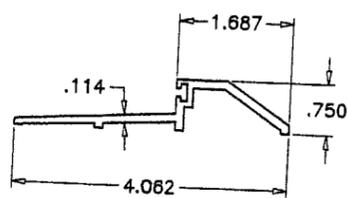


THRESHOLD

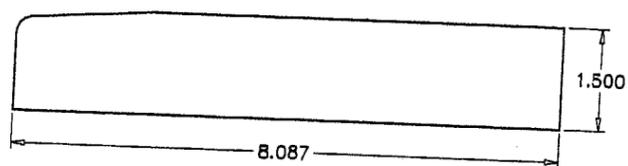

FRAME SILL

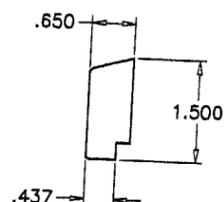

DOOR SWEEP (OPERATING)

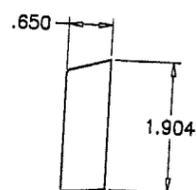

DOOR SWEEP (FIXED)

Engr: DR. HUMAYOUN FAROOQ,
STRUCTURES
FLA. PE # 16557
C.A.N. 3538

[Signature]

AUG 30 2004

Approved as complying with the
Florida Building Code
Date Oct 28, 2004
NOA# 04-0722-04
Miami Beach Product Control
Division
By Ishtaq I. Chauda

no	date	description	NO CHANGE THIS SHEET
A	08.20.04		

date: 03-24-04
scale: 3/8" = 1"
dr. by: HAMID
chk. by:

drawing no.
W04-28
sheet 6 of 8

AL-FAROOQ CORPORATION
ENGINEERS, PLANNERS & PRODUCT DESIGN
1235 SW 87 AVE
MIAMI, FLORIDA 33174
TEL. (305) 264-8100 FAX. (305) 262-6978

OPEN OUT WOOD PATIO DOOR (L.M.I.)
FENESTRA-AMERICA
25 PRESTON COURT
BROOKLYN, NY 11234
TEL. (718) 251-7387 FAX. (718) 531-2564

afc

COMP-ANI\W04-28FA

ITEM #	NUMBER	REQD.	DESCRIPTION	MATERIAL	MANF./SUPPLIER/REMARKS
1	-	3	FRAME HEAD/FRAME JAMB	WOOD	FENESTRA-AMERICA
2	-	1	FRAME SILL	WOOD	FENESTRA-AMERICA
3	Z-0-0	1	THRESHOLD	BRASS	FENESTRA-AMERICA
4	-	1	INTERIOR STOP DOOR HEAD	WOOD	FENESTRA-AMERICA
5	-	2	INTERIOR STOP JAMB/TRANSOM	WOOD	FENESTRA-AMERICA
6	-	AS REQD.	BRICK MOULDING (OPTIONAL)	WOOD	FENESTRA-AMERICA
7	-	1/ LEAF	LEAF TOP RAIL	WOOD	FENESTRA-AMERICA
8	-	1/ OPR. LEAF	LEAF BOTTOM RAIL (OPERATING)	WOOD	FENESTRA-AMERICA
9	-	1/ FIX. LEAF	LEAF BOTTOM RAIL (FIXED)	WOOD	FENESTRA-AMERICA
10	-	AS REQD.	LEAF JAMB STILE/TRANSOM BOTTOM RAIL	WOOD	FENESTRA-AMERICA
11	-	1/ LEAF	ACTIVE LEAF LOCK STILE	WOOD	FENESTRA-AMERICA
12	-	1/ LEAF	INACTIVE LEAF LOCK STILE	WOOD	FENESTRA-AMERICA
13	-	1	ASTRAGAL INTERIOR	WOOD	FENESTRA-AMERICA
14	-	1	ASTRAGAL EXTERIOR	WOOD	FENESTRA-AMERICA
15	-	1	DOOR SWEEP (OPERATING)	WOOD	FENESTRA-AMERICA
16	-	1	DOOR SWEEP (FIXED)	WOOD	FENESTRA-AMERICA
17	-	AS REQD.	IMPOST	WOOD	FENESTRA-AMERICA
19	-	AS REQD.	MULLION INTERIOR COVER	WOOD	FENESTRA-AMERICA
20	-	AS REQD.	MULLION	WOOD	FENESTRA-AMERICA
21	-	AS REQD.	INTERIOR GLAZING STOP	WOOD	FENESTRA-AMERICA
21A	-	AS REQD.	EXTERIOR GLAZING STOP	WOOD	FENESTRA-AMERICA
22	-	AS REQD.	TRANSOM	WOOD	FENESTRA-AMERICA
23	DX125	-	EXTERIOR FOAM FILLED W'STRIPPING	VINYL	DEVENTER
24	DX1362	-	INTERIOR FLAT W'STRIPPING	VINYL	DEVENTER
25	-	1	THRESHOLD BULB W'STRIPPING	VINYL	-
26	-	-	-	-	-
27	E0165.16.01	AS REQD.	ADJUSTABLE HINGES	ST. STEEL	AGB, AT 19" O.C. MAX.
28	SIRIUS1290	1/ LEAF	DOOR HANDLE	BRASS	ENTRA
29	1413/00005	1/ LEAF	EUROPEAN PROFILE CYLINDER KEY/KNOB	-	VILKA
30	BSK1685	1	SHOOT BOLT RECIEVER	BRONZE	-
31	872833/886175	5/ LEAF	SNUBBER	-	-
32	-	1/ LEAF	5 POINT LOCKING SYSTEM	-	-
33	-	AS REQD.	1" BRAD NAILS	-	⊙ 1" FROM ENDS & 4" O.C. MAX.
34	-	AS REQD.	1-1/2" BRAD NAILS	-	⊙ 2" FROM ENDS & 19" O.C. MAX.
35	-	AS REQD.	1-1/2" BRAD NAILS	-	⊙ 2" FROM ENDS & 5" O.C. MAX.
36	#10 X 4"	AS REQD.	WOOD SCREWS	-	(1) AT EACH END
37	#8 X 1-1/2"	AS REQD.	WOOD SCREWS	-	⊙ 2" FROM ENDS & 10" O.C. MAX.
38	#12 X 4-1/2"	AS REQD.	WOOD SCREWS	-	⊙ 4" FROM ENDS & 24" O.C. MAX.
39	#10 X 4"	AS REQD.	WOOD SCREWS	-	⊙ 9" FROM ENDS & 19" O.C. MAX.

TYPICAL WOOD-HONDURES MAHOGANY LUMBER

Approved as complying with the
Florida Building Code
Date Oct 28, 2004
NOA# 04-0722-04
Miami Dade Product Control
Division
By Ishaq I. Chauda

Engr: DR. HUMAYOUN FAROOQ
STRUCTURES
FLA. PE # 16557
C.A.N. 3538

AUG 30 2004



afc
AL-FAROOQ CORPORATION
ENGINEERS, PLANNERS & PRODUCT DESIGN
1235 SW 87 AVE
MIAMI, FLORIDA 33174
TEL. (305) 264-8100 FAX. (305) 262-6978
COMP-ANL\W04-28FA

OPEN OUT WOOD PATIO DOOR (L.M.I.)
FENESTRA-AMERICA
25 PRESTON COURT
BROOKLYN, NY 11234
TEL (718) 251-7387 FAX. (718) 531-2564



revisions:	no.	date	by	description
A	08.20.04			NO CHANGE THIS SHEET

date: 03-24-04
scale: 3/8" = 1"
dr. by: HAMID
chk. by:

drawing no.
W04-28
sheet 7 of 8

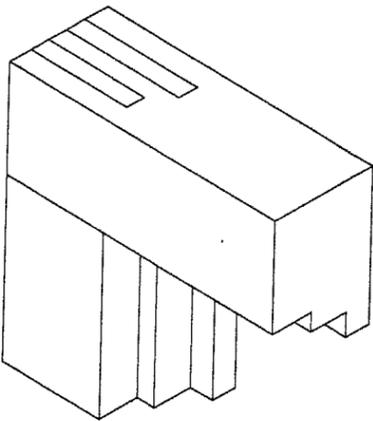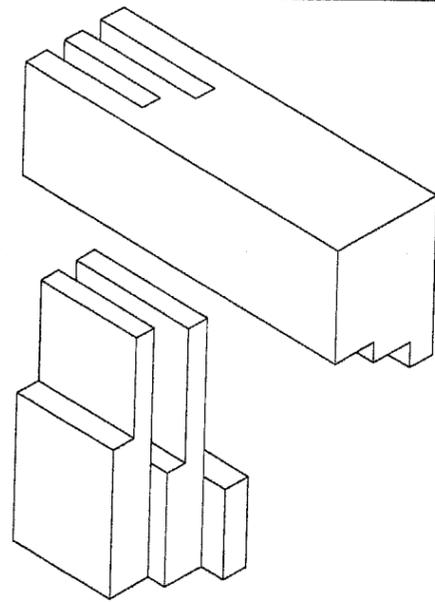


FRAME TOP CORNER

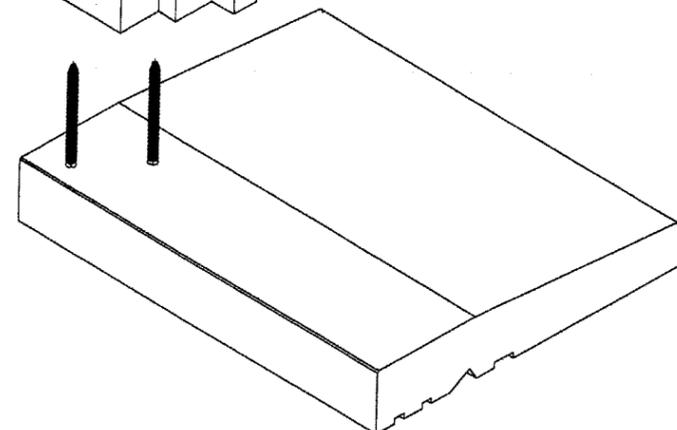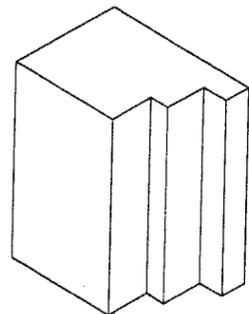


FRAME BOTTOM CORNER

FRAME/PANEL CORNERS & DOWELS SEALED/GLUED WITH 'PHENYL RESORCINOL' WATER PROOF ADHESIVE

#12 X 4-1/2"
WOOD SCREWS

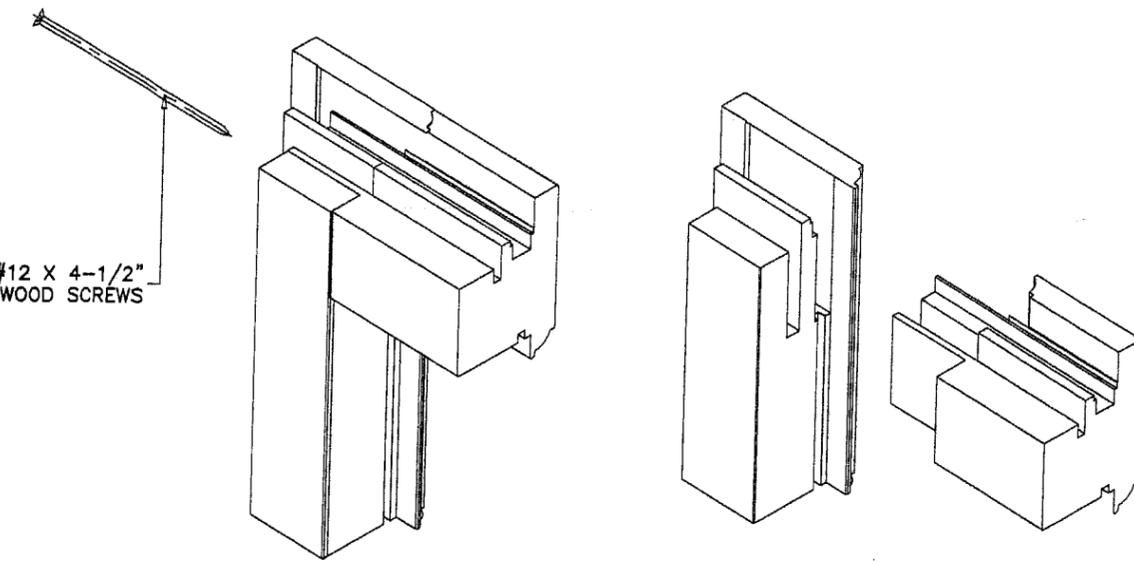

LEAF TOP CORNER

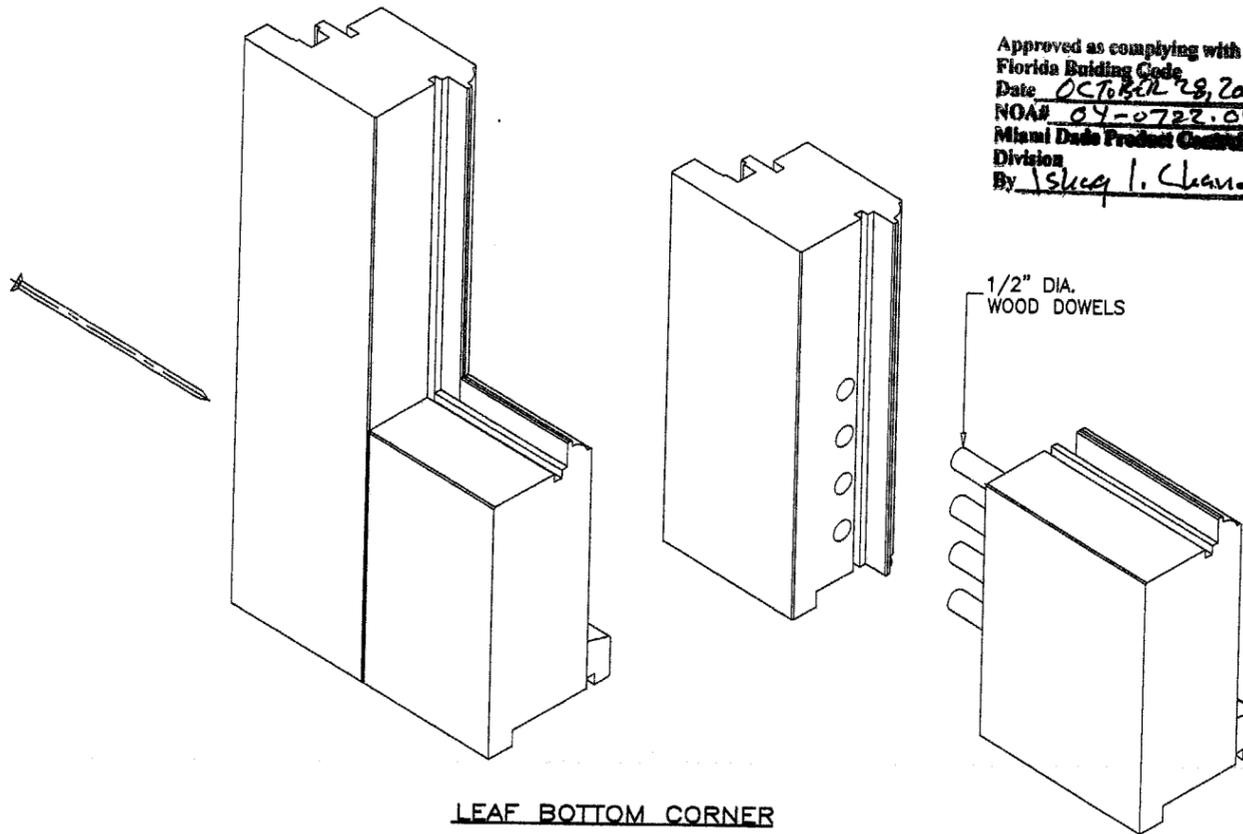

LEAF BOTTOM CORNER

Approved as complying with the
Florida Building Code
Date OCTOBER 29, 2004
NOA# 04-0722.04
Miami Dade Product Control
Division
By Shrey I. Chandra

1/2" DIA.
WOOD DOWELS

Engr: DR. HUMAYOUN FAROOQ
STRUCTURES
FLA. PE # 16557
C.A.N. 3538

[Signature]
AUG 30 2004

afc

AL-FAROOQ CORPORATION
ENGINEERS, PLANNERS & PRODUCT DESIGN
1235 SW 87 AVE
MIAMI, FLORIDA 33174
TEL. (305) 264-8100 FAX. (305) 262-6978

OPEN OUT WOOD PATIO DOOR (L.M.I.)
FENESTRA-AMERICA
25 PRESTON COURT
BROOKLYN, NY 11234
TEL. (718) 251-7387 FAX. (718) 531-2564

no	date	description
A	08.20.04	NO CHANGE THIS SHEET

date: 03-24-04
scale: 3/8" = 1"
dr. by: HAMID
chk. by:

drawing no.
W04-28

sheet 8 of 8

COMP-ANL\W04-28FA