

MIAMI-DADE COUNTY
BUILDING CODE COMPLIANCE OFFICE (BCCO)
PRODUCT CONTROL DIVISION

MIAMI-DADE COUNTY, FLORIDA
METRO-DADE FLAGLER BUILDING
140 WEST FLAGLER STREET, SUITE 1603
MIAMI, FLORIDA 33130-1563
(305) 375-2901 FAX (305) 375-2908

NOTICE OF ACCEPTANCE (NOA)

Signature Door, Inc.
401 Juniata Street
Atloona, PA 16602

SCOPE:

This NOA is being issued under the applicable rules and regulations governing the use of construction materials. The documentation submitted has been reviewed by Miami-Dade County Product Control Division and accepted by the Board of Rules and Appeals (BORA) to be used in Miami Dade County and other areas where allowed by the Authority Having Jurisdiction (AHJ).

This NOA shall not be valid after the expiration date stated below. The Miami-Dade County Product Control Division (In Miami Dade County) and/or the AHJ (in areas other than Miami Dade County) reserve the right to have this product or material tested for quality assurance purposes. If this product or material fails to perform in the accepted manner, the manufacturer will incur the expense of such testing and the AHJ may immediately revoke, modify, or suspend the use of such product or material within their jurisdiction. BORA reserves the right to revoke this acceptance, if it is determined by Miami-Dade County Product Control Division that this product or material fails to meet the requirements of the applicable building code.

This product is approved as described herein, and has been designed to comply with the Florida Building Code, including the High Velocity Hurricane Zone.

DESCRIPTION: 10' Glazed Inswing Wood Door - Impact

APPROVAL DOCUMENT: Drawing No. 1315, "10 Foot Wood Inswing Impact Doors", sheets 1 through 10 of 10, prepared by W.W. Schaefer Engineering & Consulting, P.A., dated 06/28/04, signed and sealed by Warren W. Schaefer, P.E., bearing the Miami-Dade County Product Control Revision stamp with the Notice of Acceptance number and expiration date by the Miami-Dade County Product Control Division.

MISSILE IMPACT RATING: Large and Small Missile Impact

LABELING: Each unit shall bear a permanent label with the manufacturer's name or logo, city, state and following statement: "Miami-Dade County Product Control Approved", unless otherwise noted herein.

RENEWAL of this NOA shall be considered after a renewal application has been filed and there has been no change in the applicable building code negatively affecting the performance of this product.

TERMINATION of this NOA will occur after the expiration date or if there has been a revision or change in the materials, use, and/or manufacture of the product or process. Misuse of this NOA as an endorsement of any product, for sales, advertising or any other purposes shall automatically terminate this NOA. Failure to comply with any section of this NOA shall be cause for termination and removal of NOA.

ADVERTISEMENT: The NOA number preceded by the words Miami-Dade County, Florida, and followed by the expiration date may be displayed in advertising literature. If any portion of the NOA is displayed, then it shall be done in its entirety.

INSPECTION: A copy of this entire NOA shall be provided to the user by the manufacturer or its distributors and shall be available for inspection at the job site at the request of the Building Official.

This NOA revises NOA # 05-0407.01 and consists of this page 1 and evidence pages E-1 and E-2, as well as approval document mentioned above.

The submitted documentation was reviewed by **Herminio F. Gonzalez, P.E.**



NOA No 05-0901.13
Expiration Date: February 17, 2010
Approval Date: December 22, 2005
Page 1

NOTICE OF ACCEPTANCE: EVIDENCE SUBMITTED

A. DRAWINGS

1. Manufacturer's die drawings and sections.
2. Drawing No. **1315**, titled "10 Foot Wood Inswing Doors", sheets 1 through 10 of 10, dated 06/28/04, prepared by W.W. Schaefer Engineering & Consulting, P.A., signed and sealed by Warren W. Schaefer, P.E.

B. TESTS

1. Test reports on 1) Air Infiltration Test, per FBC, TAS 202-94
2) Uniform Static Air Pressure Test, Loading per FBC, TAS 202-94
3) Water Resistance Test, per FBC, TAS 202-94
4) Large Missile Impact Test per FBC, TAS 201-94
5) Cyclic Wind Pressure Loading per FBC, TAS 203-94
6) Forced Entry Test, per FBC 2411 3.2.1 and TAS 202-94
along with marked-up drawings and installation diagram of inswing wood doors, prepared by Hurricane Test Laboratory, LLC, Test Report No. **HTL-0243-0319-04** (specimen # 4) dated 03/17-5/25/04, signed and sealed by Vinu J. Abraham, P.E.
(Submitted under previous NOA # 05-0407.01)
2. Test reports on 1) Air Infiltration Test, per FBC, TAS 202-94
2) Uniform Static Air Pressure Test, Loading per FBC, TAS 202-94
3) Water Resistance Test, per FBC, TAS 202-94
4) Large Missile Impact Test per FBC, TAS 201-94
5) Cyclic Wind Pressure Loading per FBC, TAS 203-94
6) Forced Entry Test, per FBC 2411 3.2.1 and TAS 202-94
along with marked-up drawings and installation diagram of inswing wood doors, prepared by Hurricane Test Laboratory, LLC, Test Report No. **HTL0243-0516-04** (specimen # 4, 7) dated 03/17-5/26/04, signed and sealed by Vinu J. Abraham, P.E.
(Submitted under previous NOA # 05-0407.01)
3. Test reports on 1) Air Infiltration Test, per FBC, TAS 202-94
2) Uniform Static Air Pressure Test, Loading per FBC, TAS 202-94
3) Water Resistance Test, per FBC, TAS 202-94
4) Large Missile Impact Test per FBC, TAS 201-94
5) Cyclic Wind Pressure Loading per FBC, TAS 203-94
6) Forced Entry Test, per FBC 2411 3.2.1 and TAS 202-94
along with marked-up drawings and installation diagram of inswing wood doors, prepared by Hurricane Test Laboratory, LLC, Test Report No. **HTL-0243-1013-03** (specimen # 8) dated 10/22-24/03, signed and sealed by Vinu J. Abraham, P.E.
(Submitted under previous NOA # 05-0407.01)



Herminio F. Gonzalez, P.E.
Director, Building Code Compliance Office

NOA No 05-0901.13

Expiration Date: February 17, 2010

Approval Date: December 22, 2005

NOTICE OF ACCEPTANCE: EVIDENCE SUBMITTED

4. Test reports on 1) Uniform Static Air Pressure Test, Loading per FBC, TAS 202-94
2) Large Missile Impact Test per FBC, TAS 201-94
3) Cyclic Wind Pressure Loading per FBC, TAS 203-94
along with marked-up drawings and installation diagram of inswing wood doors,
prepared by Hurricane Test Laboratory, LLC, Test Report No. **HTL-G243-1201-04**
(specimen # 2) dated 12/06-16/04, signed and sealed by Vinu J. Abraham, P.E.
(Submitted under previous NOA # 05-0407.01)

C. CALCULATIONS

1. Anchor verification calculations, complying with FBC-2004, dated 08/18/05, prepared by W.W. Schaefer Engineering & Consulting, P.A., signed and sealed by Warren W. Schaefer, P.E.
Complies with ASTM E1300-02
2. Anchor Calculations and structural analysis, prepared by W.W. Schaefer Engineering & Consulting, P.A., dated 06/23/04, signed and sealed by Warren Schaefer, P.E.
(Submitted under previous NOA # 05-0407.01)

D. QUALITY ASSURANCE

1. Miami Dade Building Code Compliance Office (BCCO).

E. MATERIAL CERTIFICATIONS

1. Notice of Acceptance No. **03-0225.10** issued to Glasslam NGI Inc. for "Safety Plus II-Laminated Glass" dated 08/07/03, expiring on 08/07/08.
2. Notice of Acceptance No. **03-0514.15** issued to Oldcastle Glass Inc. for "Storm Glass" dated 12/11/03, expiring on 12/11/08.

F. STATEMENTS



1. Statement letter of conformance and no financial interest, dated 06/28/04, signed and sealed by Warren Schaefer, P.E.
(Submitted under previous NOA # 05-0407.01)

G. OTHER

1. Notice of Acceptance No. **04-0907.03**, issued to Signature Door, Inc. for their 10' Glazed Inswing Wood Door, approved on 02/17/05 and expiring on 02/17/10.
2. Letter from the consultant, dated November 9, 2005, stating that the product is in compliance with the Florida Building Code (FBC)



Herminio F. Gonzalez, P.E.
Director, Building Code Compliance Office
NOA No 05-0901.13
Expiration Date: February 17, 2010
Approval Date: December 22, 2005

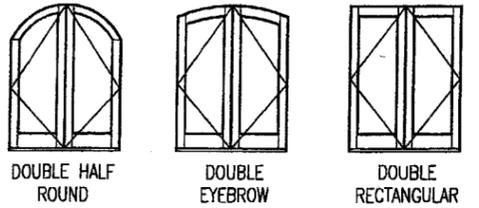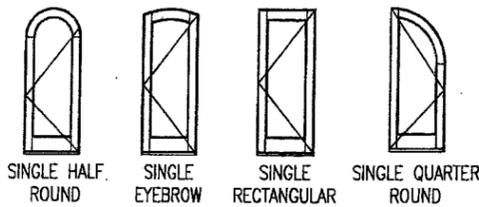

SHAPES CONSIDERED AS PART OF THIS APPROVAL

HINGE REQUIREMENTS

MAXIMUM DOOR FRAME HEIGHT	# HINGES REQUIRED	
	PANEL WIDTH 36" & LESS	PANEL WIDTH GREATER THAN 36"
82"	3	3
98"	(1) 4	(1) 4
122"	4	(1) 5

(1) ONE LESS HINGE IS REQUIRED WITH DOUBLE HALF ROUND & SINGLE QUARTER ROUND DOORS.


ALLOWABLE DESIGN PRESSURE

(1) SEE LOAD TABLES ON SHEET 11

(1) POSITIVE PRESSURE NOTE: THESE DOORS ARE NOT APPROVED FOR WATER INFILTRATION RESISTANCE UNLESS THE UNITS ARE INSTALLED IN A NON-HABITABLE AREA WHERE THE UNIT AND THE AREA ARE DESIGNED TO ACCEPT WATER INFILTRATION. OTHERWISE, THE DOORS MUST BE INSTALLED ONLY AT LOCATIONS PROTECTED BY A CANOPY OR OVERHANG SUCH THAT THE ANGLE BETWEEN THE EDGE OF THE CANOPY OR OVERHANG TO SILL IS LESS THAN 45 DEGREES.

GENERAL NOTES

- THESE DOOR SYSTEMS HAVE BEEN TESTED, ANALYZED AND APPROVED FOR DESIGN PRESSURES NOT TO EXCEED THOSE SHOWN IN THE "ALLOWABLE DESIGN PRESSURE" TABLE.
- BUCKING, OPENINGS & BUCKING FASTENERS MUST BE PROPERLY DESIGNED & INSTALLED TO TRANSFER WIND LOADS TO THE STRUCTURE.
- ALL HARDWARE & FASTENERS SHALL BE IN ACCORDANCE WITH THESE DRAWINGS & MAY NOT VARY UNLESS SPECIFICALLY MENTIONED ON THE DRAWINGS.
- THE DETAILS & SPECIFICATIONS SHOWN HEREIN REPRESENT THE PRODUCTS TESTED & PROPOSED FOR WATER, AIR, IMPACT, CYCLIC & UNIFORM STATIC AIR PRESSURE TESTING IN CONFORMANCE WITH FLORIDA BUILDING CODE PROTOCOLS TAS-201, 202 & 203 FOR LARGE MISSILE IMPACT DOORS.
- THESE DOOR SYSTEMS HAVE BEEN DESIGNED IN ACCORDANCE WITH THE 2004 FLORIDA BUILDING CODE (F.B.C.) INCLUDING HIGH VELOCITY HURRICANE ZONES (HVHZ).
- IMPACT SHUTTERS ARE NOT REQUIRED WITH THESE DOORS.
- ALL ANCHORS SHALL BE INSTALLED AS SPECIFIED ON THESE DRAWINGS. SPECIFIED EMBEDMENT TO BASE MATERIAL SHALL BE BEYOND WALL FINISH OR STUCCO.

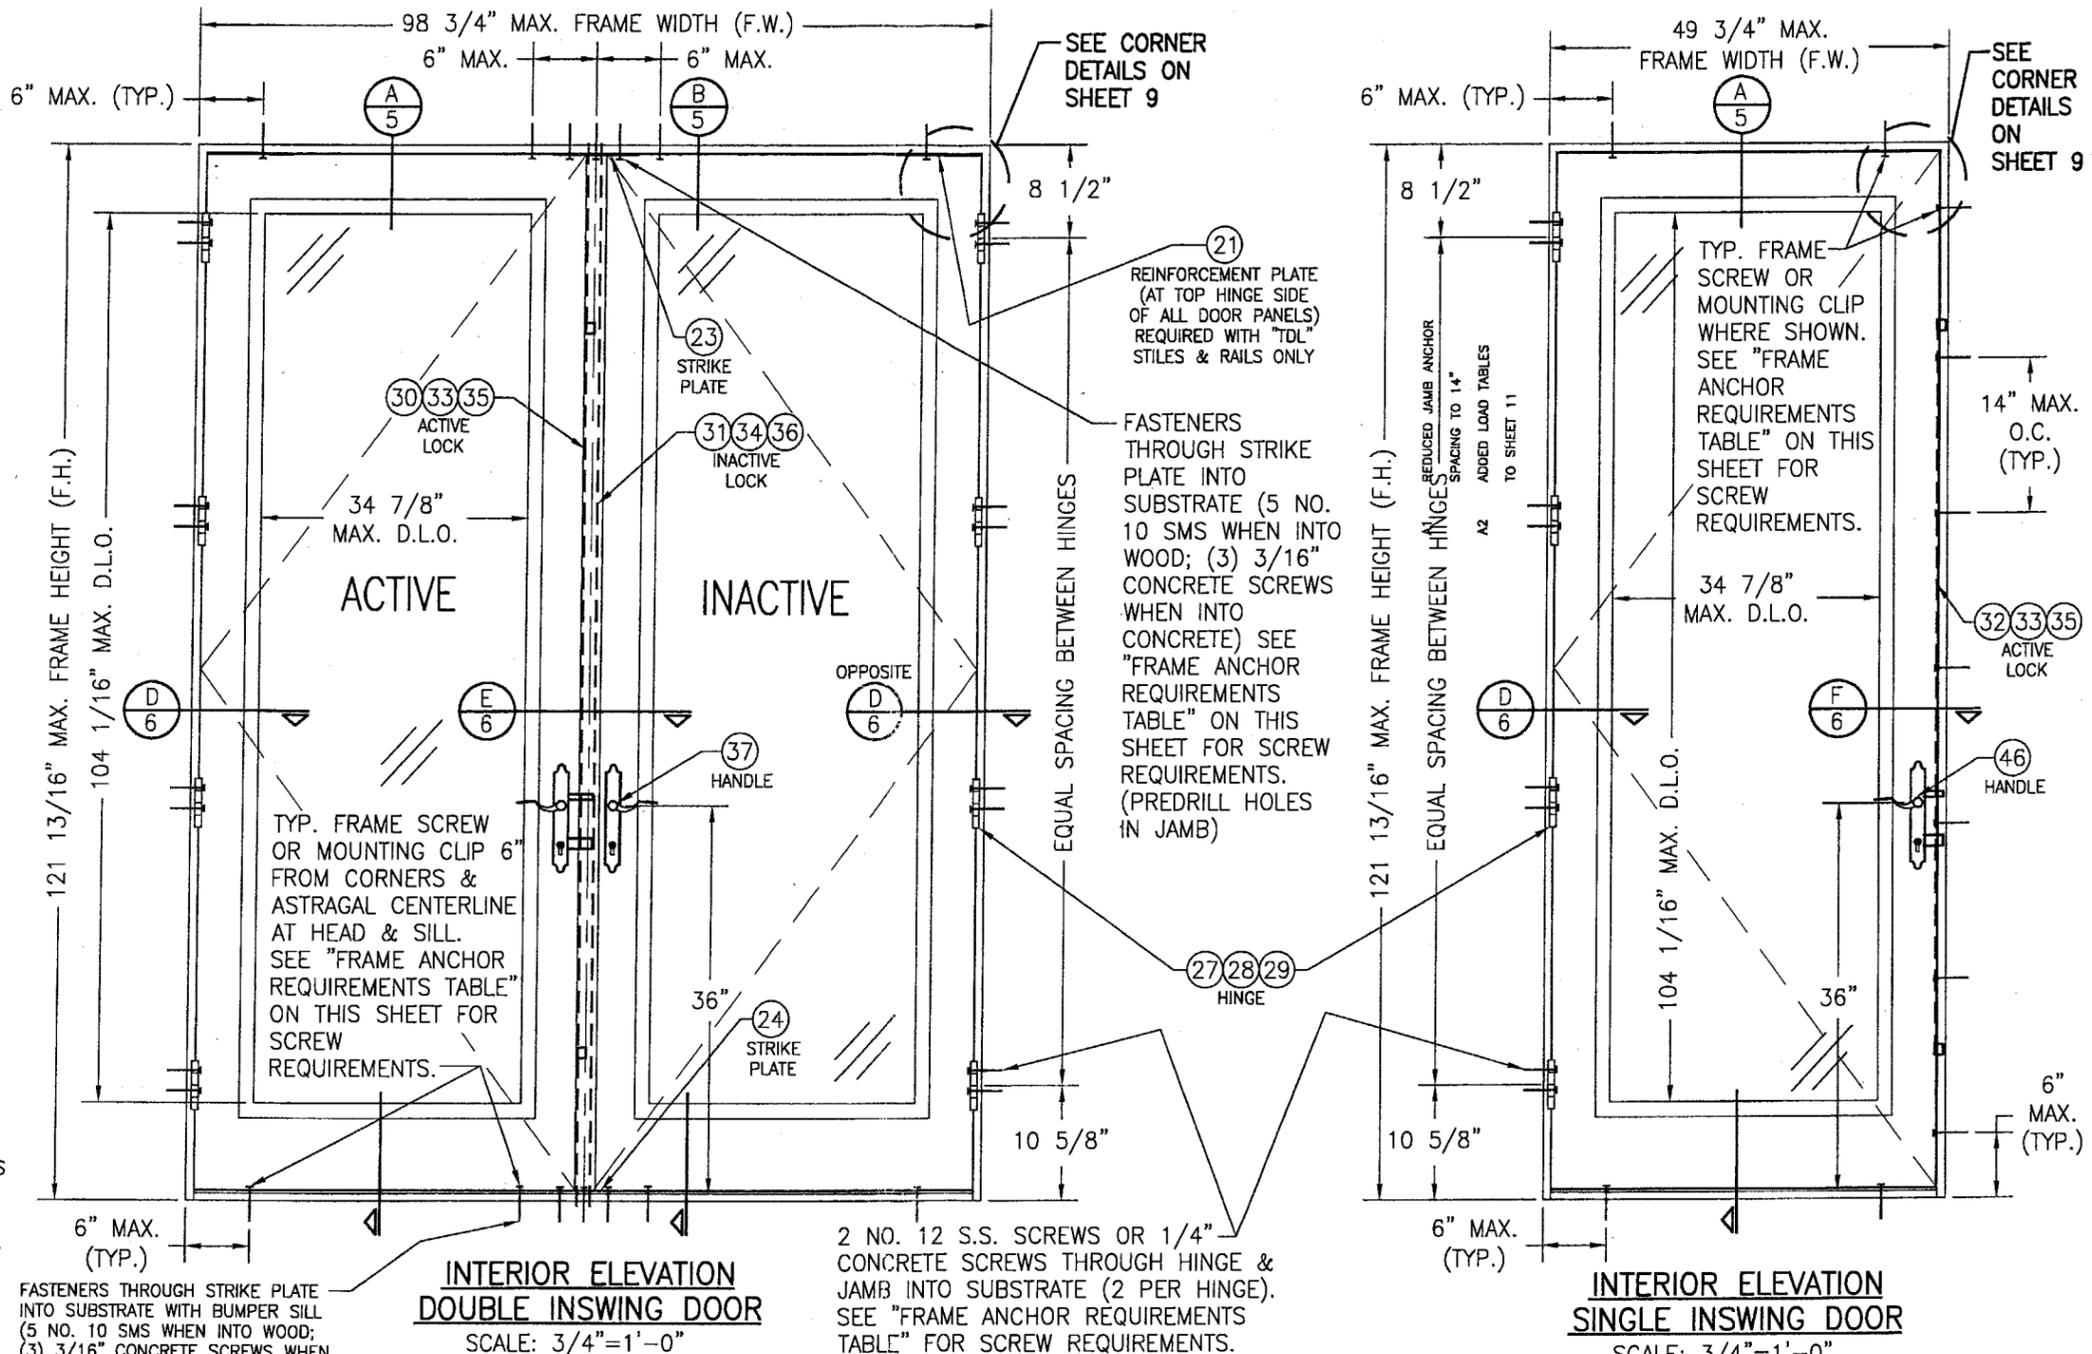

INTERIOR ELEVATION DOUBLE INSWING DOOR
SCALE: 3/4"=1'-0"

INTERIOR ELEVATION SINGLE INSWING DOOR
SCALE: 3/4"=1'-0"

FRAME ANCHOR REQUIREMENTS TABLE

OPENING TYPE (SUBSTRATE)	JAMB TO OPENING FASTENER TYPE (ANCHOR)	MINIMUM EMBED	MINIMUM EDGE DIST.
2X_ WOOD FRAME OR BUCK	NO. 10 SMS FRAME SCREW	1 3/8"	1"
2X_ WOOD FRAME OR BUCK	NO. 12 HINGE SCREW	1 3/8"	1"
CMU/CONCRETE	(1) 3/16" & 1/4" CONCRETE SCREWS	1 1/4"	2"
2X_ WOOD FRAME OR BUCK	MOUNTING CLIP W/#8 SCREWS	1 3/8"	1/2"

(1) CONCRETE SCREWS SHALL BE ELCO OR ITW RAMSET/RED HEAD TAPCONS, HILTI KWIK-CON II OR POWERS RAWL TAPPER (HARDENED STEEL OR S.S.).


* ANCHOR NOTE: FRAME MAY BE EITHER DIRECT MOUNTED TO THE OPENING, MOUNTED ONTO A CONTINUOUS WOOD SPACER, OR ANCHORED TO A MIN. 2x4 NO. 2 SOUTHERN PINE WOOD BUCK. WHEN ANCHORED TO A 2x4 BUCK, MOUNTING CLIPS OR NO. 10 SHEAR SCREWS SHALL BE USED. WHEN DIRECT MOUNTED OR MOUNTED WITH SPACER, 3/16" CONCRETE SCREWS SHALL BE USED. SEE "ANCHOR REQUIREMENTS TABLE" FOR EMBED REQUIREMENTS. PROPER MATERIAL SHALL BE USED BETWEEN ALL DISIMILAR MATERIALS (BLOCK/CONCRETE & ALUMINUM).

NOTE: SINGLE DOOR SHOWN HAS THE 3-POINT LOCK SYSTEMS. AN ALTERNATE LOCK MAY BE A SINGLE POINT BALDWIN 6021 MORTISE LOCK IF THE DOOR FRAME SIZE IS 37 9/16" X 97 5/16" OR LESS.

NOTE: DOORS MAY BE FULLY GLAZED AS SHOWN, PARTIALLY PANELED OR FULLY PANELED. SEE SHEET 4 ELEVATION FOR PANELED DOORS.

PRODUCT REVISED
in compliance with the Florida Building Code
Amendment No. 05-0901.13
Supplement Part 02/17/10
Warren W. Schaefer, P.E.
Product Control Division


DRAWN BY: K.P.S.	CHECKED BY: W.W.S.
PLOT: 1=16	DATE: 06/28/04
DATE	BY
REVISION DESCRIPTION	NO.
1 REDUCED JAMB ANCHOR SPACING TO 14" ADDED LOAD TABLES TO SHEET 11	A1
2 ADDED LOAD TABLES TO SHEET 11	A2
DRAWING TITLE 10 FOOT WOOD INSWING IMPACT DOORS	
MANUFACTURER SIGNATURE DOOR INC. 401 JUNIATA STREET ALTOONA, PA 16602 814-949-2770	
CONSULTANTS W. W. SCHAEFER ENGINEERING & CONSULTING, P.A. 8805 N. MILITARY TRAIL, SUITE C-204 PALM BEACH GARDENS, FL 33410 PHONE: 561-775-4902 FAX: 561-775-4903	
CERTIFICATION AUG 24 2005 WARREN W. SCHAEFER, P.E. P.E. NO. 44135	
DRAWING NO. 1315	REV. A
SHEET NO. 1 OF 11	

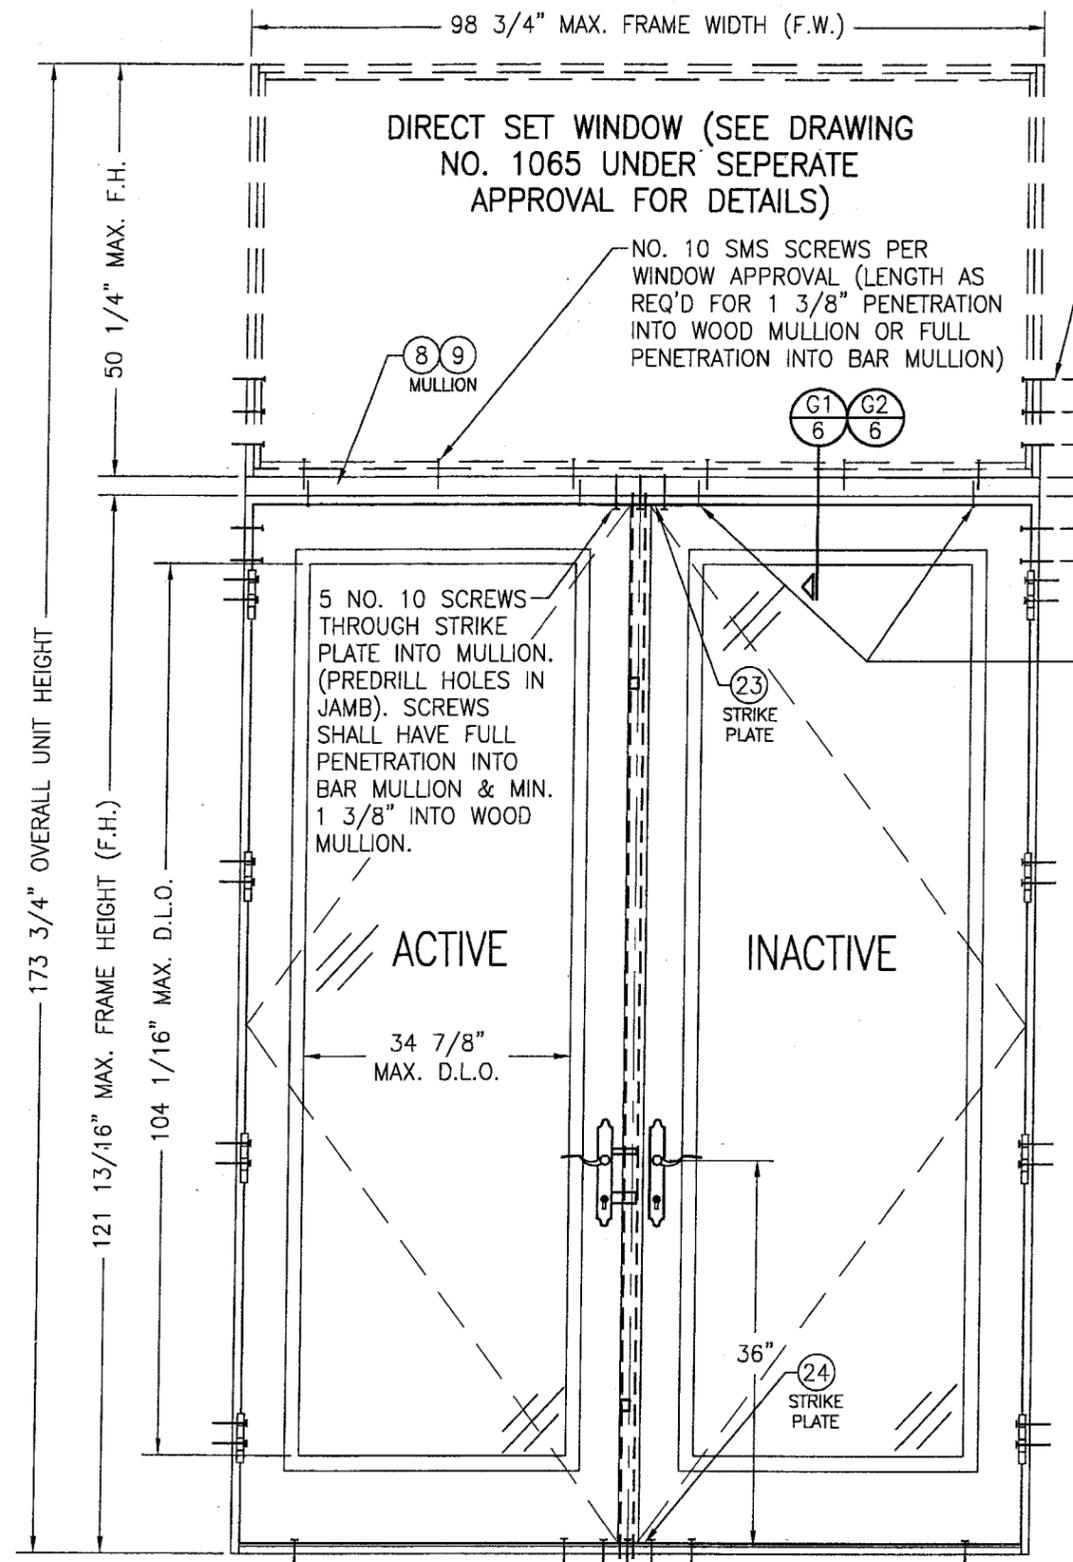

**INTERIOR ELEVATION
DOUBLE DOOR WITH TRANSOM**

SCALE: 3/4"=1'-0"

SEE DOUBLE DOOR ELEVATION ON SHEET 1 FOR DETAIL NOT SHOWN

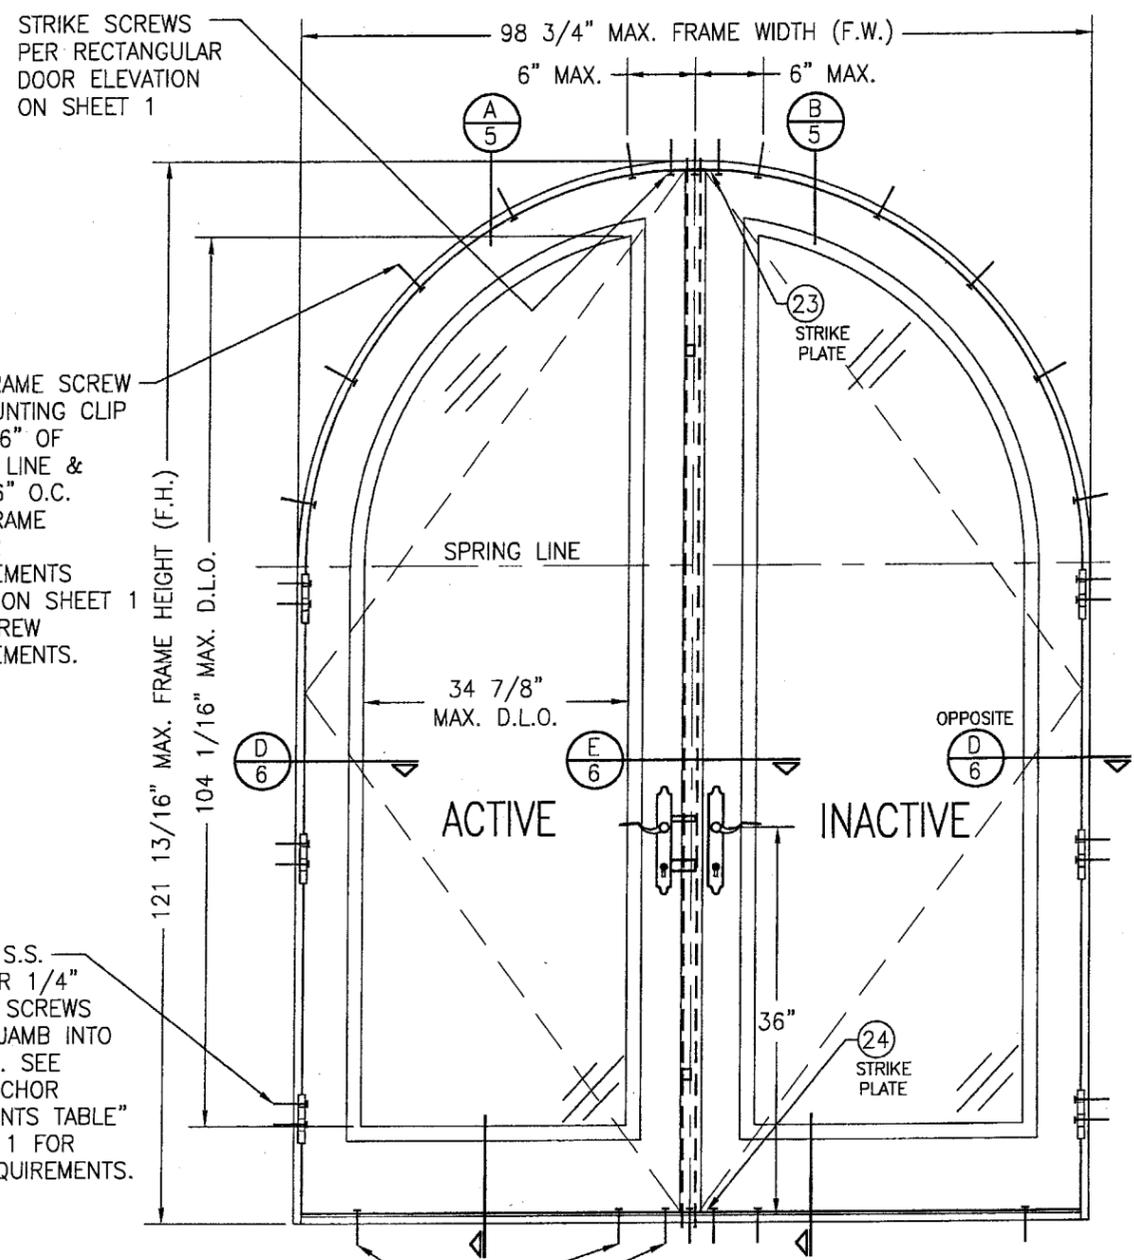

**INTERIOR ELEVATION
DOUBLE HALF ROUND DOOR**

SCALE: 3/4"=1'-0"


SEE DOUBLE DOOR ELEVATION ON SHEET 1 FOR DETAIL NOT SHOWN

PRODUCT REVIEWED
as complying with the Florida
Building Code
Acceptance No. **05-0901.13**
Expiration Date **02/13/10**


By **Miami Dade Product Control
Division**

NOTE: DOORS MAY BE FULLY
GLAZED AS SHOWN, PARTIALLY
PANELED OR FULLY PANELED.
SEE SHEET 4 ELEVATION FOR
PANELED DOORS.


DRAWN BY: K.P.S.		CHECKED BY: W.W.S.	
PLOT: 1-16		DATE: 06/28/04	
DATE	BY	REVISION DESCRIPTION	NO.
DRAWING TITLE 10 FOOT WOOD INSWING IMPACT DOORS			
CONSULTANTS W. W. SCHAEFER ENGINEERING & CONSULTING, P.A.		MANUFACTURER SIGNATURE DOOR INC.	
8895 N. MILITARY TRAIL, SUITE C-204 PALM BEACH GARDENS, FL 33410 PHONE: 561-775-4902 FAX: 561-775-4903		401 JUNIATA STREET ALTOONA, PA 16602 814-949-2770	
CERTIFICATION AUG 24 2005			
DRAWING NO. 1315		REV. A	
SHEET NO. 2 OF 11			

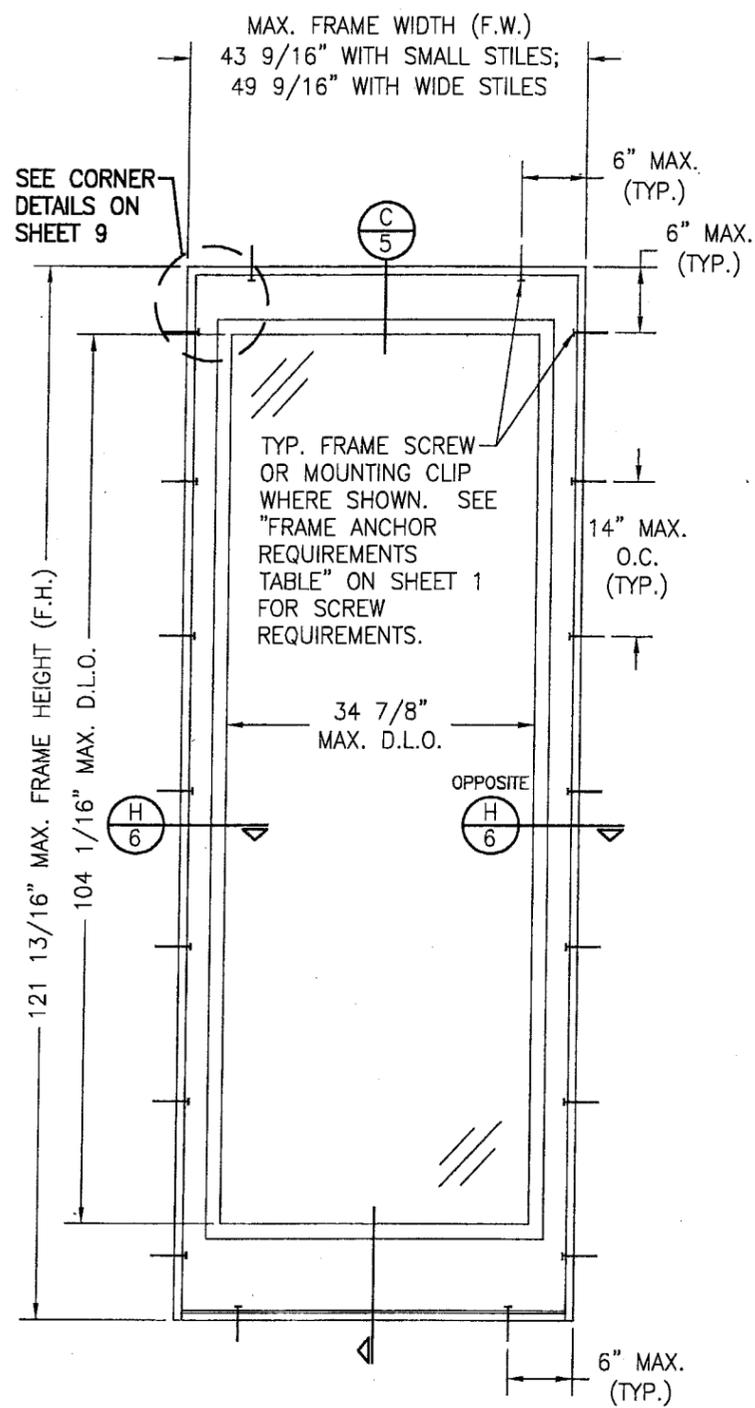


**INTERIOR ELEVATION
SINGLE FIXED PANEL**
SCALE: 3/4"=1'-0"

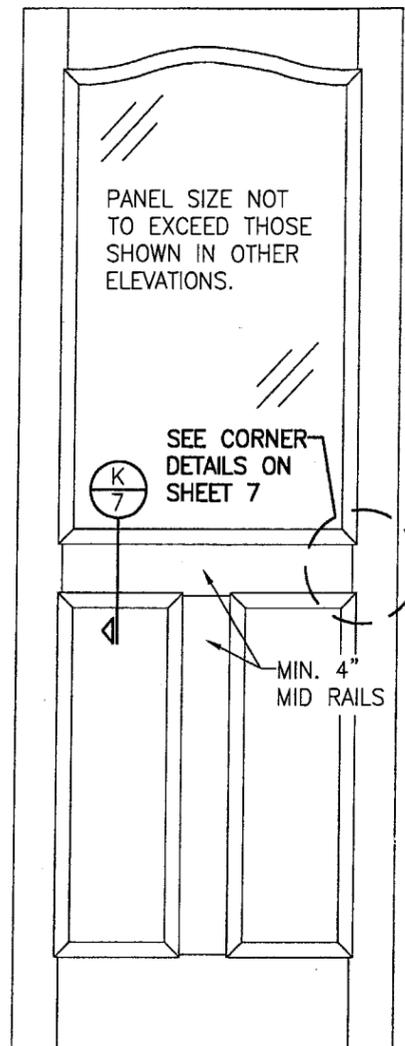

**INTERIOR ELEVATION SOLID
RAISED PANEL WITH
STANDARD MID RAILS**
SCALE: 3/4"=1'-0"

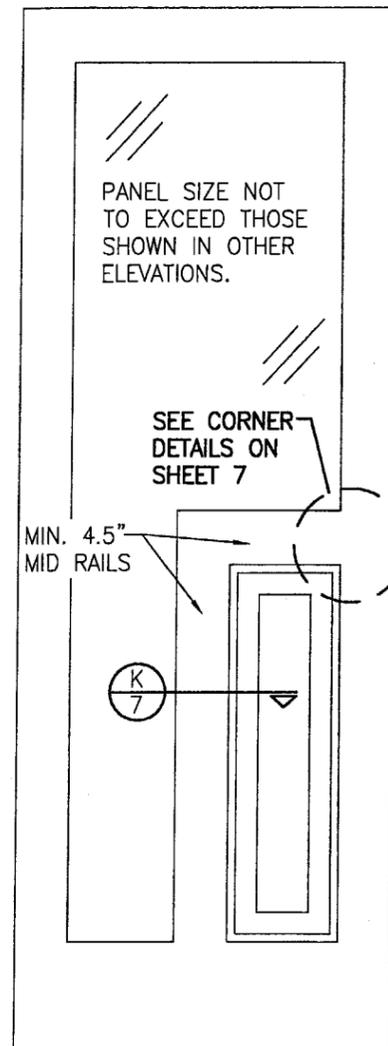

**INTERIOR ELEVATION SOLID
RAISED PANEL WITH
CORNERED MID RAILS**
SCALE: 3/4"=1'-0"

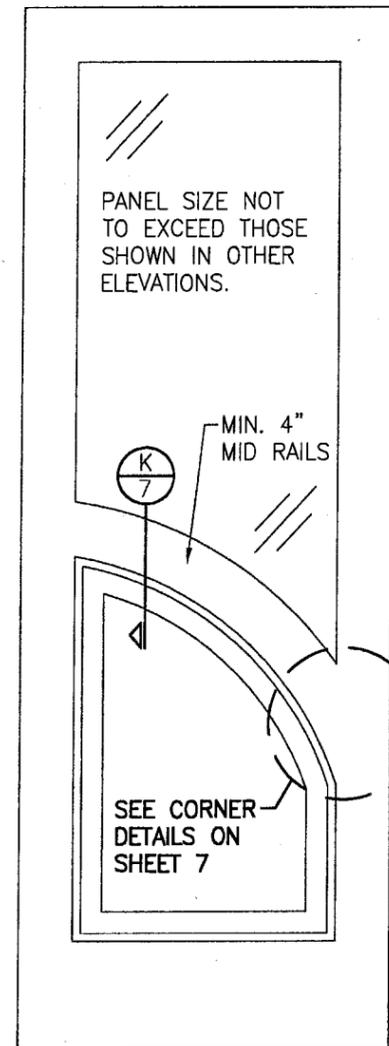


**INTERIOR ELEVATION
SOLID RAISED PANEL WITH
ARCHED/SHAPED MID RAILS**
SCALE: 3/4"=1'-0"

- 1) TOP & MID RAILS MAY BE OF ANY CONFIGURATION PROVIDING THE SMALLEST CROSS SECTION OF RAILS IS EQUAL TO OR LARGER THAN THAT DETAILED IN DRAWINGS.
- 2) MULTIPLE MID RAIL (BOTH HORIZONTAL & VERTICAL) MAY BE USED WITH THESE PANELS.
- 3) PARTIAL PANEL CONDITION IS SHOWN ABOVE. FULL PANEL DOORS AND OTHER PANEL CONFIGURATIONS ARE ALSO PART OF THIS APPROVAL AND ARE SIMILAR IN CONSTRUCTION TO THAT SHOWN ABOVE.
- 4) PANEL ONLY IS SHOWN. FOR INSTALLATION INTO FRAME, SEE OTHER ELEVATIONS.

PRODUCT REVISED
as complying with the Florida
Building Code
Acceptance No. **05-0901.13**
Expiration Date: **02/13/10**
By: *M. Thubert*
Miami Dade Product Control
Division

DRAWN BY: K.P.S.		CHECKED BY: W.W.S.	
PLOT: 1-16		DATE: 06/28/04	
NO.	REVISION DESCRIPTION	BY	DATE
DRAWING TITLE: 10 FOOT WOOD INSWING IMPACT DOORS			
CONSULTANTS W. W. SCHAEFER ENGINEERING & CONSULTING, P.A.		MANUFACTURER SIGNATURE DOOR INC.	
8895 N. MILITARY TRAIL, SUITE C-204 PALM BEACH GARDENS, FL 33410 PHONE: 561-775-4902 FAX: 561-775-4903		401 JUNIATA STREET ALTOONA, PA 16602 814-949-2770	
CERTIFICATION AUG 24 2005		WARREN W. SCHAEFER, P.E. P.E. NO. 44135	
DRAWING NO. 1315	REV. A	SHEET NO. 4 OF 11	

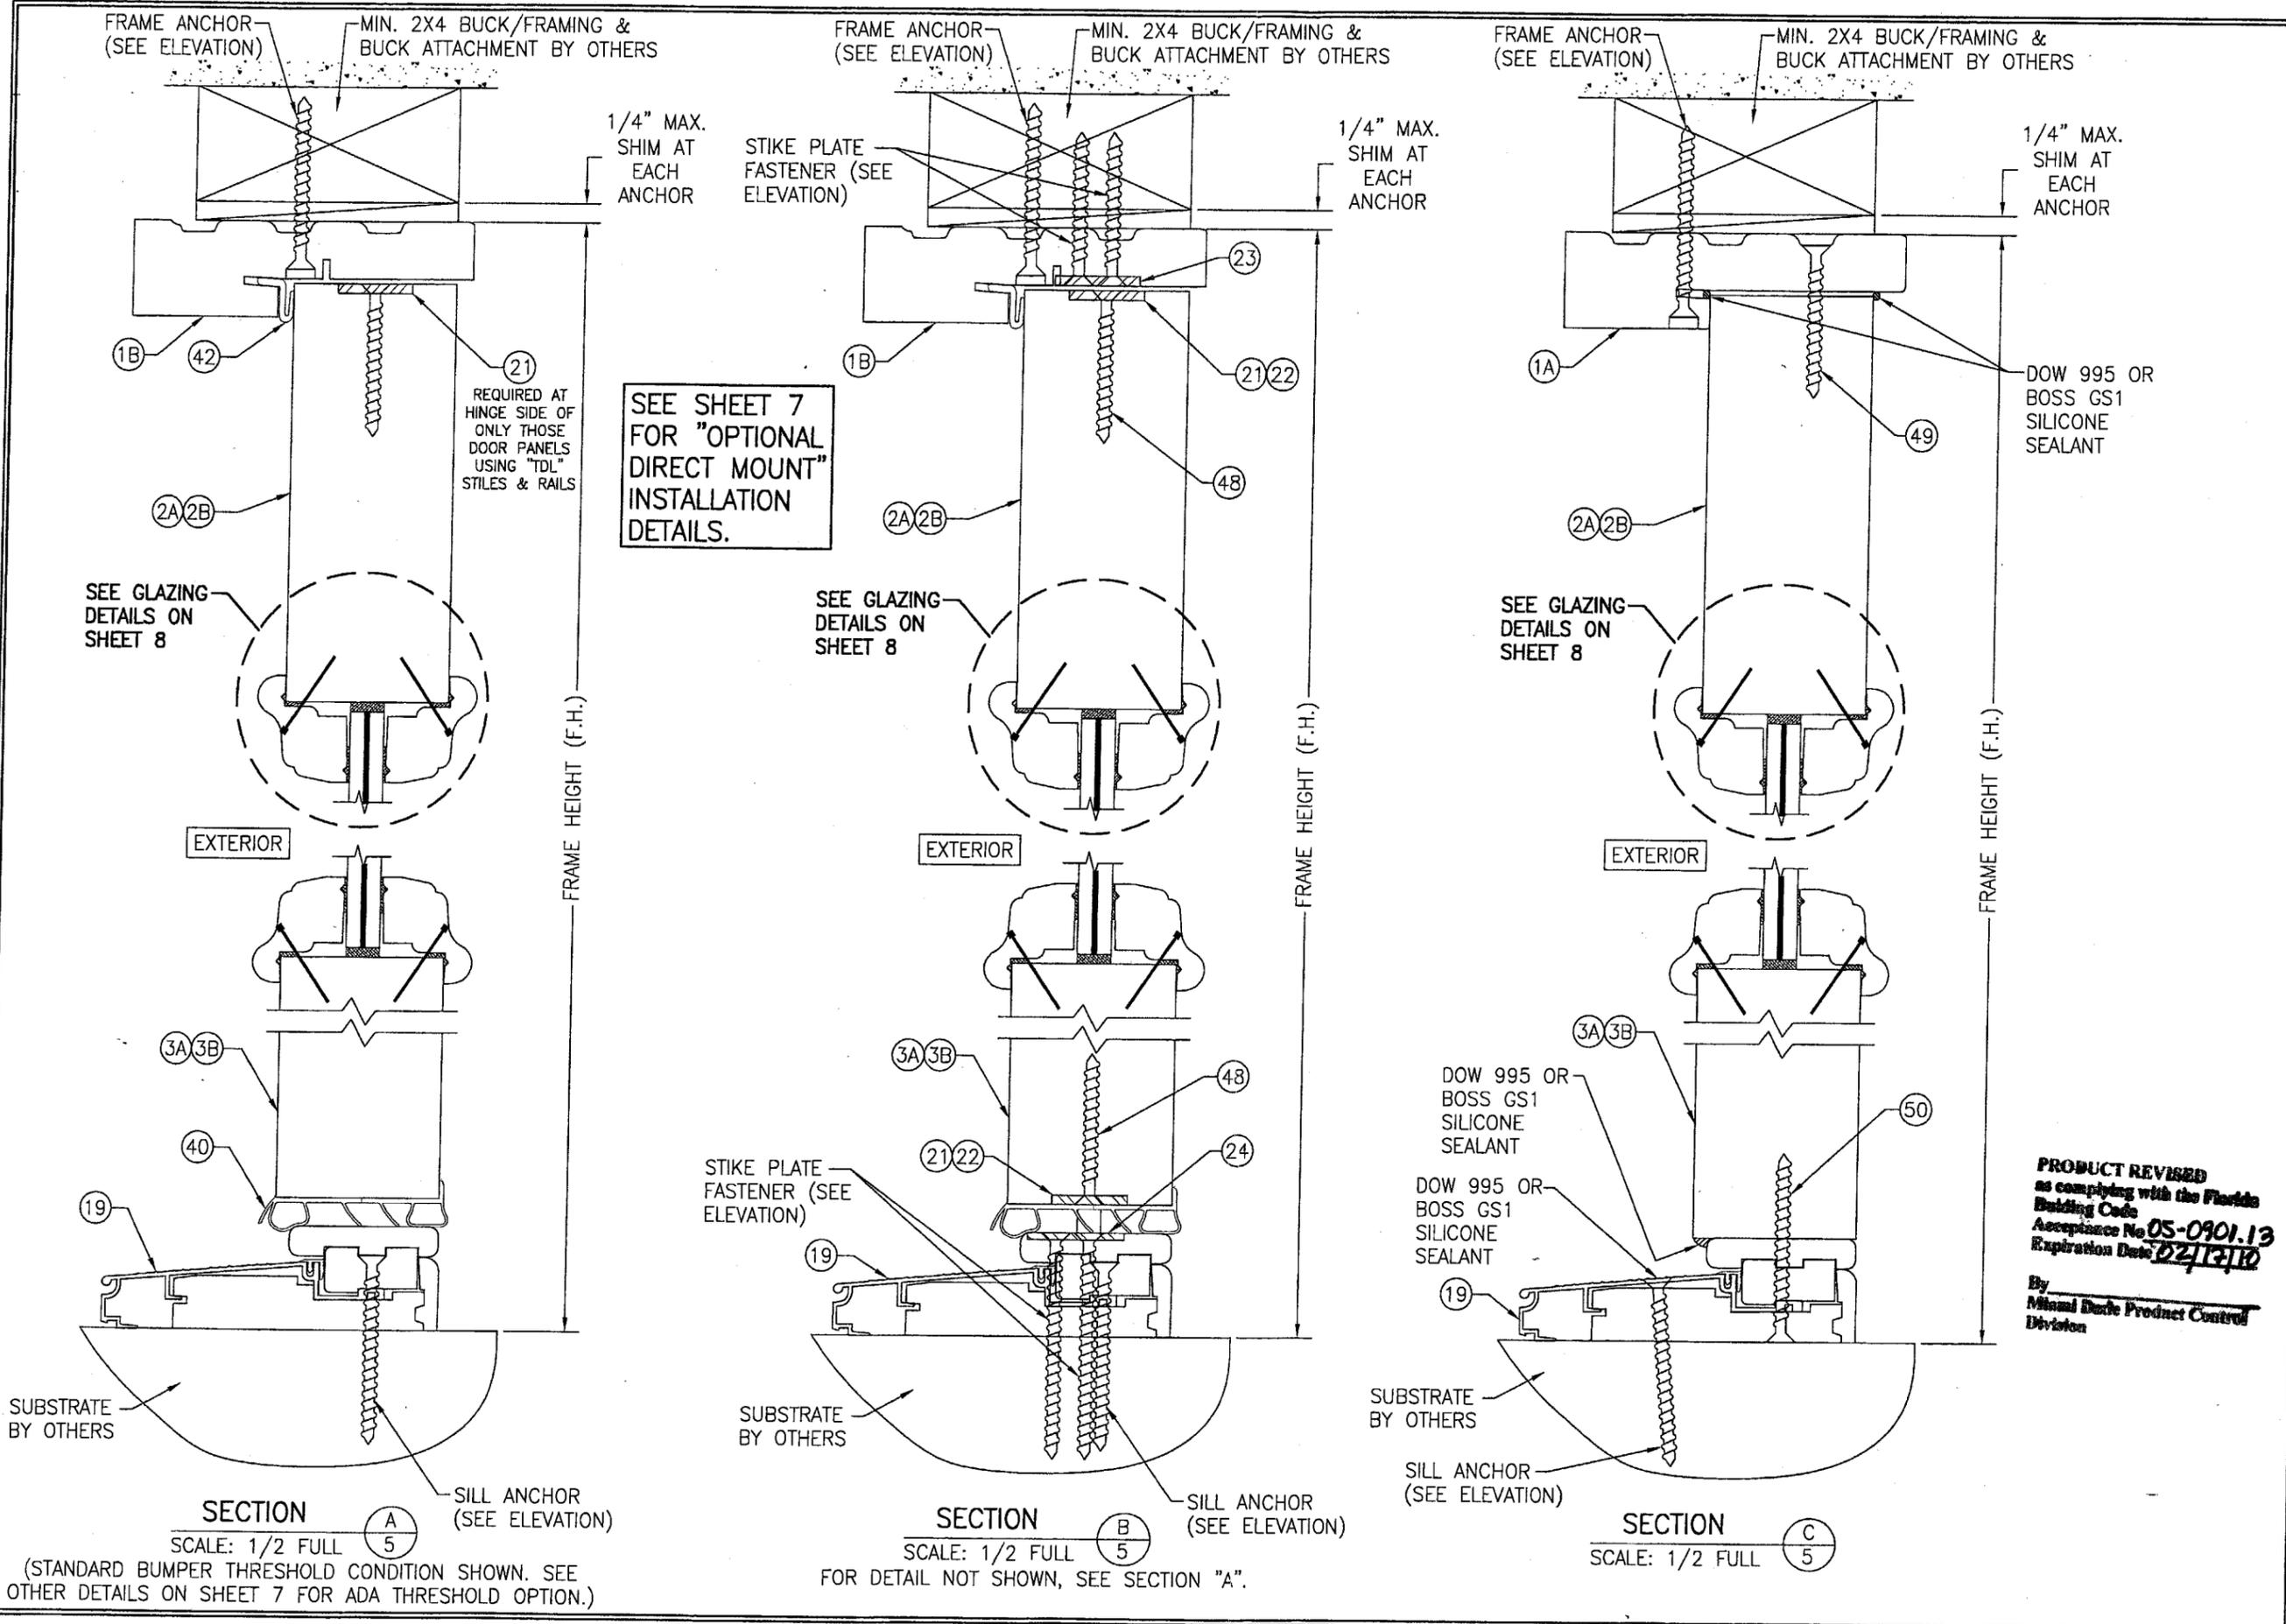


REQUIRED AT HINGE SIDE OF ONLY THOSE DOOR PANELS USING "TDL" STILES & RAILS

SEE SHEET 7 FOR "OPTIONAL DIRECT MOUNT" INSTALLATION DETAILS.

PRODUCT REVISED
 as complying with the Florida
 Building Code
 Acceptance No **05-0901.13**
 Expiration Date **02/13/10**

By **Miami Dade Product Control Division**

DRAWN BY: K.P.S.		CHECKED BY: W.W.S.	
PLOT: 1=2		DATE: 06/28/04	
NO.	REVISION DESCRIPTION	DATE	BY
DRAWING TITLE: 10 FOOT WOOD INSWING IMPACT DOORS			
CONSULTANTS: W. W. SCHAEFER ENGINEERING & CONSULTING, P.A.		MANUFACTURER: SIGNATURE DOOR INC.	
8895 N. MILITARY TRAIL, SUITE C-204 PALM BEACH GARDENS, FL 33410 PHONE: 561-775-4902 FAX: 561-775-4903		401 JUNIATA STREET ALTOONA, PA 16602 814-949-2770	
CERTIFICATION	AUG 24 2005	WARREN W. SCHAEFER, P.E.	P.E. NO. 44135
DRAWING NO.	REV.	SHEET NO.	
1315	A	5 OF 11	

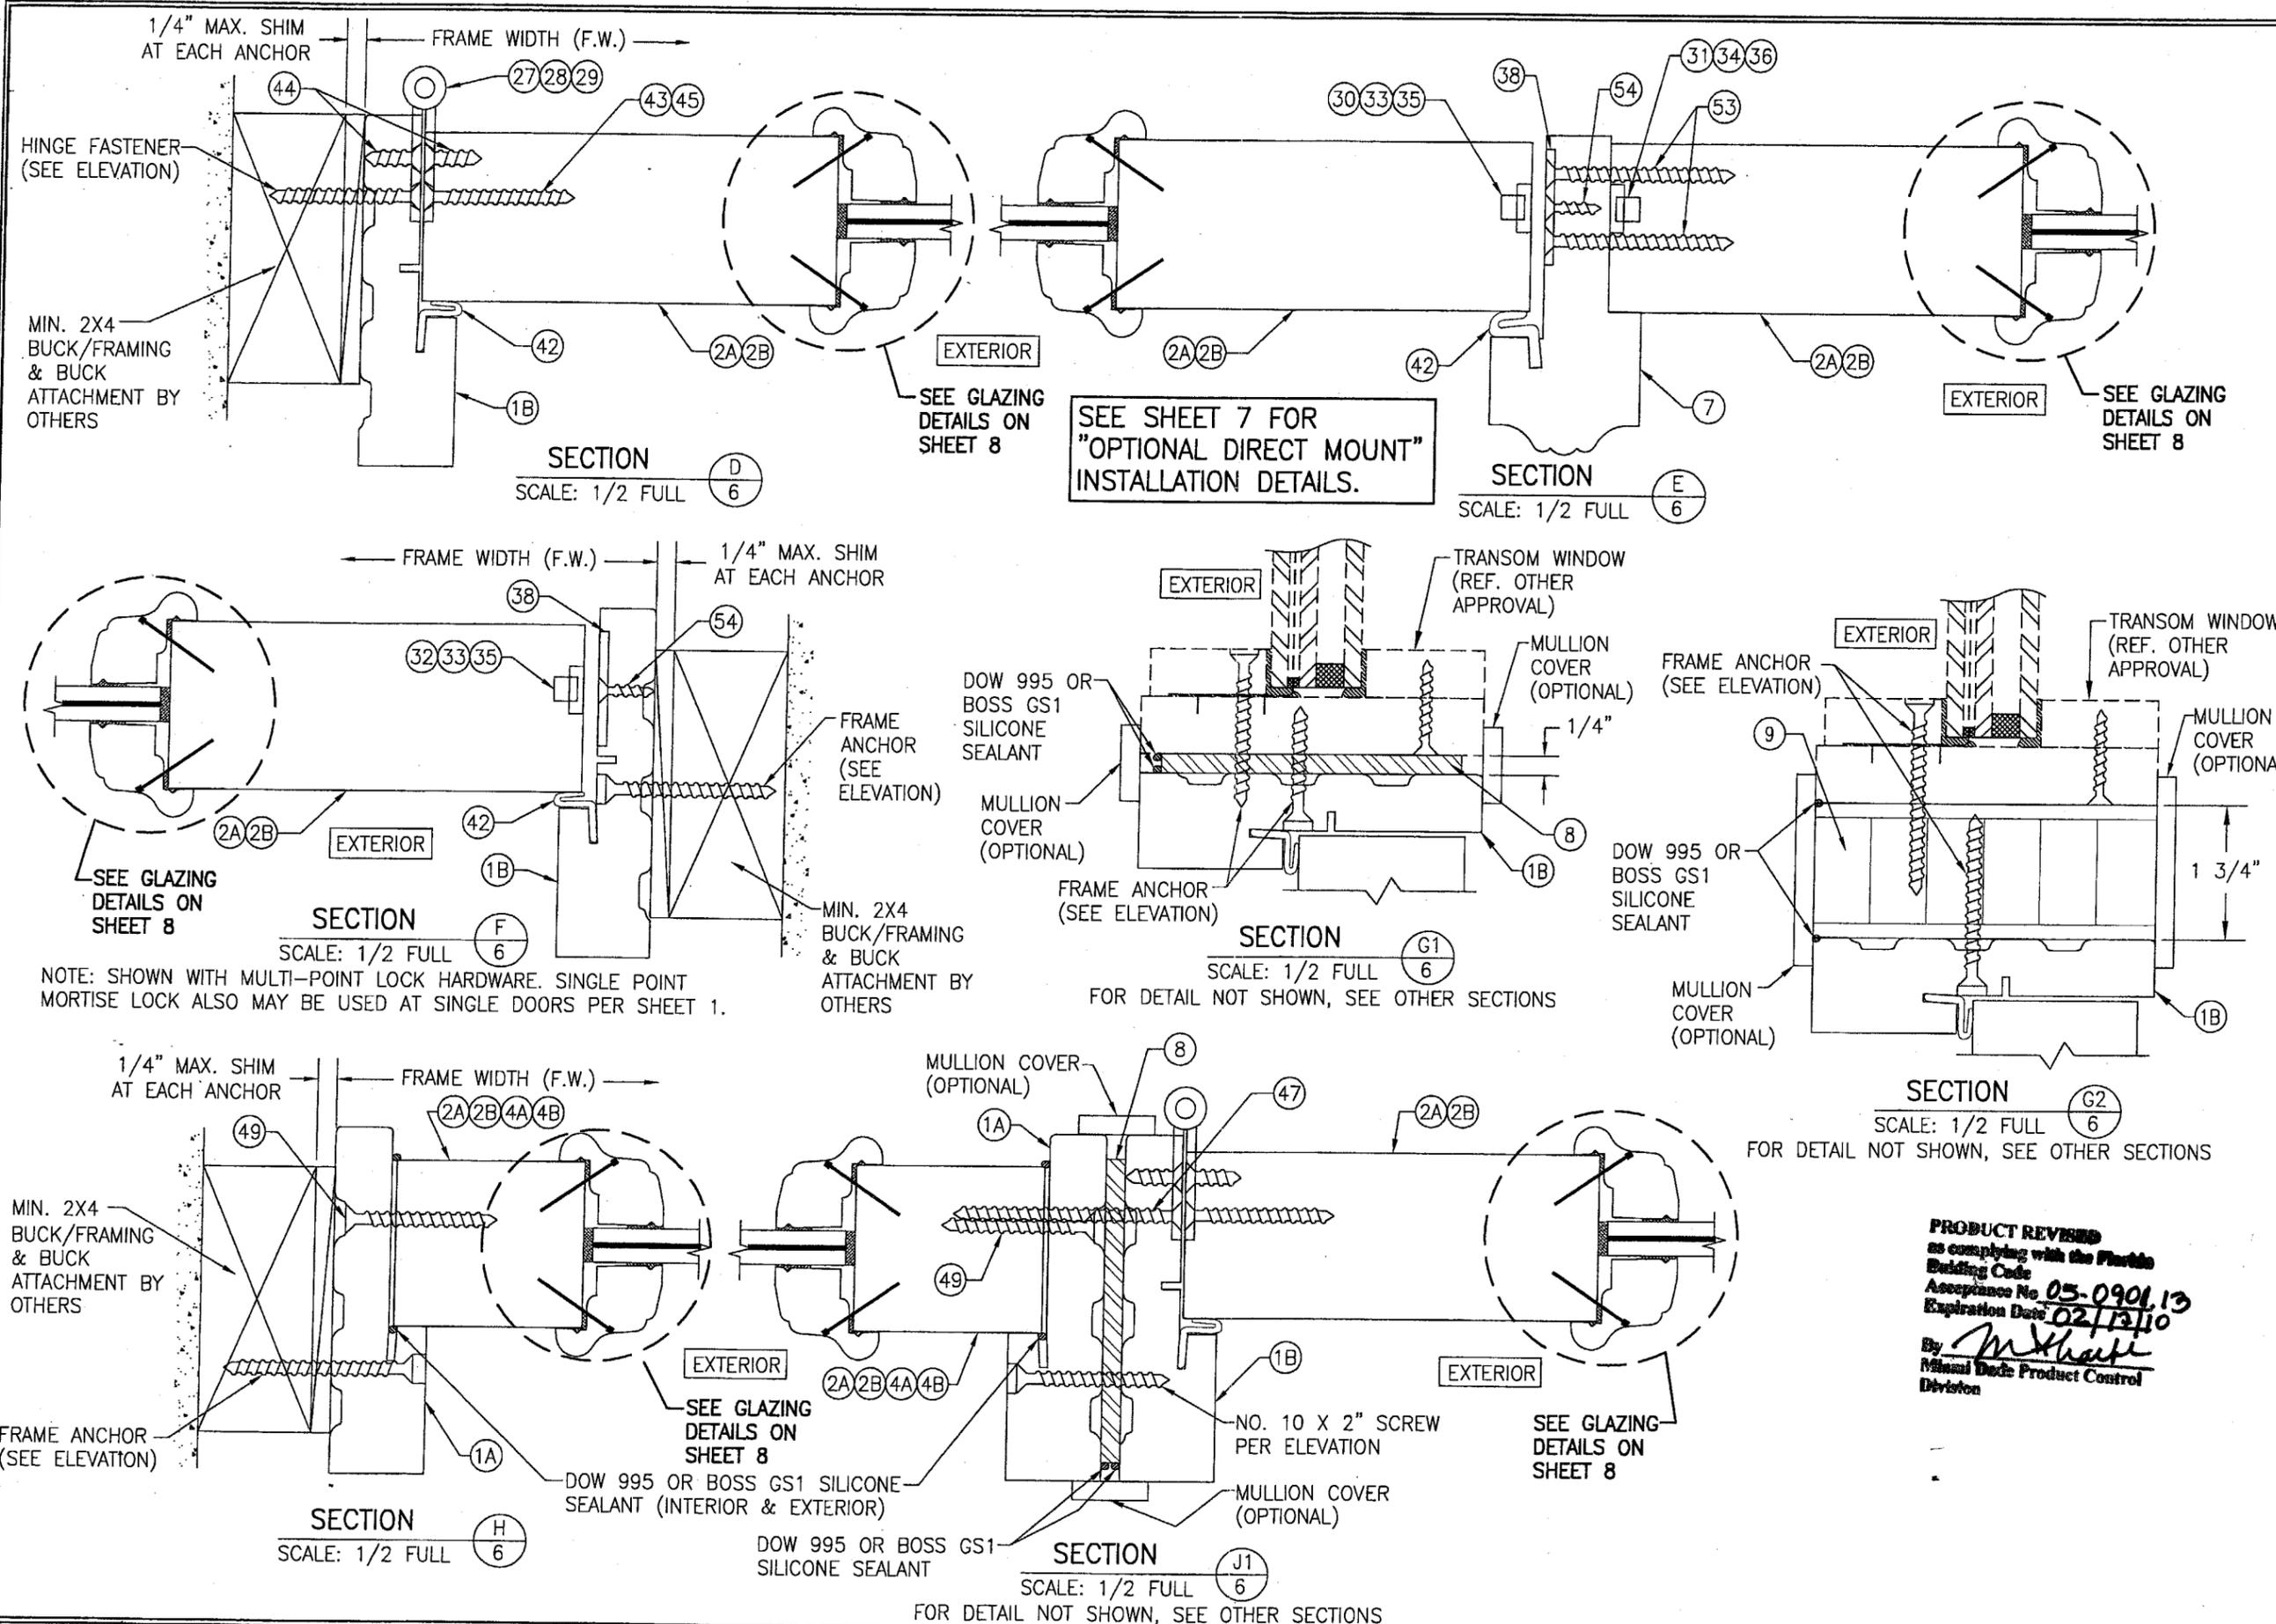

DRAWN BY: K.P.S.	CHECKED BY: W.W.S.
PLOT: 1=2	DATE: 06/28/04
NO.	REVISION DESCRIPTION
BY	DATE

10 FOOT WOOD INSWING IMPACT DOORS


MANUFACTURER
SIGNATURE DOOR INC.
401 JUNIATA STREET
ALTOONA, PA 16602
814-949-2770

CONSULTANTS
W. W. SCHAEFER ENGINEERING
& CONSULTING, P.A.
8895 N. MILITARY TRAIL, SUITE C-204
PALM BEACH GARDENS, FL 33410
PHONE: 561-775-4902 FAX: 561-775-4903

CERTIFICATION
AUG 24 2005

By: *W. Schaefer*
Warren W. Schaefer, P.E.
Division

PRODUCT REVIEWED
as complying with the Florida
Building Code
Acceptance No. 05-0901.13
Expiration Date 02/13/10

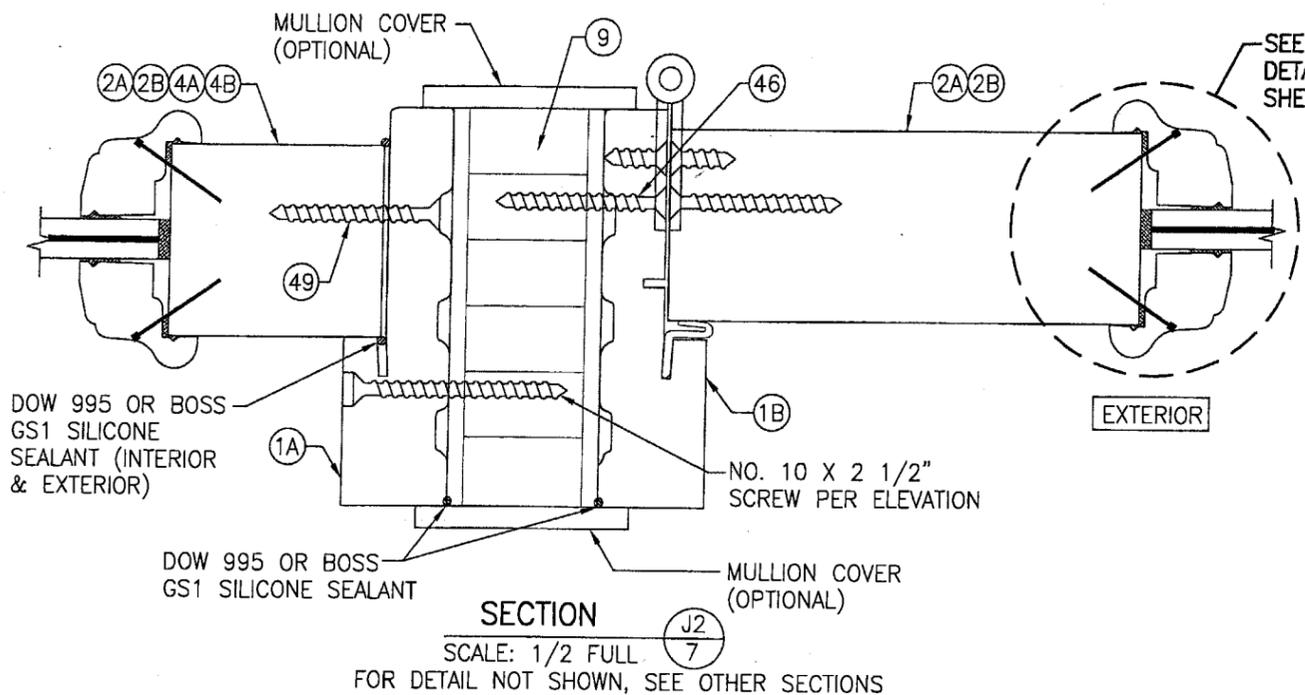


SECTION J2
SCALE: 1/2 FULL


FOR DETAIL NOT SHOWN, SEE OTHER SECTIONS

3/16" OR 1/4" CONCRETE SCREW TO REPLACE FRAME, HINGE OR STRIKE SCREWS (REF. SHEET 1 & OTHER SECTIONS FOR LOCATIONS & INSTALLATION REQUIREMENTS)

MIN. 3 1/2" DEEP CONTINUOUS WOOD P.T. MEMBER LESS IN SIZE THAN A 2x_ BUCK (NOT REQUIRED WHEN SPACE IS 1/4" OR LESS & MIN. 2" WIDE SHIMS ARE PLACED AT EACH ANCHOR)

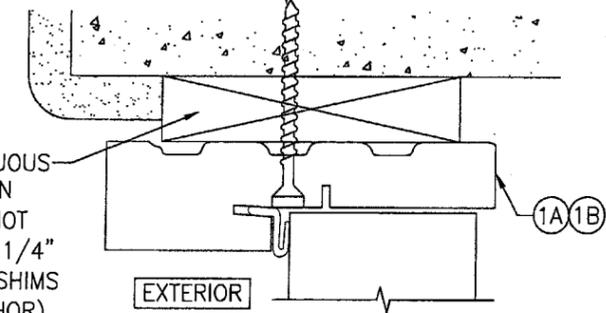


OPTIONAL DIRECT MOUNT DETAIL
FOR DETAIL NOT SHOWN, SEE OTHER SECTIONS (HEAD SECTION SHOWN, SIDES AND SILL SIMILAR)

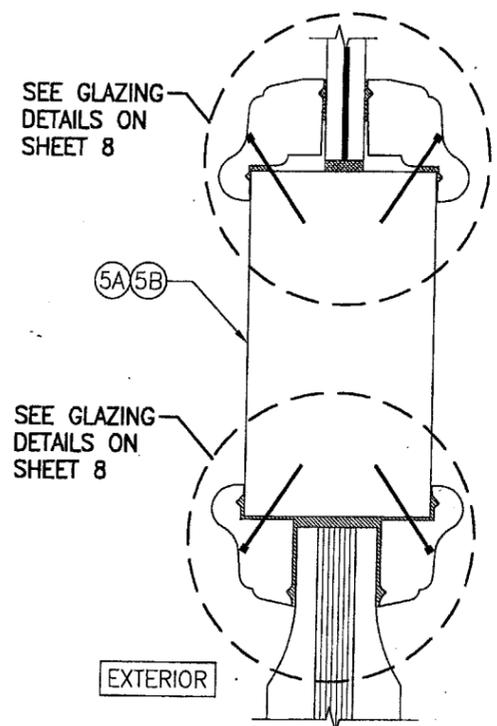

SECTION K
SCALE: 1/2 FULL


OPTIONAL ADA THRESHOLD DETAIL
FOR DETAIL NOT SHOWN, SEE OTHER SECTIONS

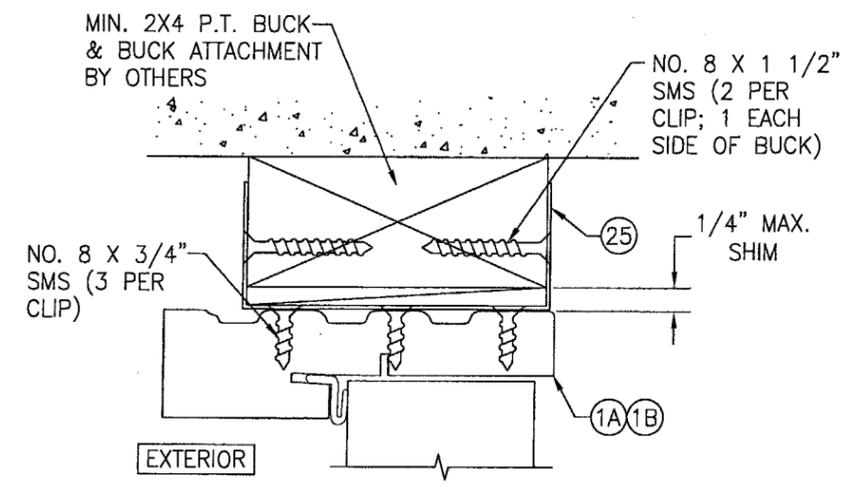


OPTIONAL CLIP MOUNT DETAIL
FOR DETAIL NOT SHOWN, SEE OTHER SECTIONS (HEAD SECTION SHOWN, SIDES AND SILL SIMILAR)

PRODUCT REVISED
as complying with the Florida Building Code
Acceptance No. 05-0901.13
Expiration Date 02/12/10
By *M. Shultz*
Miami Dade Product Control Division


DRAWN BY: K.P.S.		CHECKED BY: W.W.S.	
PLOT: 1-2		DATE: 06/28/04	
NO.	REVISION DESCRIPTION	BY	DATE
DRAWING TITLE: 10 FOOT WOOD INSWING IMPACT DOORS			
CONSULTANTS: W. W. SCHAEFER ENGINEERING & CONSULTING, P.A.		MANUFACTURER: SIGNATURE DOOR INC.	
8885 N. MILITARY TRAIL, SUITE C-204 PALM BEACH GARDENS, FL 33410 PHONE: 561-775-4902 FAX: 561-775-4903		401 JUNIATA STREET ALTOONA, PA 16602 814-949-2770	
CERTIFICATION: AUG 24 2005		WARREN W. SCHAEFER, P.E. P.E. NO. 44135	
DRAWING NO. 1315		REV. A	
SHEET NO. 7		OF 11	

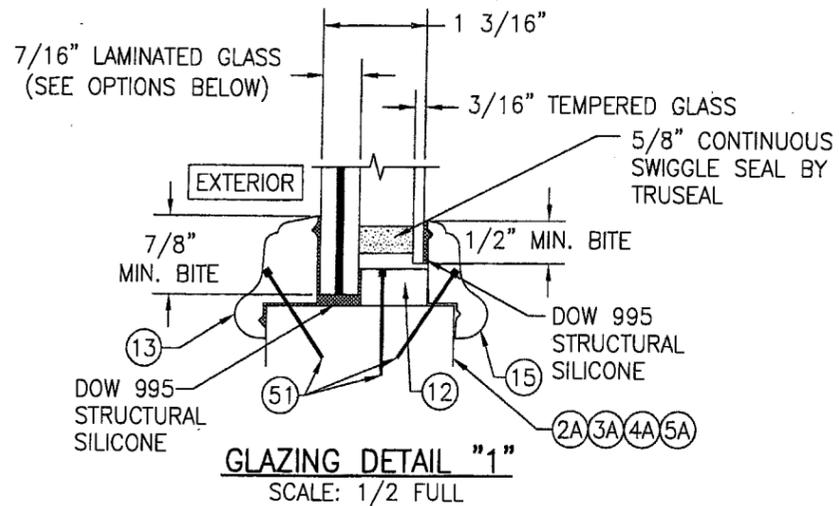


GLASS OPTION: 1) 7/16" THICK GLASSLAM SAFETY PLUS II LAMINATED OUTER GLASS (3/16" AN/0.10" POLYURETHANE POLYMER/3/16" AN); 3/16" TEMPERED SINGLE PANE INNER GLASS
 2) 7/16" THICK OLDCASTLE STORMGLASS LAMINATED OUTER GLASS (3/16" AN/0.075" STORMGLASS/3/16" AN); 3/16" TEMPERED SINGLE PANE INNER GLASS

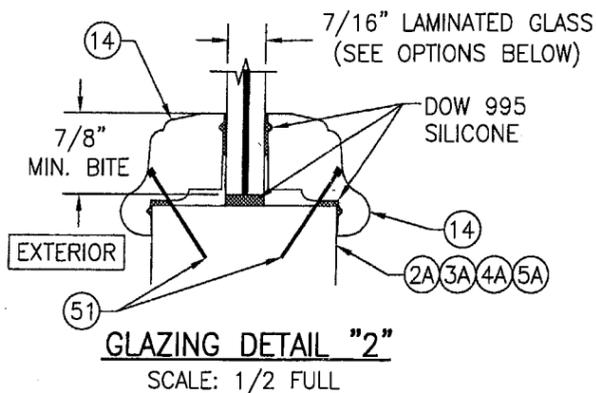



GLASS OPTION: 1) 7/16" THICK GLASSLAM SAFETY PLUS II LAMINATED GLASS (3/16" AN/0.10" POLYURETHANE POLYMER/3/16" AN)
 2) 7/16" THICK OLDCASTLE STORMGLASS LAMINATED GLASS (3/16" AN/0.075" STORMGLASS/3/16" AN)

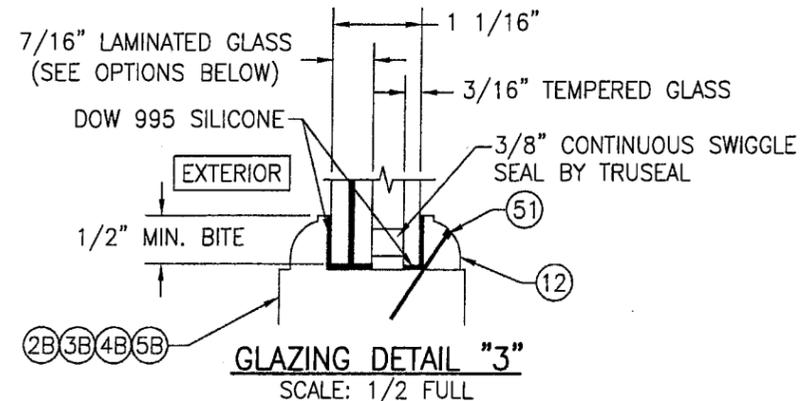

GLASS OPTION: 1) 7/16" THICK GLASSLAM SAFETY PLUS II LAMINATED OUTER GLASS (3/16" AN/0.10" POLYURETHANE POLYMER/3/16" AN); 3/16" TEMPERED SINGLE PANE INNER GLASS
 2) 7/16" THICK OLDCASTLE STORMGLASS LAMINATED OUTER GLASS (3/16" AN/0.075" STORMGLASS/3/16" AN); 3/16" TEMPERED SINGLE PANE INNER GLASS






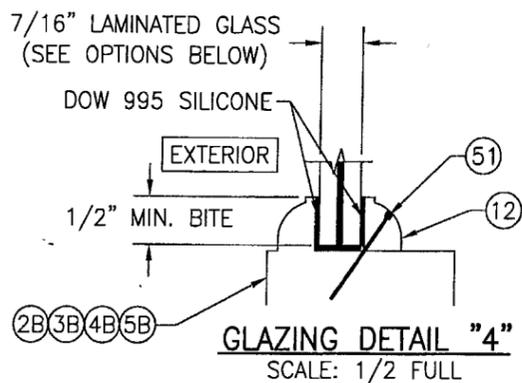


GLASS OPTION: 1) 7/16" THICK GLASSLAM SAFETY PLUS II LAMINATED GLASS (3/16" AN/0.10" POLYURETHANE POLYMER/3/16" AN)
 2) 7/16" THICK OLDCASTLE STORMGLASS LAMINATED GLASS (3/16" AN/0.075" STORMGLASS/3/16" AN)








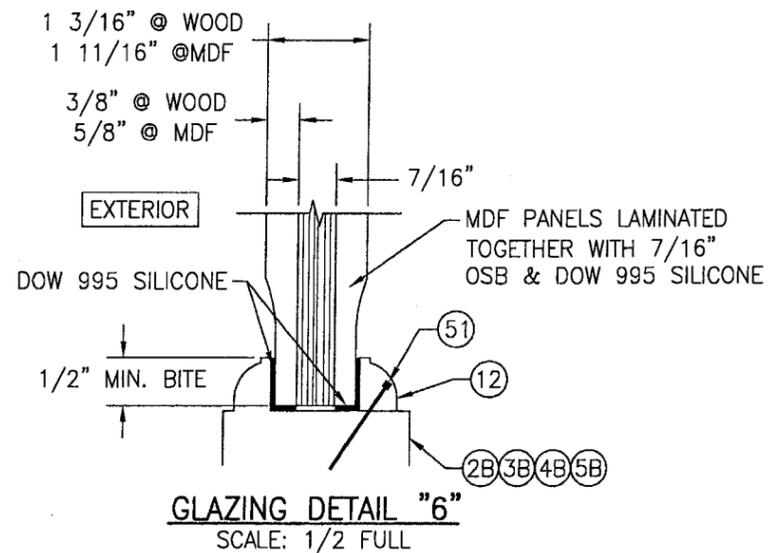
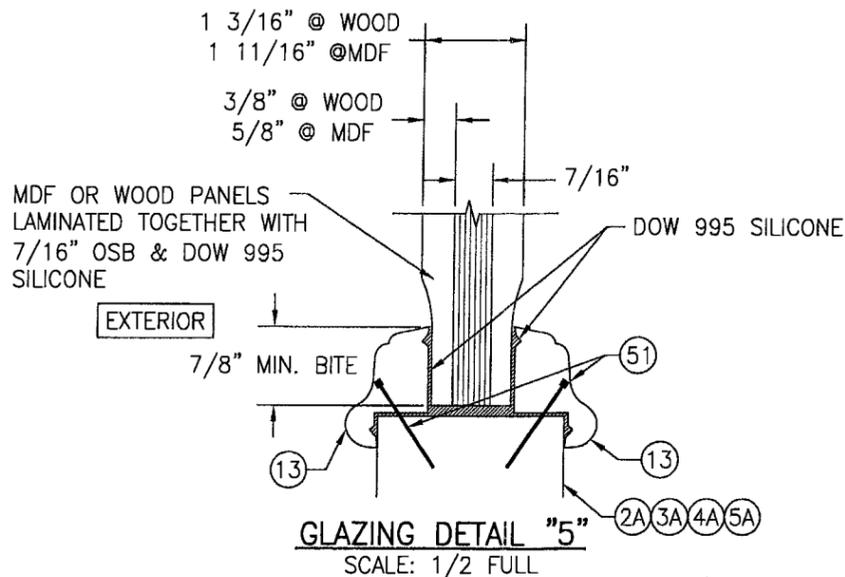


PRODUCT REVISED
 as complying with the Florida
 Building Code
 Acceptance No. 05-0901.13
 Expiration Date 02/13/10
 By *M. Thabi*
 Miami Dade Product Control
 Division

DRAWN BY: K.P.S.	CHECKED BY: W.W.S.
PLOT: 1=2	DATE: 06/28/04
NO.	REVISION DESCRIPTION
DATE	BY
DRAWING TITLE 10 FOOT WOOD INSWING IMPACT DOORS	
MANUFACTURER SIGNATURE DOOR INC. 401 JUNIATA STREET ALTOONA, PA 16602 814-949-2770	
CONSULTANTS W. W. SCHAEFER ENGINEERING & CONSULTING, P.A. 8895 N. MILITARY TRAIL, SUITE C-204 PALM BEACH GARDENS, FL 33410 PHONE: 561-775-4802 FAX: 561-775-4903	
CERTIFICATION	P.E.
AUG 24 2005	WARREN W. SCHAEFER, P.E. P.E. NO. 44135
DRAWING NO. 1315	REV. A
SHEET NO. 8 OF 11	

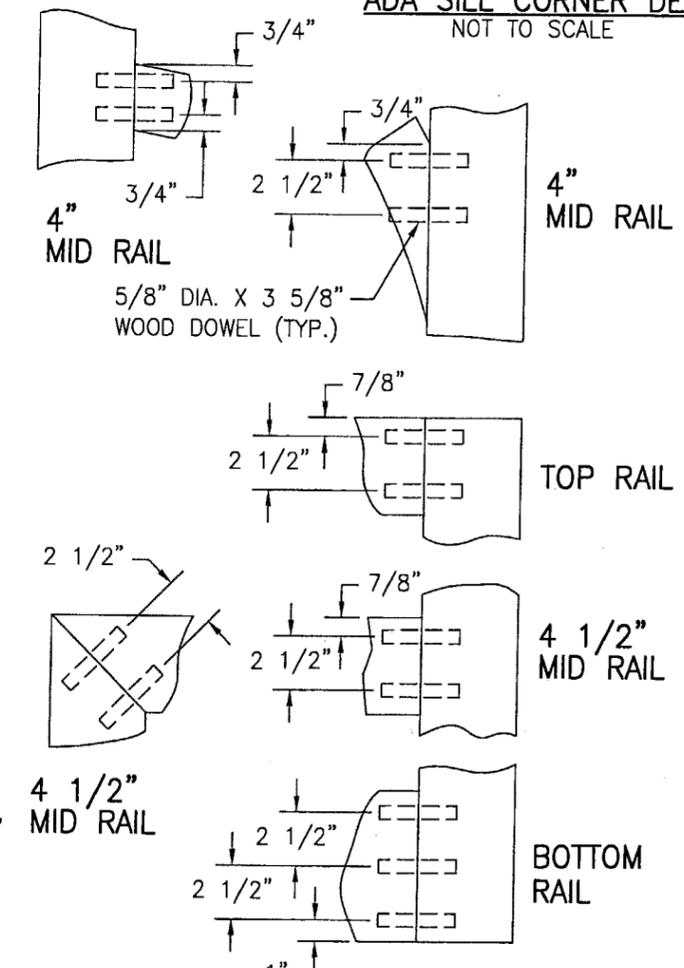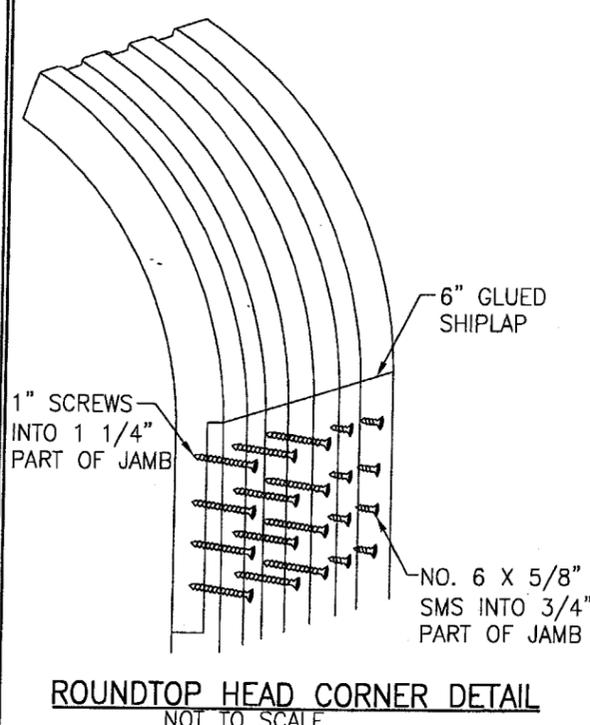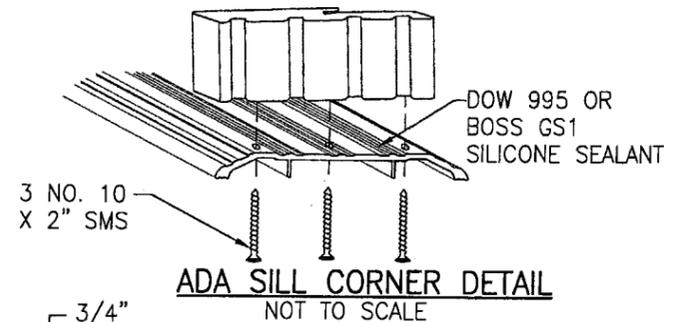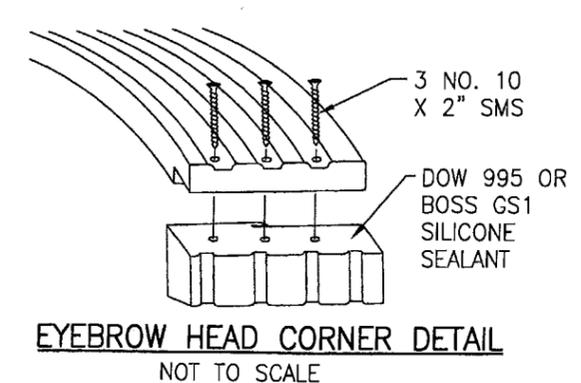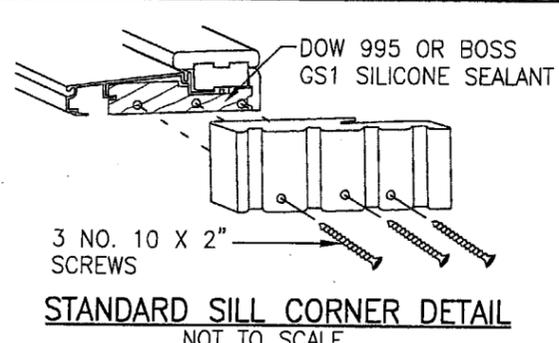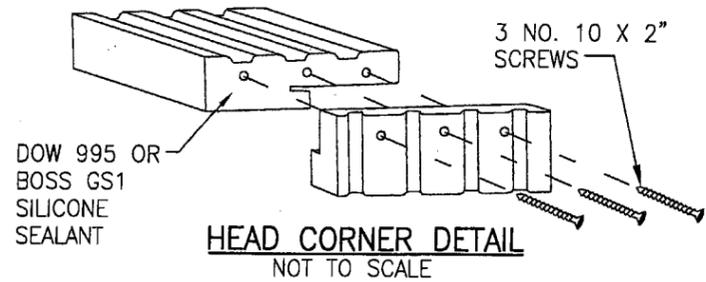


ALL DOWEL AND WOOD TO WOOD CONTACT SURFACES ARE FULLY GLUED WITH WOOD ADHESIVE BY KORLOCK GT 42-300A OR TITEBOND II BY WEATHERPROOF.

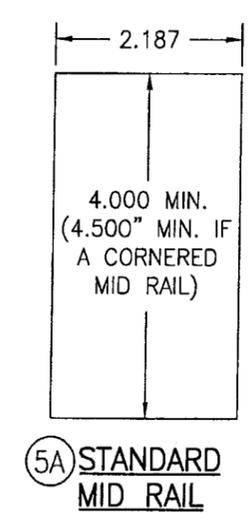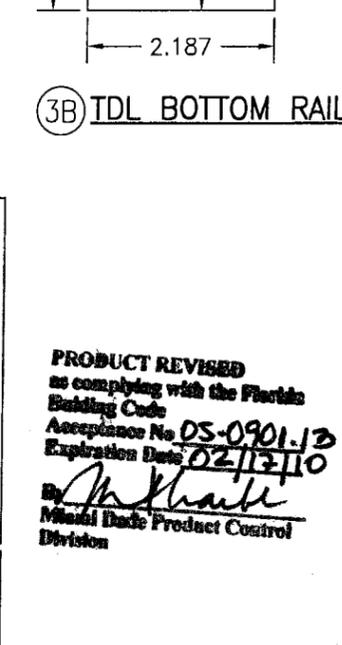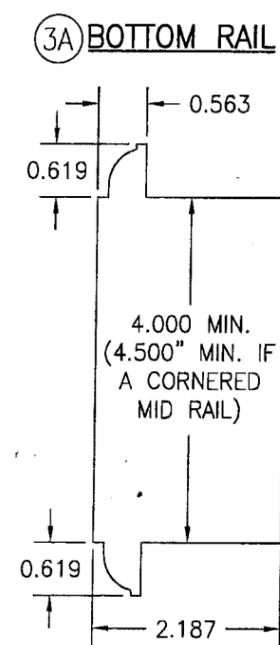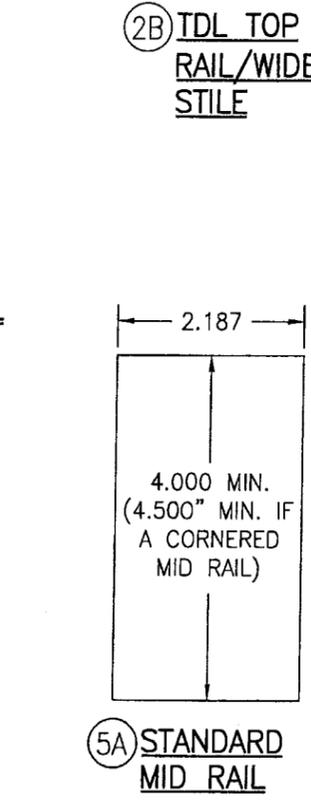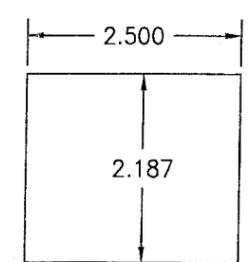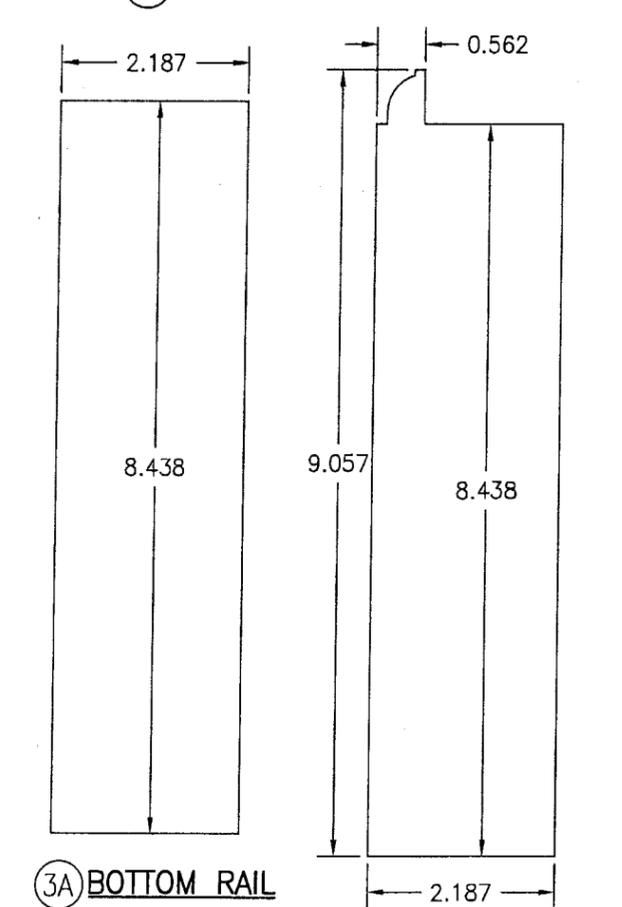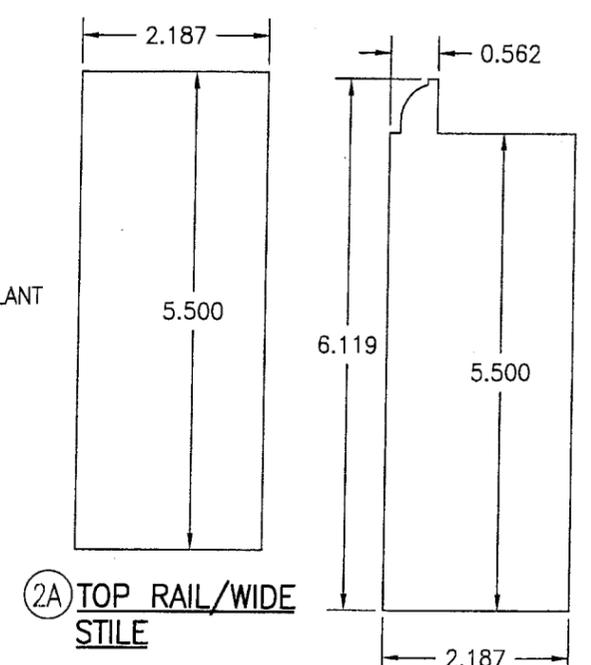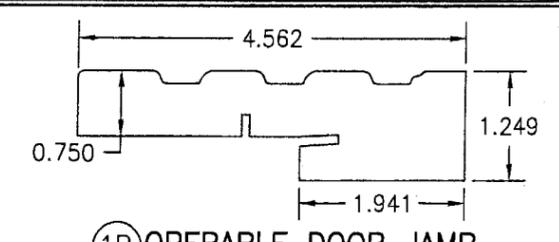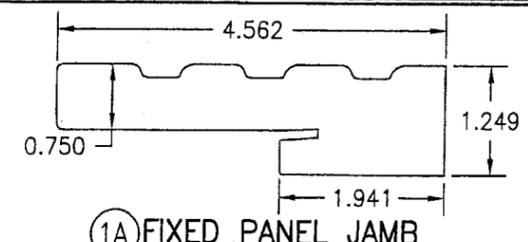

DRAWN BY: K.F.S.		CHECKED BY: W.W.S.	
PLOT: 1=2		DATE: 06/28/04	
DATE	BY	REVISION DESCRIPTION	NO.
DRAWING TITLE 10 FOOT WOOD INSWING IMPACT DOORS			
CONSULTANTS W. W. SCHAEFER ENGINEERING & CONSULTING, P.A.		MANUFACTURER SIGNATURE DOOR INC.	
8895 N. MILITARY TRAIL, SUITE C-204 PALM BEACH GARDENS, FL 33410 PHONE: 561-775-4902 FAX: 561-775-4903		401 JUNIATA STREET ALTOONA, PA 16602 814-949-2770	
CERTIFICATION AUG 24 2005		WARREN J. SCHAEFER, P.E. P.E. NO. 44135	
DRAWING NO. 1315		REV. A	
SHEET NO. 9		OF 11	

PRODUCT REVISED
as complying with the Florida Building Code
Acceptance No **DS-0901-13**
Expiration Date **02/13/10**
By *Warren J. Schaefer*
Miami Dade Product Control Division

ITEM #	ITEM DESCRIPTION	MANUFACTURER/NOTES
PARTS		
1A	FIXED PANEL JAMB	* WOOD (LAMINATED WITH CURVED JAMB)
1B	OPERABLE DOOR JAMB	* WOOD (LAMINATED WITH CURVED JAMB)
2A	TOP RAIL/WIDE STILE	LAMINATED RED OAK CORE (PINE VENEER)
2B	TDL TOP RAIL/WIDE STILE	LAMINATED RED OAK CORE (PINE VENEER)
3A	BOTTOM RAIL	LAMINATED RED OAK CORE (PINE VENEER)
3B	TDL BOTTOM RAIL	LAMINATED RED OAK CORE (PINE VENEER)
4A	FIXED SMALL STILE	LAMINATED RED OAK CORE (PINE VENEER)
4B	TDL FIXED SMALL STILE	LAMINATED RED OAK CORE (PINE VENEER)
5A	STANDARD MID RAIL	LAMINATED RED OAK CORE (PINE VENEER)
5B	TDL MID RAIL	LAMINATED RED OAK CORE (PINE VENEER) OR 3-PIECE EASTERN PINE CORE (PINE VENEER)
7	ASTRAGAL	* WOOD
8	MULLION BAR	A36 STEEL
9	WOOD MULLION	LVL OR LAMINATED RED OAK CORE (PINE VENEER)
11	GLASS STOP	* WOOD
12	GLAZING BEAD	* WOOD
13	GLAZING BEAD	* WOOD
14	GLAZING BEAD	* WOOD
15	GLAZING BEAD	* WOOD
19	INSWING & OUTSWING BUMPER THRESHOLD	IMPERIAL 5QCW
20	ADA THRESHOLD	HAGAR 401-S
21	ACTIVE PANEL & HINGE STILE REINF.	STAINLESS STEEL
22	INACTIVE PANEL REINFORCEMENT	STAINLESS STEEL
23	HEAD STRIKE PLATE	STAINLESS STEEL
24	SILL STRIKE PLATE	STAINLESS STEEL
25	MOUNTING CLIP	18 GA. GALVANIZED STEEL
26	JAMB REINF. PLATE (.044" X 4.00" X 16.00")	18 GA. GALVANIZED STEEL
HARDWARE		
27	4.5" X 4.5" BALL BEARING HINGE	BALDWIN 1046.003 (BRASS)
28	4.5" X 4.5" BALL BEARING HINGE	PENROD MH4.5BBTPSQ-SQBB (STEEL)
29	4.5" X 4.5" BALL BEARING HINGE	PENROD MH4.5BBTPSQ-SQSB (BRASS)
30	5-POINT ACTIVE PANEL LOCK SYS.	HOPPE HLS9000 ROUND BOLT/SHOOT BOLT
31	2-POINT INACTIVE PANEL LOCK SYS.	HOPPE HLS9000 SHOOT BOLT
32	3-POINT ACTIVE PANEL LOCK SYS.	HOPPE HLS9000 ROUND BOLT
33	5-POINT ACTIVE PANEL LOCK SYS. (3-POINT AT SINGLE DOOR)	GU RHINO
34	2-POINT INACTIVE PANEL LOCK SYS.	GU EUROPA
35	5-POINT ACTIVE PANEL LOCK SYS. (3-POINT AT SINGLE DOOR)	KFV 7370-S. BOLT
36	2-POINT INACTIVE PANEL LOCK SYS.	KFV 7000
37	HANDLE	AS REQ'D TO FIT LOCK SYSTEM
38	LOCK STRIKE PLATE	AS SUPPLIED WITH LOCK SYSTEM
SEALS AND SEALANTS		
40	DOOR SWEEP	IMPERIAL FBS30B/FBS36B
42	WEATHER SEAL	HOLM INDUSTRIES JF65814
MISC. FASTENERS		
43	NO. 10 X 2" SMS	2 PER HINGE LEAF INTO PANEL W/BRASS HINGES
44	NO. 10 X 3/4" SMS	2 PER HINGE LEAF INTO JAMB & PANEL
45	NO. 12 X 2" SMS	2 PER HINGE LEAF INTO PANEL W/STEEL HINGES
46	NO. 12 X 2" SMS	2 PER HINGE LEAF INTO WOOD MULLION
47	NO. 12 X 3" SMS	2 PER HINGE LEAF INTO STEEL MULLION/SIDELIGHT
48	NO. 10 X 2" SMS	4 PER DOOR REINFORCEMENT PLATE
49	NO. 10 X 2" SMS	6" FROM CORNERS & 16" MAX O.C.
50	NO. 10 X 2 1/2" SMS	6" FROM CORNERS & MID SPAN ON SILL
51	1 3/16" BRAD NAIL	1" FROM CORNERS & 8" O.C.
52	3/4" STAPLE	3/4" FROM CORNERS & 6" O.C. STAGGERED
53	NO. 10 X 2 1/2" SMS	3" FROM ENDS & 22" O.C. THRU ASTRAGAL
54	NO. 6 X 3/4" SCREW	2 PER STRIKE PLATE

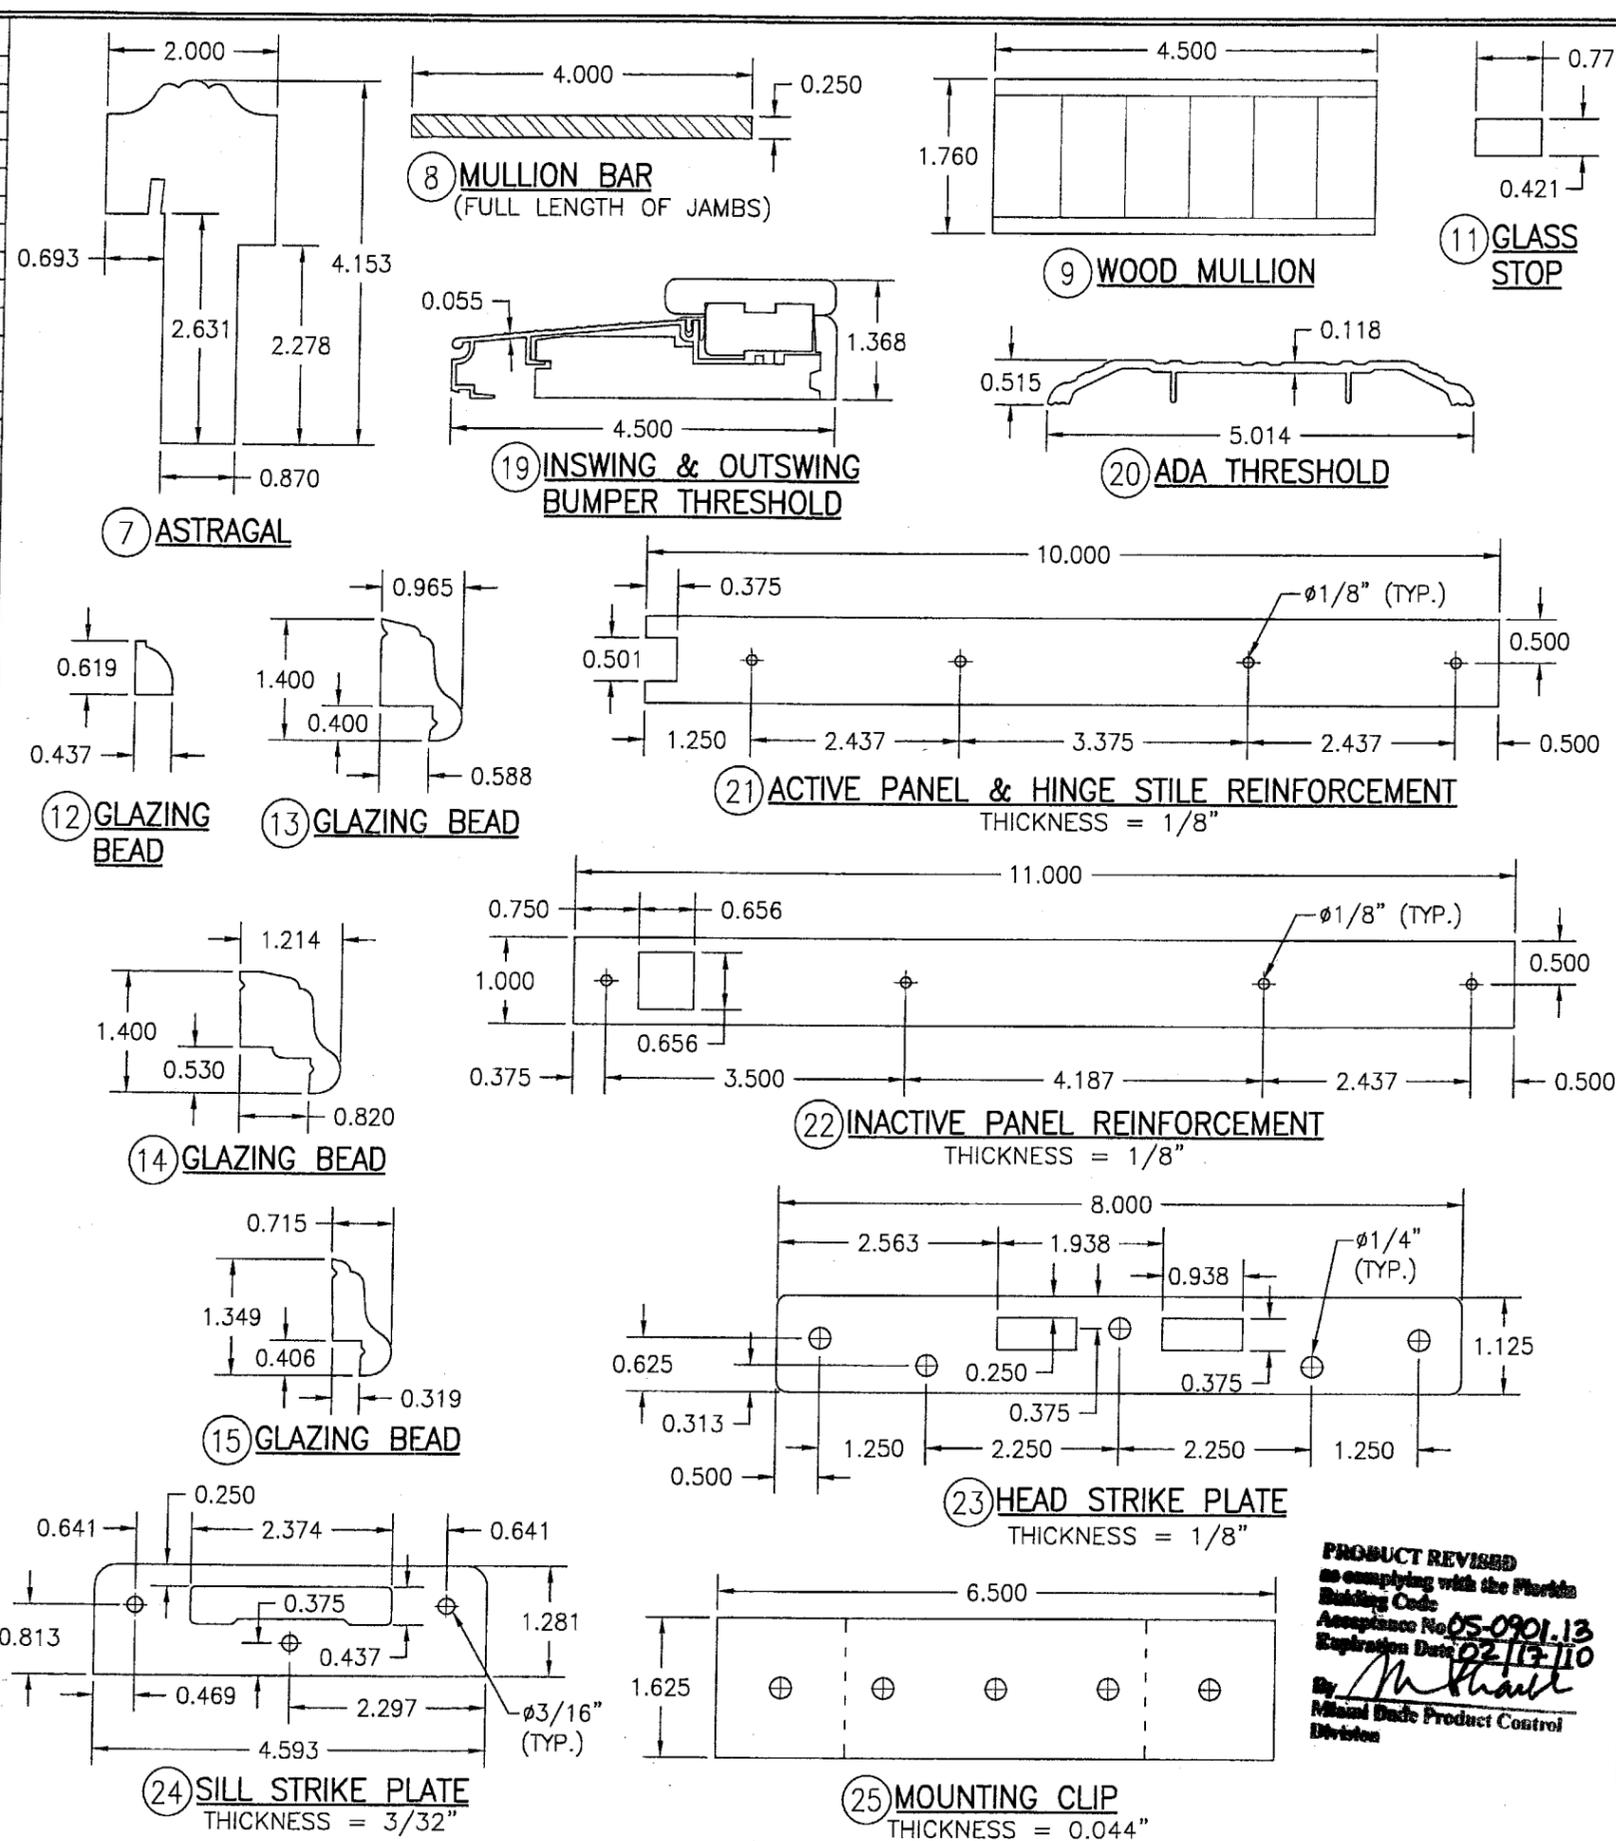

* WOOD USED WITH TEST UNITS WAS SELECT EASTERN WHITE PINE. WOOD SPECIES TO BE APPLICABLE WITH THESE WINDOWS IS MIN. SELECT MAHOGANY, SOUTHERN PINE, PONDEROSA PINE, OAK, CHERRY, MAPLE, DOUGLAS FIR, TEAK, CYPRUS & ANY OTHER SELECT WOOD STRONGER THAN EASTERN PINE.

PRODUCT REVISED
as complying with the Florida Building Code
Acceptance No. 05-0901.13
Expiration Date 02/17/10
By: *Warren W. Schaefer*
Miami Dade Product Control Division

DRAWN BY: K.P.S.	CHECKED BY: W.W.S.
PLOT: 1=2	DATE: 06/28/04
NO.	REVISION DESCRIPTION
DATE	BY
10 FOOT WOOD INSWING IMPACT DOORS	
MANUFACTURER	
SIGNATURE DOOR INC. 401 JUNIATA STREET ALTOONA, PA 16602 814-949-2770	
CONSULTANTS	
W. W. SCHAEFER ENGINEERING & CONSULTING, P.A. 8895 N. MILITARY TRAIL, SUITE C-204 PALM BEACH GARDENS, FL 33410 PHONE: 561-775-4802 FAX: 561-775-4803	
DRAWING TITLE	
CERTIFICATION	
AUG 24 2005	
WARREN W. SCHAEFER, P.E. P.E. NO. 44135	
DRAWING NO. 1315	REV. A
SHEET NO. 10 OF 11	

ALLOWABLE DESIGN PRESSURE (DOUBLE DOORS)			
MAXIMUM FRAME WIDTH (IN.)	MAXIMUM FRAME HEIGHT (IN.)	DESIGN PRESSURE	
		POSITIVE (PSF)	NEGATIVE (PSF)
98.75	121.75	50.0	50.0
	110	55.3	55.3
	98	62.1	62.1
93	121.75	53.1	53.1
	110	58.8	58.8
	98	65.0	66.0
87	121.75	56.8	56.8
	110	62.8	62.8
	98	65.0	70.5
81	121.75	61.0	61.0
	110	65.0	67.5
	98	65.0	75.7
74.25	121.75	65.0	66.5
	110	65.0	73.6
	98	65.0	80.0
68	121.75	65.0	72.6
	110	65.0	80.0
62	121.75	65.0	79.6

ALLOWABLE DESIGN PRESSURE (SINGLE DOORS)			
MAXIMUM FRAME WIDTH (IN.)	MAXIMUM FRAME HEIGHT (IN.)	DESIGN PRESSURE	
		POSITIVE (PSF)	NEGATIVE (PSF)
49.75	121.75	50.0	50.0
	110	55.3	55.3
	98	60.4	60.4
47	121.75	52.9	52.9
	110	58.6	58.6
	98	63.2	63.9
44	121.75	56.5	56.5
	110	62.6	62.6
	98	65.0	68.3
41	121.75	60.7	60.7
	110	65.0	67.2
	98	65.0	73.3
37.5	121.75	65.0	66.3
	110	65.0	73.4
	98	65.0	80.0
35	121.75	65.0	71.1
	110	65.0	78.7
31	121.75	65.0	80.0

ALLOWABLE DESIGN PRESSURE (TRANSOM MULLION)			
MAXIMUM FRAME WIDTH (IN.)	MAXIMUM OVERALL HEIGHT (IN.)	DESIGN PRESSURE	
		POSITIVE (PSF)	NEGATIVE (PSF)
98.75	173.75	50.0	50.0
	162	53.6	53.6
	150	57.9	57.9
	138	63.0	63.0
	126	65.0	68.9
	114	65.0	76.2
93	173.75	53.1	53.1
	162	56.9	56.9
	150	61.5	61.5
	138	65.0	66.8
	126	65.0	73.2
	114	65.0	80.0
87	173.75	56.8	56.8
	162	60.9	60.9
	150	65.0	65.7
	138	65.0	71.5
	126	65.0	78.3
	114	65.0	80.0
81	173.75	61.0	61.0
	162	65.0	65.4
	150	65.0	70.6
	138	65.0	76.7
74.25	173.75	65.0	66.5
	162	65.0	71.3
	150	65.0	77.0
	138	65.0	80.0

NOTE:
WITH MULLED UNITS, ALLOWABLE PRESSURE FOR THE OVERALL UNIT SHALL BE THE LESSER OF THE ALLOWABLE PRESSURE FOR THE INDIVIDUAL DOORS AND MULLION.

ALLOWABLE DESIGN PRESSURE
(VERTICAL MULLION)
AS CONTROLLED BY DOOR
PRESSURE TABLES

PRODUCT REVISED
as complying with the Florida
Building Code
Acceptance No. 05-0901.13
Expiration Date 02/12/10
By *M. Khalil*
Miami Door Product Control
Division

DRAWN BY: K.P.S. CHECKED BY: W.W.S.
PLOT: 1-2 DATE: 06/24/04

NO.	REVISION DESCRIPTION	DATE	BY

DRAWING TITLE: 10 FOOT WOOD INSWING IMPACT DOORS
CONSULTANTS: W. W. SCHAEFER ENGINEERING & CONSULTING, P.A.
MANUFACTURER: SIGNATURE DOOR INC.
401 JUNIATA STREET
ALTOONA, PA 16602
814-949-2770

8895 N. MILITARY TRAIL, SUITE C-204
PALM BEACH GARDENS, FL 33410
PHONE: 561-775-4902 FAX: 561-775-4903

CERTIFICATION
AUG 24 2005
WARREN W. SCHAEFER, P.E.
P.E. NO. 44135

DRAWING NO. 1315 REV. A
SHEET NO. 11 OF 11