



**BUILDING CODE COMPLIANCE OFFICE (BCCO)  
PRODUCT CONTROL DIVISION**

**MIAMI-DADE COUNTY, FLORIDA  
METRO-DADE FLAGLER BUILDING  
140 WEST FLAGLER STREET, SUITE 1603  
MIAMI, FLORIDA 33130-1563  
(305) 375-2901 FAX (305) 375-2908  
[www.buildingcodeonline.com](http://www.buildingcodeonline.com)**

**NOTICE OF ACCEPTANCE (NOA)**

**Wayne Dalton Corporation  
3395 Addison Drive  
Pensacola, Florida 32514**

**SCOPE:** This NOA is being issued under the applicable rules and regulations governing the use of construction materials. The documentation submitted has been reviewed by the BCCO and accepted by the Building Code and Product Review Committee (BCPRC) to be used in Miami Dade County and other areas where allowed by the Authority Having Jurisdiction (AHJ).

This NOA shall not be valid after the expiration date stated below. The BCCO (In Miami Dade County) and/or the AHJ (in areas other than Miami Dade County) reserve the right to have this product or material tested for quality assurance purposes. If this product or material fails to perform in the accepted manner, the manufacturer will incur the expense of such testing and the AHJ may immediately revoke, modify, or suspend the use of such product or material within their jurisdiction. BCPRC reserves the right to revoke this acceptance, if it is determined by BCCO that this product or material fails to meet the requirements of the applicable building code.

This product is approved as described herein, and has been designed to comply with the Florida Building Code including the High Velocity Hurricane Zone.

**DESCRIPTION: Waynemark 8000 Garage Door 16'-2" Wide.**

**APPROVAL DOCUMENT:** Drawing No.0116, Sheets 1 through 2 of 2, titled "Waynemark 8000 & 8100 Raised Panel Design Pressure: +31.0 PSF/-33.0PFS" dated 06/28/01, with last revision on 01/02/02, prepared by Wayne Dalton, signed and sealed by W.S. Wilson, PE. bearing the Miami-Dade County Product Control Renewal stamp with the NOA number and expiration date by the Miami-Dade County Product Control Division.

**MISSILE IMPACT RATING: Large & Small Missile.**

**LABELING:** Each unit shall bear a permanent label with the manufacturer's name or logo, city, state and following statement: "Miami-Dade County Product Control Approved or MDPCA", unless otherwise noted herein.

**RENEWAL** of this NOA shall be considered after a renewal application has been filed and there has been no change in the applicable building code negatively affecting the performance of this product.

**TERMINATION** of this NOA will occur after the expiration date or if there has been a revision or change in the materials, use, and/or manufacture of the product or process. Misuse of this NOA as an endorsement of any product, for sales, advertising or any other purposes shall automatically terminate this NOA. Failure to comply with any section of this NOA shall be cause for termination and removal of NOA.


**LIMITATION:** This approval requires the manufacturer to do testing of all coils used to fabricate door panel under this Notice of Acceptance. A minimum of 2 specimens shall be cut from each coil and tensile tested according to ASTM E-8 by a Miami-Dade County approved laboratory selected and paid by the manufacturer. Every 3 months, four times a year, the manufacturer shall mail to this office: a copy of the tested reports with confirmation that the specimens were selected from coils at the manufacturer production facilities, and a notarized statement from the manufacturer that only coils with yield strength of 50,000 psi or more shall be used to make panels for Miami Dade County under this Notice of Acceptance.

**ADVERTISEMENT:** The NOA number preceded by the words Miami-Dade County, Florida, and followed by the expiration date may be displayed in advertising literature. If any portion of the NOA is displayed, then it shall be done in its entirety.

**INSPECTION:** A copy of this entire NOA shall be provided to the user by the manufacturer or its distributors and shall be available for inspection at the job site at the request of the Building Official.

**This NOA renews NOA # 01-0813.02** and consists of this page, evidence page as well as approval document mentioned above.

The submitted documentation was reviewed by **Candido E. Font PE.**

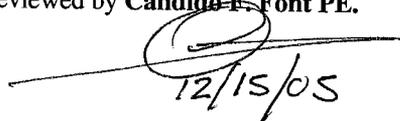  
12/15/05



**NOA No: 05-0912.10  
Expiration Date February 07, 2011  
Approval Date: December 15, 2005  
Page 1**

Wayne Dalton Corporation.

**NOTICE OF ACCEPTANCE: EVIDENCE PAGE**

**A DRAWINGS**

1. Drawing prepared by Wayne-Dalton Corporation titled "Waynemark 8000 & 8100 Raised Panel Design Pressure: +31 psf / -33 psf.", Drawing No. 0116 dated 06/28/2001 with latest revision on 01/02/02 Sheets 1 to 2 of 2 signed and sealed by W. S. Wilson, PE.

**B TEST**

1. Test Report on Large Missile Impact Test and Cyclic Wind Pressure Test of "Sectional Residential Garage Door Waynemark 8000-0113" prepared by Hurricane Engineering and Testing Inc. Report #01-995 dated 04/04/01 signed and sealed by HM Medina, PE.
2. Test Report on Uniform Static Air Pressure & Forced Entry Resistance Test "Sectional Residential Garage Door Waynemark 8000-0113" prepared by Hurricane Engineering and Testing Inc., Report No. 01-994, dated 04/02/2001, signed and sealed by HM Medina, PE.
3. Test Report on ASTM B117-90 Test of 3"x9" galvanized panels (controls) & painted panels prepared by Sub-Tropical Testing Service, Test Number WDC-1, dated 04/26/0, signed and sealed by illegible.

**C CALCULATIONS**

1. Anchor Method Summary, prepared by W. S. Wilson, Sheets 1 through 5 prepared, signed and sealed by W. S. Wilson, PE on 08/02/01.

**D QUALITY ASSURANCE**


1. Building Code Compliance Office.


**D MATERIAL CERTIFICATION**

- 1 Tensile Test Report No. 01-T036, prepared by Hurricane Engineering & Testing dated 04/17/01, signed and sealed by HM Medina, PE.

**E STATEMENTS**

- 1 Letter of code compliance issued by Wayne-Dalton Corporation, signed & sealed by W. S. Wilson, PE. on 08/02/01.
- 2 Letter on Non Financial Interest issued by Wayne-Dalton Corporation, signed & sealed by W. S. Wilson, PE on 08/02/01.
- 3 Letter of no fabrication for Dade County of approved door under this NOA prepared by Wayne Dalton on 10/25/05 and signed by M. R. Barrow PE.

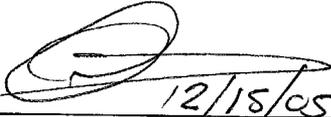  
12/15/05  
Candido F. Font PE.  
Sr. Product Control Examiner  
NOA No 05-0912.10  
Expiration Date: February 07, 2011  
Approval Date: December 15, 2005

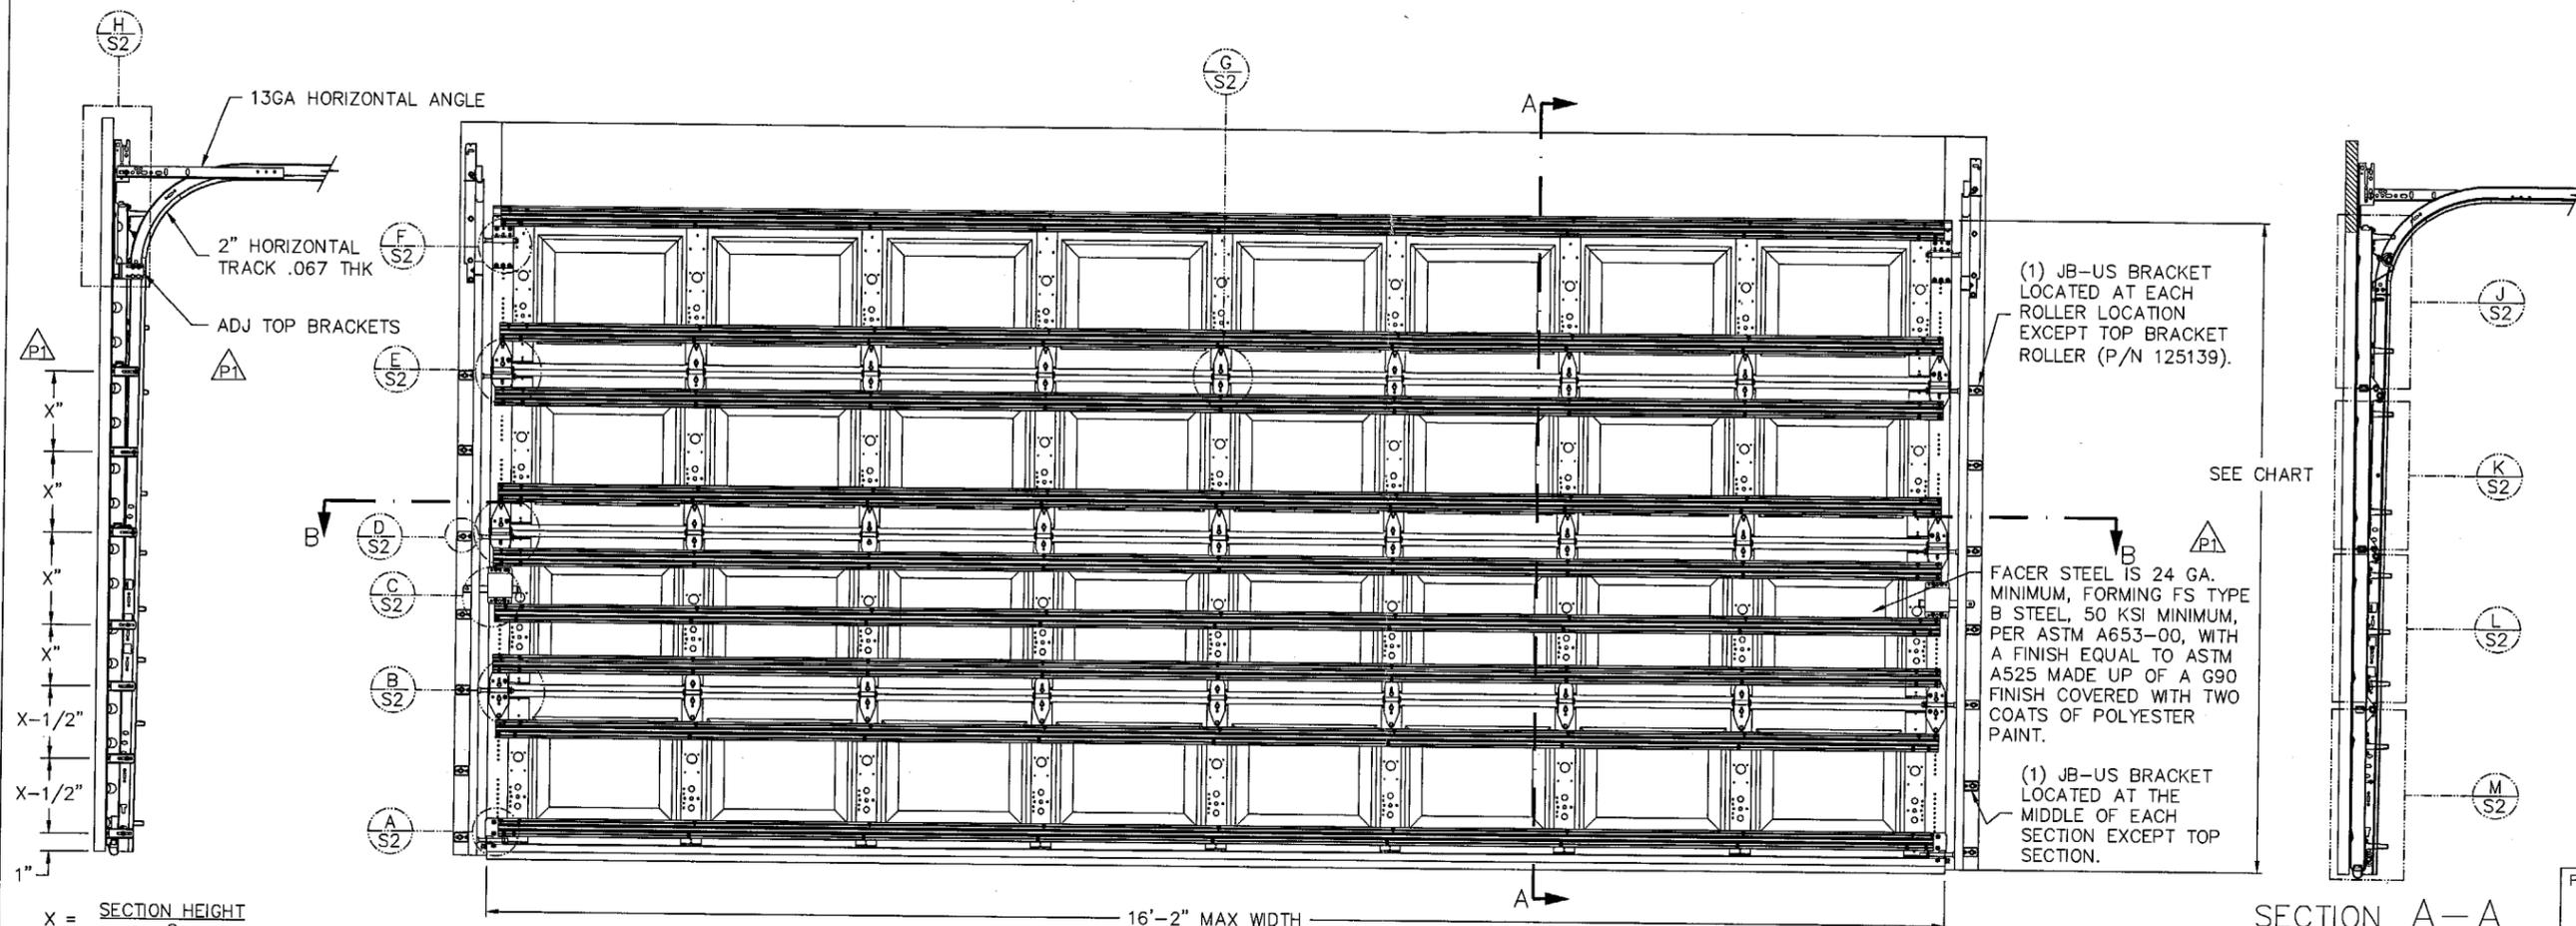


x = SECTION HEIGHT / 2

16'-2" MAX WIDTH

SECTION A-A

PART NO. 296540  
 R & D RELEASE TO PRODUCT ENGINEERING  
 BY: [Signature]  
 CHANGES  
 P1 REV NOTES AND DESCR PER DADE CNTY MARK UPS. 10/18/01 DCC  
 P2 ADDED NOTE FOR PRESSURE REQUIREMENTS 01/02/02 SAD

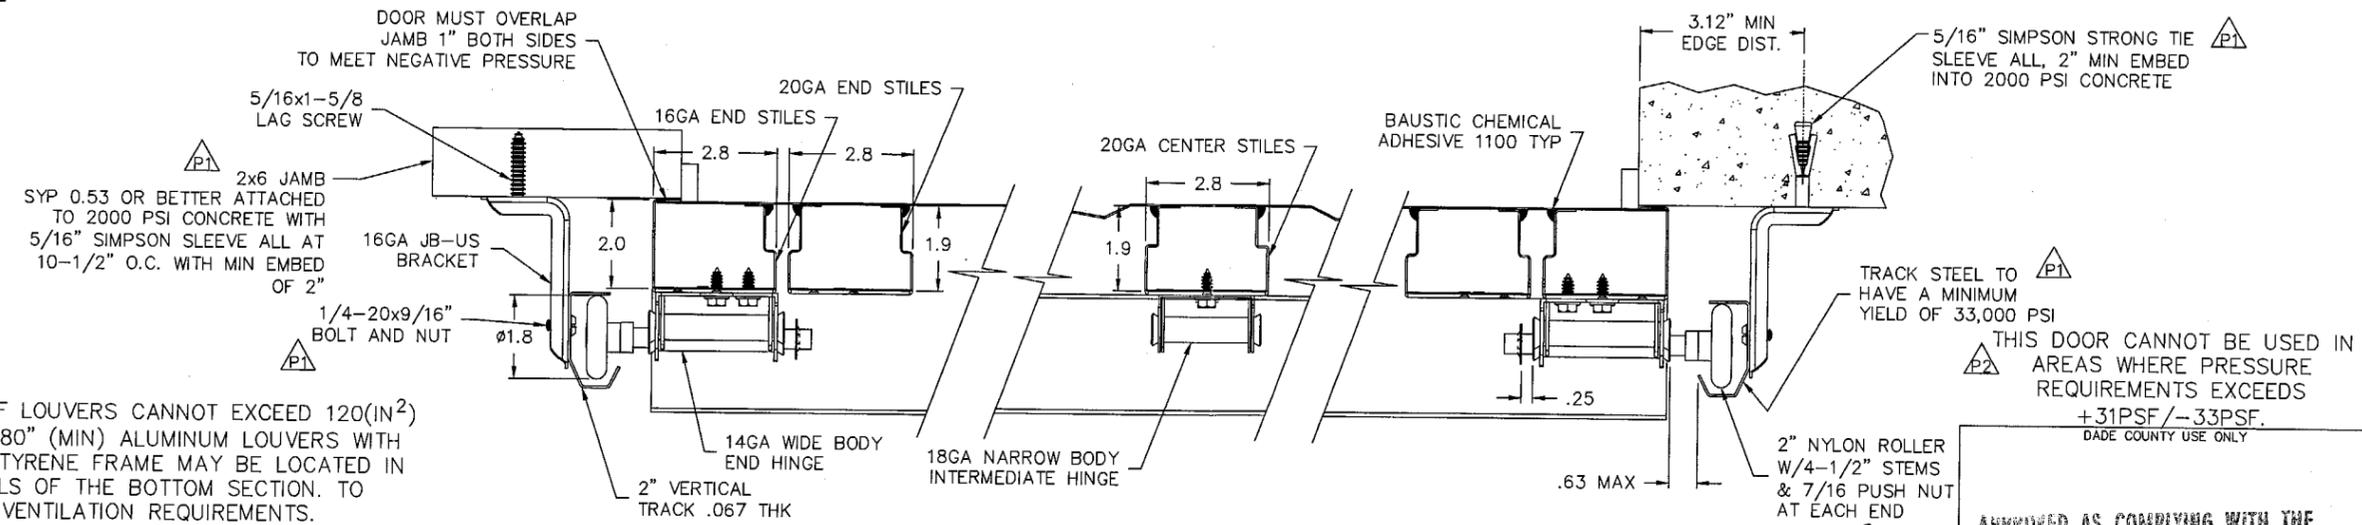

NOTE:  
 TOTAL AREA OF LOUVERS CANNOT EXCEED 120(IN<sup>2</sup>)  
 OPTIONAL - .080" (MIN) ALUMINUM LOUVERS WITH HIGH IMPACT STYRENE FRAME MAY BE LOCATED IN THE END PANELS OF THE BOTTOM SECTION. TO MEET MINIMUM VENTILATION REQUIREMENTS.

THIS DOOR CANNOT BE USED IN AREAS WHERE PRESSURE REQUIREMENTS EXCEEDS +31PSF / -33PSF. DADE COUNTY USE ONLY

DOOR HEIGHT	U-BARS	SECTION HEIGHTS								JB-US BRACKETS
		BOTTOM	#2	#3	#4	#5	#6	#7	TOP	
6'-6"	9	21"	18"	18"					21"	7
7'-0"	9	21"	21"	21"					21"	7
7'-6"	12	18"	18"	18"	18"				18"	9
8'-0"	12	21"	18"	18"	18"				21"	9
9'-0"	14	18"	18"	18"	18"	18"			18"	11
10'-0"	14	21"	21"	21"	18"	18"			21"	11
11'-0"	16	21"	18"	18"	18"	18"	18"		21"	13
12'-0"	16	21"	21"	21"	21"	21"	21"		18"	13
13'-0"	18	21"	21"	21"	18"	18"	18"	18"	21"	15
14'-0"	18	21"	21"	21"	21"	21"	21"	21"	21"	15



SECTION B-B

Approved: [Signature]  
 W.S. Wilson, P.E.  
 3395 ADDISON DR., PENSACOLA, FL 32514  
 FLORIDA CERTIFICATION NO. 0048489  
 GEORGIA CERTIFICATION NO. 018519  
 NORTH CAROLINA CERTIFICATION NO. 023836  
 Date: 1-3-02


APPROVED AS COMPLYING WITH THE SOUTH FLORIDA BUILDING CODE  
 DATE FEB 07 2002  
 BY [Signature]  
 PRODUCT CONTROL DIVISION  
 BUILDING CODE COMPLIANCE OFFICE  
 ACCEPTANCE NO. 01-0813.02

PRODUCT RENEWED as complying with the Florida Building Code  
 Acceptance No. 05-0912.10  
 Date: 02/27/11  
 By [Signature]  
 Miami Dade Product Control Division


	3395 ADDISON DRIVE PENSACOLA, FLORIDA 32514 (850) 474-9890		DATE: 6/28/2001	NAME: D. RESTER	SHEET 1 of 2	
	WAYNE MARK 8000 & 8100 RAISED PANEL		DRAWN	CHECKED		PROJECT: WINDLOAD/WMK8000
	DESIGN PRESSURE: +31.0 PSF / -33.0 PSF		APPR.	OPTION CODE: 0116		REV: P2

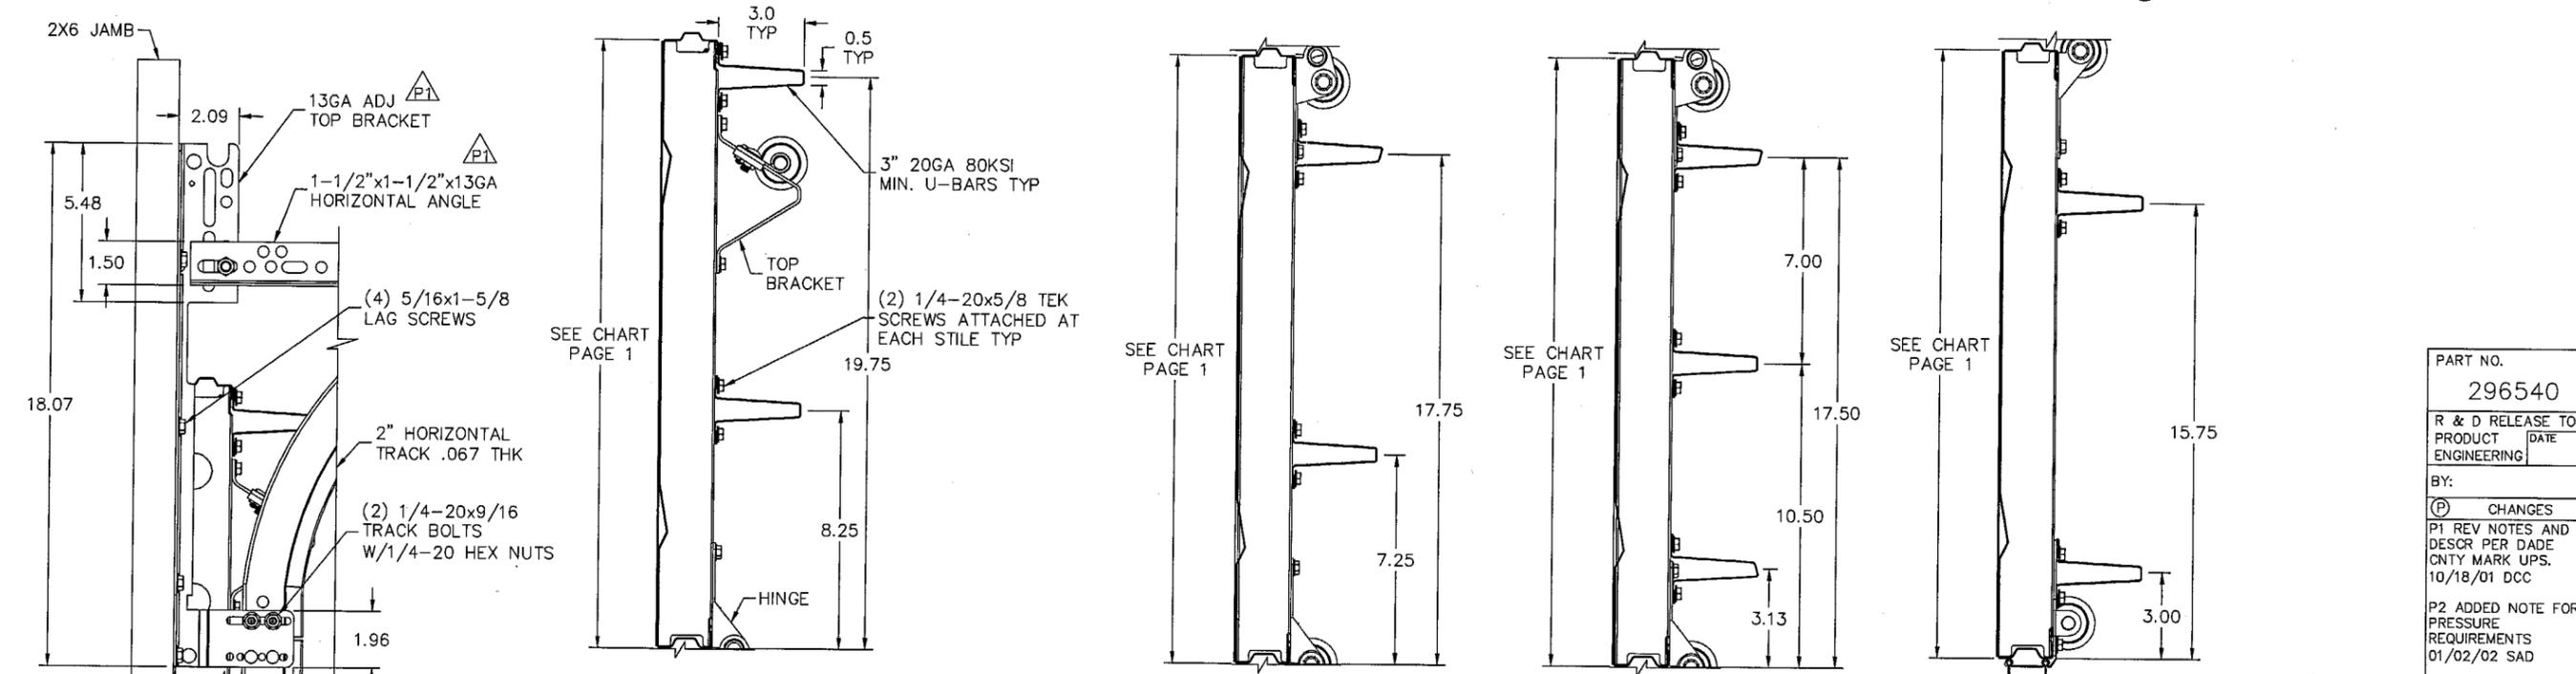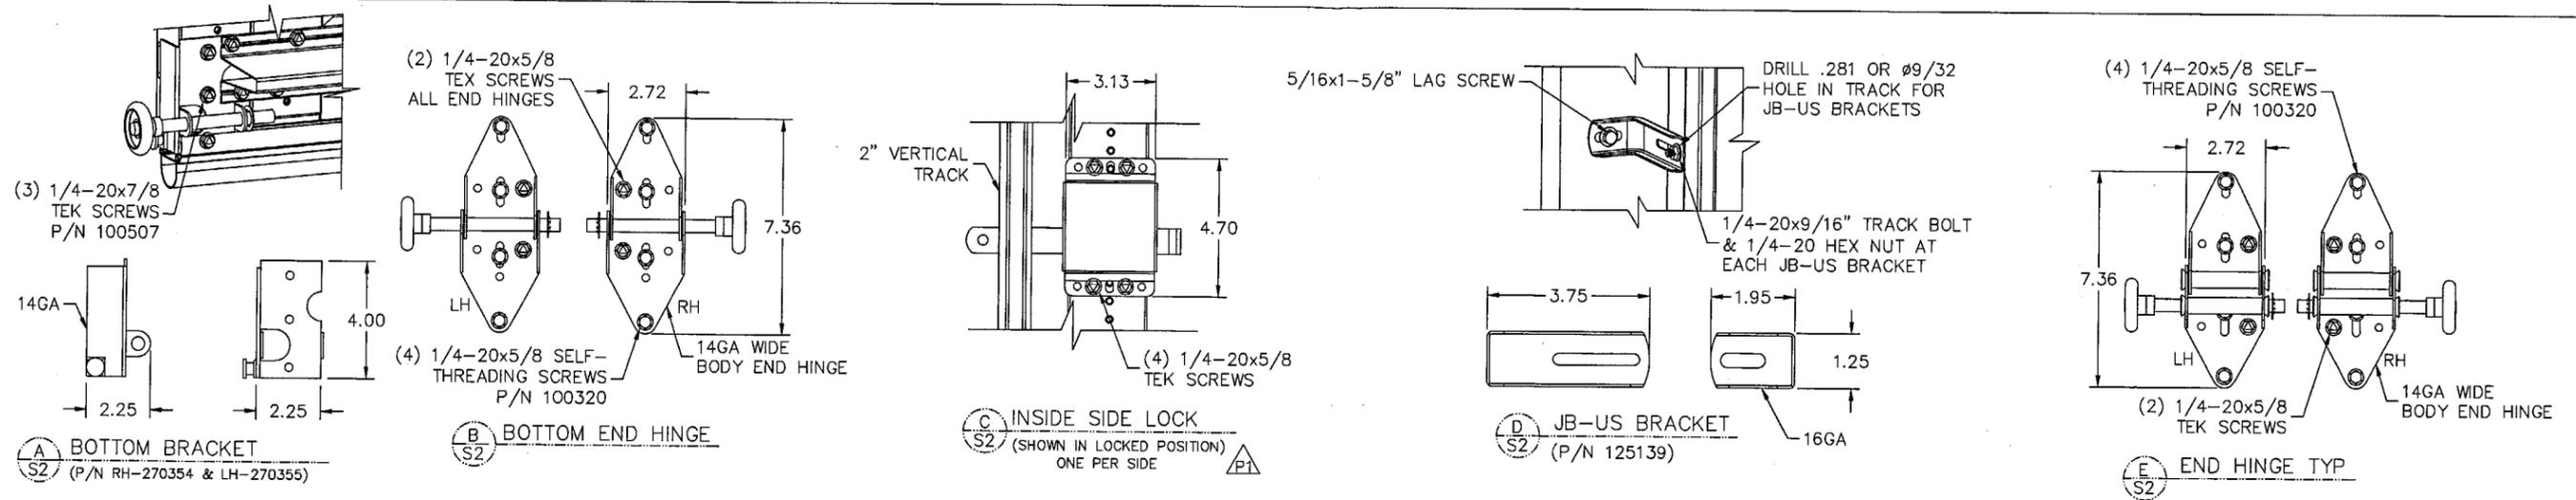

PART NO.		296540	
R & D RELEASE TO PRODUCT ENGINEERING	DATE		
BY:			
(P) CHANGES			
P1 REV NOTES AND DESCR PER DADE CNTY MARK UPS. 10/18/01 DCC			
P2 ADDED NOTE FOR PRESSURE REQUIREMENTS 01/02/02 SAD			

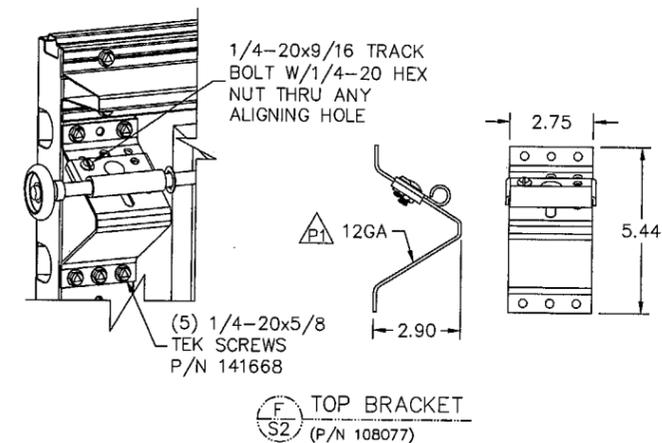

NOTE: LOCK OR OPERATOR REQUIRED

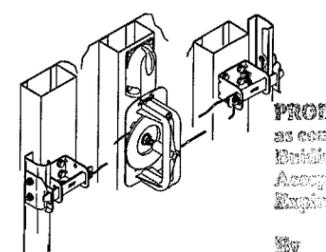

Approved: *[Signature]*

W.S. Wilson, P.E.  
3395 ADDISON DR., PENSACOLA, FL 32514  
FLORIDA CERTIFICATION NO. 0048489  
GEORGIA CERTIFICATION NO. 018519  
NORTH CAROLINA CERTIFICATION NO. 023836

DATE: 1-3-02

APPROVED AS COMPLYING WITH THE SOUTH FLORIDA BUILDING CODE

DATE FEB 07 2002

BY: *[Signature]*

PRODUCT CONTROL DIVISION  
BUILDING CODE COMPLIANCE OFFICE  
ACCEPTANCE NO. 01-0813.02

<b>Wayne Dalton</b>	3395 ADDISON DRIVE PENSACOLA, FLORIDA 32514 (850) 474-9890		DATE	NAME	SHEET 2 of 2
	DRAWN	6/28/2001	D. RESTER		
	CHECKED				
WAYNEMARK 8000 & 8100 RAISED PANEL			PROJECT	OPTION CODE	REV
DESIGN PRESSURE: +31.0 PSF/-33.0 PSF			APPR.	WINDLOAD\WMKB000	
SIZE C			0116		P2