



BUILDING CODE COMPLIANCE OFFICE (BCCO)
PRODUCT CONTROL DIVISION

MIAMI-DADE COUNTY, FLORIDA
METRO-DADE FLAGLER BUILDING
140 WEST FLAGLER STREET, SUITE 1603
MIAMI, FLORIDA 33130-1563
(305) 375-2901 FAX (305) 375-2908

NOTICE OF ACCEPTANCE (NOA)

www.buildingcodeonline.com

Jeld-Wen, Inc.
3250 Lakepoint Blvd.
Klamath Falls, OR 97601

SCOPE:

This NOA is being issued under the applicable rules and regulations governing the use of construction materials. The documentation submitted has been reviewed by Miami-Dade County Product Control Division and accepted by the Board of Rules and Appeals (BORA) to be used in Miami Dade County and other areas where allowed by the Authority Having Jurisdiction (AHJ).

This NOA shall not be valid after the expiration date stated below. The Miami-Dade County Product Control Division (In Miami Dade County) and/or the AHJ (in areas other than Miami Dade County) reserve the right to have this product or material tested for quality assurance purposes. If this product or material fails to perform in the accepted manner, the manufacturer will incur the expense of such testing and the AHJ may immediately revoke, modify, or suspend the use of such product or material within their jurisdiction. BORA reserves the right to revoke this acceptance, if it is determined by Miami-Dade County Product Control Division that this product or material fails to meet the requirements of the applicable building code.

This product is approved as described herein, and has been designed to comply with the Florida Building Code including the High Velocity Hurricane Zone.

DESCRIPTION: Series "8'-0" Inswing Glazed Steel Door – L.M.I.

APPROVAL DOCUMENT: Drawing No. **JW059-02-01** titled "Impact Glazed Steel Door Inswing 8'-0" Lip-Lite" Sheets 1 through 6 of 6, prepared by Jeld-Wen, Inc., dated 09/06/05 with revision "B" on 04/08/06, signed and sealed by James J. Dobrowski, P. E., bearing the Miami-Dade County Product Control Approval stamp with the Notice of Acceptance number and approval date by the Miami-Dade County Product Control Division.

MISSILE IMPACT RATING: Large and Small Missile Impact

LABELING: Each unit shall bear a permanent label with the manufacturer's name or logo, city, state and following statement: "Miami-Dade County Product Control Approved", unless otherwise noted herein.

RENEWAL of this NOA shall be considered after a renewal application has been filed and there has been no change in the applicable building code negatively affecting the performance of this product.

TERMINATION of this NOA will occur after the expiration date or if there has been a revision or change in the materials, use, and/or manufacture of the product or process. Misuse of this NOA as an endorsement of any product, for sales, advertising or any other purposes shall automatically terminate this NOA. Failure to comply with any section of this NOA shall be cause for termination and removal of NOA.

ADVERTISEMENT: The NOA number preceded by the words Miami-Dade County, Florida, and followed by the expiration date may be displayed in advertising literature. If any portion of the NOA is displayed, then it shall be done in its entirety.

INSPECTION: A copy of this entire NOA shall be provided to the user by the manufacturer or its distributors and shall be available for inspection at the job site at the request of the Building Official.

This NOA consists of this page 1 and evidence pages E-1 and E-2, as well as approval document mentioned above.

The submitted documentation was reviewed by **Jaime D. Gascon, P.E.**



J. Gascon
5/5/06

NOA No 05-1215.02
Expiration Date: May 25, 2011
Approval Date: May 25, 2006
Page 1

Jeld-Wen, Inc.

NOTICE OF ACCEPTANCE: EVIDENCE SUBMITTED

A. DRAWINGS

1. Manufacturers die drawings and sections.
2. Drawing No. **JW059-02-01** titled "Impact Glazed Steel Door Inswing 8'-0" Sheets 1 through 6 of 6, prepared by Jeld-Wen, Inc., dated 09/06/05 with revision "B" on 04/08/06, signed and sealed by James J. Dobrowski, P. E.

B. TESTS

1. Test reports on
 - 1) Air Infiltration Test, per FBC, TAS 202-94
 - 2) Uniform Static Air Pressure Test, Loading per FBC, TAS 202-94
 - 3) Water Resistance Test, per FBC, TAS 202-94
 - 4) Large Missile Impact Test, FBC, TAS 201-94
 - 5) Cyclic Loading Test, per FBC, TAS 203-94along with installation diagram of an Wood Edge, Impact Glazed Insulated Steel Door, 8-0 Inswing Single-Double, marked-up by National Certified Testing Laboratories, Test Reports No. **NCTL No. 210-3196-1**, dated 09/26/05, signed and sealed by Gerard John Ferrara, P.E.

C. CALCULATIONS


1. Anchor Calculations and structural analysis, prepared by Jeld-Wen, dated 11/04/05, signed and sealed by James J. Dobrowki, P.E.
Complies with ASTM E 1300-98

D. QUALITY ASSURANCE BY:

1. Miami Dade Building Code Compliance Office (BCCO).

E. MATERIAL CERTIFICATIONS

1. Notice of Acceptance No. **03-0827.08** issued to Solutia Inc. for "Clear or Colored Interlayer" dated 03/04/04, expiring on 03/04/09.
2. Test report No. **J99006660-001**, dated 04/08/99, for "Surface Burning Characteristics of Building Materials" per ASTM E84-97A for the Dylite Expandable Polystyrene, issued by Intertek Testing Service NA Inc.
3. Test report No. **J99006660-001**, dated 04/08/99, for "Test Method for Ignition Properties of Plastics, Procedure B, Short Method" per ASTM D1929-91 for the Dylite Expandable Polystyrene, issued by Intertek Testing Service NA Inc.
4. Test report No. **ATI-61782.01-106-31**, dated 01/14/06, for "Standard Test Methods for Tension Testing of Metallic Materials" per ASTM E8-01 for Steel Door Skin, issued by Architectural Testing, Inc.
5. Notice of Acceptance No. **03-0428.02** issued to ODL Inc. for "ODL/Western Reflection Series Aluminum Glazed Lite Kit Assembly-Impact" dated 07/28/05, expiring on 07/28/10.

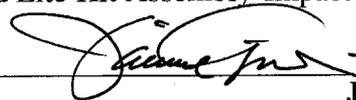

Jaime D. Gascon, P.E.
Chief, Product Control Division
NOA No 05-1215.02
Expiration Date: May 25, 2011
Approval Date: May 25, 2006

Jeld-Wen, Inc.

NOTICE OF ACCEPTANCE: EVIDENCE SUBMITTED

F. STATEMENTS

1. Statement Letter of conformance and letter of "No financial interest" issued by David Evans and Associates, Inc., dated 11/04/05, signed and sealed by James Dobrowski, P.E.
2. Statement Letter of conformance and letter of "No financial interest" issued Jeld-Wen, dated 11/02/05, signed and sealed by Steve Saffell.

G. OTHER

1. Letter from the consultant, dated 03/27/06, stating that the product is in compliance with the Florida Building Code (FBC)



Jaime D. Gascon, P.E.
Chief, Product Control Division
NOA No 05-1215.02
Expiration Date: May 25, 2011
Approval Date: May 25, 2006

JELD-WEN® Steel

WOOD EDGE IMPACT GLAZED INSULATED STEEL DOOR
8-0 INSWING SINGLE OR DOUBLE DOOR UNIT
UTILIZING COMPONENTS FROM ODL® INC. AND
ENDURA PRODUCTS INC.

GENERAL NOTES

1. THIS PRODUCT IS DESIGNED TO MEET THE FLORIDA BUILDING CODE INCLUDING "HVHZ".
2. WOOD BUCKS BY OTHERS, MUST BE ANCHORED PROPERLY TO TRANSFER LOADS TO THE STRUCTURE.
3. PRODUCT ANCHORS SHALL BE AS LISTED AND SPACED AS SHOWN ON DETAILS. ANCHOR EMBEDMENT TO BASE MATERIAL SHALL BE BEYOND WALL DRESSING OR STUCCO.
4. DESIGNED PRESSURE RATING SEE TABLE I, PAGE 1.
5. THIS PRODUCT DOES NOT MEET WATER REQUIREMENTS FOR HIGH VELOCITY HURICANE ZONE (HVHZ)
6. PRODUCT REQUIRES PROTECTIVE COVERING IN ACCORDANCE TO FBC FOR HVHZ

RESIDENTIAL INSULATED STEEL DOOR (Common to all frame conditions)

DOOR LEAF CONSTRUCTION:

Face sheets: 24 GA (0.021" min) thickness. Galvanized steel A-525 commercial quality AKDQ per ASTM 620 with average minimum yield strength $F_y(\text{ave})=30627$ psi.

Core Design: Expanded polystyrene with 1.0 to 1.25 lbs density, by Jeld-Wen Inc.


Panel Construction: The active and inactive panels are constructed from 24 GA (0.021" min) galvanized steel. The face sheets at top and bottom are bent 90° over the top and bottom rails. The top rail measures 1.0" high x 1.688" wide. The steel bottom rail measures 1.21" high x 1.688" wide. The sides of the face sheets are roll formed into the latch and hinge stiles which measure 1.00" high x 1.688" wide. The interior cavity is filled with expanded polystyrene. The face sheets are glued to the expanded polystyrene. The panels are cut out for the two-piece ODL Aluminum lite frame. Units are glazed with tempered and laminated impact 1" IG. On double door applications the inactive door is fitted with an extruded aluminum astragal of 6063-T5 alloy, manufactured by Endura.

Frame Construction: The frames are constructed of fingerjointed pine jambs measuring 4-9/16" x 1-1/4". The head jambs are mortised and butt joined to the side jambs, and attached with three (3) 16GA 7/16" crown x 2" long staples on each side. The threshold is attached to the side jambs with three (3) 16GA 7/16" crown x 2" long staples on each side. The units use an inswing adjustable threshold.

Glazing: ODL insulated lite is 1" overall thickness, consisting of one (1) pane of 0.125" tempered glass; 0.5" air space; two (2) panes of 0.125" annealed with .090" PVB interlayer by Solutia. All lites are sandwiched glazed into the panels.

TABLE OF CONTENTS

SHEET #	DESCRIPTION
1	TYPICAL ELEVATIONS
2	VERTICAL CROSS SECTION & BILL OF MATERIAL
3	HORIZONTAL CROSS SECTIONS
4	ANCHORING LOCATIONS
5	MISCELLANEOUS DETAILS
6	UNIT COMPONENTS

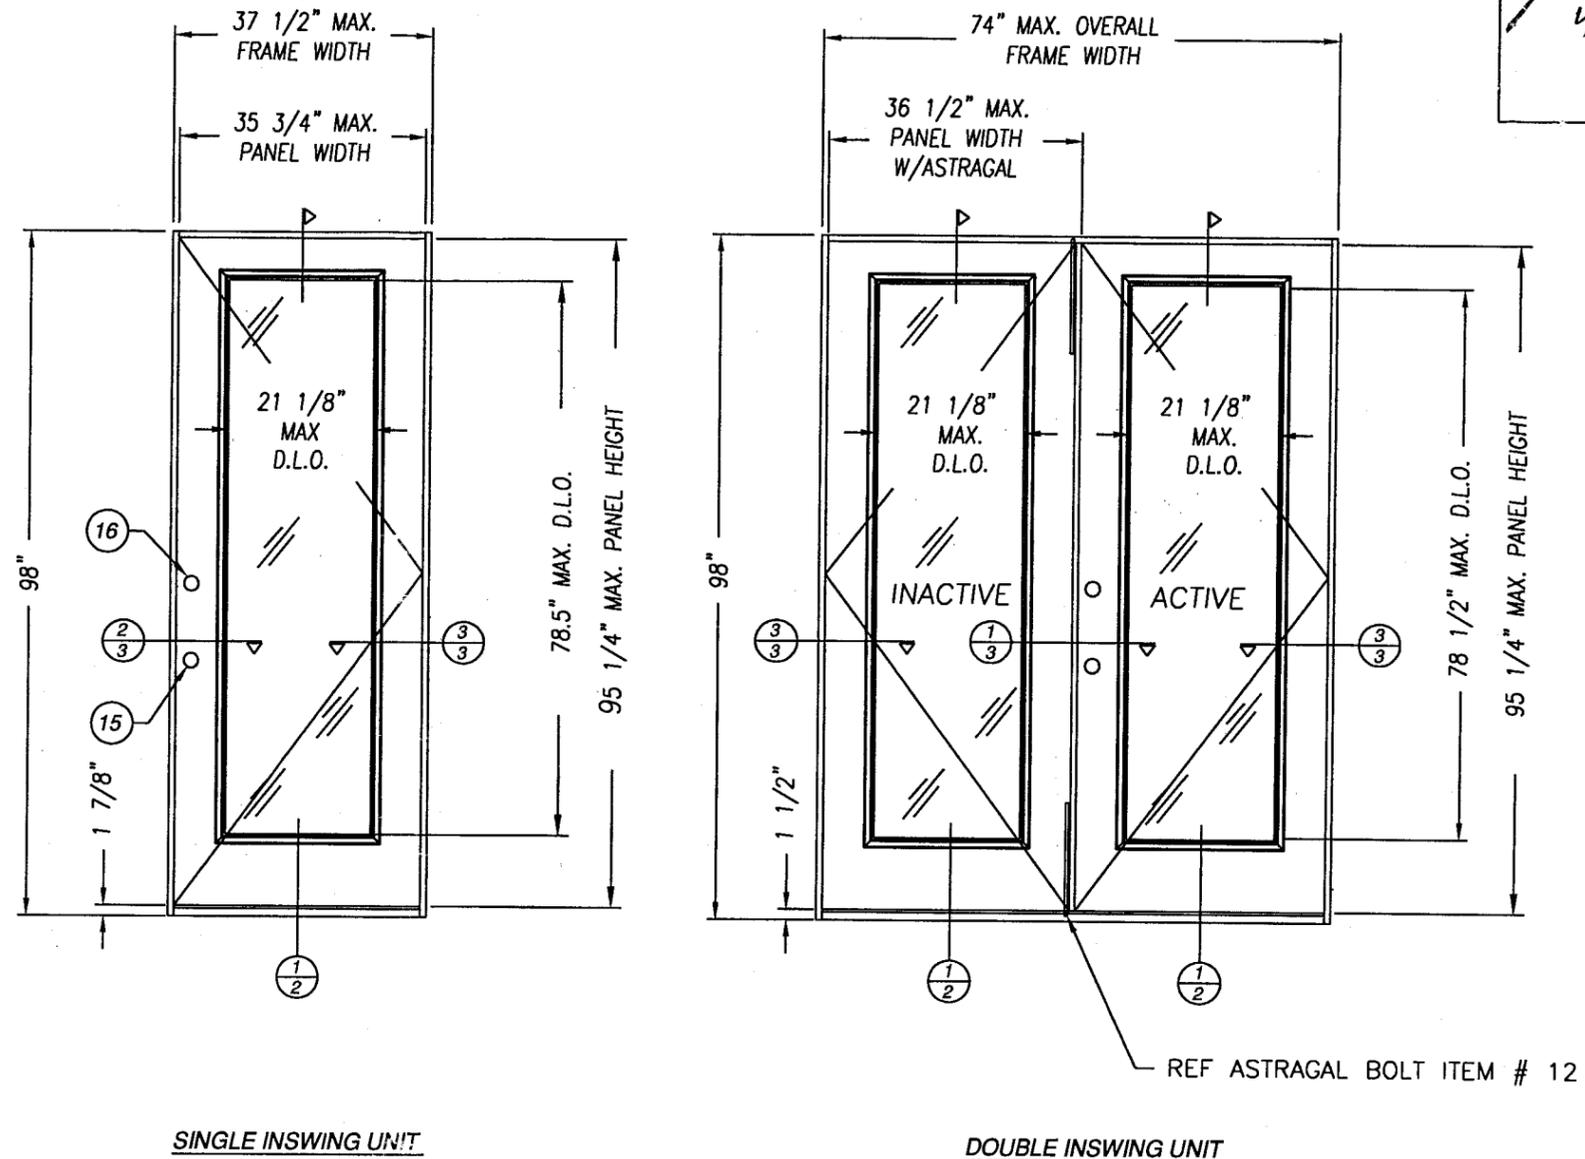

SINGLE INSWING UNIT

DOUBLE INSWING UNIT

ALL DOOR MODELS ARE VIEWED
FROM THE INTERIOR SIDE

APPROVED FOR USE WHERE
PROTECTION FOR WATER
INFILTRATION IS REQUIRED

	WHERE WATER INFILTRATION REQUIREMENT IS NEEDED.	WHERE WATER INFILTRATION REQUIREMENT IS NOT NEEDED OR PROTECTED BY OVERHANG. *
POSITIVE	NOT APPROVED	+50.0 PSF
NEGATIVE	NOT APPROVED	-50.0 PSF

* Unit shall be installed at location protected by overhang such that overhang ratio (OH) = OH length/OH height greater than 1.0

James D. Shoultz
4-19-06


JELD-WEN, INC.
31725 HIGHWAY 97 N.
CHILOQUIN, OR. 97624
PH. 1-800-535-3936

PRODUCT: IMPACT GLAZED STEEL DOOR
INSWING 8'-0" LIP LITE
PART OR ASSEMBLY: TYPICAL ELEVATIONS

NO.	DATE	BY
B	04-08-06	DREW
A	12-17-04	DREW

Approved as complying with the
Florida Building Code
Date 05/25/06
NOA# 05-1215-02
Miami Dade Product Control
Division
By: *[Signature]*

DATE: 9-06-05
SCALE: NTS
DWG. BY: JPR
CHK. BY:
DRAWING NO.: JW0509-02-01
SHEET 1 OF 6

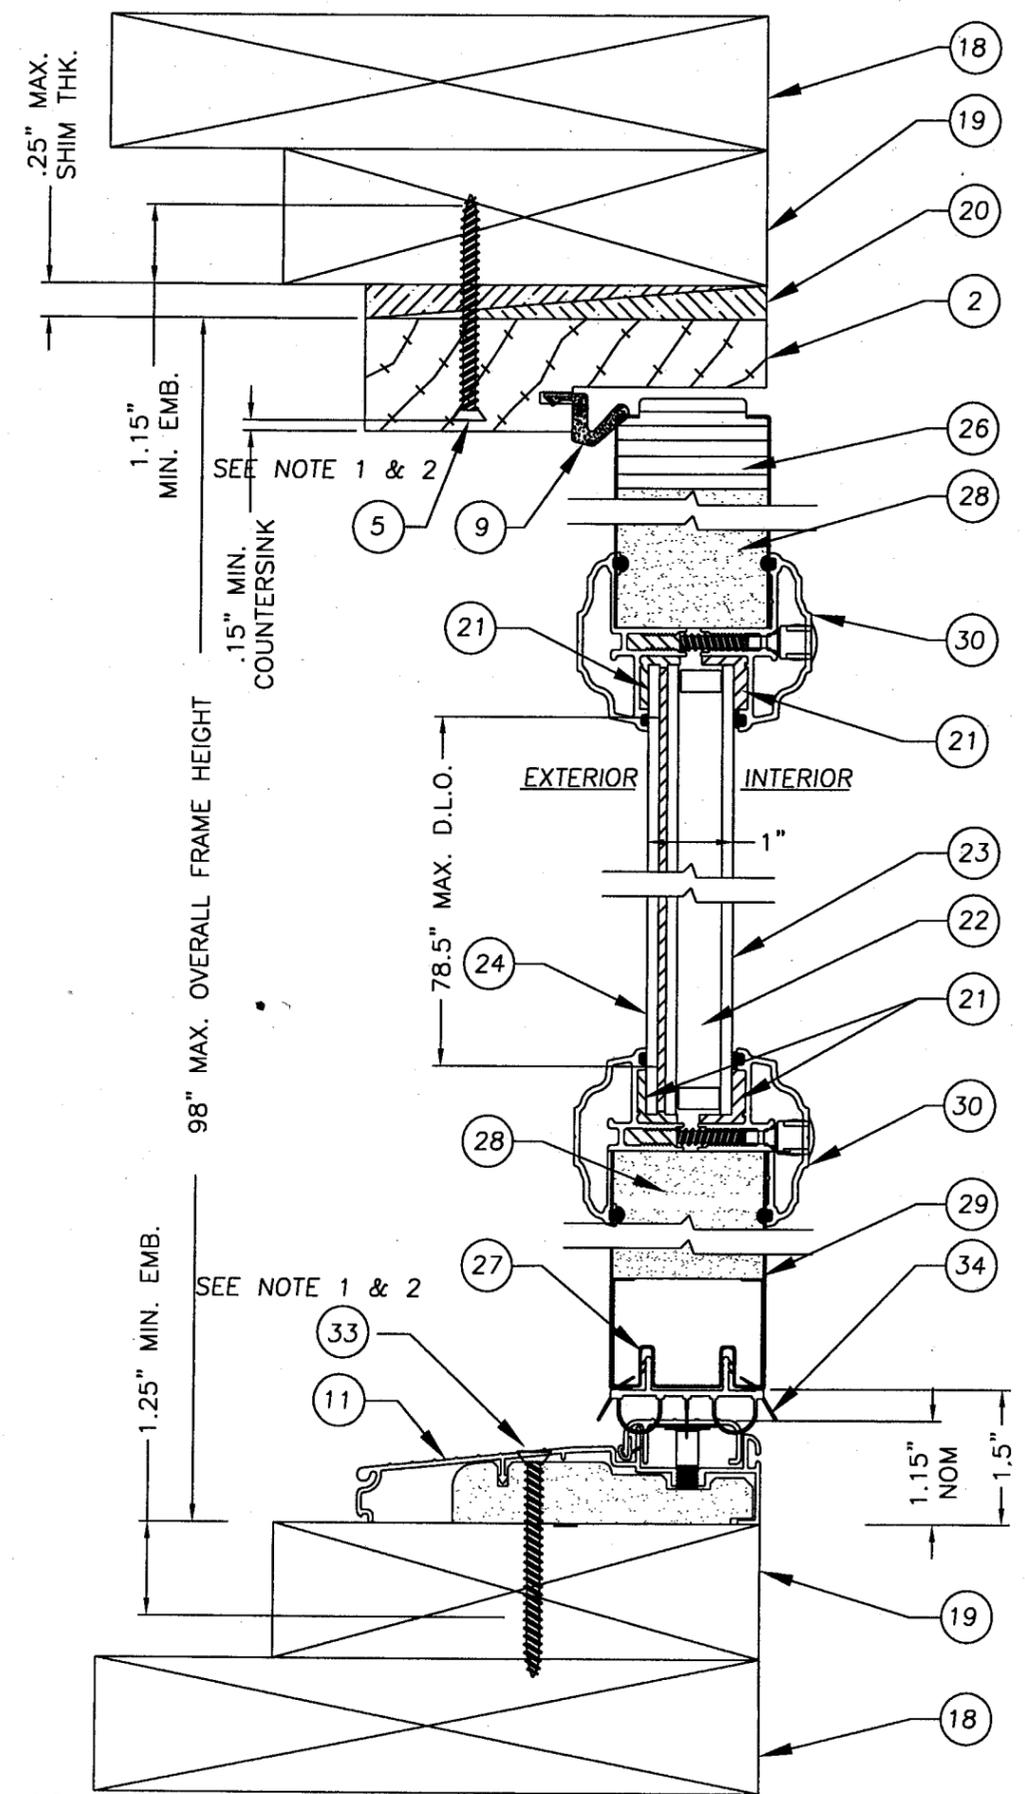

1 VERTICAL CROSS-SECTION
2 (ENDURA # A14566AA SILL)

Item	DESCRIPTION	Material
1	SIDE JAMB (1 1/4" x 4 9/16" FINGERJOINTED PINE)	PINE
2	HEAD JAMB (1 1/4" x 4 9/16" FINGERJOINTED PINE)	PINE
3	4" x 4" BUTT HINGE 12GA. (.089" MIN)	STEEL
4	#9 x 5/8" PHILLIPS FLATHEAD WOOD SCREW	STEEL
5	#8 x 2 1/2" PHILLIPS FLATHEAD WOOD SCREW	STEEL
6	#10 X 1 1/2" PHILLIPS FLATHEAD WOOD SCREW	STEEL
7	#8 X 3" PHILLIPS FLATEHEAD WOOD SCREW	STEEL
8	#8X1" PHILLIPS PAN HEAD WOOD SCREW	STEEL
9	COMPRESSION WEATHERSTRIP (Q-LON QDS-650)	
11	INSWING ADJUSTABLE THRESHOLD (ENDURA)	ALUMINUM
12	ASTRAGAL THROW BOLT, STEEL ROD, 5/16 x 18"	STEEL
13	ASTRAGAL BOLT STRIKE PLATE LOCATED ON HEAD JAMB	STEEL
14	16 Ga. 7/16" CROWN x 2" LONG STAPLES	STEEL
15	KWIKSET TITAN SERIES LOCK SERIES 400	
16	KWIKSET TITAN SERIES DEADBOLT SERIES 780	
17	ENDURA ULTIMATE HURRICANE ASTRAGAL	ALUMINUM
18	2x WOOD BUCK	
19	2x WOOD BUCK	WOOD
20	SHIMS FOR 1/4" MAX THICKNESS	WOOD
21	DOW 995 SILICONE SEALANT	SILICONE
22	1" IMPACT IG ASSEMBLY NOA #03-0428-02	GLASS
23	1/8" TEMPERED GLASS	GLASS
24	3/8" LAMINATED ANNEALED GLASS	GLASS
25	LOCK BLOCK (WOOD X 12" LG)	WOOD
26	TOP RAIL (FINGERJOINTED PINE)	PINE
27	BOTTOM RAIL (25GA MIN GALVANIZED STEEL)	STEEL
28	EXPANDED POLYSTYRENE (1.0 TO 1.25lbs DENSITY BY JELD-WEN)	FOAM
29	STEEL DOOR PANEL SKIN MATERIAL (24GA GALVANIZED A-525 COMMERCIAL QUALITY 0.021" MIN. THICK.)	STEEL GALVANIZED
30	ODL LITE FRAME (ALUM 6063 T5)	ALUMINUM
31	HINGE SIDE STILE (FINGER JOINTED LVL)	PINE
32	LATCH SIDE STILE (FINGER JOINTED LVL)	LVL
33	#8 x 2" PHILLIPS FLATHEAD WOOD SCREW	STEEL
34	INSWING VINYL DOOR BOTTOM SWEEP	VINYL

NOTES:
1. FOR ANCHOR SPACING SEE SHEET 4 OF 6
2. 2x BUCK TO SUBSTRATE FASTENING MAY UTILIZE OPTIONAL 3/16" ELCO TAPCON (NOA #02-0503.07)

James Dohowski
4-14-06


JELD-WEN, INC.
31725 HIGHWAY 97 N.
CHILOQUIN, OR. 97624
PH. 1-800-535-3936

PRODUCT:		IMPACT GLAZED STEEL DOOR INSWING 8'-0" LIP LITE	
PART OR ASSEMBLY:		VERTICAL CROSS SECTION BILL OF MATERIALS	
NO.	DATE	REVISIONS	BY
B	04-08-06	GENERAL REVISIONS	DREW.
A	12-16-04	GENERAL REVISIONS	

Approved as complying with the
Florida Building Code
Date 05/25/06
NOA # 05-1215-02
Miami Dade Product Control
Division
By *[Signature]*


DATE: 9-06-05
SCALE: NTS
DWG. BY: JPR
CHK. BY:
DRAWING NO.: JW0509-02-02
SHEET 2 OF 6

James D. [Signature]
4-11-06

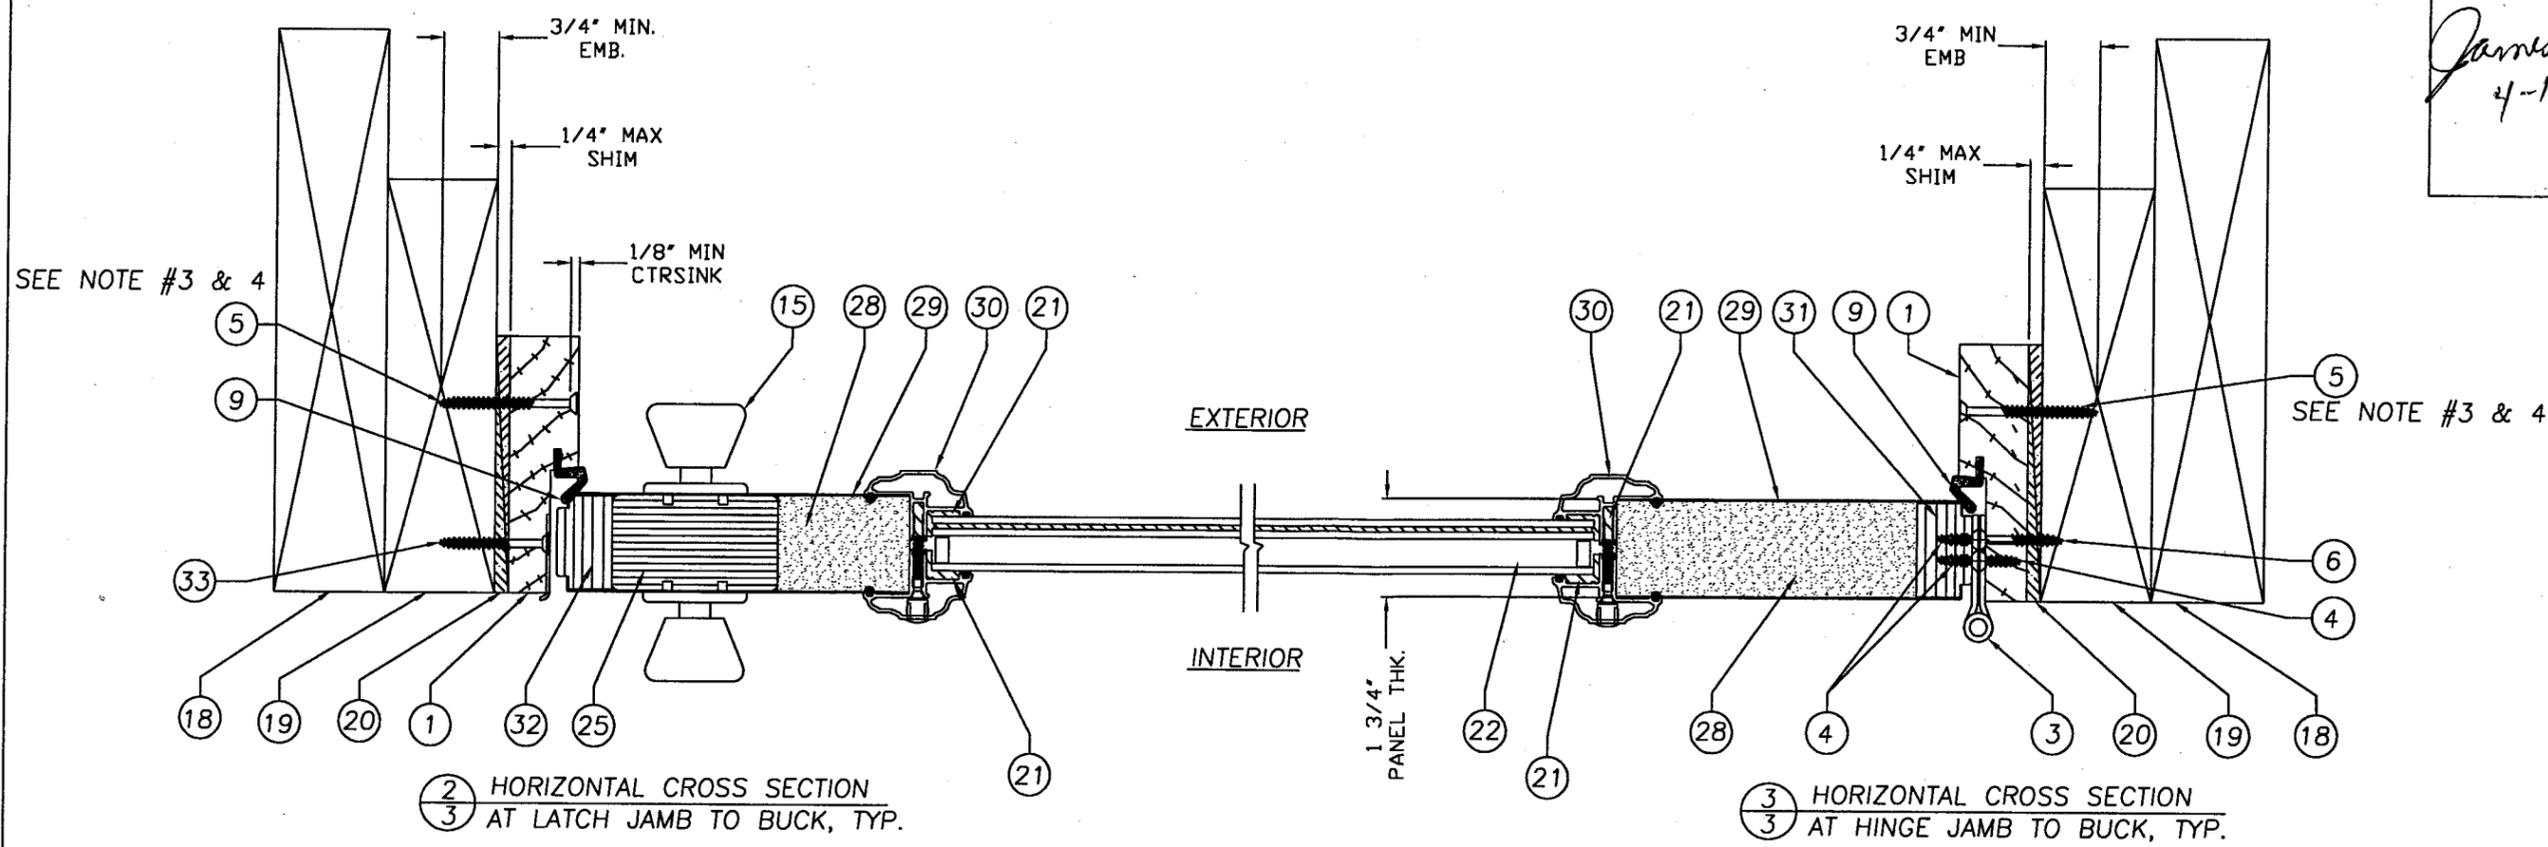

2 HORIZONTAL CROSS SECTION
3 AT LATCH JAMB TO BUCK, TYP.

3 HORIZONTAL CROSS SECTION
3 AT HINGE JAMB TO BUCK, TYP.

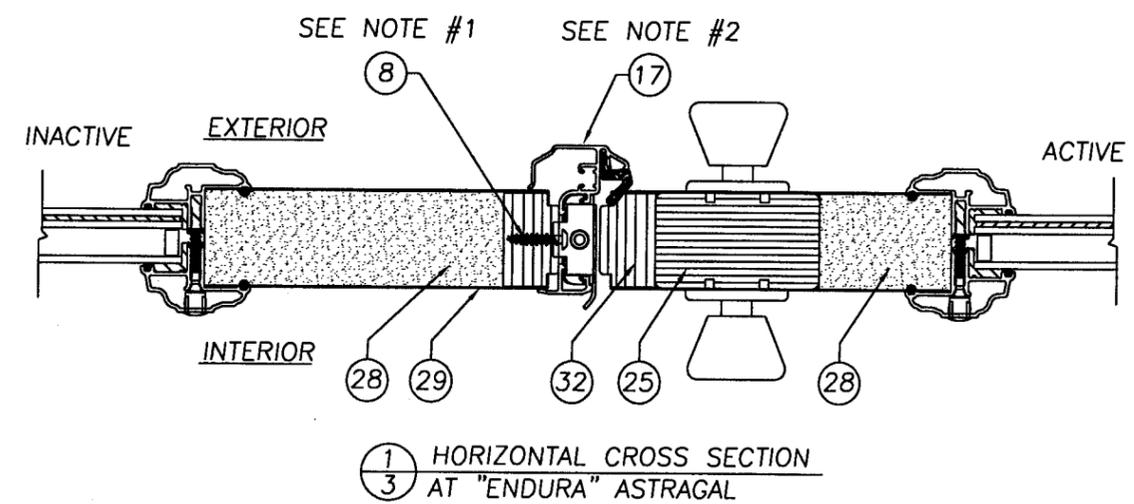


1 HORIZONTAL CROSS SECTION
3 AT "ENDURA" ASTRAGAL

- NOTES:
1. ASTAGAL FASTENER SPACING DETAIL F, PAGE #5. (TOTAL OF 16 SCREWS).
 2. LATCH AND DEADBOLT STRIKE PLATES MOUNT TO ASTRAGAL WITH ADJUSTABLE NUT PLATES. BOTH PLATES REQUIRE #8 X 3" PHILLIPS FLAT HEAD SCREW
 3. FOR ANCHOR CALCS, SEE SHEET 4 OF 6
 4. 2x BUCK TO SUBSTRATE FASTENING MAY UTILIZE OPTIONAL 3/16" ELCO TAPCON (NOA #02-0503.07)


JELD-WEN, INC. 31725 HIGHWAY 97 N. CHILOQUIN, OR. 97624 PH. 1-800-535-3936	
PRODUCT: IMPACT GLAZED STEEL DOOR INSURING 8'-0" LIP LITE	PART OR ASSEMBLY: HORIZONTAL CROSS SECTIONS
NO. DATE B 04-08-06	GENERAL REVISIONS REVISIONS BY

Approved as complying with the
Florida Building Code
Date 05/25/06
NOA# 05-1215.02
Miami Dade Product Control
Division
By *[Signature]*


DATE:	9-06-05
SCALE:	NTS
DWG. BY:	JPR
CHK. BY:	
DRAWING NO.:	JW0509-02-03
SHEET	3 OF 6

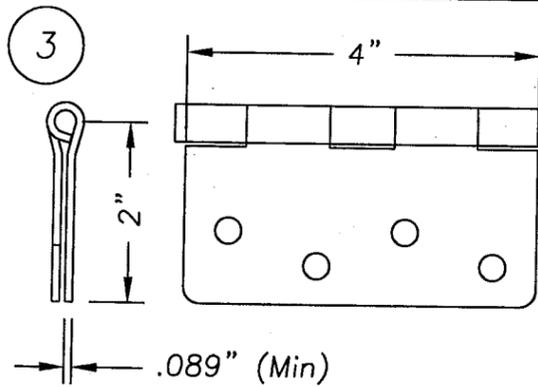


BUTT HINGE
4 x 4 x 12GA STEEL

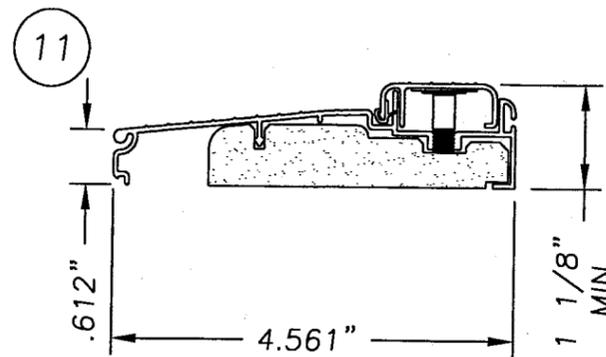

INSWING THRESHOLD (ENDURA)
PART# AI4566AA, 6063-T6 ALUMINUM

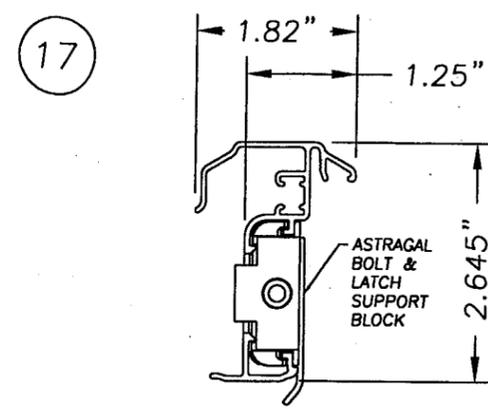


ENDURA ULTIMATE HURRICANE ASTRAGAL
6063-T6 ALUMINUM

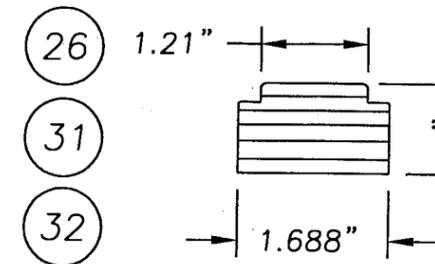


STILES AND RAILS
LATCH STILE & HINGE STILE (LVL)
TOP RAIL (FINGERJOINTED PINE)


James D. Doherty
4-14-06

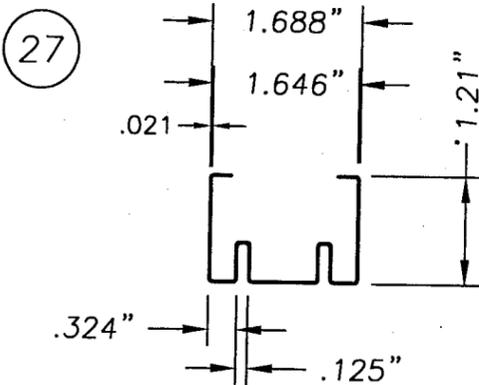


BOTTOM RAIL
STEEL, 25GA MIN GALVANIZED

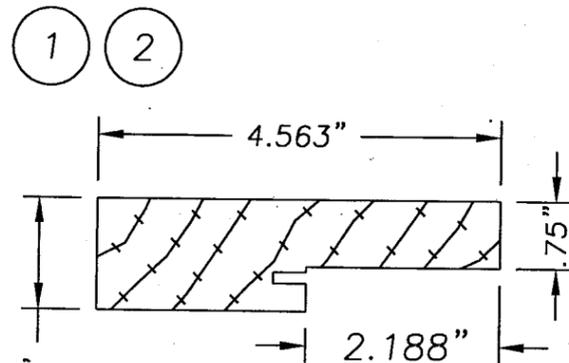


WOOD JAMB
FINGERJOINTED PINE

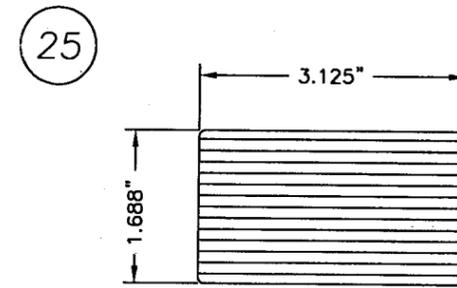


LOCK BLOCK (48" LG)
LVL

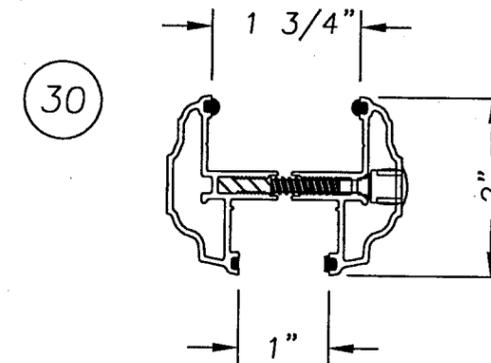


ODL LITE FRAME
ALUMINUM 6063 T5

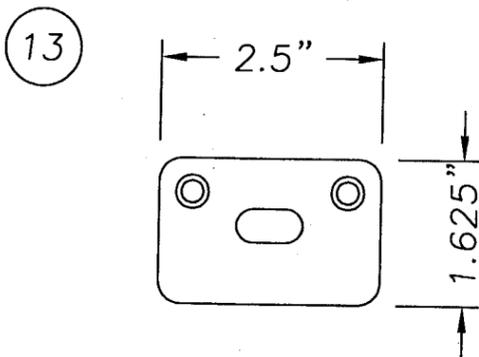


ASTRAGAL BOLT HEAD STRIKE

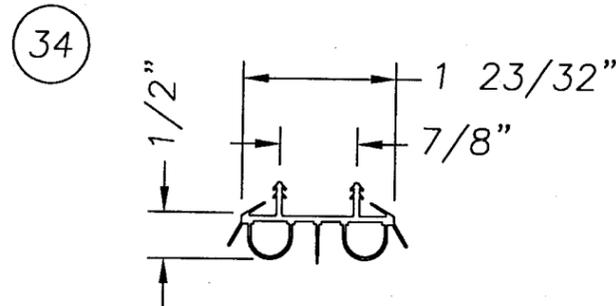

DOOR BOTTOM SWEEP

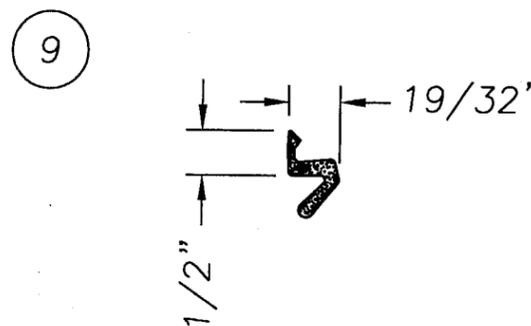

COMPRESSION WEATHERSTRIP

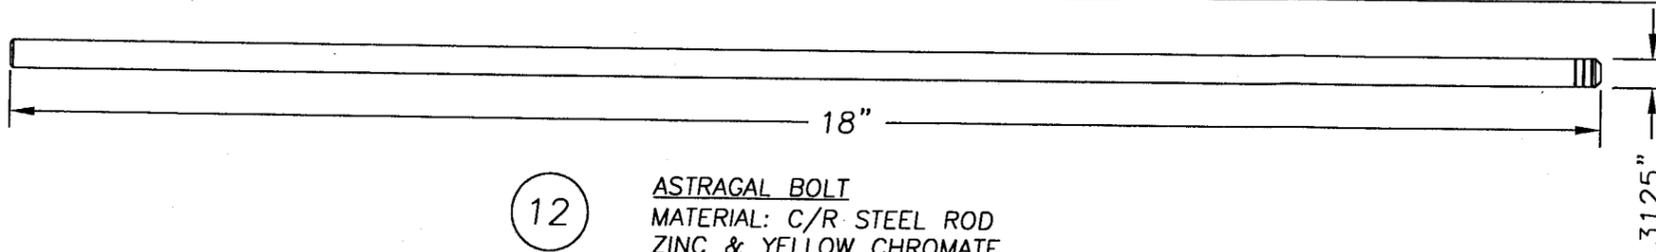

ASTRAGAL BOLT
MATERIAL: C/R STEEL ROD
ZINC & YELLOW CHROMATE

JELD-WEN, INC.
31725 HIGHWAY 97 N.
CHILOQUIN, OR. 97624
PH. 1-800-535-3936

PRODUCT:
IMPACT GLAZED STEEL DOOR
INSWING 8'-0" LIP LITE
PART OR ASSEMBLY:
UNIT COMPONENTS

NO.	DATE	REVISIONS	BY
B	04-08-06	GENERAL REVISIONS	DREW
A	12-16-04	GENERAL REVISIONS	

Approved as complying with the
Florida Building Code
Date 05/25/06
NOA# 05-1215.02
Miami Dade Product Control
Division
By *James P. ...*

DATE: 9-06-05
SCALE: NTS
DWG. BY: JPR
CHK. BY:
DRAWING NO.: JW0509-02-06
SHEET 6 OF 6