



BUILDING CODE COMPLIANCE OFFICE (BCCO)  
 PRODUCT CONTROL DIVISION

MIAMI-DADE COUNTY, FLORIDA  
 METRO-DADE FLAGLER BUILDING  
 140 WEST FLAGLER STREET, SUITE 1603  
 MIAMI, FLORIDA 33130-1563  
 (305) 375-2901 FAX (305) 375-2908

**NOTICE OF ACCEPTANCE (NOA)**

**Wayne-Dalton Corporation**  
**3395 Addison Drive**  
**Pensacola, FL 32514**

**SCOPE:** This NOA is being issued under the applicable rules and regulations governing the use of construction materials. The documentation submitted has been reviewed by Miami-Dade County Product Control Division and accepted by the Board of Rules and Appeals (BORA) to be used in Miami Dade County and other areas where allowed by the Authority Having Jurisdiction (AHJ).

This NOA shall not be valid after the expiration date stated below. The Miami-Dade County Product Control Division (In Miami Dade County) and/or the AHJ (in areas other than Miami Dade County) reserve the right to have this product or material tested for quality assurance purposes. If this product or material fails to perform in the accepted manner, the manufacturer will incur the expense of such testing and the AHJ may immediately revoke, modify, or suspend the use of such product or material within their jurisdiction. BORA reserves the right to revoke this acceptance, if it is determined by Miami-Dade County Product Control Division that this product or material fails to meet the requirements of the applicable building code.

This product is approved as described herein, and has been designed to comply with the Florida Building Code, including the High Velocity Hurricane Zone.

**DESCRIPTION: Waynemark 8000 & 8100 Raised Panel Steel Overhead Sectional Garage Door**

**APPROVAL DOCUMENT:** Drawing No. 0113, titled "Waynemark 8000 & 8100 Raised Panel", sheets 1 through 2 of 2, prepared by Wayne-Dalton Corp., signed and sealed by W.S. Wilson, P.E., dated 06/28/01, with last revision P1 on 10/18/01, bearing the Miami-Dade County Product Control Renewal stamp with the Notice of Acceptance number and expiration date by the Miami-Dade County Product Control Division.

**MISSILE IMPACT RATING: Large and Small Missile Impact**

**LABELING:** Each unit shall bear a permanent label with the manufacturer's name or logo, city, state and following statement: "Miami-Dade County Product Control Approved or MDCPCA", unless otherwise noted herein.

**RENEWAL** of this NOA shall be considered after a renewal application has been filed and there has been no change in the applicable building code negatively affecting the performance of this product.

**TERMINATION** of this NOA will occur after the expiration date or if there has been a revision or change in the materials, use, and/or manufacture of the product or process. Misuse of this NOA as an endorsement of any product, for sales, advertising or any other purposes shall automatically terminate this NOA. Failure to comply with any section of this NOA shall be cause for termination and removal of NOA.

**LIMITATIONS:** This approval requires the manufacturer to do testing of all coils used to fabricate door panels under this Notice of Acceptance. A minimum of two specimens shall be cut from each coil and tensile tested according to ASTM E-8 by a Miami-Dade County approved laboratory selected and paid by the manufacturer. Every 3 months, four times a year, the manufacturer shall mail to this office: a copy of the tested reports with confirmation that the specimens were selected from coils at the manufacturer production facilities, and a notarized statement from the manufacturer that only coils with yield strength of 40ksi or more shall be used to make panels for Miami-Dade county under this Notice of Acceptance.

**ADVERTISEMENT:** The NOA number preceded by the words Miami-Dade County, Florida, and followed by the expiration date may be displayed in advertising literature. If any portion of the NOA is displayed, then it shall be done in its entirety.

**INSPECTION:** A copy of this entire NOA shall be provided to the user by the manufacturer or its distributors and shall be available for inspection at the job site at the request of the Building Official.

This NOA **renews** NOA # **01-0813.03** and, consists of this page, evidence page E-1 as well as approval document mentioned above.

The submitted documentation was reviewed by **Jaime D. Gascon, P.E.**



*J. Gascon*  
 1/23/07

NOA No 06-0921.02  
 Expiration Date: December 13, 2011  
 Approval Date: February 15, 2007  
 Page 1

**Wayne-Dalton Corporation**

**NOTICE OF ACCEPTANCE: EVIDENCE SUBMITTED**

**A. DRAWINGS**

1. Drawing No. 0113, titled "Waynemark 8000 & 8100 Raised Panel", sheets 1 through 2 of 2, prepared by Wayne-Dalton Corp., signed and sealed by W.S. Wilson, P.E., dated 06/28/01, with last revision P1 on 10/18/01.

**B. TESTS**

1. Test Report on Large Missile Impact Test and Cyclic Wind Pressure Test of "Sectional Residential Garage Door Waynemark 8000-0113" prepared by Hurricane Engineering and Testing Inc. Report #01-995 dated 04/04/01 signed and sealed by HM Medina, PE.
2. Test Report on Uniform Static Air Pressure & Forced Entry Resistance Test "Sectional Residential Garage Door Waynemark 8000-0113" prepared by Hurricane Engineering and Testing Inc., Report No. 01-994, dated 04/02/01, signed and sealed by HM Medina, PE.
3. Test Report on ASTM B117-90 Test of 3"x9" galvanized panels (controls) & painted panels prepared by Sub-Tropical Testing Service, Test Number WDC-1, dated 04/26/01, signed and sealed by Mark Mosbat, P.E.

**C. CALCULATIONS**

1. Anchoring Method Summary, prepared by W. S. Wilson, Sheets 1 through 5 prepared, signed and sealed by W. S. Wilson, PE on 08/02/01.

**D. QUALITY ASSURANCE**

1. Building Code Compliance Office.

**E. MATERIAL CERTIFICATIONS**

1. Tensile Test Report No-HETI 01-T036, prepared Hurricane Engineering & Testing, Inc., dated 04/17/01, signed and sealed by H. M. Medina, PE.

**F. STATEMENTS**

1. Letter of code compliance issued by Wayne-Dalton Corporation, signed & sealed by W. S. Wilson, PE. on 08/02/01.
2. Letter on Non Financial Interest issued by Wayne-Dalton Corporation, signed & sealed by W. S. Wilson, PE on 08/02/01.
3. No change in product since last approved letter issued by Wayne-Dalton Corporation on 09/11/06, signed by W.S. Wilson, P.E.


  
Jaime D. Gascon, P.E.

Chief, Product Control Division

NOA No 06-0921.02

Expiration Date: December 13, 2011

Approval Date: February 15, 2007

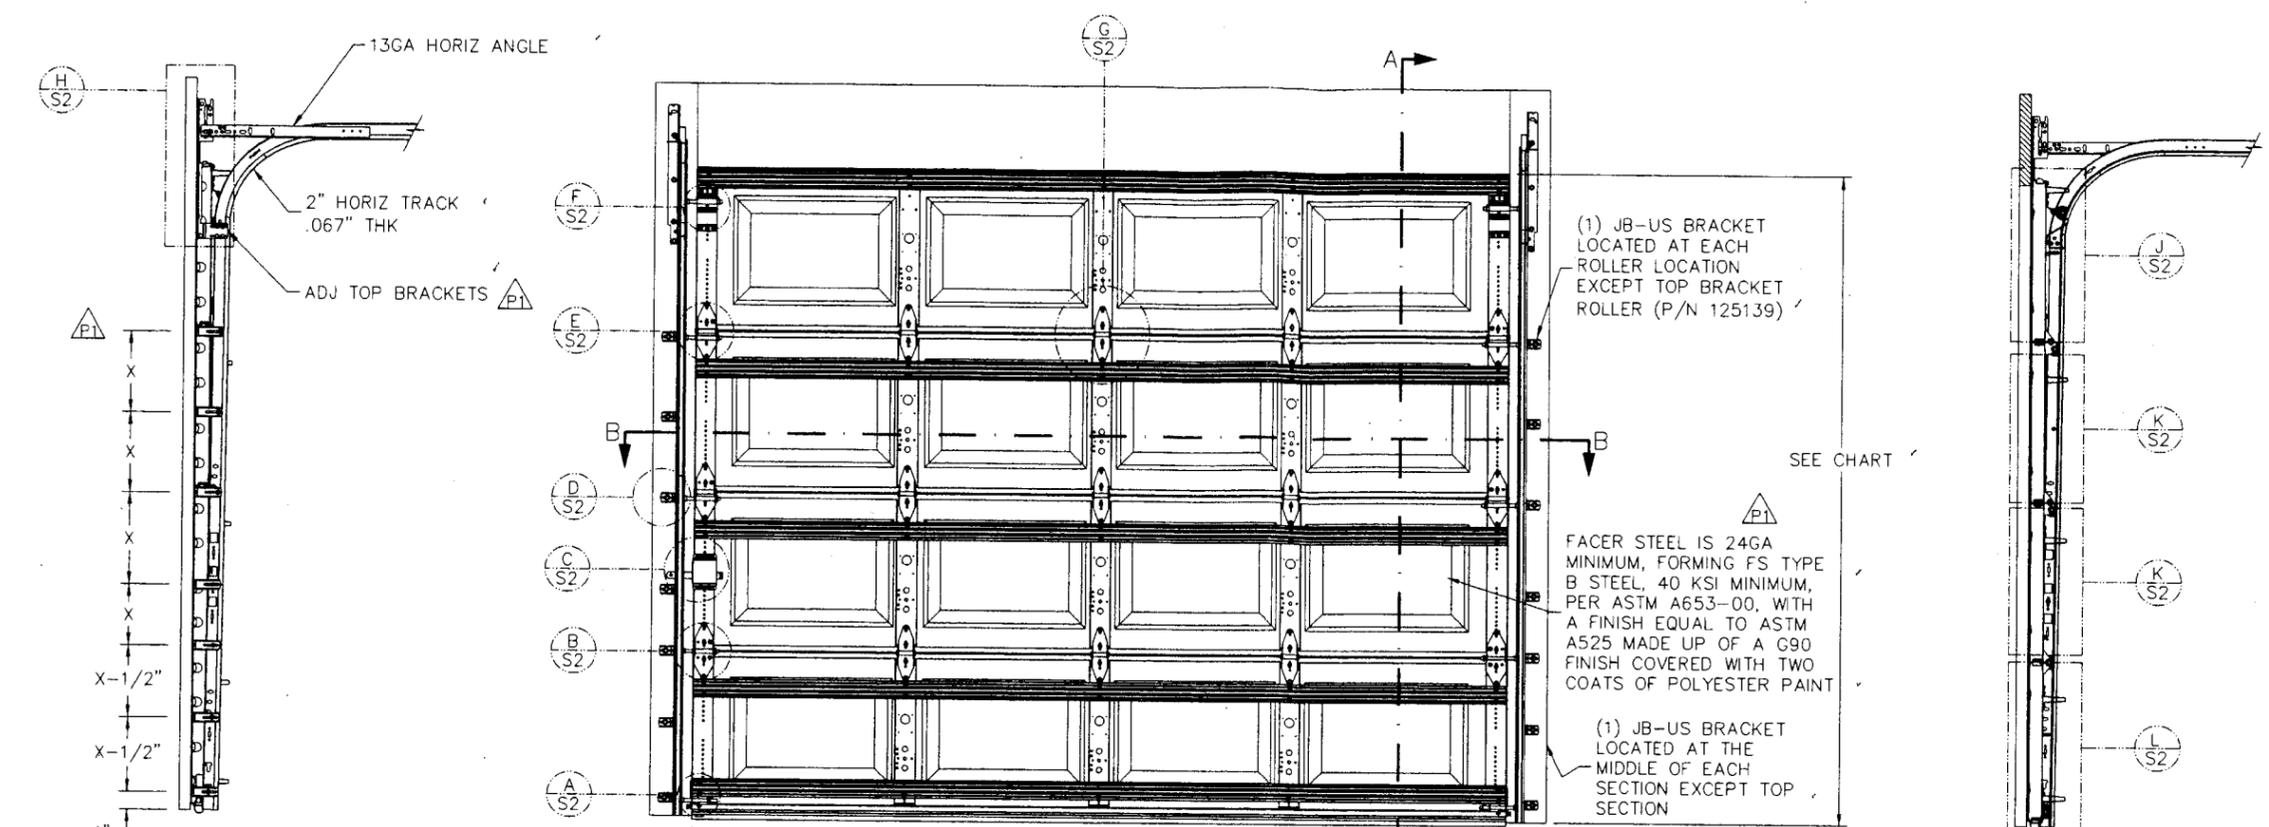

$X = \frac{\text{SECTION HEIGHT}}{2}$


VINYL OR WOOD DOOR STOP (NAILED ON 6" CENTERS) MUST OVERLAP TOP AND BOTH ENDS OF PANELS MINIMUM 7/16" TO MEET NEGATIVE PRESSURES

(1) JB-US BRACKET LOCATED AT EACH ROLLER LOCATION EXCEPT TOP BRACKET ROLLER (P/N 125139)

FACER STEEL IS 24GA MINIMUM, FORMING FS TYPE B STEEL, 40 KSI MINIMUM, PER ASTM A653-00, WITH A FINISH EQUAL TO ASTM A525 MADE UP OF A G90 FINISH COVERED WITH TWO COATS OF POLYESTER PAINT

(1) JB-US BRACKET LOCATED AT THE MIDDLE OF EACH SECTION EXCEPT TOP SECTION

SECTION A-A

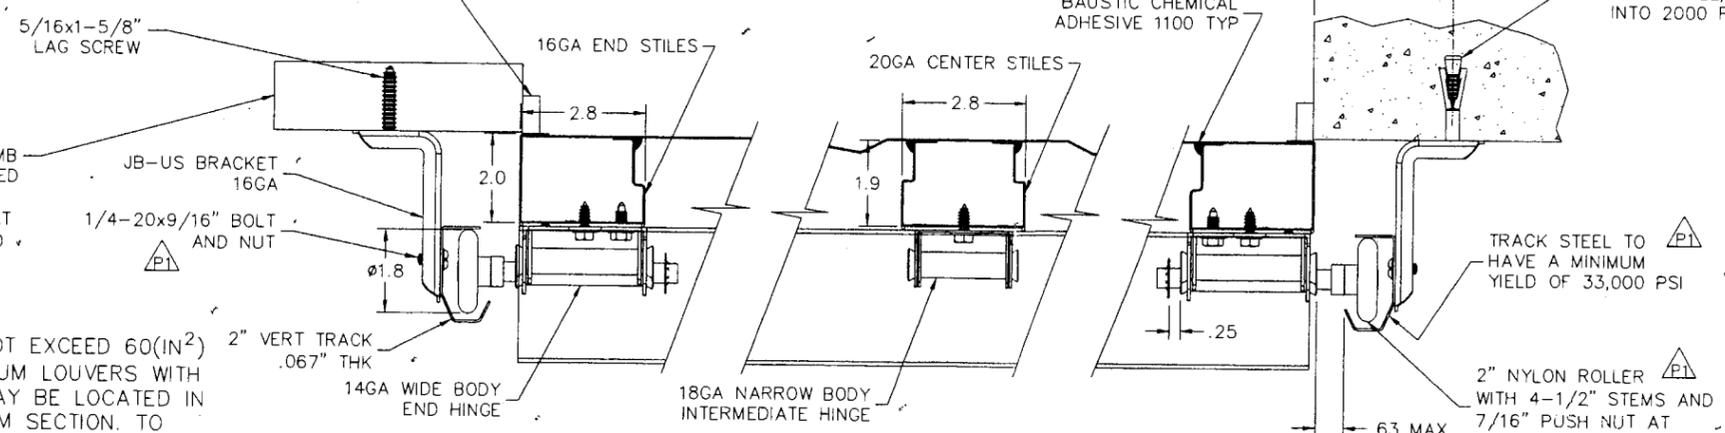

NOTE: TOTAL AREA OF LOUVERS CANNOT EXCEED 60(IN<sup>2</sup>) OPTIONAL - .080" (MIN) ALUMINUM LOUVERS WITH HIGH IMPACT STYRENE FRAME MAY BE LOCATED IN THE END PANELS OF THE BOTTOM SECTION. TO MEET MINIMUM VENTILATION REQUIREMENTS.

| DOOR HEIGHT | U-BARS | SECTION HEIGHTS |     |     |     |     |     |     |     |    | JB-US BRACKETS |
|-------------|--------|-----------------|-----|-----|-----|-----|-----|-----|-----|----|----------------|
|             |        | BOTTOM          | #2  | #3  | #4  | #5  | #6  | #7  | TOP |    |                |
| 6'-6"       | 5      | 21"             | 18" | 18" |     |     |     |     | 21" | 7  |                |
| 7'-0"       | 5      | 21"             | 21" | 21" |     |     |     |     | 21" | 7  |                |
| 7'-6"       | 7      | 18"             | 18" | 18" | 18" |     |     |     | 18" | 9  |                |
| 8'-0"       | 7      | 21"             | 18" | 18" | 18" |     |     |     | 21" | 9  |                |
| 9'-0"       | 8      | 18"             | 18" | 18" | 18" | 18" |     |     | 18" | 11 |                |
| 10'-0"      | 8      | 21"             | 21" | 21" | 18" | 18" |     |     | 21" | 11 |                |
| 11'-0"      | 9      | 21"             | 18" | 18" | 18" | 18" | 18" |     | 21" | 13 |                |
| 12'-0"      | 9      | 21"             | 21" | 21" | 21" | 21" | 21" |     | 18" | 13 |                |
| 13'-0"      | 10     | 21"             | 21" | 21" | 18" | 18" | 18" | 18" | 21" | 15 |                |
| 14'-0"      | 10     | 21"             | 21" | 21" | 21" | 21" | 21" | 21" | 21" | 15 |                |






Approved: *[Signature]*  
 W.S. Wilson, P.E.  
 3395 ADDISON DR., PENSACOLA, FL 32514  
 FLORIDA CERTIFICATION NO. 0048489  
 GEORGIA CERTIFICATION NO. 018519  
 NORTH CAROLINA CERTIFICATION NO. 023836  
 Date: 11-7-01

**PRODUCT RENEWED**  
 as complying with the Florida Building Code  
 Acceptance No 06-0921-02  
 Expiration Date December 13, 2011  
 By *[Signature]*  
 Miami Dade Product Control Division






APPROVED AS COMPLYING WITH THE SOUTH FLORIDA BUILDING CODE  
 DATE DEC 13 2001  
 BY *[Signature]*  
 PRODUCT CONTROL DIVISION  
 BUILDING CODE COMPLIANCE OFFICE  
 ACCEPTANCE NO. 01-0813.03

|  |        |
|--|--------|
| PART NO.                                       | 294823 |
| R & D RELEASE TO PRODUCT ENGINEERING           | DATE   |
| BY:  |        |
| (P) CHANGES                                    |        |
| P1 REV NOTES AND DESCR PER DADE CNTY MARK UFS. |        |
| 10/18/01 DCC                                   |        |




|                                     |  |         |           |           |                              |
|-------------------------------------|--|---------|-----------|-----------|------------------------------|
| <b>Wayne Dalton</b>                 | 3395 ADDISON DRIVE<br>PENSACOLA, FLORIDA 32514<br>(850) 474-9890 | DRAWN   | DATE      | NAME      | SHEET 1 of 2                 |
|                                     |  | CHECKED | 6/28/2001 | K. HART   |                              |
| WAYNE MARK 8000 & 8100 RAISED PANEL |  | APPR.   |           |           | PROJECT<br>WINDLOAD W/MK8000 |
| DESIGN PRESSURE: ±37 PSF            |  |         |           | SIZE<br>C | OPTION CODE<br>0113          |
|                                     |  |         |           | REV<br>P1 |                              |

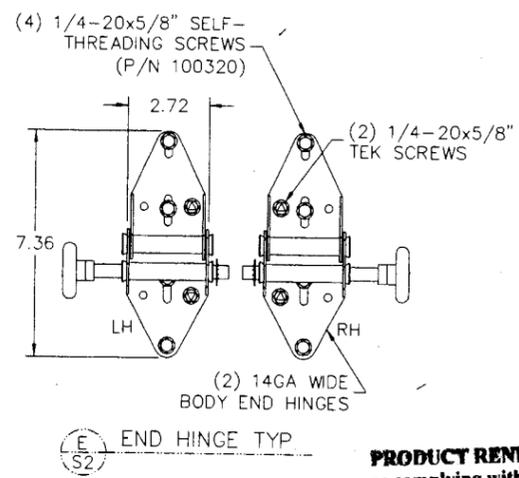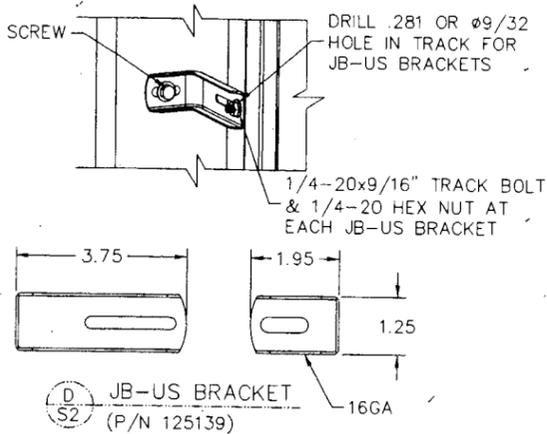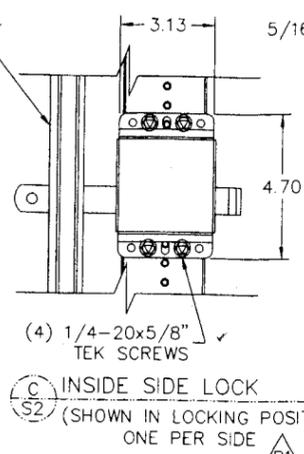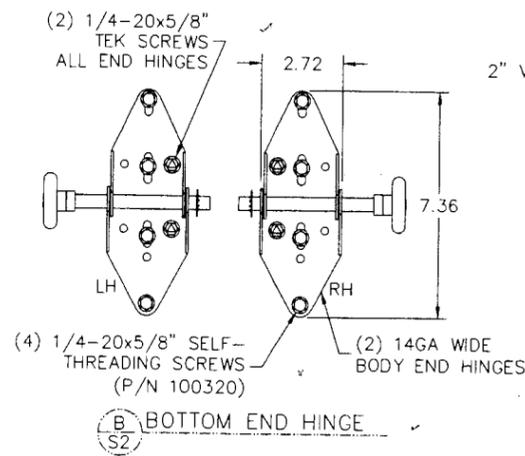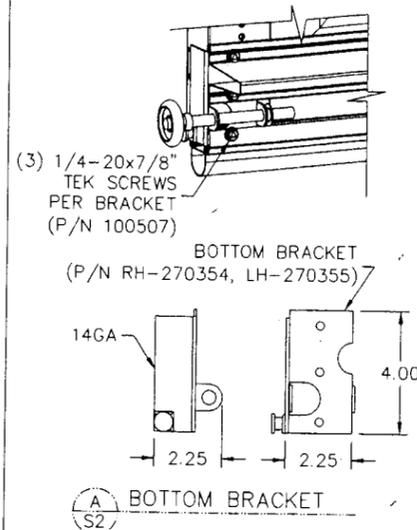

**PRODUCT RENEWED**  
 as complying with the Florida  
 Building Code  
 Acceptance No. ~~06-0921-02~~  
 Expiration Date ~~December 13, 2011~~  
 By *[Signature]*  
 Miami Dade Product Control  
 Division

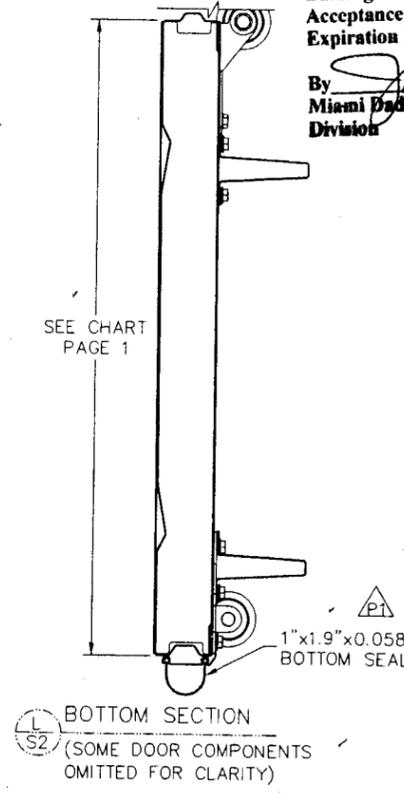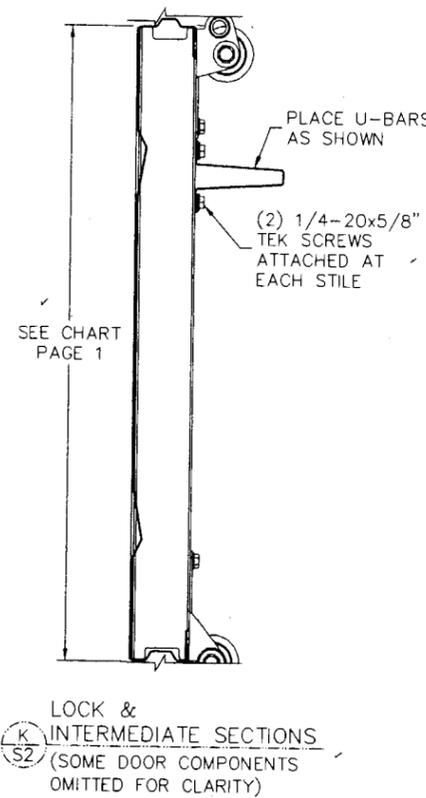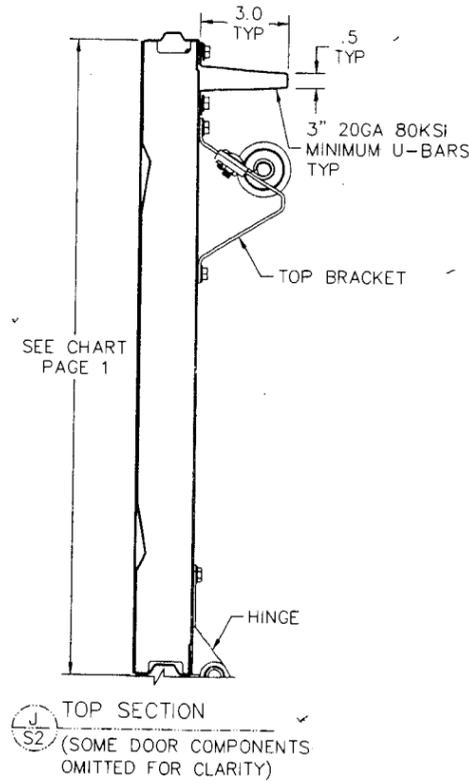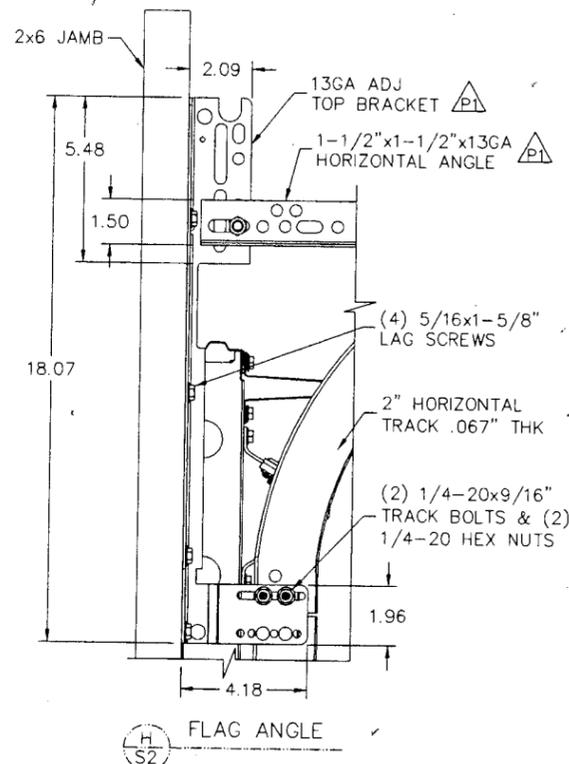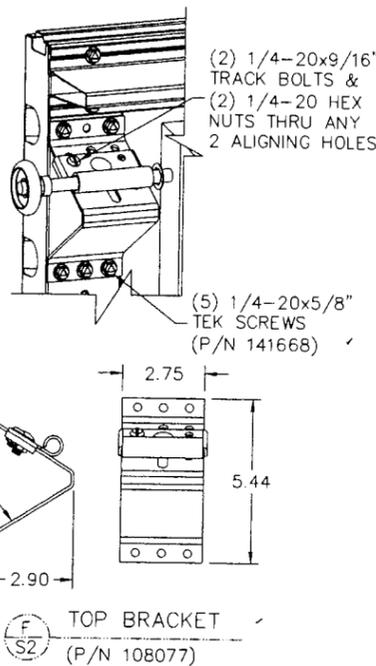

|  |        |
|--|--------|
| PART NO.                                       | 294823 |
| R & D RELEASE TO PRODUCT ENGINEERING           | DATE   |
| BY:  |        |
| (P) CHANGES                                    |        |
| P1 REV NOTES AND DESCR PER DADE CNTY MARK UPS. |        |
| 10/18/01 DCC                                   |        |

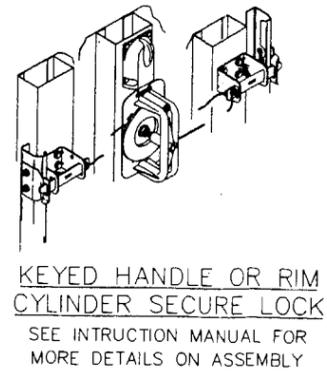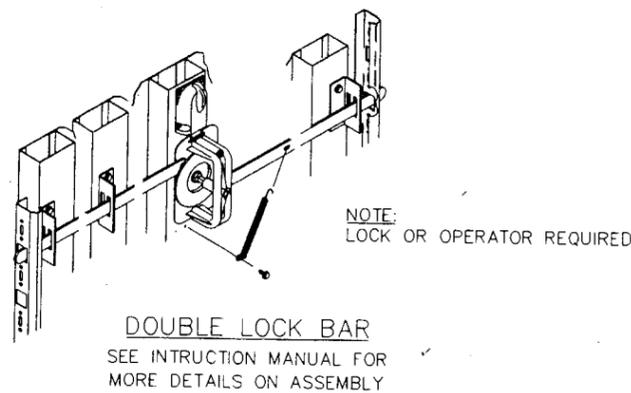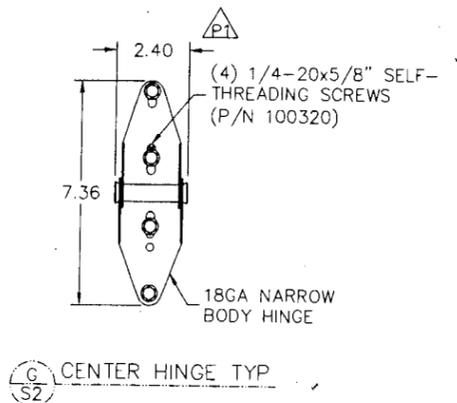

Approved: *[Signature]*  
 W.S. Wilson, P.E.  
 3395 ADDISON DR., PENSACOLA, FL 32514  
 FLORIDA CERTIFICATION NO. 0048489  
 GEORGIA CERTIFICATION NO. 018519  
 NORTH CAROLINA CERTIFICATION NO. 023836  
 Date: 11-7-01

DADE COUNTY USE ONLY  
 APPROVED AS COMPLYING WITH THE  
 SOUTH FLORIDA BUILDING CODE  
 DATE DEC 13 2001  
 BY *[Signature]*  
 PRODUCT CONTROL DIVISION  
 BUILDING CODE COMPLIANCE OFFICE  
 ACCEPTANCE NO. 01-0813.03

|                                     |  |             |           |         |                   |
|-------------------------------------|--|-------------|-----------|---------|-------------------|
| <b>Wayne Dalton</b>                 | 3395 ADDISON DRIVE<br>PENSACOLA, FLORIDA 32514<br>(850) 474-9890 | DRAWN       | DATE      | NAME    | SHEET 2 of 2      |
|                                     |  | CHECKED     | 6/28/2001 | K. HART |                   |
|                                     |  | APPR.       |           |         |                   |
| WAYNE MARK 8000 & 8100 RAISED PANEL |  |             |           |         | PROJECT           |
| DESIGN PRESSURE: ±37 PSF            |  |             |           |         | WINDLOAD \WMK8000 |
| SIZE                                | C  | OPTION CODE | REV       |         |                   |
|                                     |  | 0113        | P1        |         |                   |