



**BUILDING CODE COMPLIANCE OFFICE (BCCO)
PRODUCT CONTROL DIVISION**

**MIAMI-DADE COUNTY, FLORIDA
METRO-DADE FLAGLER BUILDING
140 WEST FLAGLER STREET, SUITE 1603
MIAMI, FLORIDA 33130-1563
(305) 375-2901 FAX (305) 375-2908**

NOTICE OF ACCEPTANCE (NOA)

**Wayne-Dalton Corporation
3395 Addison Drive
Pensacola, FL 32514**

SCOPE: This NOA is being issued under the applicable rules and regulations governing the use of construction materials. The documentation submitted has been reviewed by Miami-Dade County Product Control Division and accepted by the Board of Rules and Appeals (BORA) to be used in Miami Dade County and other areas where allowed by the Authority Having Jurisdiction (AHJ).

This NOA shall not be valid after the expiration date stated below. The Miami-Dade County Product Control Division (In Miami Dade County) and/or the AHJ (in areas other than Miami Dade County) reserve the right to have this product or material tested for quality assurance purposes. If this product or material fails to perform in the accepted manner, the manufacturer will incur the expense of such testing and the AHJ may immediately revoke, modify, or suspend the use of such product or material within their jurisdiction. BORA reserves the right to revoke this acceptance, if it is determined by Miami-Dade County Product Control Division that this product or material fails to meet the requirements of the applicable building code.

This product is approved as described herein, and has been designed to comply with the Florida Building Code, including the High Velocity Hurricane Zone.

DESCRIPTION: Waynemark 8000 & 8100 Raised Panel Steel Overhead Sectional Garage Door

APPROVAL DOCUMENT: Drawing No. 0114, titled "Waynemark 8000 & 8100 Raised Panel", sheets 1 through 2 of 2, prepared by Wayne-Dalton Corp., signed and sealed by W.S. Wilson, P.E., dated 06/27/01, with last revision P1 on 10/19/01, bearing the Miami-Dade County Product Control Renewal stamp with the Notice of Acceptance number and expiration date by the Miami-Dade County Product Control Division.

MISSILE IMPACT RATING: Large and Small Missile Impact

LABELING: Each unit shall bear a permanent label with the manufacturer's name or logo, city, state and following statement: "Miami-Dade County Product Control Approved or MDCPCA", unless otherwise noted herein.

RENEWAL of this NOA shall be considered after a renewal application has been filed and there has been no change in the applicable building code negatively affecting the performance of this product.

TERMINATION of this NOA will occur after the expiration date or if there has been a revision or change in the materials, use, and/or manufacture of the product or process. Misuse of this NOA as an endorsement of any product, for sales, advertising or any other purposes shall automatically terminate this NOA. Failure to comply with any section of this NOA shall be cause for termination and removal of NOA.

LIMITATIONS: This approval requires the manufacturer to do testing of all coils used to fabricate door panels under this Notice of Acceptance. A minimum of two specimens shall be cut from each coil and tensile tested according to ASTM E-8 by a Miami-Dade County approved laboratory selected and paid by the manufacturer. Every 3 months, four times a year, the manufacturer shall mail to this office: a copy of the tested reports with confirmation that the specimens were selected from coils at the manufacturer production facilities, and a notarized statement from the manufacturer that only coils with yield strength of 40ksi or more shall be used to make panels for Miami-Dade county under this Notice of Acceptance.

ADVERTISEMENT: The NOA number preceded by the words Miami-Dade County, Florida, and followed by the expiration date may be displayed in advertising literature. If any portion of the NOA is displayed, then it shall be done in its entirety.

INSPECTION: A copy of this entire NOA shall be provided to the user by the manufacturer or its distributors and shall be available for inspection at the job site at the request of the Building Official.

This NOA **renews NOA # 01-0813.06** and, consists of this page, evidence page E-1 as well as approval document mentioned above.

The submitted documentation was reviewed by **Jaime D. Gascon, P.E.**



*J. Gascon
1/23/07*

NOA No 06-0921.04

Expiration Date: December 13, 2011

Approval Date: February 15, 2007

Page 1

Wayne-Dalton Corporation

NOTICE OF ACCEPTANCE: EVIDENCE SUBMITTED

A. DRAWINGS

1. Drawing No. 0114, titled "Waynemark 8000 & 8100 Raised Panel", sheets 1 through 2 of 2, prepared by Wayne-Dalton Corp., signed and sealed by W.S. Wilson, P.E., dated 06/27/01, with last revision P1 on 10/19/01.

B. TESTS

1. Test Report on Large Missile Impact Test and Cyclic Wind Pressure Test of "Sectional Residential Garage Door Waynemark 8000-0114" prepared by Hurricane Engineering and Testing Inc. Report #01-993 dated 04/03/01 signed and sealed by HM Medina, PE.
2. Test Report on Uniform Static Air Pressure & Forced Entry Resistance Test "Sectional Residential Garage Door Waynemark 8000-0114" prepared by Hurricane Engineering and Testing Inc., Report No. 01-992, dated 04/02/01, signed and sealed by HM Medina, PE.
3. Test Report on ASTM B117-90 Test of 3"x9" galvanized panels (controls) & painted panels prepared by Sub-Tropical Testing Service, Test Number WDC-1, dated 04/26/01, signed and sealed by Mark Mosbat, P.E.

C. CALCULATIONS

1. Anchoring Method Summary, prepared by W. S. Wilson, Sheets 1 through 5 prepared, signed and sealed by W. S. Wilson, PE on 08/02/01.

D. QUALITY ASSURANCE

1. Building Code Compliance Office.

E. MATERIAL CERTIFICATIONS


1. Tensile Test Report No-HETI 01-T034, prepared Hurricane Engineering & Testing, Inc., dated 04/05/01, signed and sealed by H. M. Medina, PE.

F. STATEMENTS

1. Letter of code compliance issued by Wayne-Dalton Corporation, signed & sealed by W. S. Wilson, PE. on 08/02/01.
2. Letter of No Financial Interest issued by Wayne-Dalton Corporation, signed & sealed by W. S. Wilson, PE on 08/02/01.
3. No change in product since last approved letter issued by Wayne-Dalton Corporation on 09/11/06, signed by W.S. Wilson, P.E.




Jaime D. Gascon, P.E.
Chief, Product Control Division
NOA No 06-0921.04
Expiration Date: December 13, 2011
Approval Date: February 15, 2007

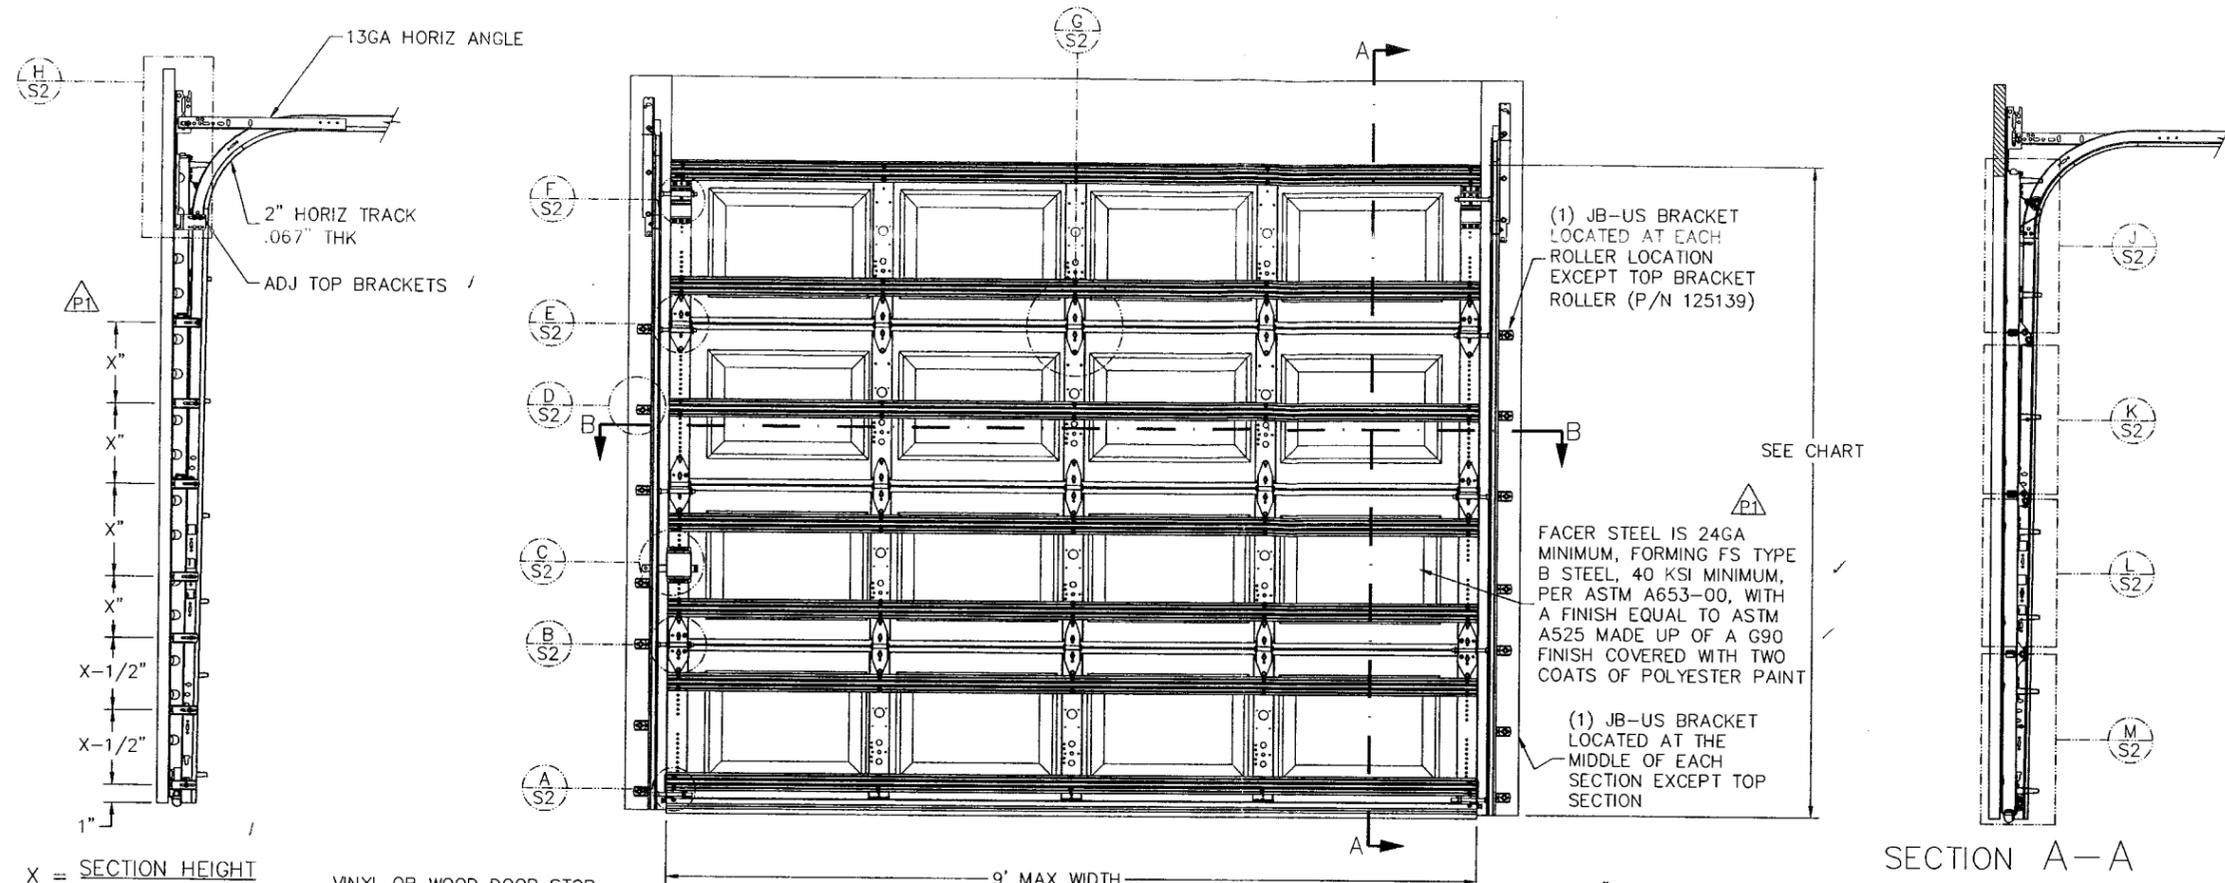

X = SECTION HEIGHT
2

VINYL OR WOOD DOOR STOP (NAILED ON 6" CENTERS) MUST OVERLAP TOP AND BOTH ENDS OF PANELS MINIMUM 7/16" TO MEET NEGATIVE PRESSURES

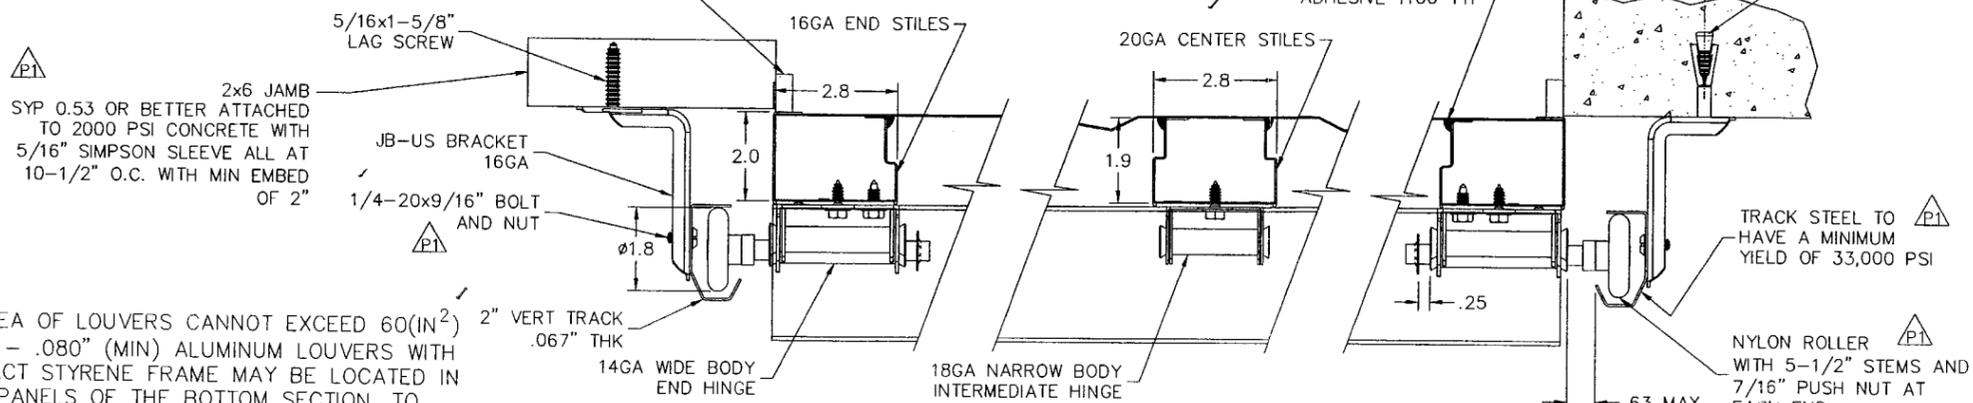

SECTION B-B

NOTE:
TOTAL AREA OF LOUVERS CANNOT EXCEED 60(IN²)
OPTIONAL - .080" (MIN) ALUMINUM LOUVERS WITH HIGH IMPACT STYRENE FRAME MAY BE LOCATED IN THE END PANELS OF THE BOTTOM SECTION. TO MEET MINIMUM VENTILATION REQUIREMENTS.

DOOR HEIGHT	U-BARS	SECTION HEIGHTS								JB-US BRACKETS
		BOTTOM	#2	#3	#4	#5	#6	#7	TOP	
6'-6"	7	21"	18"	18"					21"	7
7'-0"	7	21"	21"	21"					21"	7
7'-6"	9	18"	18"	18"	18"				18"	9
8'-0"	9	21"	18"	18"	18"				21"	9
9'-0"	11	18"	18"	18"	18"	18"			18"	11
10'-0"	11	21"	21"	21"	18"	18"			21"	11
11'-0"	13	21"	18"	18"	18"	18"	18"		21"	13
12'-0"	13	21"	21"	21"	21"	21"	21"		18"	13
13'-0"	15	21"	21"	21"	18"	18"	18"	18"	21"	15
14'-0"	15	21"	21"	21"	21"	21"	21"	21"	21"	15

(1) JB-US BRACKET LOCATED AT EACH ROLLER LOCATION EXCEPT TOP BRACKET ROLLER (P/N 125139)

FACER STEEL IS 24GA MINIMUM, FORMING FS TYPE B STEEL, 40 KSI MINIMUM, PER ASTM A653-00, WITH A FINISH EQUAL TO ASTM A525 MADE UP OF A G90 FINISH COVERED WITH TWO COATS OF POLYESTER PAINT

(1) JB-US BRACKET LOCATED AT THE MIDDLE OF EACH SECTION EXCEPT TOP SECTION

SECTION A-A

PRODUCT RENEWED
as complying with the Florida Building Code
Acceptance No 06-0921-04
Expiration Date 12/13/2011















By *[Signature]*
Miami Dade Product Control Division

APPROVED AS COMPLYING WITH THE SOUTH FLORIDA BUILDING CODE
DATE DEC 13 2001
BY *[Signature]*
PRODUCT CONTROL DIVISION
BUILDING CODE COMPLIANCE OFFICE
ACCEPTANCE NO. 01-0813.06

Approved: *[Signature]*
W.S. Wilson, P.E.
3395 ADDISON DR., PENSACOLA, FL 32514
FLORIDA CERTIFICATION NO. 0048489
GEORGIA CERTIFICATION NO. 018519
NORTH CAROLINA CERTIFICATION NO. 023836
Date: 11-7-01

Wayne Dalton	3395 ADDISON DRIVE PENSACOLA, FLORIDA 32514 (850) 474-9890		DATE	NAME	SHEET 1 of 2
	DRAWN	6/27/2001	D. RESTER		
	CHECKED				
WAYNE MARK 8000 & 8100 RAISED PANEL				PROJECT	
DESIGN PRESSURE: +46.0 PSF / -52.0 PSF				WINDLOAD\WMK8000	
				OPTION CODE	REV
				0114	P1

PART NO. 294822
R & D RELEASE TO PRODUCT ENGINEERING
BY:
CHANGES
P1 REV NOTES AND DESCR PER DADE CNTY MARK UPS.
10/19/01 DCC

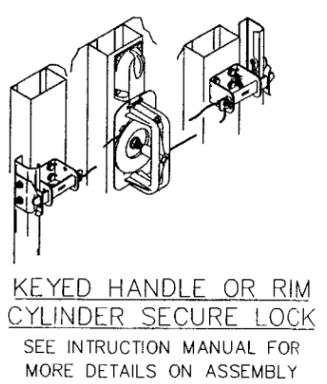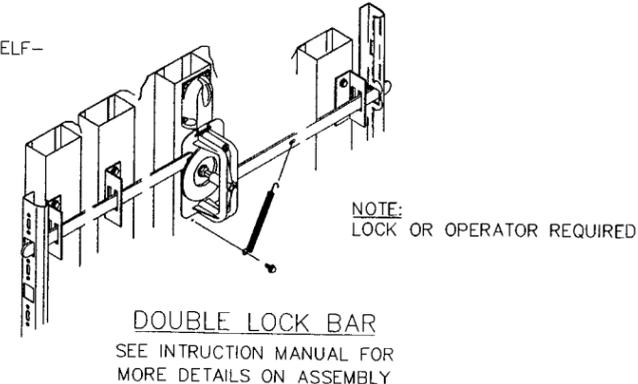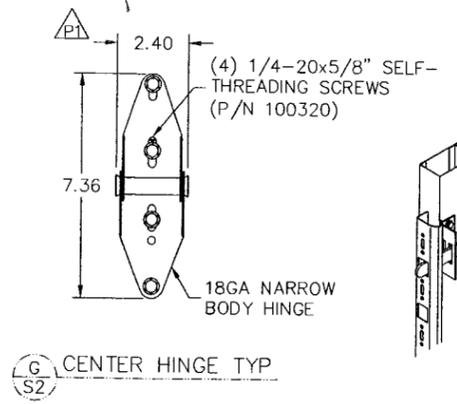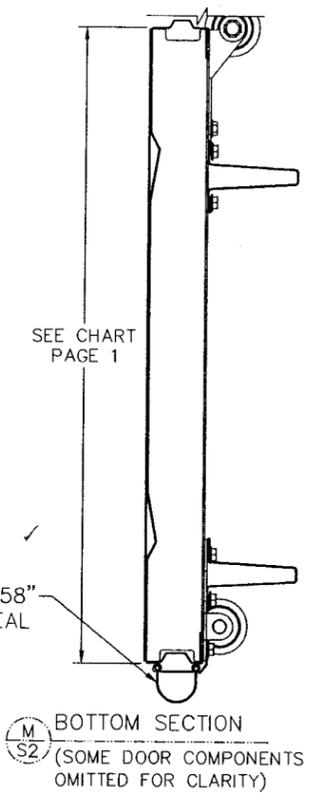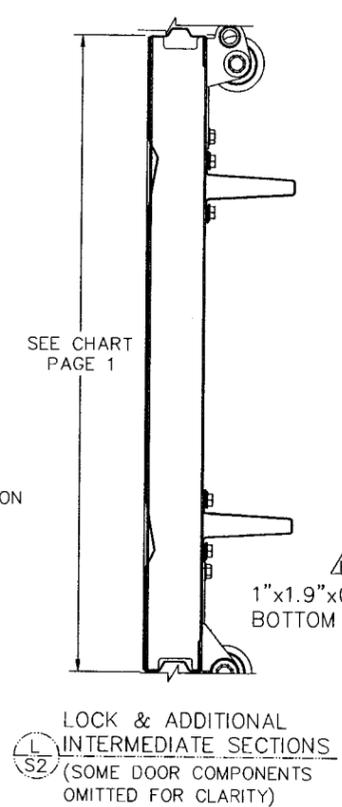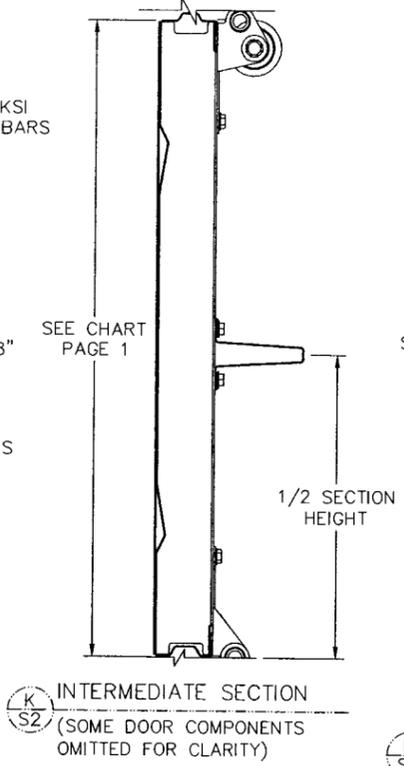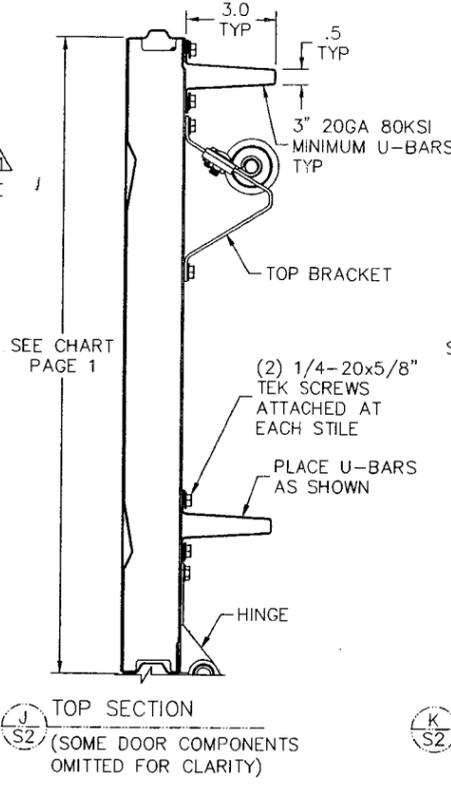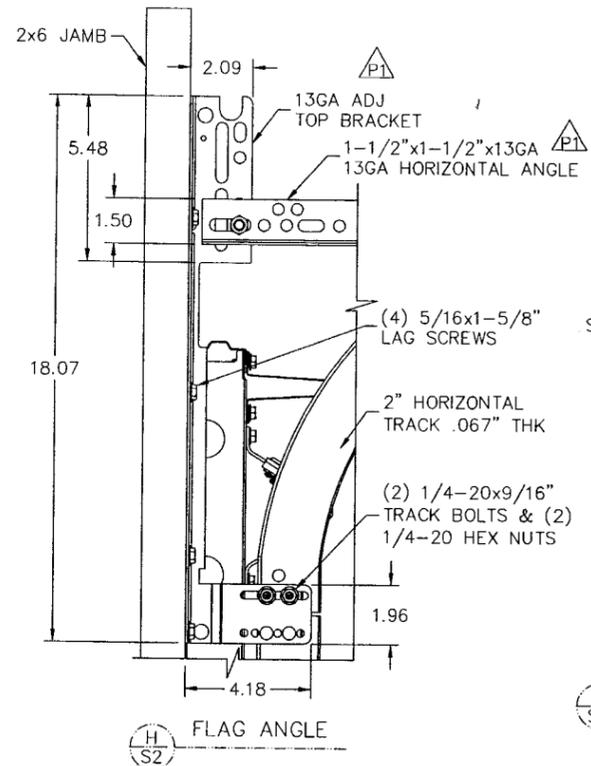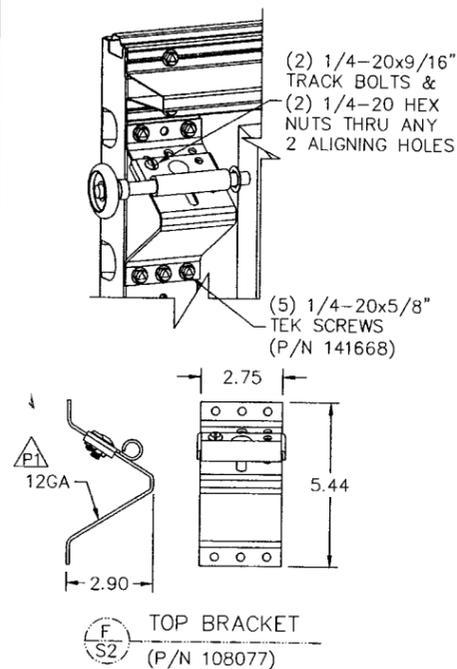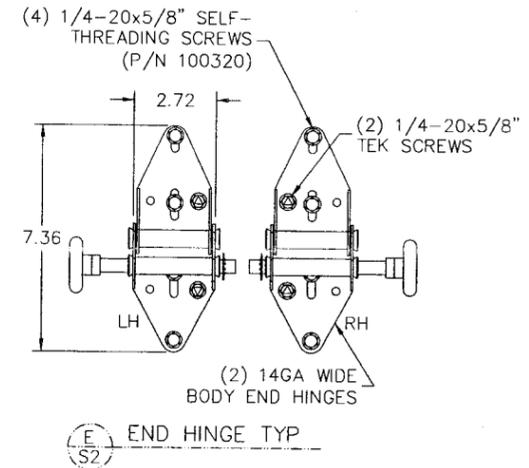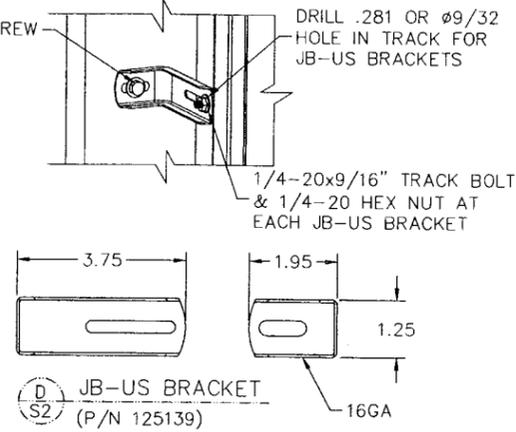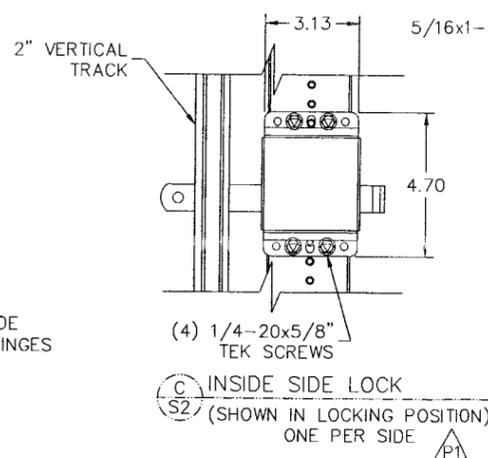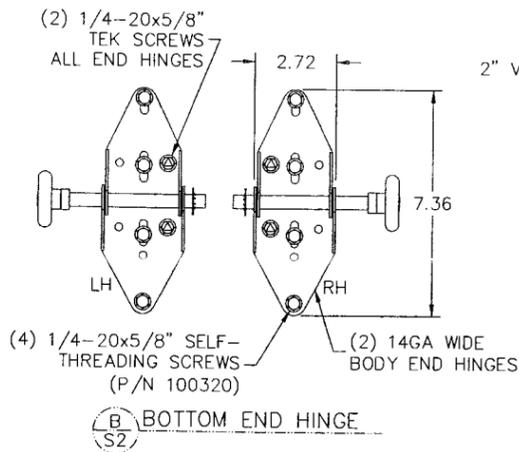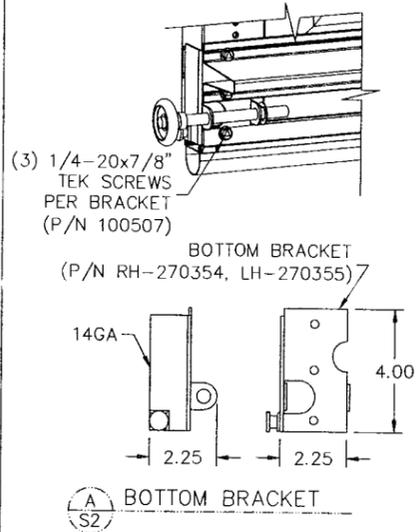

PART NO.	
294822	
R & D RELEASE TO PRODUCT ENGINEERING	DATE
BY:	
(P) CHANGES	
P1 REV NOTES AND DESCR PER DADE CNTY MARK UPS.	
10/19/01 DCC	

Approved: *[Signature]*

W.S. Wilson, P.E.
3395 ADDISON DR., PENSACOLA, FL 32514
FLORIDA CERTIFICATION NO. 0048489
GEORGIA CERTIFICATION NO. 018519
NORTH CAROLINA CERTIFICATION NO. 023836

Date: 11-7-01

DADE COUNTY USE ONLY

APPROVED AS COMPLYING WITH THE SOUTH FLORIDA BUILDING CODE

DATE DEC 13 2001

BY *[Signature]*

PRODUCT CONTROL DIVISION
BUILDING CODE COMPLIANCE OFFICE
ACCEPTANCE NO. 01-0813.06

PRODUCT RENEWED
as complying with the Florida Building Code
Acceptance No. 06-0921.04
Expiration Date 12/13/2011

By *[Signature]*
Miami Dade Product Control Division

Wayne Dalton	3395 ADDISON DRIVE PENSACOLA, FLORIDA 32514 (850) 474-9890		DATE	NAME	SHEET 2 of 2
	DRAWN	6/27/2001	D. RESTER		
	CHECKED				
WAYNEMARK 8000 & 8100 RAISED PANEL			APPR.		PROJECT WINDLOAD\WMK8000
DESIGN PRESSURE: +46.0 PSF/-52.0 PSF			SIZE C	OPTION CODE 0114	REV P1