



BUILDING CODE COMPLIANCE OFFICE (BCCO)  
PRODUCT CONTROL DIVISION

MIAMI-DADE COUNTY, FLORIDA  
METRO-DADE FLAGLER BUILDING  
140 WEST FLAGLER STREET, SUITE 1603  
MIAMI, FLORIDA 33130-1563  
(305) 375-2901 FAX (305) 375-2908

**NOTICE OF ACCEPTANCE (NOA)**

[www.buldingcodeonline.com](http://www.buldingcodeonline.com)

**Simonton Building Products, Inc. dba Simonton Windows**  
**One Cochrane Drive**  
**Pennsboro, WV 26415**

**SCOPE:**

This NOA is being issued under the applicable rules and regulations governing the use of construction materials. The documentation submitted has been reviewed by Miami-Dade County Product Control Division and accepted by the Board of Rules and Appeals (BORA) to be used in Miami Dade County and other areas where allowed by the Authority Having Jurisdiction (AHJ).

This NOA shall not be valid after the expiration date stated below. The Miami-Dade County Product Control Division (In Miami Dade County) and/or the AHJ (in areas other than Miami Dade County) reserve the right to have this product or material tested for quality assurance purposes. If this product or material fails to perform in the accepted manner, the manufacturer will incur the expense of such testing and the AHJ may immediately revoke, modify, or suspend the use of such product or material within their jurisdiction. BORA reserves the right to revoke this acceptance, if it is determined by Miami-Dade County Product Control Division that this product or material fails to meet the requirements of the applicable building code.

This product is approved as described herein, and has been designed to comply with the Florida Building Code, including the High Velocity Hurricane Zone.

**DESCRIPTION: Series 300VL Stormbreaker Plus White PVC Double Hung Window – L.M.I.**

**APPROVAL DOCUMENT:** Drawing No. DA0003, titled "Stormbreaker Plus Vinyl Double Hung Window NOA", sheets 1 to 8 of 8, dated 01/26/07, with revision #3 dated 5/1/07, prepared by manufacturer, signed and sealed by Charles A. Pagen, P.E., bearing the Miami-Dade County Product Control Revision stamp with the Notice of Acceptance number and expiration date by the Miami-Dade County Product Control Division.

**MISSILE IMPACT RATING: Large and Small Missile Impact Resistant**

**LABELING:** Each unit shall bear a permanent label with the manufacturer's name or logo, city, state and following statement: "Miami-Dade County Product Control Approved", unless otherwise noted herein.

**RENEWAL** of this NOA shall be considered after a renewal application has been filed and there has been no change in the applicable building code negatively affecting the performance of this product.

**TERMINATION** of this NOA will occur after the expiration date or if there has been a revision or change in the materials, use, and/or manufacture of the product or process. Misuse of this NOA as an endorsement of any product, for sales, advertising or any other purposes shall automatically terminate this NOA. Failure to comply with any section of this NOA shall be cause for termination and removal of NOA.

**ADVERTISEMENT:** The NOA number preceded by the words Miami-Dade County, Florida, and followed by the expiration date may be displayed in advertising literature. If any portion of the NOA is displayed, then it shall be done in its entirety.

**INSPECTION:** A copy of this entire NOA shall be provided to the user by the manufacturer or its distributors and shall be available for inspection at the job site at the request of the Building Official.

This NOA revises NOA # 04-0421.03 and consists of this page 1 and evidence page E-1, as well as approval document mentioned above.

The submitted documentation was reviewed by **Manuel Perez, P.E.**



**NOA No. 07-0309.07**  
**Expiration Date: August 05, 2009**  
**Approval Date: June 7, 2007**  
**Page 1**

Simonton Windows

NOTICE OF ACCEPTANCE: EVIDENCE SUBMITTED

**A. DRAWINGS**

1. Manufacturer's die drawings and sections.
2. Drawing No **DA0003**, Sheets 1 through 8 of 8, titled "Stormbreaker Plus Vinyl Double Hung Windows NOA", dated 1/26/07 with revision #3 dated 5/1/07, prepared by manufacturer, signed and sealed by Charles A. Pagen, P.E.

**B. TESTS**

1. Test reports on 1) Air Infiltration Test, per FBC, TAS 202-94  
2) Uniform Static Air Pressure Test, Loading per FBC TAS 202-94  
3) Water Resistance Test, per FBC, TAS 202-94  
4) Large Missile Impact Test, per FBC, TAS 201-94  
5) Cyclic Wind Pressure Loading per FBC, TAS 203-94  
6) Forced Entry Test, per FBC 2411.3.2.1 (b) and TAS 202-94  
along with marked-up drawings and installation diagram of PVC double hung window, prepared by Architectural Testing Inc., Test Report No. **ATI-01-48833.02** dated 04/14/04, signed and sealed by Joseph A. Reed, P.E.

**C. CALCULATIONS**

1. Anchor verification calculations and structural analysis, complying with FBC-2004, dated 1/26/07 and revised on 5/11/07, prepared, signed and sealed by Charles A. Pagen, P.E.  
**Complies with ASTM E1300-98**

**D. QUALITY ASSURANCE**

1. Miami Dade Building Code Compliance Office (BCCO).

**E. MATERIAL CERTIFICATIONS**


1. Notice of Acceptance No. **03-0421.02** issued to Solutia, Inc. for "Saflex III G" dated 01/08/04, expiring on 05/21/06.
2. Notice of Acceptance No. **00-1212.04** issued to E.I. DuPont DeNemours for "Dupont Butacite ® PVB" dated 02/15/01, expiring on 12/11/05.

**F. STATEMENTS**

1. Statement letter of conformance, dated January 26, 2007, signed and sealed by Charles A. Pagen, P.E.
2. Statement letter of no financial interest, dated January 26, 2007, signed and sealed by Charles A. Pagen, P.E.

**G. OTHER**

1. Notice of Acceptance No. **04-0421.03**, issued to Simonton Windows for their Series 5500 Storm Breaker PVC Double Hung Window, approved on 08/05/04 and expiring on 08/05/09.

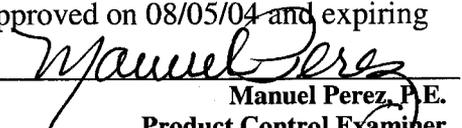

Manuel Perez, P.E.  
Product Control Examiner  
NOA No. 07-0309.07

Expiration Date: August 05, 2009

Approval Date: June 7, 2007



1 COCHRANE AVE. PENNSBORO, WV 26415 PH.  
800-426-2249

# STORMBREAKER PLUS 300VL IMPACT RESISTANT VINYL DOUBLE HUNG WINDOWS


### GENERAL NOTES:

1. THIS PRODUCT IS DESIGNED TO COMPLY WITH THE 'HVHZ' OF FLORIDA BUILDING CODE.
2. WOOD BUCKS BY OTHERS, MUST BE PROPERLY ENGINEERED AND ANCHORED TO TRANSFER LOADS TO STRUCTURE AND THE INSTALLATION IS TO BE REVIEWED BY BUILDING OFFICIAL.
3. PRODUCT ANCHORS SHALL BE AS LISTED AND SPACED AS SHOWN ON DETAILS. ANCHOR EMBEDMENT TO BASE MATERIAL SHALL BE BEYOND WALL DRESSING OR STUCCO.
4. FOR DESIGN PRESSURE RATING SEE CHART THIS SHEET.
5. INSTALLATION OF THIS SYSTEM DOES NOT REQUIRE THE USE OF APPROVED SHUTTER/EXTERNAL PROTECTION DEVICE.
6. THIS PRODUCT MEETS THE WATER REQUIREMENTS FOR HIGH VELOCITY HURRICANE ZONES.


TABLE OF CONTENTS	
SHEET #	DESCRIPTION
1	GENERAL NOTES & TYPICAL ELEVATIONS
2	VERTICAL CROSS SECTIONS (2X) & GLAZING DETAILS
3	HORIZONTAL CROSS SECTIONS (2X) & GLAZING DETAILS
4	VERTICAL & HORIZONTAL CROSS SECTIONS (1X)
5	ANCHORING LOCATIONS
6	BILL OF MATERIALS & COMPONENTS
7	COMPONENTS

1" INSULATED GLASS	SIZE	DESIGN PRESSURE RATINGS	
3/16" TEMP AIR 1/8" ANN - 0.100 PVB - 1/8" ANN	UP TO 53" X 71"	POS. 55.0 PSF	NEG. 58.0 PSF
3/16" TEMP AIR 1/8" ANN - 0.100 PVB - 1/8" ANN	UP TO 37" X 76"	POS. 60.0 PSF	NEG. 70.0 PSF
1/8" TEMP AIR 1/8" ANN - 0.100 PVB - 1/8" ANN	UP TO 53" X 71"	POS. 52.8 PSF	NEG. 52.8 PSF
1/8" TEMP AIR 1/8" ANN - 0.100 PVB - 1/8" ANN	UP TO 53" X 68"	POS. 55.0 PSF	NEG. 55.0 PSF
1/8" TEMP AIR 1/8" ANN - 0.100 PVB - 1/8" ANN	UP TO 53" X 64.5"	POS. 55.0 PSF	NEG. 58.0 PSF
1/8" TEMP AIR 1/8" ANN - 0.100 PVB - 1/8" ANN	UP TO 37" X 76"	POS. 60.0 PSF	NEG. 70.0 PSF

REVISIONS			
REV.	DESCRIPTION	DATE	BY
1	ADDED TAPCON TX INSTALLATION METHOD (SHEET 4 & 5)	1/22/07	GLS
2	REVISED MARKETING NAME 5500 SERIES TO 300VL (SHEET 1)	3/26/07	GLS
3	ADDED SYMBOLS & NOTES (SHEET 1, 6 & 7)	5/1/07	GLS

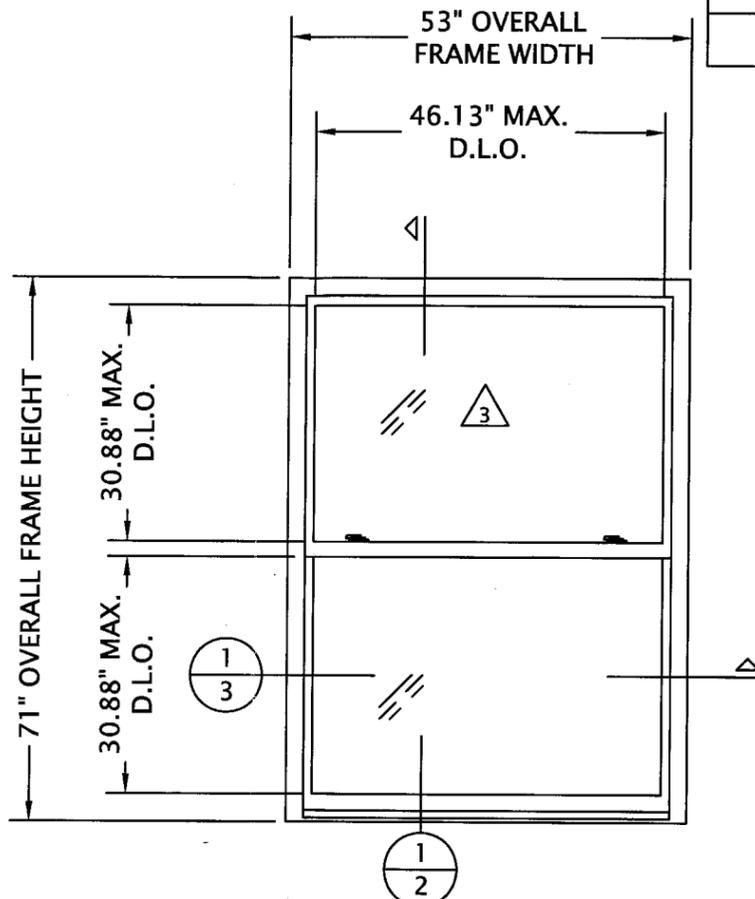

53" X 71" DOUBLE HUNG WINDOW  
W/ STEEL REINFORCEMENT  
1" INSULATED, IMPACT RESISTANT GLAZING  
VIEWED FROM EXTERIOR

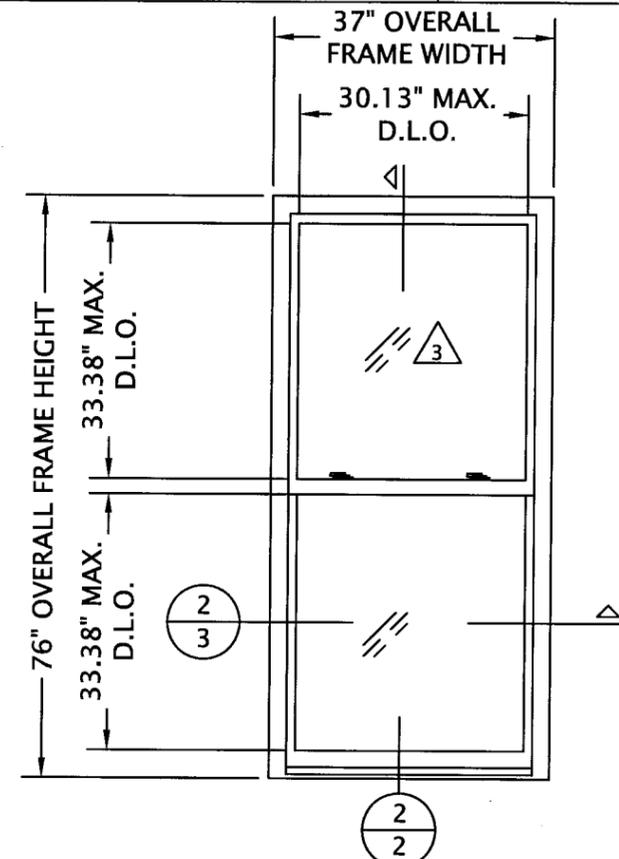


37" X 76" DOUBLE HUNG WINDOW  
W/ ALUMINUM REINFORCEMENT  
1" INSULATED, IMPACT RESISTANT GLAZING  
VIEWED FROM EXTERIOR


PRODUCT REVISED  
as complying with the Florida  
Building Code  
Acceptance No. 07-0309.07  
Expiration Date AUG. 5, 2009  
By *Manuel Perez*  
Miami Dade Product Control  
Division

 CHARLES A. PAGEN, P.E. FL. REG. ENG. # 49121 DATE: 5/1/07		SIZE: B DRAWING NUMBER: DA0003 REV: 1
		DRAWN BY: GLS CHECKED BY: PR APPROVED BY: CAP DATE: 1/22/07 DATE: 1/26/07 DATE: 1/26/07
SCALE: FIT SHEET: 1 of 8 SERIES: STORMBREAKER PLUS VINYL TITLE: DOUBLE HUNG WINDOWS NOA		


REVISIONS			
REV.	DESCRIPTION	DATE	BY
1	ADDED TAPCON 1X INSTALLATION METHOD (SHEET 4 & 5)	1/22/07	GLS
2	REVISED MARKETING NAME FROM 5500 SERIES TO 300VL (SHEET 1)	3/26/07	GLS
3	ADDED SYMBOLS & NOTES (SHEET 1, 6 & 7)	5/1/07	GLS

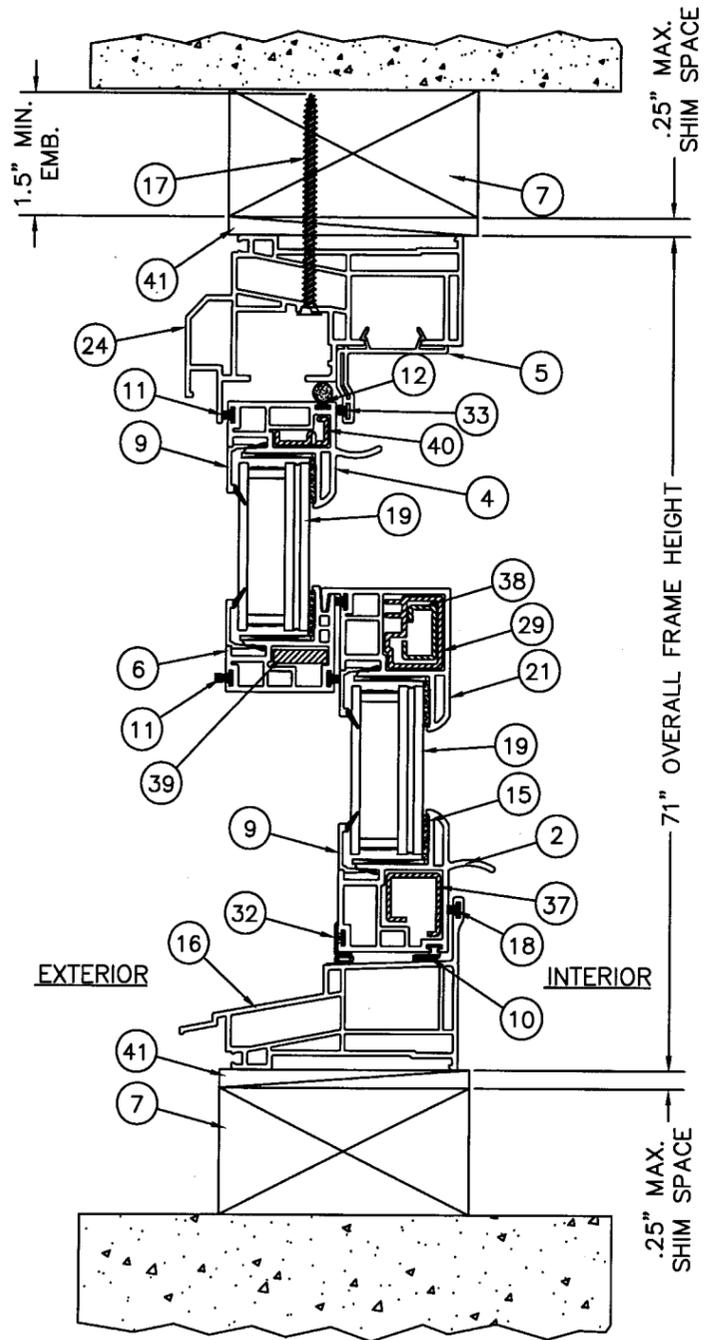


1 VERTICAL CROSS SECTION  
2 53" x 71" DOUBLE HUNG  
W/ STEEL REINFORCEMENTS

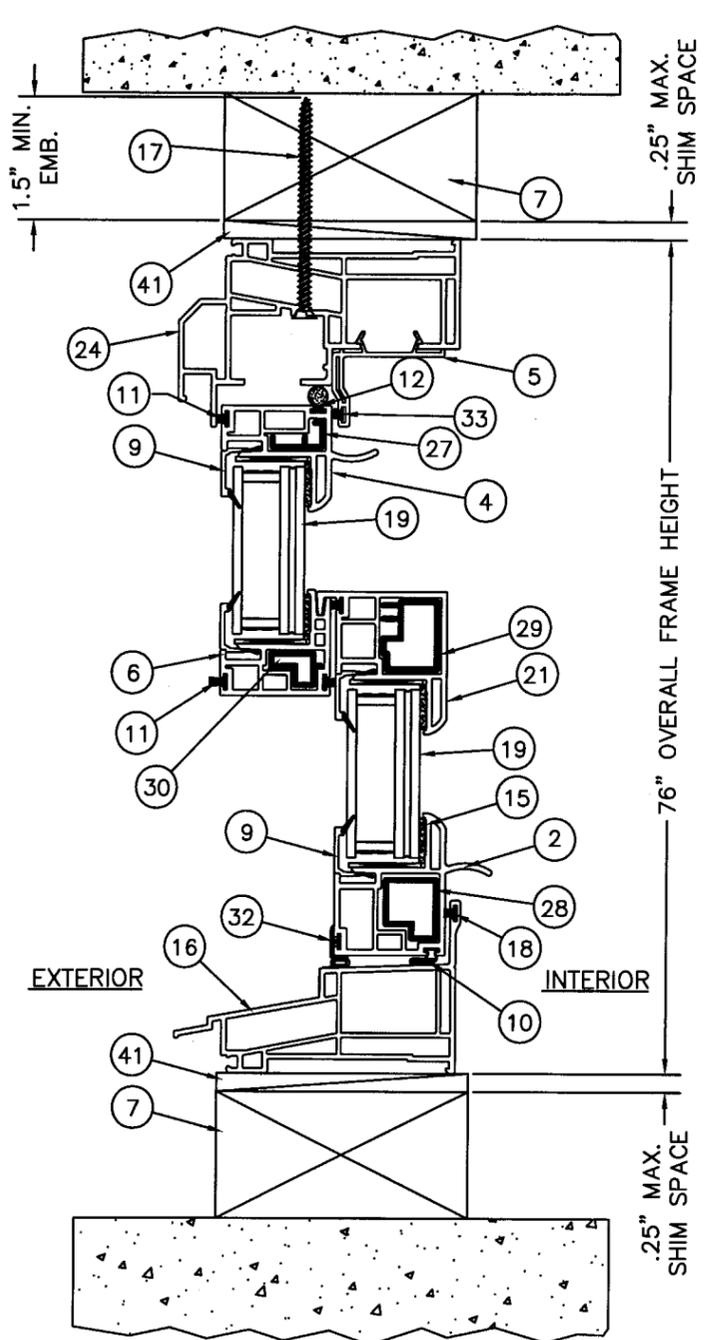

2 VERTICAL CROSS SECTION  
2 37" x 76" DOUBLE HUNG  
W/ ALUMINUM REINFORCEMENTS

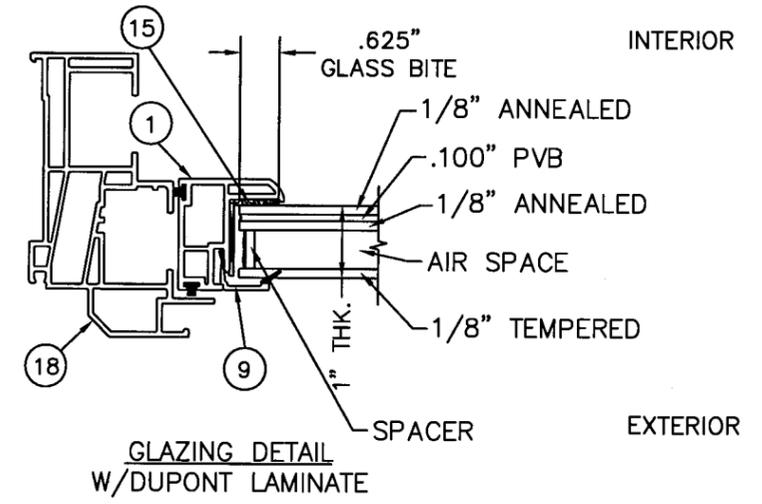

GLAZING DETAIL  
W/DUPONT LAMINATE

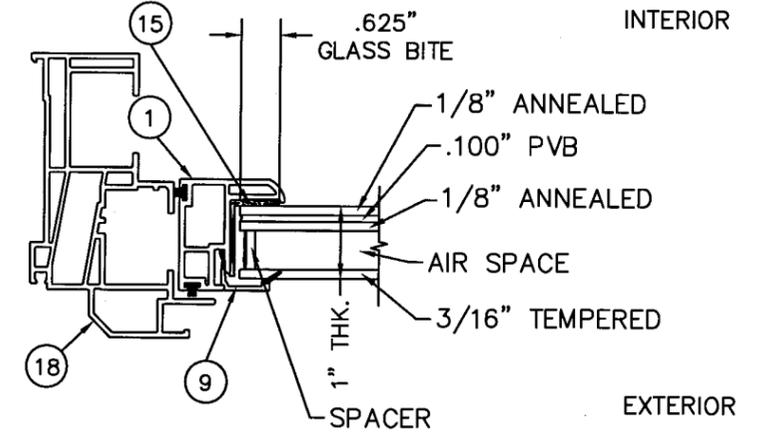





GLAZING DETAIL  
W/DUPONT LAMINATE

NOTE:  
UNITS LARGER THAN 37" x 76"  
USE STEEL REINFORCEMENTS.

**PRODUCT REVISED**  
as complying with the Florida  
Building Code  
Acceptance No. 07-0309.07  
Expiration Date Aug. 5, 2009  
By *Manuel Perez*  
Miami Dade Product Control  
Division

 CHARLES A. PAGEN, P.E. FL. REG. ENG. # 49121 DATE: 5/11/07		 SIMONTON WINDOWS	SIZE: B DRAWING NUMBER: DA0003 REV: 1
			DRAWN BY: GLS DATE: 1/22/07 CHECKED BY: PR DATE: 1/26/07 APPROVED BY: CAP DATE: 1/26/07
SCALE: FIT		SHEET 2 of 8	SERIES: STORMBREAKER PLUS VINYL
TITLE: DOUBLE HUNG WINDOWS NDA (2X CROSS SECTION)			

REVISIONS			
REV.	DESCRIPTION	DATE	BY
1	ADDED TAPCON 1X INSTALLATION METHOD (SHEET 4 & 5)	1/22/07	GLS
2	REVISED MARKETING NAME FROM 5500 SERIES TO 300VL (SHEET 1)	3/26/07	GLS
3	ADDED SYMBOLS & NOTES (SHEET 1, 6 & 7)	5/1/07	GLS

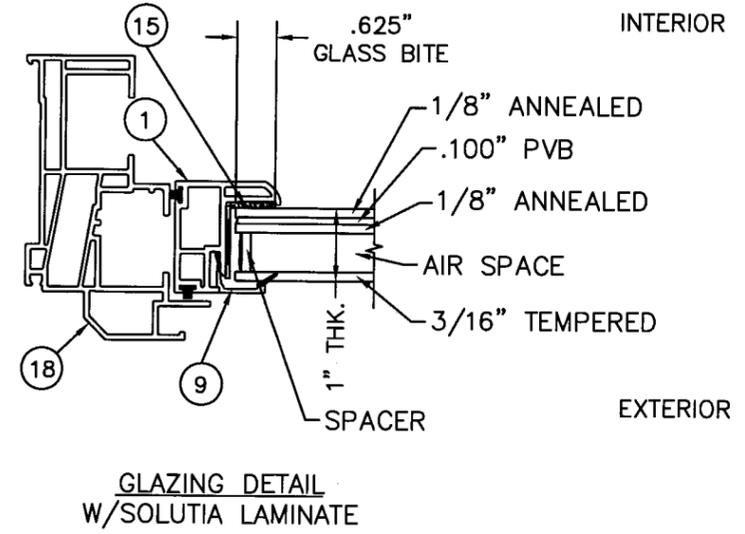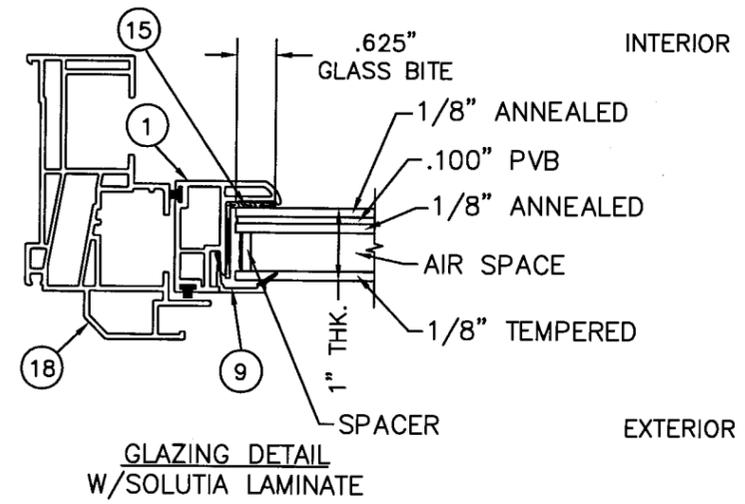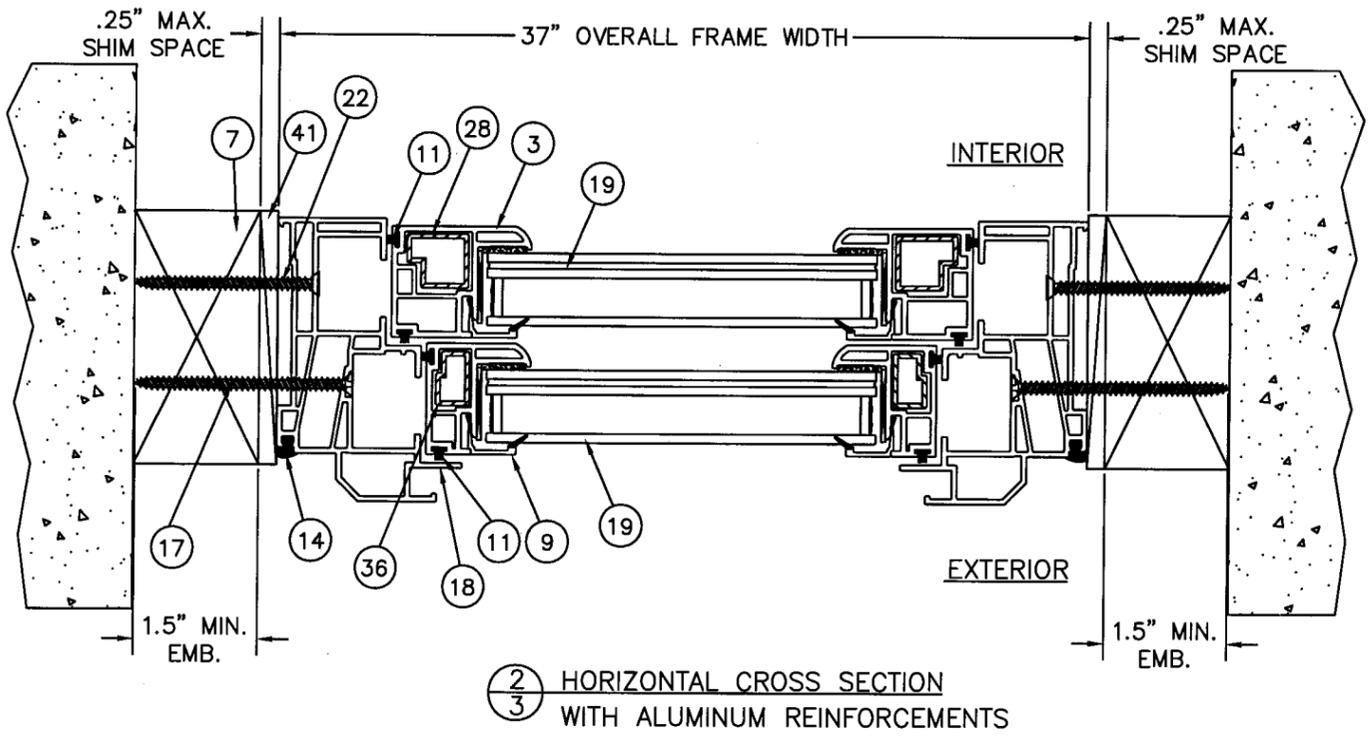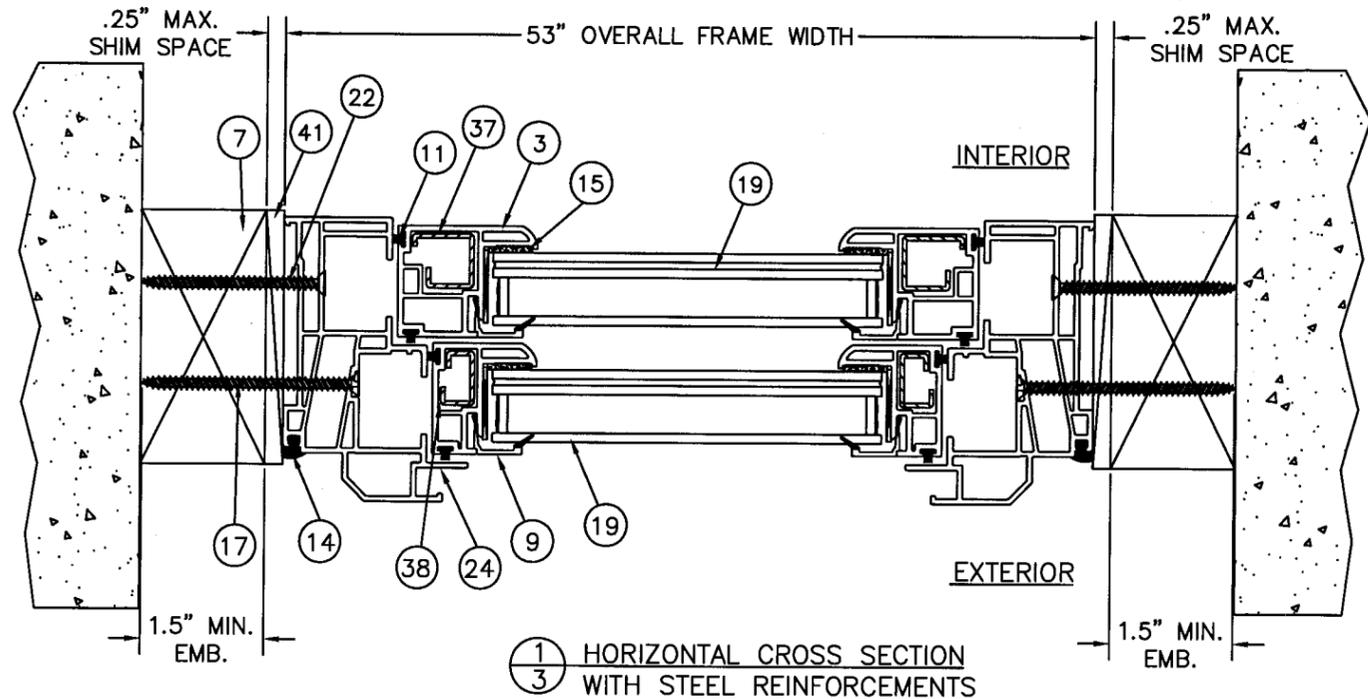


NOTE:  
UNITS LARGER THAN 37" x 76"  
USE STEEL REINFORCEMENTS.


PRODUCT REVISED  
as complying with the Florida  
Building Code  
Acceptance No. 07-0309.07  
Expiration Date AUG. 5, 2009  
By *Manuel Perez*  
Miami Code Product Control  
Division

 CHARLES A. PAGEN, P.E. FL. REG. ENG. # 49121 DATE: 5/11/07		SIZE: B DRAWING NUMBER: DA0003 REV: 1
		SIMONTON WINDOWS
SCALE: FIT SHEET: 3 of 8 SERIES: STORMBREAKER PLUS VINYL TITLE: DOUBLE HUNG WINDOWS NDA (2X CROSS SECTION)	DRAWN BY: GLS CHECKED BY: PR APPROVED BY: CAP	DATE: 1/22/07 DATE: 1/26/07 DATE: 1/26/07

REVISIONS			
REV.	DESCRIPTION	DATE	BY
1	ADDED TAPCON 1X INSTALLATION METHOD (SHEET 4 & 5)	1/22/07	GLS
2	REVISED MARKETING NAME FROM 5500 SERIES TO 300VL (SHEET 1)	3/26/07	GLS
3	ADDED SYMBOLS & NOTES (SHEET 1, 6 & 7)	5/1/07	GLS

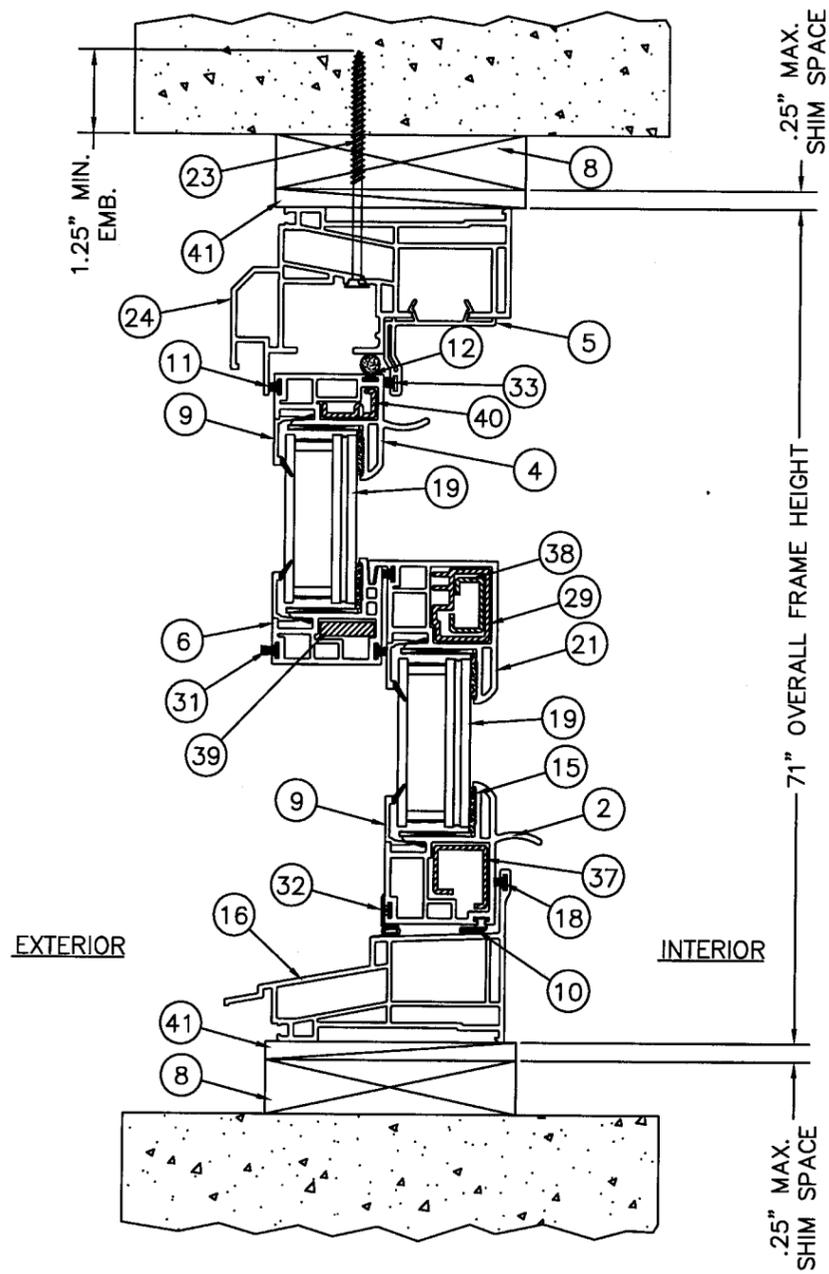

1 VERTICAL CROSS SECTION  
2 53" x 71" DOUBLE HUNG  
W/ STEEL REINFORCEMENTS

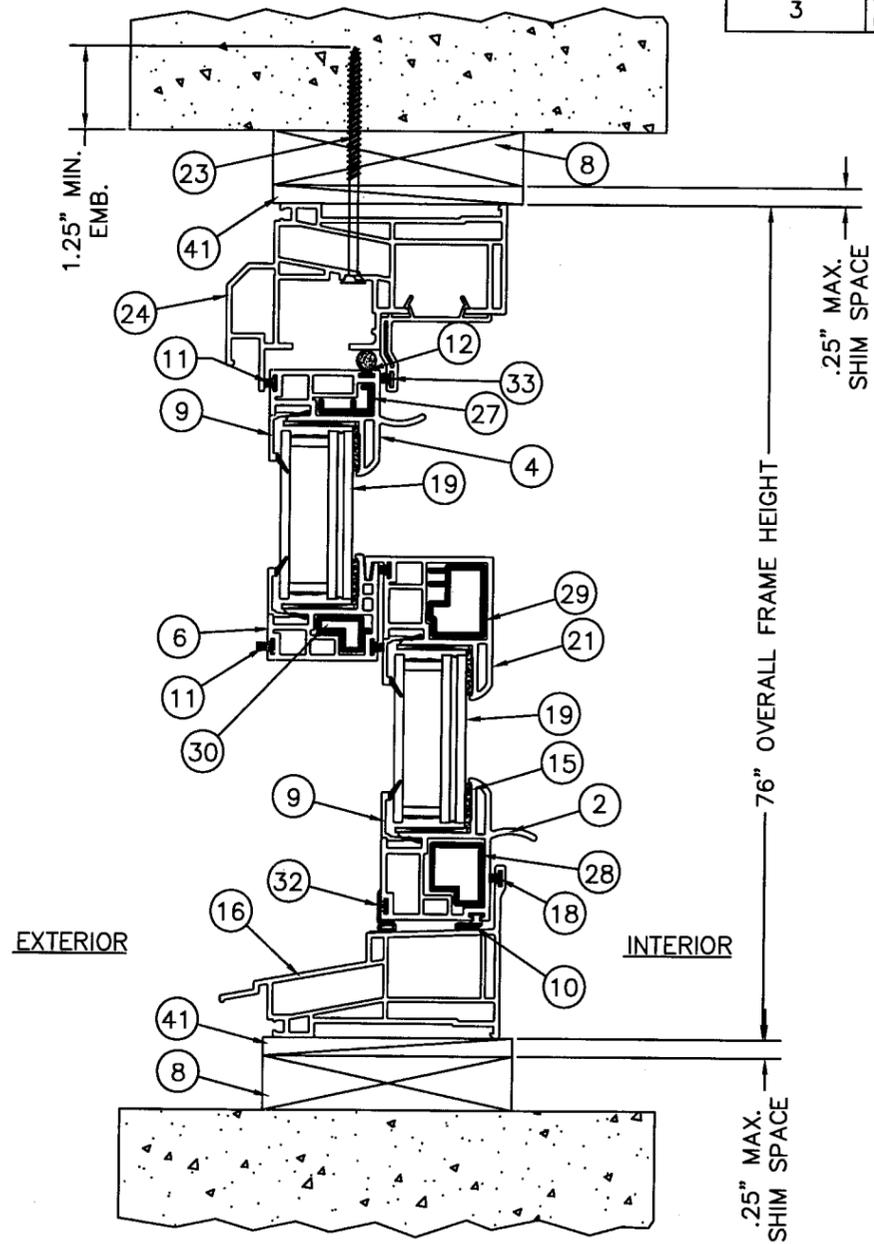


2 VERTICAL CROSS SECTION  
2 37" x 76" DOUBLE HUNG  
W/ ALUMINUM REINFORCEMENTS


PRODUCT REVISED  
as complying with the Florida  
Building Code  
Acceptance No. 07-0309.07  
Expiration Date AUG. 5, 2009  
By *Maurel Perez*  
Miami/Dade Product Control  
Division

 CHARLES A. PAGEN, P.E. FL. REG. ENG. # 49121 DATE: 5/11/07		SIMANTON WINDOWS	SIZE: B DRAWING NUMBER: DA0003 DRAWN BY: TDD CHECKED BY: PR APPROVED BY: CAP	REV. 1 DATE: 1/22/07 DATE: 1/26/07 DATE: 1/26/07
SCALE: FIT		SHEET: 4 of 8		
SERIES: STORMBREAKER PLUS VINYL				
TITLE: DOUBLE HUNG WINDOWS (IX CROSS SECTION)				

REVISIONS			
REV.	DESCRIPTION	DATE	BY
1	ADDED TAPCON 1X INSTALLATION METHOD (SHEET 4 & 5)	1/22/07	GLS
2	REVISED MARKETING NAME FROM 5500 SERIES TO 300VL (SHEET 1)	3/26/07	GLS
3	ADDED SYMBOLS & NOTES (SHEET 1, 6 & 7)	5/1/07	GLS

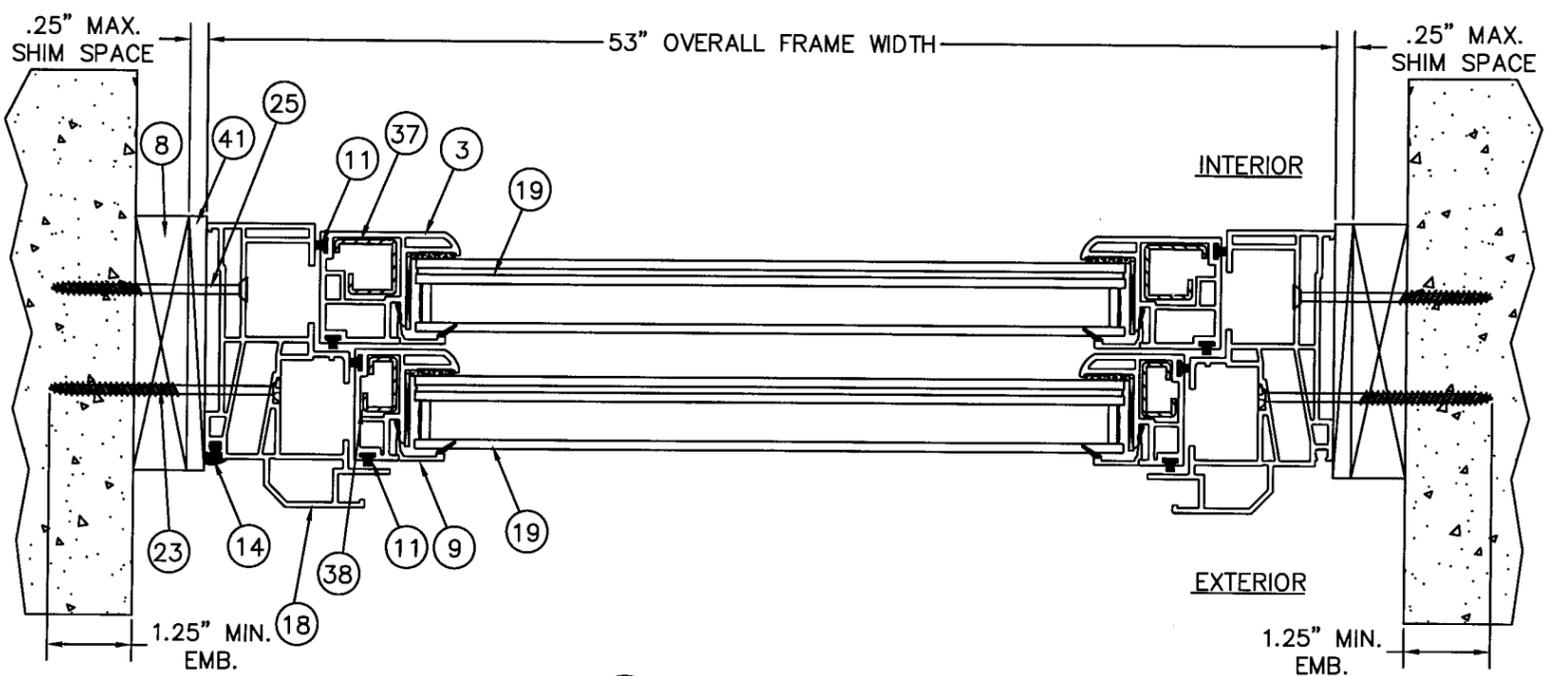

①  
③ HORIZONTAL CROSS SECTION WITH STEEL REINFORCEMENTS

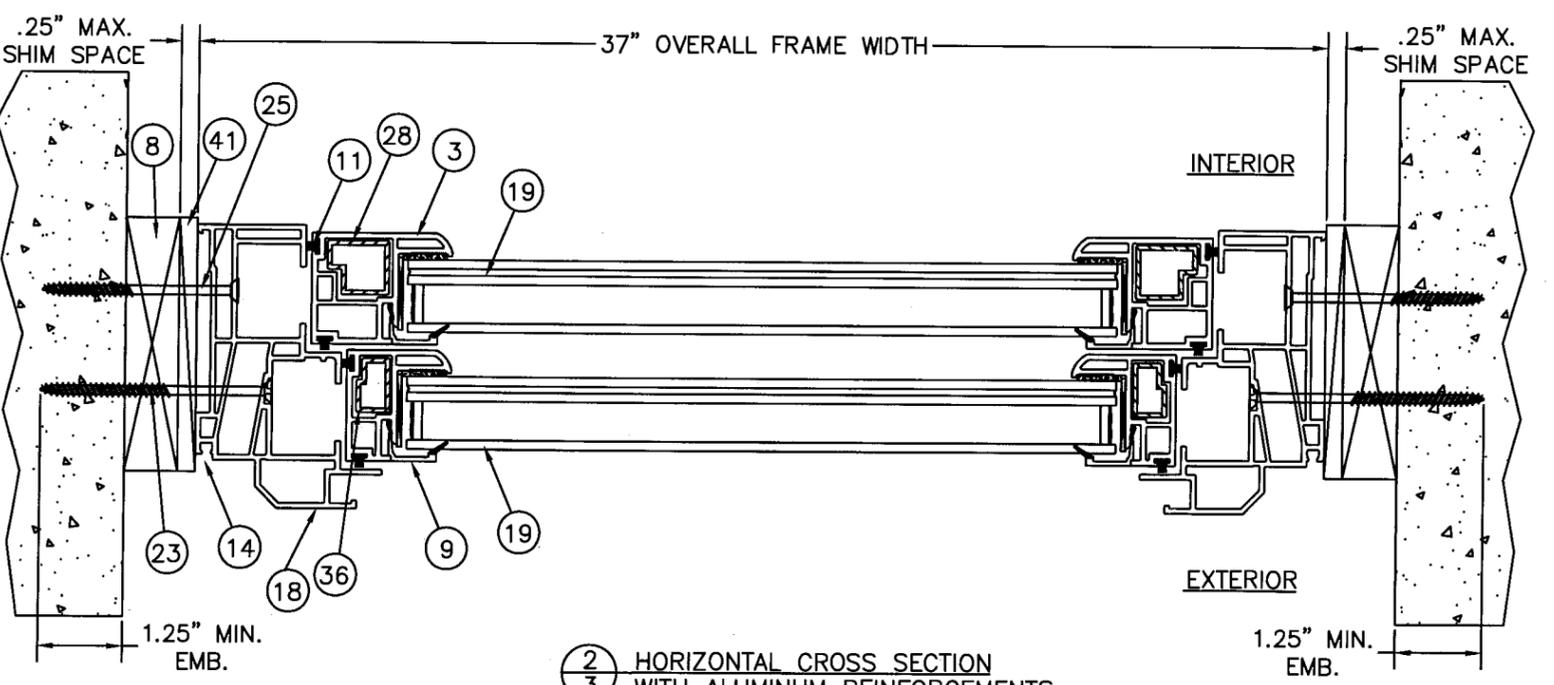


②  
③ HORIZONTAL CROSS SECTION WITH ALUMINUM REINFORCEMENTS


PRODUCT REVISED  
 as complying with the Florida  
 Building Code  
 Acceptance No. 07-0309.07  
 Expiration Date AUG. 5, 2009  
 By *Manuel Serrano*  
 Miami Dade Product Control  
 Division

 CHARLES A. PAGEN, P.E. FL. REG. ENG. # 79121 DATE: 5/11/07		SIZE: B DRAWING NUMBER: DA0003 REV: 1
		DRAWN BY: TDD DATE: 1/22/07 CHECKED BY: PR DATE: 1/26/07 APPROVED BY: CAP DATE: 1/26/07
SCALE: FIT SHEET: 5 of 8 SERIES: STORMBREAKER PLUS VINYL TITLE: DOUBLE HUNG WINDOWS NOA (IX CROSS SECTION)		

REVISIONS			
REV.	DESCRIPTION	DATE	BY
1	ADDED TAPCON TX INSTALLATION METHOD (SHEET 4 & 5)	1/22/07	GLS
2	REVISED MARKETING NAME FROM 5500 SERIES TO 300VL (SHEET 1)	3/26/07	GLS
3	ADDED SYMBOLS & NOTES (SHEET 1, 6 & 7)	5/1/07	GLS

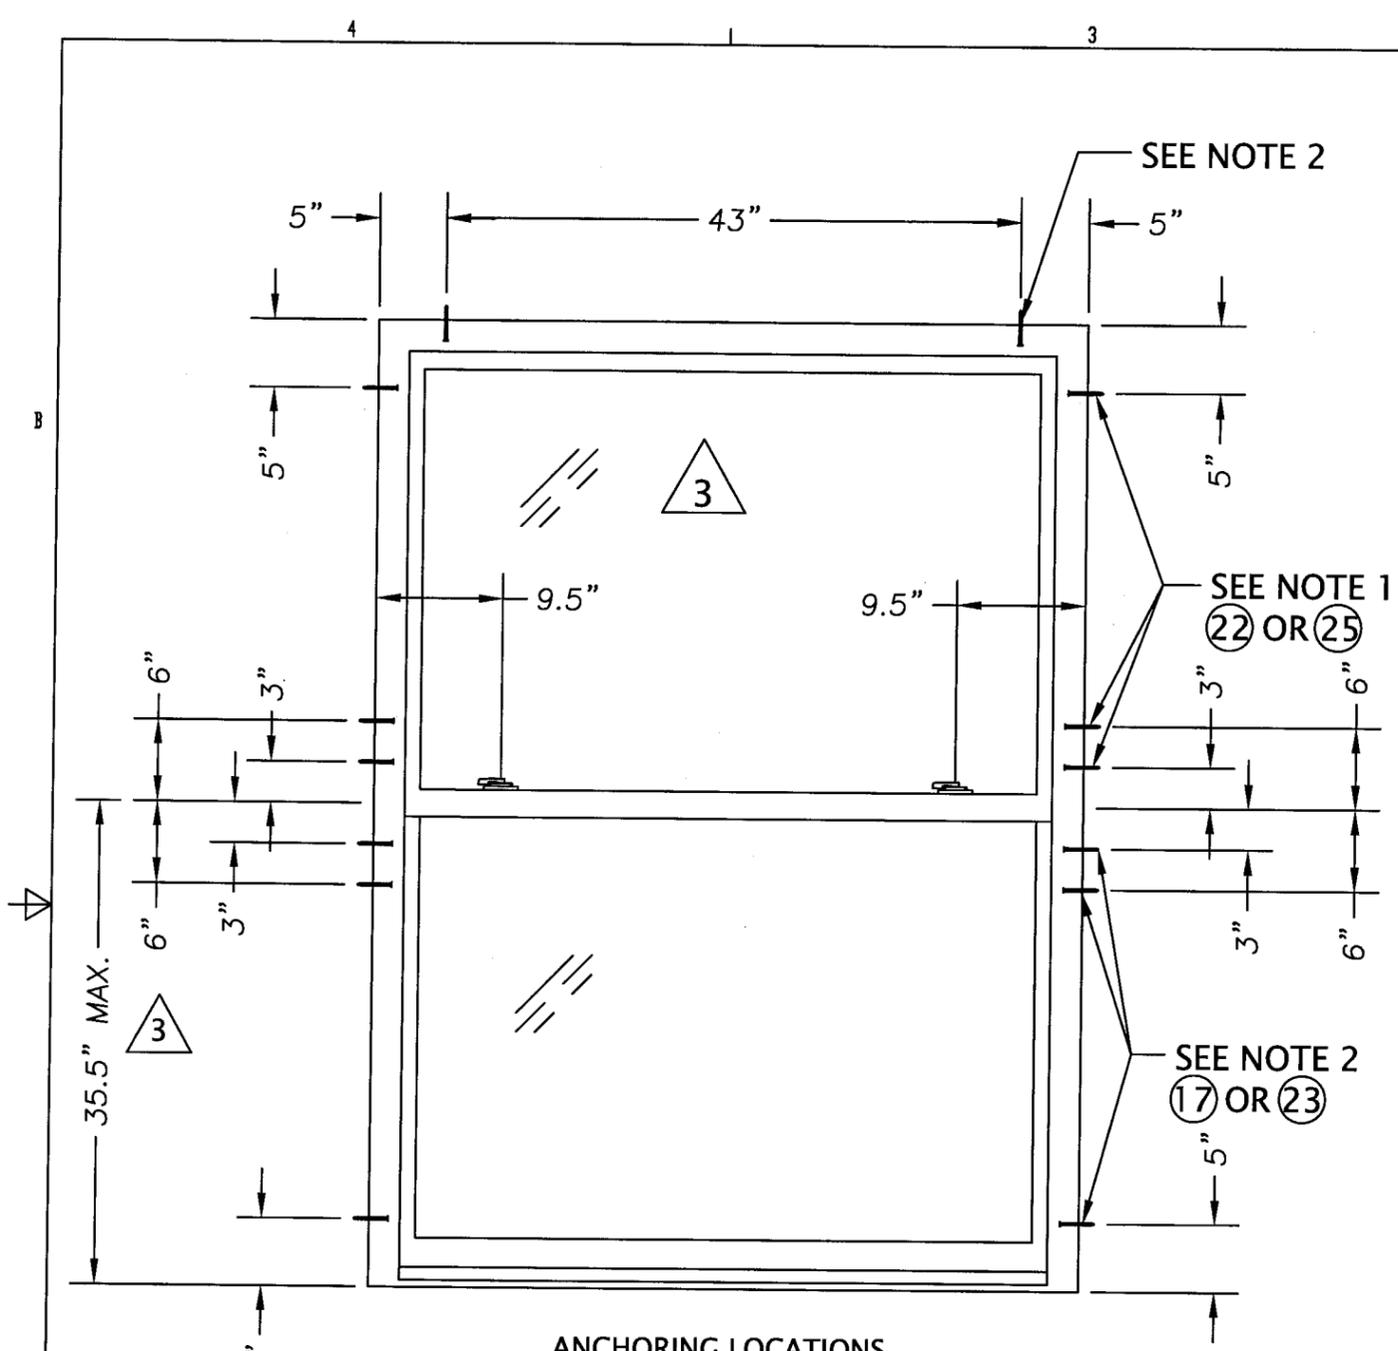

ANCHORING LOCATIONS  
SINGLE WINDOW  
53" X 71"

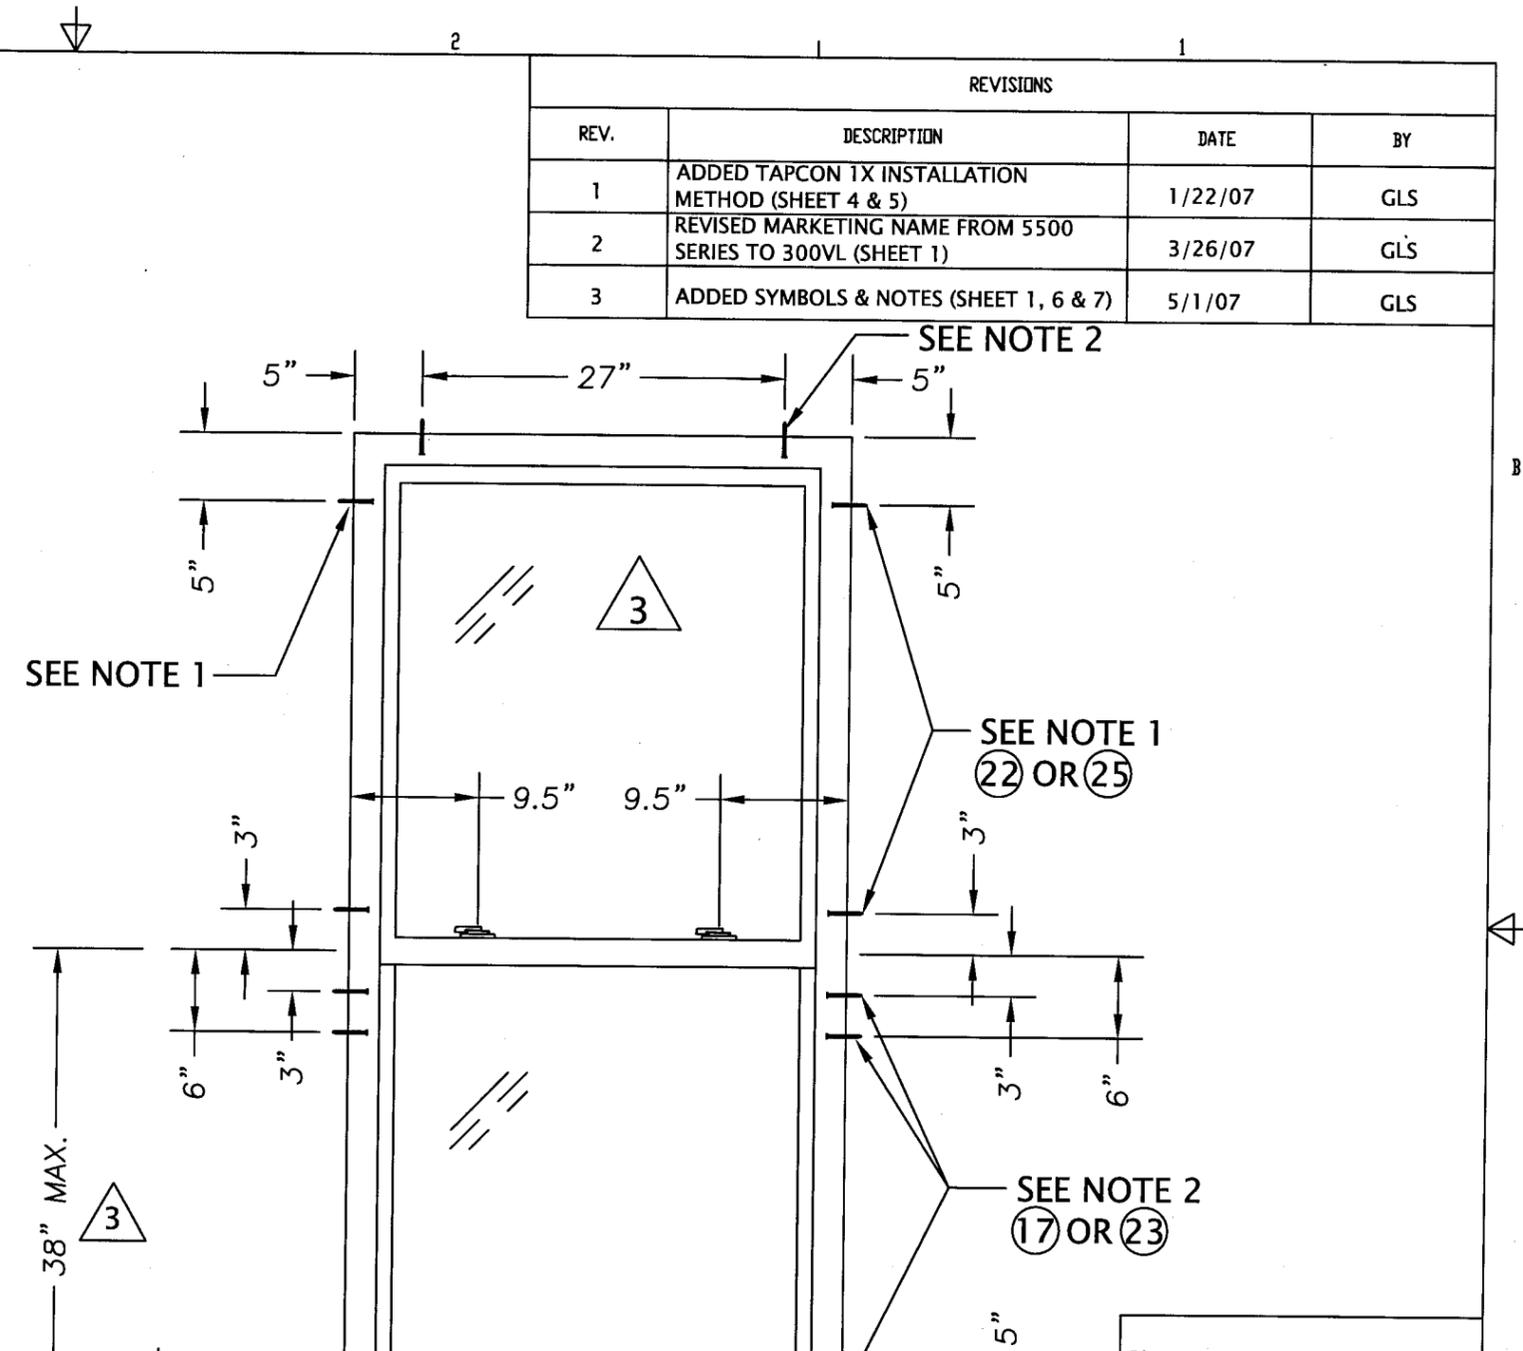

ANCHORING LOCATIONS  
SINGLE WINDOW  
37" X 76"


- NOTES:
- FASTENERS ARE LOCATED IN INTERIOR TRACK.
  - FASTENERS ARE LOCATED IN EXTERIOR TRACK.
  - USE ONLY DADE COUNTY APPROVED FASTENERS AND SHIMS.
  - THE WOOD SCREW, TAPCON & SHEET METAL SCREW FASTENERS ARE ALL LOCATED AT THE SAME WINDOW LOCATIONS. THE SAME NUMBER OF FASTENERS ARE USED FOR A GIVEN WINDOW IN WOOD OR CONCRETE STRUCTURE.

PRODUCT REVISED  
as complying with the Florida  
Building Code  
Acceptance No. 07-0309.07  
Expiration Date AUG. 5, 2009  
By *Manuel Perez*  
Miami Made Product Control  
Division


 CHARLES A. PAGEN, P.E. FL. REG. ENG. # 49721 DATE: 5/11/07		 <b>SIMONTON</b> WINDOWS	SIZE: B DRAWING NUMBER: DA0003 DRAWN BY: GLS CHECKED BY: PR APPROVED BY: CAP DATE: 1/22/07 DATE: 1/26/07 DATE: 1/26/07
SCALE: FIT SHEET: 6 of 8 SERIES: STORMBREAKER PLUS VINYL TITLE: DOUBLE HUNG WINDOW NOA(ANCHORING LOCATIONS)			

BILL OF MATERIALS		
ITEM	DESCRIPTION	MATERIAL
1	COMMON RAIL	VINYL-SIMEX, INC.
2	LIFT RAIL	VINYL-SIMEX, INC.
3	EQUAL GLASS STILE	VINYL-SIMEX, INC.
4	LIFT RAIL	VINYL-SIMEX, INC.
5	HEAD INSERT	-
6	KEEPER STILE	VINYL-SIMEX, INC.
7	2 X 4 INNER WOOD BUCK	WOOD
8	1 X 4 INNER WOOD BUCK	WOOD
9	1" GLAZING BEAD	-
10	FOAM TITE C-FOLD BY AMESBURY GROUP	FOAM
11	FIN WEATHERSTRIPPING (.250)	FOAM
12	FOAM BULB (TOP RAIL) BY AMESBURY GROUP	FOAM
13	SCREEN TRACK INSERT	-
14	SILICONE CAULK	SILICONE
15	GLAZING COMPOUND (NATIONAL STARCH 939A)	-
16	SILL	VINYL-SIMEX, INC.
17	#10 X 3" SHEET METAL SCREW	STEEL
18	FIN WEATHERSTRIPPING (.210)	-
19	1" INSULATED IMPACT RESISTANT GLASS (SEE GLAZING DETAILS SHEET 2 AND SHEET 3)	GLASS
20	KEEPER LOCK SET 30219 BY TRUTH	-
21	LOCK RAIL	VINYL-SIMEX, INC.
22	#10 X 2 3/8" SHEET METAL SCREW	STEEL
23	1/4" DIA X 3 3/4" TAPCON ANCHOR	STEEL
24	EXTRUDED VINYL DOUBLE HUNG HEAD/JAMB	VINYL-SIMEX, INC.
25	1/4" DIA X 3 1/4" TAPCON ANCHOR	STEEL
26	SCREEN	-
27	REINFORCEMENT 16107	ALUMINUM
28	REINFORCEMENT 56109	ALUMINUM
29	REINFORCEMENT 60911	ALUMINUM
30	REINFORCEMENT 56110	ALUMINUM
31	FIN WEATHERSTRIPPING (.340)	FOAM
32	FOAM TITE BULB (BOTTOM RAIL SILL) BY AMESBURY	FOAM
33	FOAM TITE FRAME .180 HEAD INSERT BY AMESBURY	FOAM
34	TILT LATCH 76825 BY ASHLAND	-
35	OFFSET PIVOT BAR 12985 BY ASHLAND	-
36	REINFORCEMENT 56111	ALUMINUM
37	REINFORCEMENT DH78/79	STEEL
38	REINFORCEMENT DH75	STEEL
39	REINFORCEMENT ST-439	STEEL
40	REINFORCEMENT DH76	STEEL
41	SHIM	WOOD


REVISIONS			
REV.	DESCRIPTION	DATE	BY
1	ADDED TAPCON 1X INSTALLATION METHOD (SHEET 4 & 5)	1/22/07	GLS
2	REVISED MARKETING NAME FROM 5500 SERIES TO 300VL (SHEET 1)	3/26/07	GLS
3	ADDED SYMBOLS & NOTES (SHEET 1, 6 & 7)	5/1/07	GLS

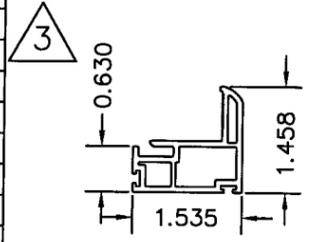


① COMMON SASH P/N DH75

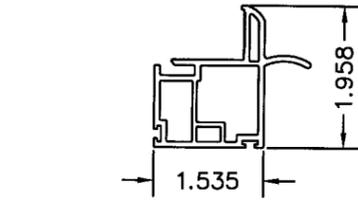


② EQUAL GLASS LIFT RAIL P/N DH79

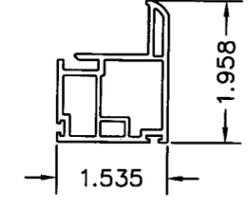


③ EQUAL GLASS STILE P/N DH78

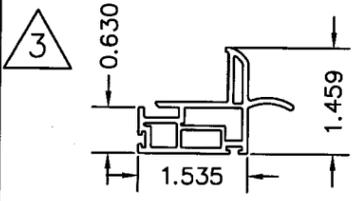

④ LIFT RAIL P/N DH76

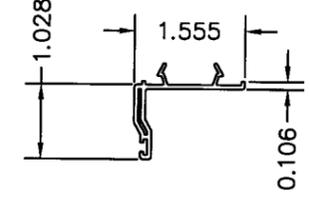


⑤ HEAD INSERT P/N VPI-421

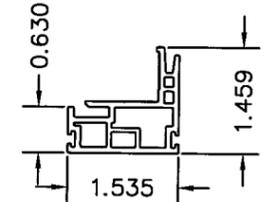


⑥ KEEPER RAIL P/N DH74


③

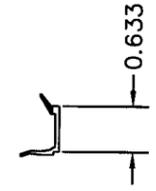


⑨ 1" GLAZING BEAD P/N B18

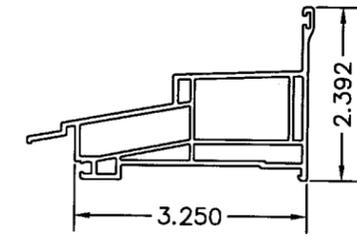

⑬ SILL P/N DH73

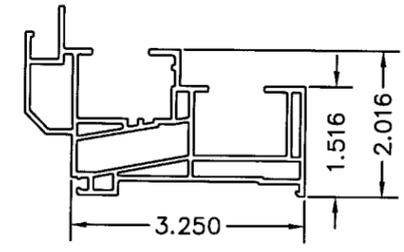

⑭ DOUBLE HUNG JAMB/HEAD P/N DH71

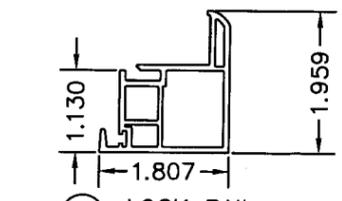


⑰ LOCK RAIL P/N DH77

PRODUCT REVISED as complying with the Florida Building Code  
 Acceptance No. 07-0309.07  
 Expiration Date AUG. 5, 2009  
 By *Manuel Perez*  
 Miami Dade Product Control Division


 CHARLES A. PAGEN, P.E. FL. REG. ENG. # 79121 DATE: 5/11/07		SIZE: B DRAWING NUMBER: DA0003 REV: 1
		DRAWN BY: GLS DATE: 1/22/07 CHECKED BY: PR DATE: 1/26/07 APPROVED BY: CAP DATE: 1/26/07
SCALE: FIT SHEET: 7 of 8 SERIES: STORMBREAKER PLUS VINYL TITLE: DOUBLE HUNG WINDOWS NOA (COMPONENTS)		

REVISIONS			
REV.	DESCRIPTION	DATE	BY
1	ADDED TAPCON 1X INSTALLATION METHOD (SHEET 4 & 5)	1/22/07	GLS
2	REVISED MARKETING NAME FROM 5500 SERIES TO 300VL (SHEET 1)	3/26/07	GLS
3	ADDED SYMBOLS & NOTES (SHEET 1, 6 & 7)	5/1/07	GLS


10 FOAM TITE C-FOLD  
BOTTOM RAIL  
WEATHERSTRIPPING

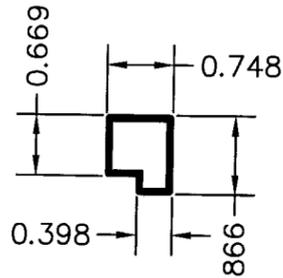


11 .250" FIN  
WEATHERSTRIPPING  
18 .210" FIN  
WEATHERSTRIPPING  
31 .340" FIN  
WEATHERSTRIPPING

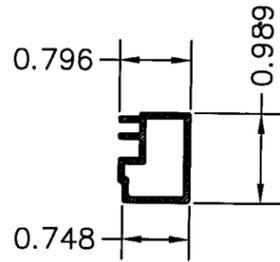


12 FOAM TITE TOP RAIL  
BULB  
WEATHERSTRIPPING

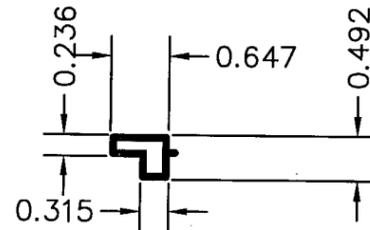


13 SCREEN TRACK  
INSERT

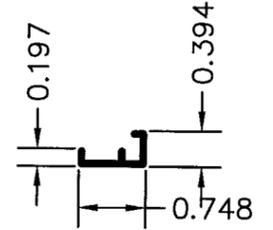


28 REINFORCEMENT 56109  
P/N DH79A  
ALUMINUM 6063-T5  
.062" WALL

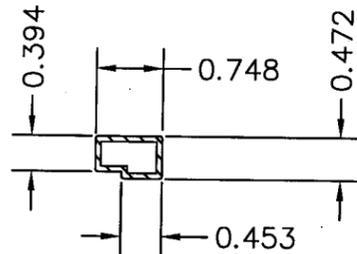


29 REINFORCEMENT 60911  
ALUMINUM 6063-T5  
.062" WALL

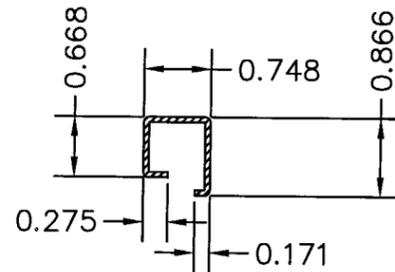

30 REINFORCEMENT 56110  
P/N DH74A  
ALUMINUM 6063-T5  
.062" WALL

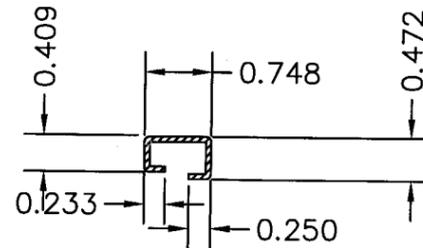

32 FOAM TITE BOTTOM  
RAIL  
SILL BULB

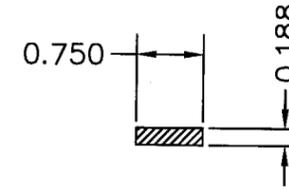


27 REINFORCEMENT 16107  
P/N DH76A  
ALUMINUM 6063-T5  
.062" WALL



33 FOAM TITE FRAME .180  
HEAD INSERT

36 REINFORCEMENT 56111  
P/N DH75A  
ALUMINUM 6063-T5  
.062" WALL

37 REINFORCEMENT DH78/79  
16 GA H.D. GALV G-90

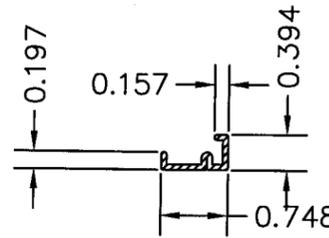

38 REINFORCEMENT DH75  
16 GA H.D. GALV G-90

39 REINFORCEMENT ST-439  
16 GA H.D. GALV G-90

40 REINFORCEMENT DH76  
16 GA H.D. GALV G-90

PRODUCT REVISED  
as complying with the Florida  
Building Code  
Acceptance No. 07-0309.07  
Expiration Date AUG. 5, 2009  
By *Manuel Lopez*  
Miami Dade Product Control  
Division

 CHARLES A. PAGEN, P.E. FL. REG. ENG. # 49121 DATE: 5/11/07		SIZE: B DRAWING NUMBER: DA0003 REV: 1
		DRAWN BY: GLS DATE: 1/22/07 CHECKED BY: PR DATE: 1/26/07 APPROVED BY: CAP DATE: 1/26/07
SCALE: FIT SHEET: 8 of 8 SERIES: STORMBREAKER PLUS VINYL TITLE: DOUBLE HUNG WINDOWS NOA (COMPONENTS)		