



**BUILDING CODE COMPLIANCE OFFICE (BCCO)
PRODUCT CONTROL DIVISION**

**MIAMI-DADE COUNTY, FLORIDA
METRO-DADE FLAGLER BUILDING
140 WEST FLAGLER STREET, SUITE 1603
MIAMI, FLORIDA 33130-1563
(305) 375-2901 FAX (305) 375-2908**

NOTICE OF ACCEPTANCE (NOA)

www.miamidade.gov/buildingcode

**Nan Ya Plastics Corporation USA
8989 North Loop East, Suite 800
Houston, TX 77029**

SCOPE:

This NOA is being issued under the applicable rules and regulations governing the use of construction materials. The documentation submitted has been reviewed by Miami-Dade County Product Control Division and accepted by the Board of Rules and Appeals (BORA) to be used in Miami Dade County and other areas where allowed by the Authority Having Jurisdiction (AHJ).

This NOA shall not be valid after the expiration date stated below. The Miami-Dade County Product Control Division (In Miami Dade County) and/or the AHJ (in areas other than Miami Dade County) reserve the right to have this product or material tested for quality assurance purposes. If this product or material fails to perform in the accepted manner, the manufacturer will incur the expense of such testing and the AHJ may immediately revoke, modify, or suspend the use of such product or material within their jurisdiction. BORA reserves the right to revoke this acceptance, if it is determined by Miami-Dade County Product Control Division that this product or material fails to meet the requirements of the applicable building code.

This product is approved as described herein, and has been designed to comply with the Florida Building Code, including the High Velocity Hurricane Zone.

DESCRIPTION: Nan Ya Series Fiberglass Outswing Opaque Doors – N.I.

APPROVAL DOCUMENT: Drawing No. **NAN0012**, titled "Opaque Double Entry Non-Impact Outswing", sheets 1 through 5 of 5, dated 04/21/08 and lat revised on 01-27-09, prepared by PTC, LLC, signed and sealed by Paul E. winter, P.E., bearing the Miami-Dade County Product Control Approval stamp with the Notice of Acceptance number and approval date by the Miami-Dade County Product Control Division.

MISSILE IMPACT RATING: None: Approved Hurricane protection Devices, complying w/ FBC, as applicable are required.

LABELING: Each unit shall bear a permanent label with the manufacturer's name or logo, city, state and following statement: "Miami-Dade County Product Control Approved", unless otherwise noted herein.

RENEWAL of this NOA shall be considered after a renewal application has been filed and there has been no change in the applicable building code negatively affecting the performance of this product.

TERMINATION of this NOA will occur after the expiration date or if there has been a revision or change in the materials, use, and/or manufacture of the product or process. Misuse of this NOA as an endorsement of any product, for sales, advertising or any other purposes shall automatically terminate this NOA. Failure to comply with any section of this NOA shall be cause for termination and removal of NOA.

ADVERTISEMENT: The NOA number preceded by the words Miami-Dade County, Florida, and followed by the expiration date may be displayed in advertising literature. If any portion of the NOA is displayed, then it shall be done in its entirety.

INSPECTION: A copy of this entire NOA shall be provided to the user by the manufacturer or its distributors and shall be available for inspection at the job site at the request of the Building Official. This NOA consists of this page 1 and evidence page E-1 and E-2, as well as approval document mentioned above.

The submitted documentation was reviewed by **Ishaq I. Chanda, P.E.**



2/12/19

**NOA No 08-0425.13
Expiration Date: March 04, 2014
Approval Date: March 04, 2009
Page 1**

Nan Ya Plastics Corporation USA

NOTICE OF ACCEPTANCE: EVIDENCE SUBMITTED

A. DRAWINGS

1. Manufacturer's die drawings and sections.
2. Drawing No. **NAN0012**, titled "Opaque Double Entry Non-Impact Outswing", sheets 1 through 5 of 5, dated 04/21/08 and last revised on 01-27-09, prepared by PTC, LLC, signed and sealed by Paul E. Winter, P.E.

B. TESTS

1. Test reports on 1) Air Infiltration Test, per FBC, TAS 202-94
2) Uniform Static Air Pressure Test, Loading per FBC TAS 202-94
3) Water Resistance Test, per FBC, TAS 202-94
4) Forced Entry Test, per FBC 3603.2 (b) and TAS 202-94

along with marked-up drawings and installation diagram of Fiberglass Outswing Door w/ Sidelites, prepared by ETC Laboratories, Test Report No. **ETC-06-255-174121.3**, dated 12/18/08, signed and sealed by Joseph L. Doldan, P.E.

Note: This test report has been revised by an addendum issued by ETC Lab on 01/23/09, signed & sealed by Joseph L. Doldan, P.E.

C. CALCULATIONS

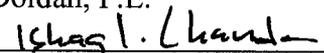
1. Anchor verification calculations and structural analysis, prepared by PTC Engineering, Inc., dated 4/21/08, signed and sealed by Douglas J. McDougall, P.E.
2. Successor Engineer's letter dated 01/15/09, prepared, signed and sealed by Paul E. Winter, P.E.

D. QUALITY ASSURANCE

1. Miami Dade Building Code Compliance Office (BCCO).

E. MATERIAL CERTIFICATIONS

1. Test report No.ETC-05-255-16776.1, prepared by ETC Laboratories, dated 07/06/06, issued to Nan Ya Plastics Corp., for their SMC Fiberglass material / ETC05033 per ASTM D638-03 "4500 exposed Xenon Arch" & tensile strength ASTM D638-03 "Tensile strength", Smoke density per ASTM D2843-99, Rate of burning per ASTM D635-98 and "Self ignition" per ASTM D1929-01, all signed and sealed by Joseph Labora Doldan, P.E.
2. Test report No.ETC-05-255-17144.0, prepared by ETC Laboratories, dated 07/03/08, issued to Nan Ya Plastics Corp., for their Rigid PVC plastic(part #ETC06024) per ASTM D1929-96 "Standard Test Method for Ignition Properties of Plastics", ASTM D2843-99 "Standard Test Method for Density of Smoke from the Burning or Decomposition of Plastics", ASTM D635-98 "Standard Test Method for Rate of Burning and/or Extent and Time of Burning of Self-Supporting Plastics in a Horizontal Position" and ASTM D638-03 "Standard Test Methods for Tensile Properties of Plastics" for exposed & unexposed sample per Xenon Arch after 4500 Hours, signed and sealed by Joseph Labora Doldan, P.E.
3. Test report No.ETC-06-255-17412.0, prepared by ETC Laboratories, dated 04/25/06, issued to Nan Ya Plastics Corp., for their Phenolic Foam Board / ETC06013 plastic per ASTM E84-05 "Standard Test Method for Surface Burning Characteristics of Building Materials", signed and sealed by Joseph Labora Doldan, P.E.



Ishaq I. Chanda, P.E.

Product Control Examiner

NOA No 08-0425.13

Expiration Date: March 04, 2013

Approval Date: March 04, 2009

Nan Ya Plastics Corporation USA

NOTICE OF ACCEPTANCE: EVIDENCE SUBMITTED

E. MATERIAL CERTIFICATIONS (continue)

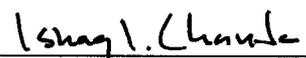
4. Test report No.ETC-05-255-17412.1, prepared by ETC Laboratories, dated 04/25/06, re-issued on 06/28/06 to Nan Ya Plastics Corp., for their Phenolic Foam Board / ETC06013 plastic per ASTM E84-05 "*Standard Test Method for Surface Burning Characteristics of Building Materials*", signed and sealed by Joseph L. Doldan, P.E.
5. Test report No.ETC-05-255-17900.0, prepared by ETC Laboratories, dated 06/28/06, issued to Nan Ya Plastics Corp., for their Phenolic Foam Board / ETC06013 plastic per ASTM D1929-96 "*Standard Test Method for Ignition Properties of Plastics*", signed and sealed by Joseph L. Doldan, P.E.
6. Test report No.ETC-05-255-16776.0, prepared by ETC Laboratories, dated 01/04/06, issued to Nan Ya Plastics Corp., for their SMC / ETC05033 plastic per ASTM D1929-96 "*Standard Test Method for Ignition Properties of Plastics*", ASTM D2843-99 "*Standard Test Method for Density of Smoke from the Burning or Decomposition of Plastics*", ASTM D635-98 "*Standard Test Method for Rate of Burning and/or Extent and Time of Burning of Self-Supporting Plastics in a Horizontal Position*" and ASTM D638-03 "*Standard Test Methods for Tensile Properties of Plastics*", signed and sealed by Joseph Labora Doldan, P.E.
7. Test report No.ETC-05-255-16777.1, prepared by ETC Laboratories, dated 07/26/06, issued to Nan Ya Plastics Corp., for their Cellular PVC / ETC05034 plastic per ASTM D1929-96 "*Standard Test Method for Ignition Properties of Plastics*", ASTM D2843-99 "*Standard Test Method for Density of Smoke from the Burning or Decomposition of Plastics*", ASTM D635-98 "*Standard Test Method for Rate of Burning and/or Extent and Time of Burning of Self-Supporting Plastics in a Horizontal Position*" and ASTM D638-03 "*Standard Test Methods for Tensile Properties of Plastics*", signed and sealed by Joseph Labora Doldan, P.E.

F. STATEMENTS

1. Statement letter dated 01/15/2009 being successor Engineer, prepared, signed and sealed by Paul E. Winter, P.E.
2. Statement letter of conformance and no financial interest, issued by PTC, dated April 21, 2008, signed and sealed by Douglas J. McDougall, P.E.
3. Lab compliance letter as part of above test reports.

G. OTHER

1. Test proposal # **06-1291** dated 11/06/2006 approved by BCCO.



Ishaq I. Chanda, P.E.

Product Control Examiner

NOA No 08-0425.13

Expiration Date: March 04, 2014

Approval Date: March 04, 2009

NAN YA PLASTICS CORP.

OPAQUE DOUBLE ENTRY NON-IMPACT OUTSWING DOOR

GENERAL NOTES:

1. THE PRODUCT ANCHORAGE SHOWN HEREIN IS DESIGNED TO COMPLY WITH THE FLORIDA BUILDING CODE (FBC), AT THE DESIGN PRESSURES STATED HEREIN.
2. THE PRODUCT DETAILS CONTAINED HEREIN ARE BASED UPON SIGNED AND SEALED TEST REPORT #ETC-07-255-18448.3 REISSUE DATED 10/01/07, AND ASSOCIATED LABORATORY STAMPED DRAWINGS. 
3. THE PRODUCT HAS BEEN EVALUATED FOR CONFORMANCE TO THE STANDARDS LISTED IN THE FLORIDA BUILDING CODE (FBC) AND IS IN COMPLIANCE WITH SAID STANDARDS, INCLUDING HIGH VELOCITY HURRICANE ZONE (HVHZ) REQUIREMENTS.
4. ADEQUACY OF THE EXISTING STRUCTURAL CONCRETE / MASONRY AND WOOD FRAMING AS A MAIN WIND FORCE RESISTING SYSTEM CAPABLE OF WITHSTANDING AND TRANSFERRING APPLIED PRODUCT LOADS TO THE FOUNDATION IS THE RESPONSIBILITY OF THE PROJECT ENGINEER OR ARCHITECT OF RECORD.
5. 1X AND 2X BUCKS (WHEN USED) SHALL BE DESIGNED AND ANCHORED TO PROPERLY TRANSFER ALL LOADS TO THE STRUCTURE. BUCK DESIGN AND INSTALLATION IS THE RESPONSIBILITY OF THE PROJECT ENGINEER OR ARCHITECT OF RECORD.
6. THE INSTALLATION DETAILS DESCRIBED HEREIN ARE GENERIC AND MAY NOT REFLECT ACTUAL CONDITIONS FOR A SPECIFIC SITE. IF SITE CONDITIONS CAUSE INSTALLATION TO DEVIATE FROM THE REQUIREMENTS DETAILED HEREIN, THEN THE BUILDING OFFICIAL MAY ELECT ONE OF THE FOLLOWING OPTIONS:
 - A. OUTSIDE HVHZ: REQUIRE THAT A LICENSED ENGINEER OR ARCHITECT PREPARE AND SUBMIT SITE SPECIFIC DOCUMENTS FOR USE WITH THIS DOCUMENT, TO BE REVIEWED BY AUTHORITY HAVING JURISDICTION. 
 - B. INSIDE HVHZ: REQUIRE THAT A ONE-TIME SITE SPECIFIC APPROVAL BE APPLIED FOR AND OBTAINED FROM THE MIAMI-DADE COUNTY PRODUCT CONTROL DIVISION.

7. IN HVHZ AREAS, USE OF AN APPROVED IMPACT PROTECTIVE SYSTEM COMPLYING WITH THE HVHZ REQUIREMENTS OF THE FBC IS MANDATORY FOR THE PRODUCT HEREIN. OUTSIDE HVHZ AREAS, USE OF AN APPROVED IMPACT PROTECTIVE SYSTEM COMPLYING WITH THE FBC IS MANDATORY. 
8. DOOR FRAME AND PANEL FRAME MATERIAL: FOAM PVC DOOR PANEL SKIN IS MOULDED FIBERGLASS SKIN
9. A 1/3 INCREASE IN ALLOWABLE STRESS FOR WIND LOADS WAS NOT USED IN THE DESIGN OF THE PRODUCT(S) SHOWN HEREIN.

INSTALLATION NOTES:

1. ONE (1) INSTALLATION ANCHOR IS REQUIRED AT EACH ANCHOR LOCATION SHOWN.
2. THE NUMBER OF INSTALLATION ANCHORS DEPICTED IS THE MINIMUM NUMBER OF ANCHORS TO BE USED FOR PRODUCT INSTALLATION.
3. SHIM AS REQUIRED AT EACH INSTALLATION ANCHOR WITH LOAD BEARING SHIM. MAXIMUM ALLOWABLE SHIM SIZE OF 1/4 INCH. SHIM WHERE SPACE OF 1/16 INCH OR GREATER OCCURS. SHIM SHALL BE CONSTRUCTED OF HIGH DENSITY PLASTIC OR BETTER (LOAD BEARING). 
4. FOR INSTALLATION INTO WOOD FRAMING, USE #12 WOOD SCREWS OF SUFFICIENT LENGTH TO ACHIEVE 1 1/2 INCH MINIMUM EMBEDMENT.
5. FOR INSTALLATION THROUGH 1X BUCK TO CONCRETE / MASONRY, OR DIRECTLY INTO CONCRETE / MASONRY, USE 1/4 INCH ITW TAPCONS OF SUFFICIENT LENGTH TO ACHIEVE 1 1/4 INCH MINIMUM EMBEDMENT.
6. MINIMUM EMBEDMENT AND EDGE DISTANCE EXCLUDE WALL FINISHES (INCLUDING BUT NOT LIMITED TO STUCCO, FOAM, BRICK VENEER, AND SIDING).
7. INSTALLATION ANCHORS AND ASSOCIATED HARDWARE MUST BE MADE OF CORROSION RESISTANT MATERIAL OR HAVE A CORROSION RESISTANT COATING.
8. FOR CONCRETE BLOCK, DO NOT INSTALL INSTALLATION ANCHORS INTO MORTAR JOINTS. EDGE DISTANCE IS MEASURED FROM FREE EDGE OF BLOCK OR EDGE OF MORTAR JOINT INTO FACE SHELL OF BLOCK.
9. INSTALLATION ANCHORS SHALL BE INSTALLED IN ACCORDANCE WITH ANCHOR MANUFACTURER'S INSTALLATION INSTRUCTIONS, AND ANCHORS SHALL NOT BE USED IN SUBSTRATES WITH STRENGTHS LESS THAN THE MINIMUM STRENGTH SPECIFIED BY THE ANCHOR MANUFACTURER BELOW.
 - A. WOOD - PT SOUTHERN YELLOW PINE, MINIMUM SPECIFIC GRAVITY OF 0.55.
 - B. CONCRETE - MINIMUM COMPRESSIVE STRENGTH OF 3192 PSI AND COMPLIES WITH ACI 301, ACI 318-05 AND ACI 355.
 - C. MASONRY - STRENGTH CONFORMANCE TO ASTM C-90 AND ACI 530-05, GRADE N, TYPE 1 (OR GREATER).
10. INSTALLATION ANCHOR CAPACITIES FOR PRODUCTS HEREIN ARE BASED ON SUBSTRATE MATERIALS WITH THE FOLLOWING PROPERTIES: 

TABLE OF CONTENTS		
SHEET	REV.	SHEET DESCRIPTION
1	A	GENERAL AND INSTALLATION NOTES
2	A	ELEVATION AND ANCHOR LAYOUT
3	A	VERTICAL SECTIONS AND CORNER DETAIL
4	A	HORIZONTAL SECTIONS
5	A	BILL OF MATERIALS AND COMPONENTS

DESIGN PRESSURE RATING (PSF)
WHERE WATER INFILTRATION IS NOT REQUIRED 
±55.0

Approved as complying with the Florida Building Code
 Date MARCH 04, 2009
 NOA# 08-0425-13
 Miami Dade Product Control Division
 By Shag L. Lhanda

DATE: 01/27/09			
APPROVED BY: Paul E. Winter			
REV	A	PER MIAMI DADE COMMENTS DATED 1-5-09	01/08/09 SMC
		DESCRIPTION	DATE
			BY

NANYA PLASTICS
 8989 NORTH LOOP EAST
 HOUSTON, TX 77029

TITLE: OPAQUE DOUBLE ENTRY NON-IMPACT OUTSWING DOOR
 GENERAL, INSTALLATION NOTES AND ELEVATION

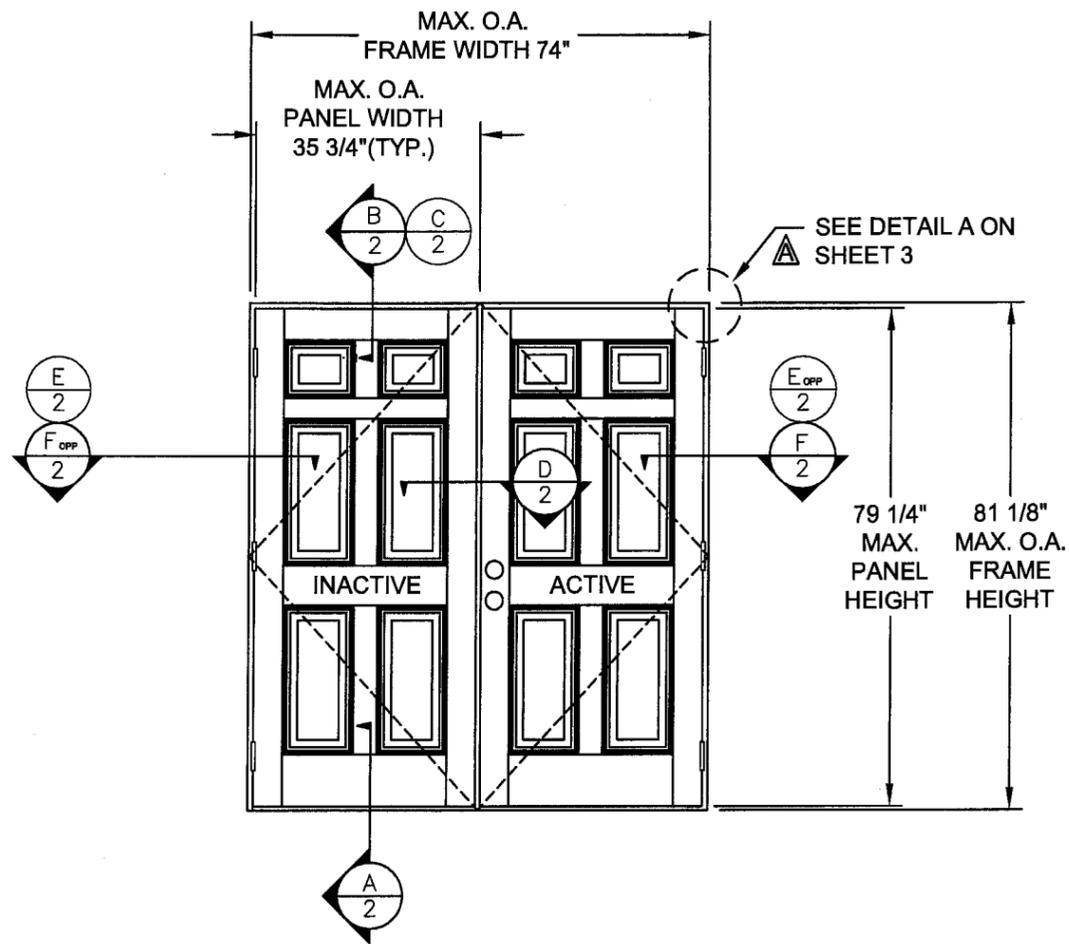
DATE: 04/21/08
 DRAWING NO: NAN0012
 SHEET: 1 OF 5

PREPARED BY: CB
 SCALE: N.T.S.
 REV: A

FPE
 P.T.C. LLC
 Phone 281.686.1788
 Fax 281.686.1788


PROJECT #307-1211.22
 Paul E. Winter
 Florida P.E. No. 79693

PTC, LLC
 1535 Cogswell Street, Suite C25
 Rockledge, Florida 32955
 FBPE Certificate of Authorization NO. 25935



ELEVATION

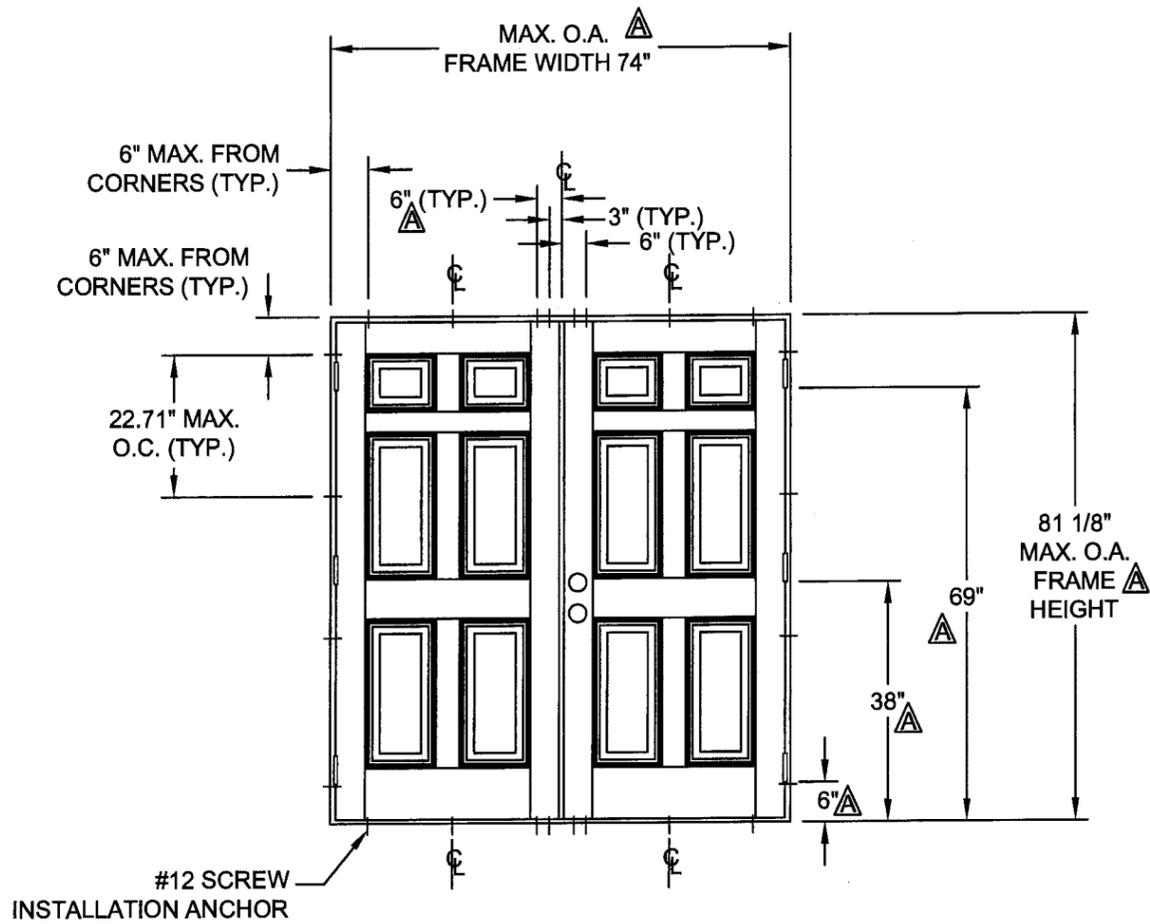EXTERIOR VIEW



ANCHOR LAYOUT

EXTERIOR VIEW

Approved as complying with the
 Florida Building Code
 Date MAY 14, 2009
 NOA# 09-0425-13
 Miami Dade Product Control
 Division
 By Shag I. Chaudhary

PROJECT #307-1211-22
 Paul E. Winter
 Florida P.E. No. 22693


 1535 Cogswell Street, Suite C25
 Rockledge, Florida 32955
 FBPE Certificate of Authorization NO. 25835

NANYA PLASTICS
 8989 NORTH LOOP EAST
 HOUSTON, TX 77029
 TITLE: OPAQUE DOUBLE ENTRY NON-IMPACT OUTSWING DOOR
 ELEVATION AND ANCHOR LAYOUT




PREPARED BY: N.T.S.
 DRAWN BY: CB
 DATE: 04/21/08
 DRAWING NO: NAN0012
 SHEET: 2 OF 5

APPROVED BY: Paul E. Winter	DATE: 01/27/09	PER MIAMI DADE COMMENTS DATED 1-5-09	01/08/09	SMC
		REV	DESCRIPTION	DATE
		A		

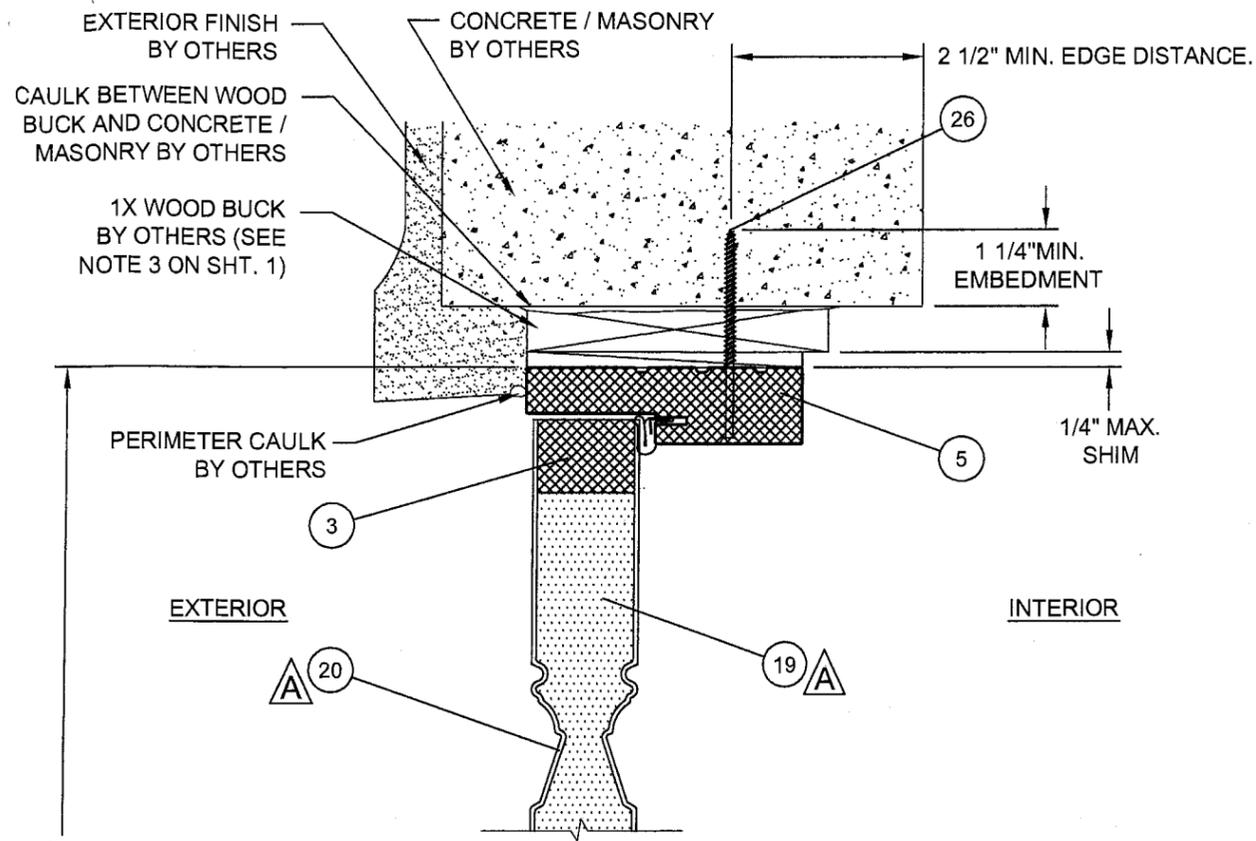


B VERTICAL SECTION
CONCRETE / MASONRY SUBSTRATE

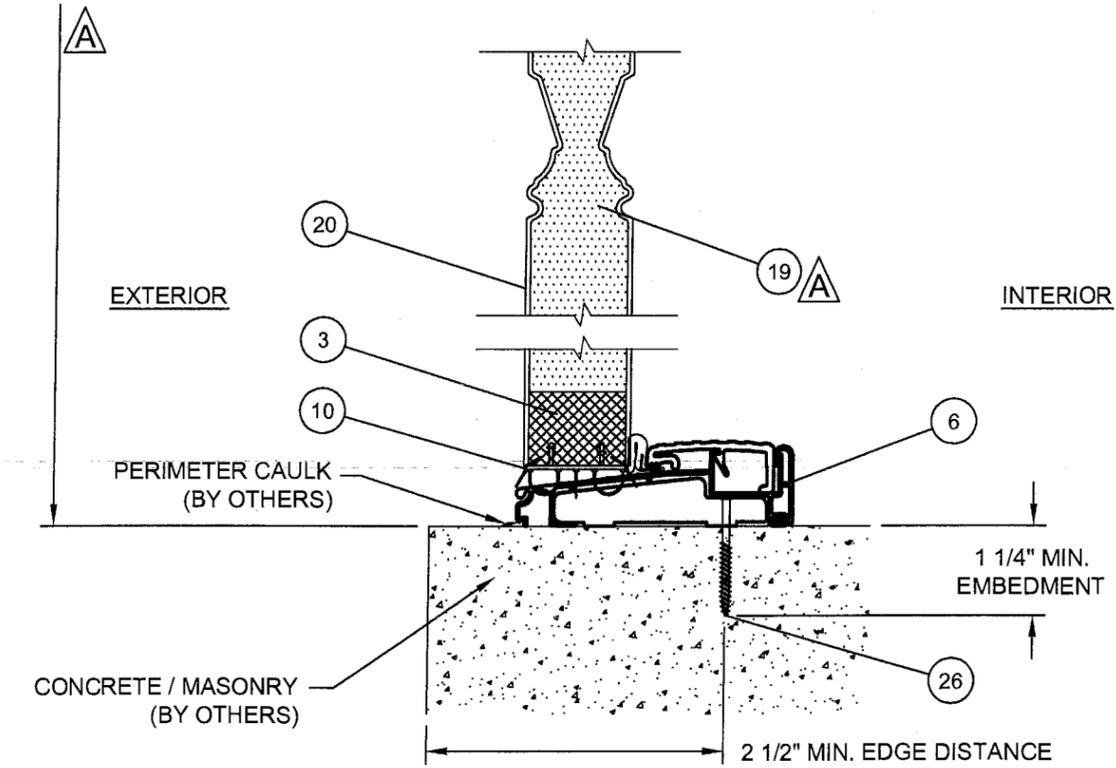
MAX. UNIT HEIGHT 81 1/8"



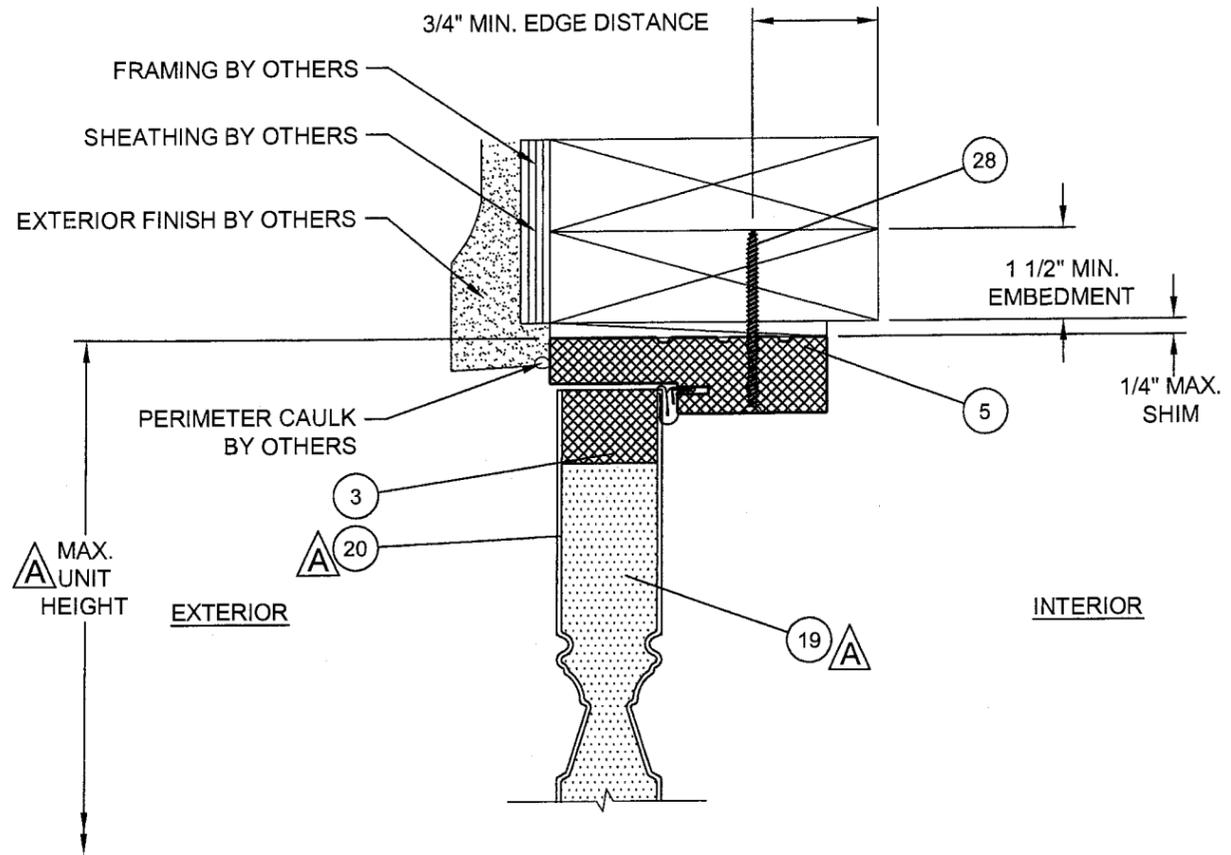
A VERTICAL SECTION
CONCRETE / MASONRY SUBSTRATE




C VERTICAL SECTION
WOOD FRAME SUBSTRATE

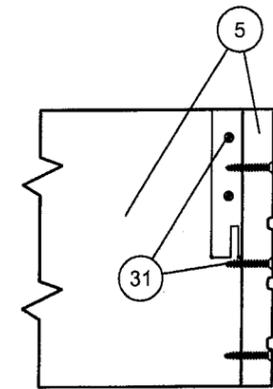

TOP VIEW

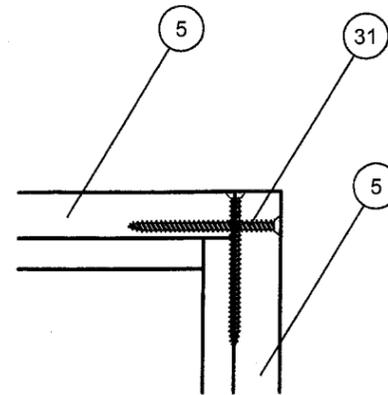

FRONT VIEW

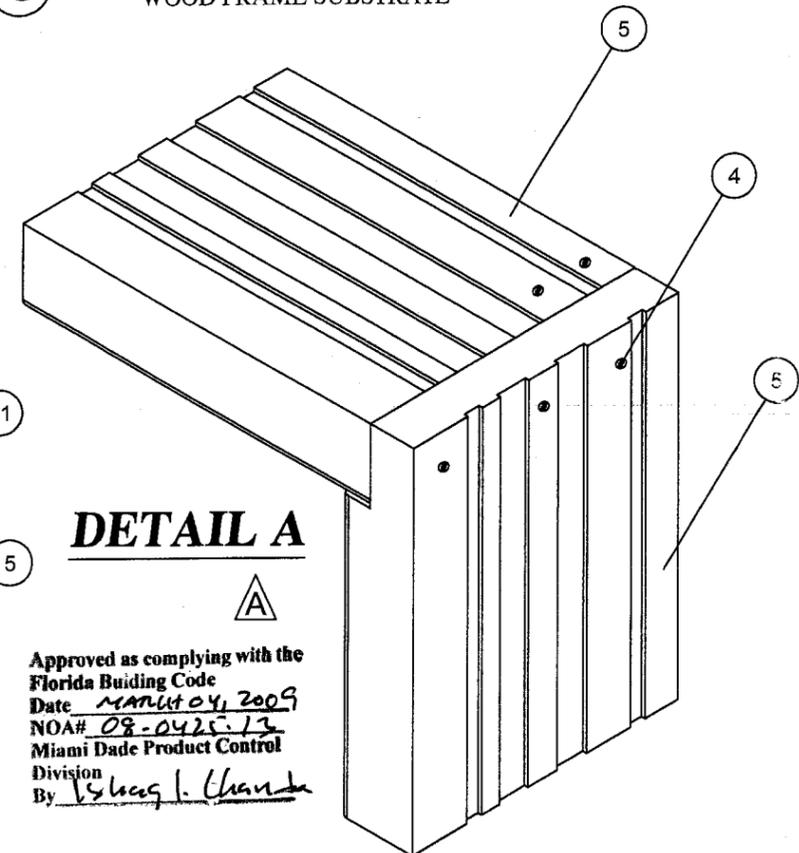


DETAIL A

Approved as complying with the
Florida Building Code
Date MAR 04, 2009
NOA# 08-0425-13
Miami Dade Product Control
Division
By Shang J. Chan

APPROVED BY: Paul E. Winter	DATE: 01/08/09	PER MIAMI DADE COMMENTS DATED 1-5-09	DATE	BY
		A		SMC

NANYA PLASTICS 8989 NORTH LOOP EAST HOUSTON, TX 77029		DATE: 04/21/08	3 OF 5
TITLE: OPAQUE DOUBLE ENTRY NON-IMPACT OUTSWINGING DOOR VERTICAL SECTIONS & CORNER DETAIL	DRAWING NO: NAN0012	SCALE: N.T.S.	SHEET:
DRAWN BY: CB	REV: A		

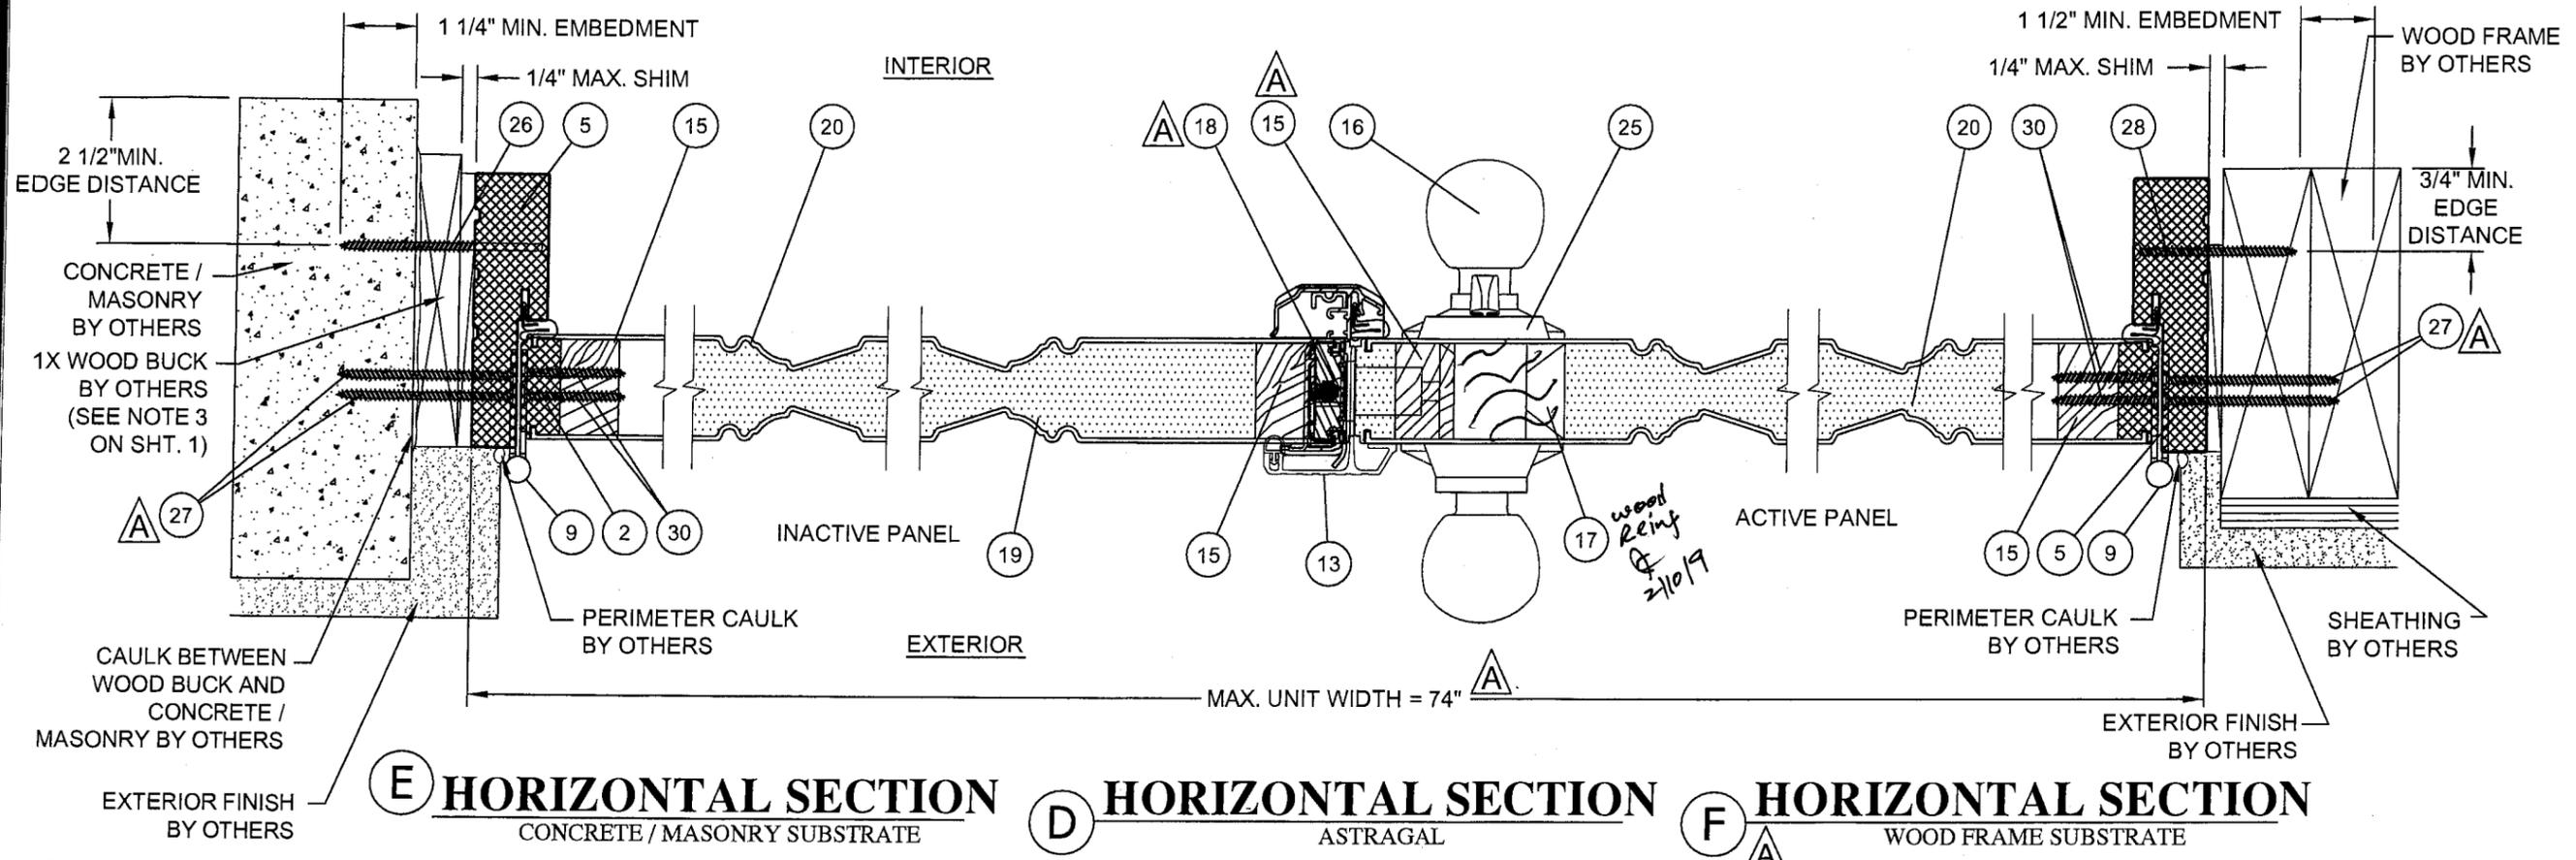PROJECT #307-1211.22
Paul E. Winter
Florida - P.E. No. 22693
04/27/09
PTC, LLC
1535 Cogswell Street, Suite C25
Rockledge, Florida 32955
FBPE Certificate of Authorization NO. 25695




E HORIZONTAL SECTION
CONCRETE / MASONRY SUBSTRATE

D HORIZONTAL SECTION
ASTRAGAL

F HORIZONTAL SECTION
WOOD FRAME SUBSTRATE

APPROVED BY: Paul E. Winter	DATE: 01/08/09	PER MIAMI DADE COMMENTS DATED 1-5-09	DESCRIPTION	DATE	BY
		A		01/08/09	SMC

















NANYA PLASTICS 8989 NORTH LOOP EAST HOUSTON, TX 77029		DRAWN BY: CB	DATE: 04/21/08
TITLE: OPAQUE DOUBLE ENTRY NON-IMPACT OUTSWING DOOR HORIZONTAL SECTIONS		SCALE: N.T.S.	DRAWING NO.: NAN0012
PREPARED BY: FPPE	REV: A	SHEET: 4 OF 5	PTC, LLC Phone 321.660.1788 Fax 321.660.1789

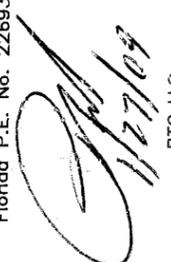Paul E. Winter
 Florida P.E. No. 22693

 PTC, LLC
 1535 Cogswell Street, Suite C25
 Rockledge, Florida 32955
 FPPE Certificate of Authorization No. 25935

Approved as complying with the
 Florida Building Code
 Date MARCH 04, 2009
 NOA# 08-0425-13
 Miami Dade Product Control
 Division
 By LS Hagl. Grants

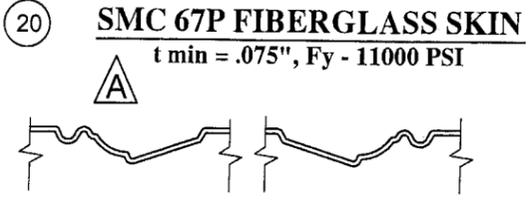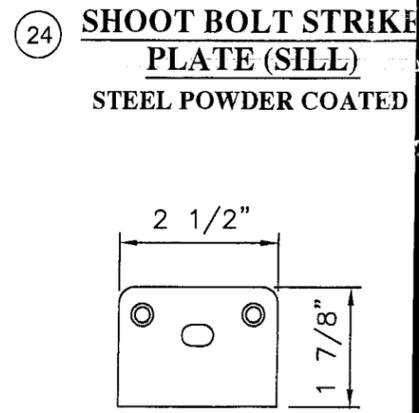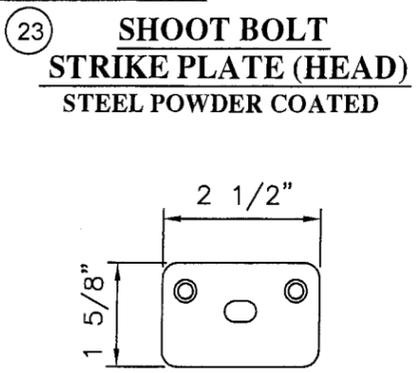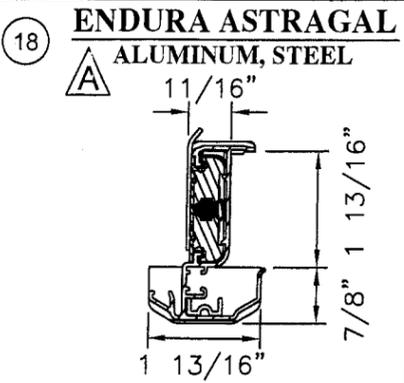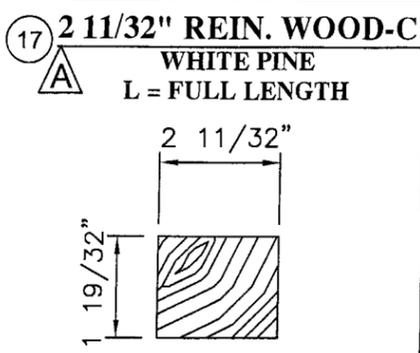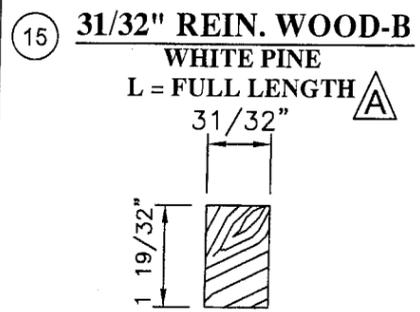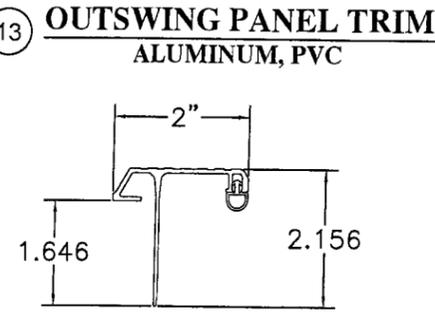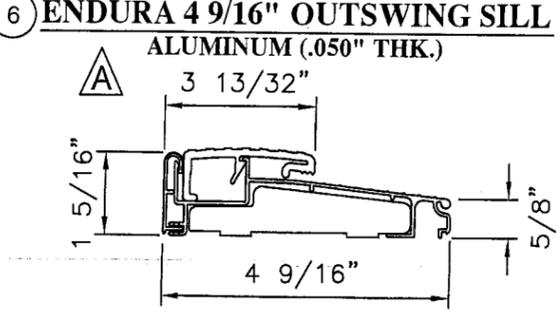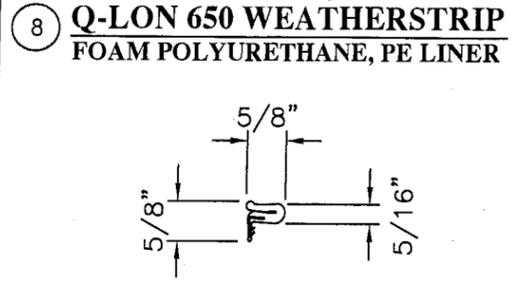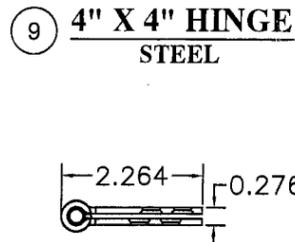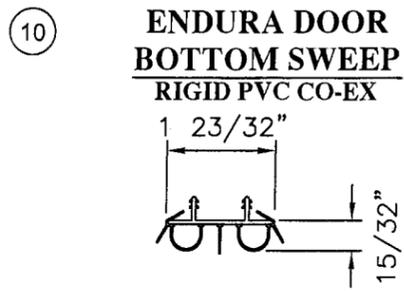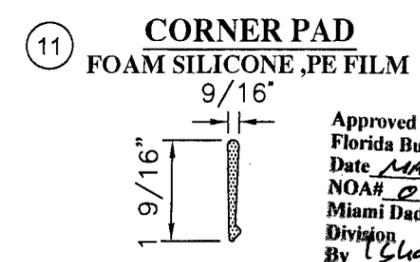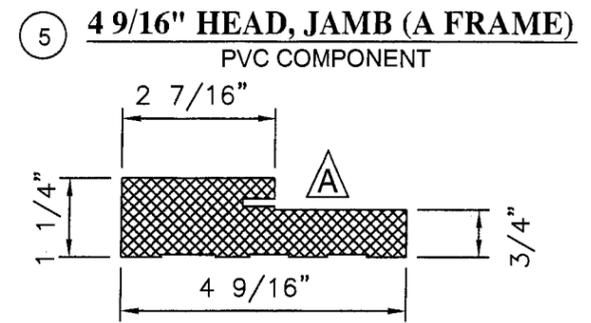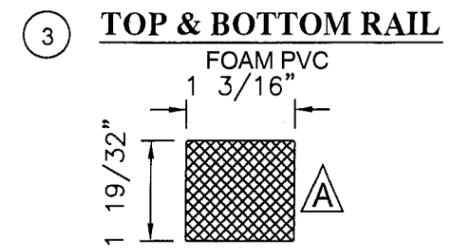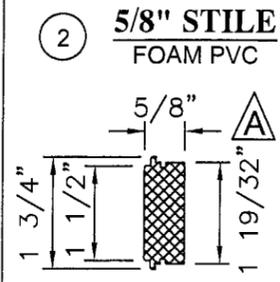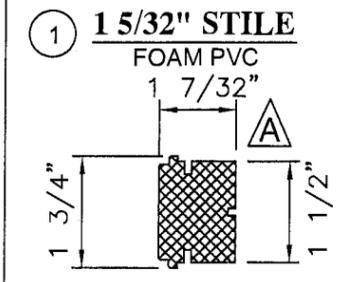BILL OF MATERIALS

ITEM NO.	PART NO.	QUANTITY	DESCRIPTION	MATERIAL	VENDOR
1	XXX	3	1 5/32" STILE	FOAM PVC	NANYA PLASTICS
2	XXX	8	5/8" STILE	FOAM PVC	NANYA PLASTICS
3	XXX	1	1 3/4" TOP/BOTTOM RAIL	FOAM PVC	NANYA PLASTICS
4	----	AS REQ'D.	#10 X 2 1/2" PH FL HD SCREW	----	----
5	XXX	3	FRAME HEAD & JAMB	FOAM PVC	NANYA PLASTICS
6	XXX	1	ENDURA 4 9/16" OUTSWING SILL	ALUMINUM	ENDURA
8	XXX	AS REQ'D.	Q-LON 650 WEATHERSTRIP	FOAM SILICONE (PE FILM)	Q-LON
9	----	4	4" X 4" HINGE	STEEL	MICOTA
10	XXX	2	ENDURA DOOR BOTTOM SWEEP	RIGID PVC CO-EX	ENDURA
11	XXX	2	CORNER PAD	FOAM SILICONE (PE FILM)	DOW-TECH PLASTICS
13	XXX	2	OUTSWING PANEL TRIM	ALUMINUM, PVC	MINI DIE CASTINGS
15	XXX	2	REINFORCEMENT (FULL LENGTH) A	WHITE PINE	----
16	----	1	ENTRY LATCH	----	KWIKSET
17	XXX	2	REINFORCEMENT (FULL LENGTH) A	WHITE PINE	----
18	XXX	1	ENDURA ASTRAGAL W/ BOLTS A	ALUMINUM, STEEL, PVC	ENDURA
19	XXX	AS REQ'D.	POLYURETHANE	----	NANYA PLASTICS A
20	XXX	4	SMC 67P DOOR SKIN - Fymin = 11000 PSI A	FIBERGLASS SKIN	NANYA PLASTICS
23	XXX	1	SHOOT BOLT STRIKE PLATE (HEAD)	STEEL (POWDER COATED)	----
24	XXX	1	SHOOT BOLT STRIKE PLATE (SILL)	STEEL (POWDER COATED)	----
25	XXX	1	DEAD BOLT	----	KWIKSET
26	----	----	1/4" ITW TAPCON W/ 1-1/4" MIN. EMBEDMENT	STEEL	ITW
27	----	12	#10 X 3" PFH SCREW	STEEL	----
28	----	14	#12 PFH SCREW	STEEL	----
29	----	12	#10 X 1 1/2" PFH SCREW	STEEL	----
30	----	14	#10 X 2" PFH SCREW	STEEL	----



APPROVED BY: Paul E. Winter DATE: 01/08/09

PER MIAMI DADE COMMENTS DATED 1-5-09

DATE: 01/08/09

DESCRIPTION: SMC

REV: A

DATE: 04/21/08

DRAWING NO: NAN0012

SHEET: 5 OF 5

PREPARED BY: N.T.S.

SCALE: N.T.S.

DRAWN BY: CB

DATE: 04/21/08

REV: A

REV: 5 OF 5

PTC, LLC
Phone 321.690.1788
Fax 321.690.1788

PTC, LLC
1535 Cugswell Street, Suite C25
Rockledge, Florida 32955
FBPE Certificate of Authorization NO. 25936

Paul E. Winter
Florida P.E. No. 22693

8989 NORTH LOOP EAST
HOUSTON, TX 77029

NANYA PLASTICS

OPaque DOUBLE ENTRY NON-IMPACT OUTSWING DOOR
BILL OF MATERIALS AND COMPONENTS