



**MIAMI-DADE COUNTY**  
**BUILDING CODE COMPLIANCE OFFICE (BCCO)**  
**PRODUCT CONTROL DIVISION**

**MIAMI-DADE COUNTY, FLORIDA**  
**METRO-DADE FLAGLER BUILDING**  
**140 WEST FLAGLER STREET, SUITE 1603**  
**MIAMI, FLORIDA 33130-1563**  
**(305) 375-2901 FAX (305) 372-6339**

**NOTICE OF ACCEPTANCE (NOA)**

[www.maimidade.gov/buildingcode](http://www.maimidade.gov/buildingcode)

**Galaxy Window and Door, Inc.**  
**1900 N. Andrews Ave, # C**  
**Pompano Beach, FL 33069**

**SCOPE:**

This NOA is being issued under the applicable rules and regulations governing the use of construction materials. The documentation submitted has been reviewed by Miami-Dade County Product Control Division and accepted by the Board of Rules and Appeals (BORA) to be used in Miami Dade County and other areas where allowed by the Authority Having Jurisdiction (AHJ).

This NOA shall not be valid after the expiration date stated below. The Miami-Dade County Product Control Division (In Miami Dade County) and/or the AHJ (in areas other than Miami Dade County) reserve the right to have this product or material tested for quality assurance purposes. If this product or material fails to perform in the accepted manner, the manufacturer will incur the expense of such testing and the AHJ may immediately revoke, modify, or suspend the use of such product or material within their jurisdiction. BORA reserves the right to revoke this acceptance, if it is determined by Miami-Dade County Product Control Division that this product or material fails to meet the requirements of the applicable building code. This product is approved as described herein, and has been designed to comply with the Florida Building Code, including the High Velocity Hurricane Zone.

**DESCRIPTION: Series "Tropical Force" Tilt White PVC Double Hung Window – L.M.I.**

**APPROVAL DOCUMENT:** Drawing No. **08-081**, titled "Series Tropical Force Vinyl Double Hung Tilt Window", sheets 1 through 6 of 6, dated 03/24/08, prepared by EngCo, Inc., signed and sealed by Pedro De Figueiredo, P.E., bearing the Miami-Dade County Product Control Approval stamp with the Notice of Acceptance number and Approval date by the Miami-Dade County Product Control Division.

**MISSILE IMPACT RATING: Large and Small Missile Impact Resistant**

**LABELING:** Each unit shall bear a permanent label with the AAMA PVC Extrusion Certification Label and with the manufacturer's name or logo, city, state and following statement: "Miami-Dade County Product Control Approved", unless otherwise noted herein.

**RENEWAL** of this NOA shall be considered after a renewal application has been filed and there has been no change in the applicable building code negatively affecting the performance of this product.

**TERMINATION** of this NOA will occur after the expiration date or if there has been a revision or change in the materials, use, and/or manufacture of the product or process. Misuse of this NOA as an endorsement of any product, for sales, advertising or any other purposes shall automatically terminate this NOA. Failure to comply with any section of this NOA shall be cause for termination and removal of NOA.

**ADVERTISEMENT:** The NOA number preceded by the words Miami-Dade County, Florida, and followed by the expiration date may be displayed in advertising literature. If any portion of the NOA is displayed, then it shall be done in its entirety.

**INSPECTION:** A copy of this entire NOA shall be provided to the user by the manufacturer or its distributors and shall be available for inspection at the job site at the request of the Building Official.

This NOA consists of this page 1 and evidence pages E-1 and E-2, as well as approval document mentioned above.

The submitted documentation was reviewed by **Manuel Perez, P.E.**



**NOA No. 08-0709.19**  
**Expiration Date: October 30, 2013**  
**Approval Date: October 30, 2008**  
**Page 1**

Galaxy Window and Door, Inc.

NOTICE OF ACCEPTANCE: EVIDENCE SUBMITTED

**A. DRAWINGS**

1. Manufacturer's die drawings and sections.
2. Drawing No **08-081**, titled "Series Tropical Force Vinyl Double Hung Tilt Window", sheets 1 through 6 of 6, dated 03/24/08, prepared by EngCo, Inc., signed and sealed by Pedro De Figueiredo, P.E.

**B. TESTS**

1. Test reports on:
  - 1) Air Infiltration Test, per FBC, TAS 202-94
  - 2) Uniform Static Air Pressure Test, Loading per FBC TAS 202-94
  - 3) Water Resistance Test, per FBC, TAS 202-94
  - 4) Large Missile Impact Test per FBC, TAS 201-94
  - 5) Cyclic Wind Pressure Loading per FBC, TAS 203-94
  - 6) Forced Entry Test, per FBC 2411 3.2.1, TAS 202-94

Along with marked-up drawings and installation diagram of a Vinyl Double Hung Tilt Window, prepared by Fenestration Testing Laboratory, Inc., Test Report No. **FTL-5374**, dated 02/06/08, signed and sealed by Michael R. Wenzel, P.E.

**C. CALCULATIONS**

1. Anchor verification calculations and structural analysis, complying with FBC-2004 and 2007, prepared by EngCo, Inc., dated 04/10/08 and 08/08/08, signed and sealed by Pedro De Figueiredo, P.E.  
**Complies with ASTM E1300-02**

**D. QUALITY ASSURANCE**


1. Miami Dade Building Code Compliance Office (BCCO).

**E. MATERIAL CERTIFICATIONS**

1. Notice of Acceptance No. **06-0216.06** issued to Solutia Inc. for their "**Saflex III G Clear or colored interlayer**" dated May 04, 2006, expiring on May 21, 2011.
2. Notice of Acceptance No. **08-0520.08** issued to Solutia Inc. for their "**Vanceva Composites Glass Interlayer**" dated July 17, 2008, expiring on December 11, 2013.
3. Notice of Acceptance No. **04-0709.01** issued to PH Tech, Inc., for their "**AAMA Certification Programs for Rigid PVC Extrusions**", dated September 30, 2004, expiring on September 30, 2009.

**F. STATEMENTS**

1. Statement letter of conformance and no financial interest, dated June 06, 2008, signed and sealed by Pedro De Figueiredo, P.E.

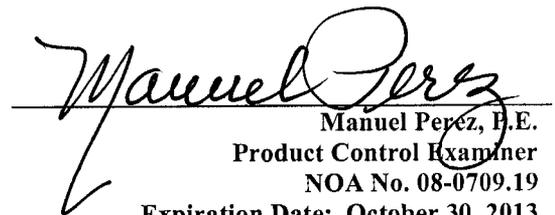  
Manuel Perez, P.E.  
Product Control Examiner  
NOA No. 08-0709.19  
Expiration Date: October 30, 2013  
Approval Date: October 30, 2008

Galaxy Window and Door, Inc.

NOTICE OF ACCEPTANCE: EVIDENCE SUBMITTED

**F. STATEMENTS (CONTINUED)**

2. Laboratory compliance letter for Test Report no. **FTL-5374**, issued by Fenestration Testing Laboratory, Inc., dated February 07, 2008, signed and sealed by Michael R. Wenzel, P.E.
3. Laboratory independent letter for Test Report no. **FTL-5374**, issued by Fenestration Testing Laboratory, Inc., dated February 07, 2008, signed by Manny Sanchez.

**G. OTHERS**

1. AAMA Certification Programs for Rigid PVC Extrusions AAMA Publication No. 109-97 and No. 303-97 revised October 01, 1997.

  
Manuel Perez, P.E.  
Product Control Examiner  
NOA No. 08-0709.19

Expiration Date: October 30, 2013  
Approval Date: October 30, 2008


**INDEX**

SHEET	DESCRIPTION
1	GENERAL NOTES, TYPICAL ELEVATIONS, WINDOW SPECIFICATIONS AND RATING
2	VERTICAL & HORIZONTAL DETAILS
3	TYPICAL DOUBLE HUNG ANCHORAGE, WEATHERSTRIPPING & CONSTRUCTION
4	MULLION ANCHORAGE
5	GLAZING OPTIONS & HARDWARE SCHEDULE
6	TYPICAL COMPONENTS, BILL OF MATERIALS

**GENERAL NOTES**


- 1- CODE: THIS PRODUCT HAS BEEN TESTED AND DESIGNED IN ACCORDANCE WITH THE FLORIDA BUILDING CODE 2007 INCLUDING THE HIGH VELOCITY HURRICANE ZONE (HVHZ).
- 2- DEFINITION: THIS PRODUCT IS A DOUBLE HUNG TILT TYPE WINDOW DESIGNED, CONSTRUCTED AND TESTED TO PROVIDE PROTECTION FROM HURRICANE FORCE WINDS AND WIND BORNE DEBRIS (LARGE MISSILE) WITHIN THE ALLOWABLE DESIGNED PRESSURES AND LIMITATIONS STATED IN THIS APPROVAL.
- 3- POSTING:
 

GALAXY WINDOW & DOOR  
POMPANO BEACH - FLORIDA  
MIAMI-DADE COUNTY PRODUCT CONTROL APPROVED\*
- 4- DESIGN LOADS: THE DESIGNED LOADS MUST BE CALCULATED BY A PROFESSIONAL ARCHITECT OR ENGINEER FOR EACH SPECIFIC PROJECT. THE CALCULATED DESIGNED PRESSURE MUST NOT EXCEED THE ALLOWABLE WINDOW PRESSURE.
- 5- MATERIAL: ALL PARTS TO BE AS NOTED ON THIS APPROVAL.
- 6- FASTENERS: ASSEMBLY SCREWS AND ANCHORS SHALL BE AS SPECIFIED IN THE CURRENT SET OF DRAWINGS. INSTALLATION AND LOADS AS PER THIS APPROVAL. ANCHOR QUANTITY & SPACING MUST NOT EXCEED THE MAXIMUM LIMITS SPECIFIED BY THIS APPROVAL.
- 7- USE: IT SHALL BE THE RESPONSIBILITY OF THE CONTRACTOR, ARCHITECT OR ENGINEER OF RECORD TO VERIFY THE FOLLOWING:
  - 7.1- THE STABILITY OF THE STRUCTURE WHERE THE PRODUCT IS TO BE ATTACHED INSURING PROPER ANCHORAGE.
  - 7.2- THE SITE SPECIFIC PROJECT CRITERIA, SUCH AS BUT NOT LIMITED TO, LOCAL CODE REQUIREMENTS, DESIGNED PRESSURES ETC.
  - 7.3- THAT THIS APPROVAL IS ADEQUATE TO THE SPECIFIC PROJECT.
- 8- 33 1/3% INCREASE IN ALLOWABLE LOADS HAVE NOT BEEN USED IN THE DESIGN OF THE ANCHORS FOR THIS PRODUCT APPROVAL, HOWEVER, WOOD SCREWS WITH 1.6 INCREASE FOR WIND LOAD DURATION HAVE BEEN USED.
- 9- DISSIMILAR MATERIALS: MATERIALS, INCLUDING BUT NOT LIMITED TO STEEL, THAT COME IN CONTACT WITH OTHER DISSIMILAR MATERIALS SHALL MEET THE REQUIREMENTS OF 2007 FLORIDA BUILDING CODE.

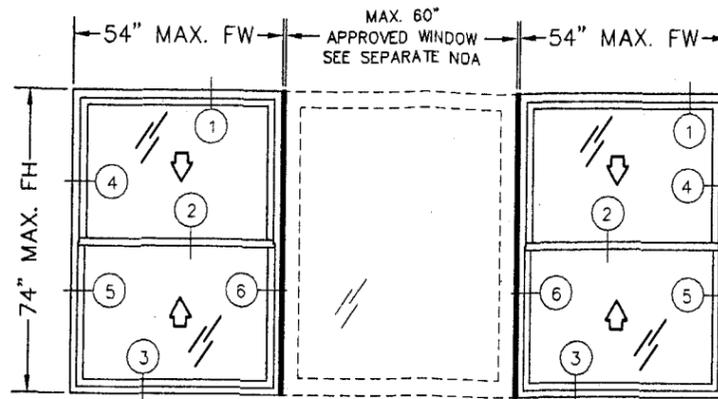


**ELEVATION TYPE A**

MULTIPLE MODULES DOUBLE HUNG IN COMBINATION WITH OTHER DOUBLE HUNG OR APPROVED WINDOW (NOT LIMITED TO 3)

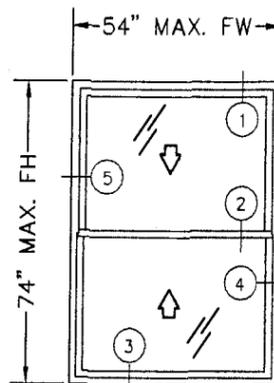

**ELEVATION TYPE C**  
SINGLE WINDOW

**TYPICAL ELEVATIONS**

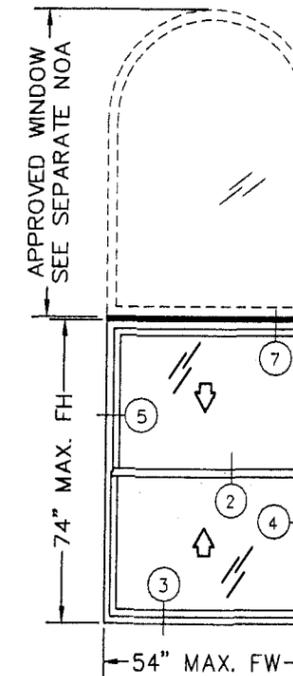

**ELEVATION TYPE B**  
DOUBLE HUNG IN COMBINATION WITH OTHER APPROVED WINDOW

NOTE: OPERABLE WINDOWS CAN BE USED IN COMBINATION WITH ANOTHER FIXED WINDOW OR OPERABLE WINDOW (FIX, CAS, DH, SH, HR, DHR, AW) WITH A VALID PRODUCT APPROVAL MANUFACTURED BY GALAXY WINDOWS

**WINDOW SPECIFICATIONS AND RATING**

MAXIMUM WINDOW SIZE: **54x74**

ALLOWABLE WINDOW PRESSURE - Pd = **+60.7 PSF, -76.8 PSF**

TEST PROTOCOLS: TAS 201/94 (LARGE MISSILE), 202/94, 203/94  
 ASTM E283 AT 1.57 PSF - 0.08 CFM/SQ. FT.  
 ASTM E547/E331 AT 9.1 SPSF - NO WATER LEAKAGE  
 FORCE ENTRY ASTM F558-04 TYPE B GRADE 10  
 ASTM E987 - DEGLAZING - 9%

WHITE RIGID PVC EXTRUSIONS MANUFACTURED BY PH TECH, INC. SHALL MEET ASTM D472, CLASSIFICATION (ASTM D4216) 1-10154-33-0000, 1-20131-13-0000 OR 1-40131-13 AND THE FOLLOWING PROPERTIES:

- ASTM D-635 - CLASS C1
- ASTM D-1929 - 925°F > 650
- ASTM D-2843 - 43% < 75
- ASTM E84 - 26.2 < 75
- ASTM D-638 - 498% < 10

MANUFACTURER:  
**GALAXY**  
**Window & Door**  
 1900 N ANDREWS AVE # C  
 POMPANO BEACH, FL-33069  
 TEL: (954) 978-2400  
 FAX: (954) 978-2403

PRODUCT:  
**TROPICAL FORCE**  
**VINYL DOUBLE HUNG**  
**TILT WINDOW**

Engineering:  
**EngCo Inc.**  
 CA 8116  
 6971 W. Sunrise Blvd. 104  
 Plantation, FL 33313  
 ENGCO@AOL.COM

**AUG 08 2008**

Engineer Seal  
 Pedro De Figueiredo, PE 52609

DRAFTING:  
**PK DRAFTING & MORE**

MIAMI-DADE BCCD

Approved as complying with the Florida Building Code  
 Date: 10/30/2008  
 NOA# 08-0769.19  
 Miami Dade Product Control  
 By: *Manuel Perez*





Date: 03/24/08  
 Scale: NA  
 Design by: PPMF

Drawing Number  
**08-081**

Sheet  
**1 of 6**



TYPICAL FRAMING ANCHORAGE

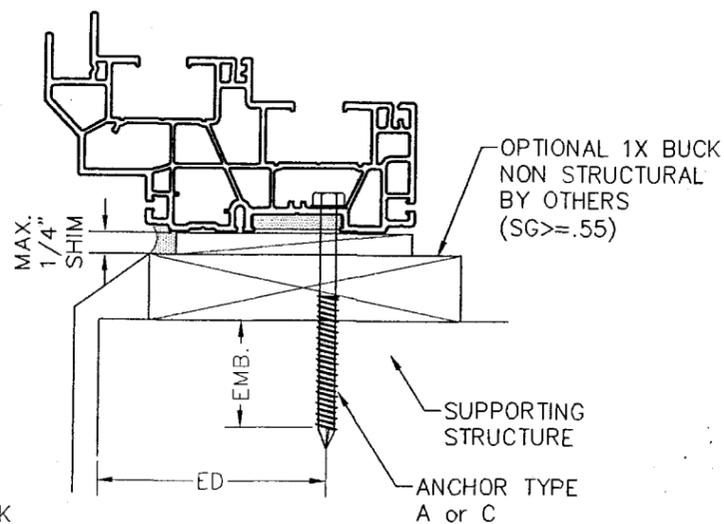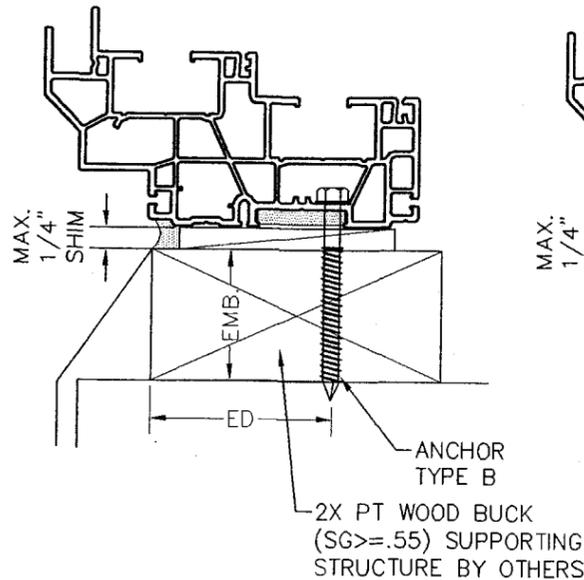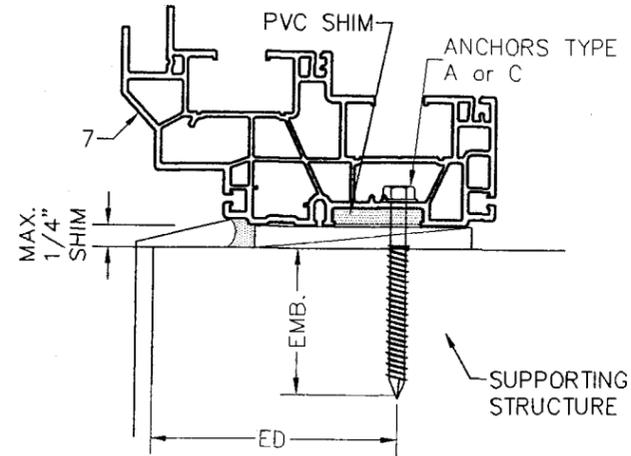
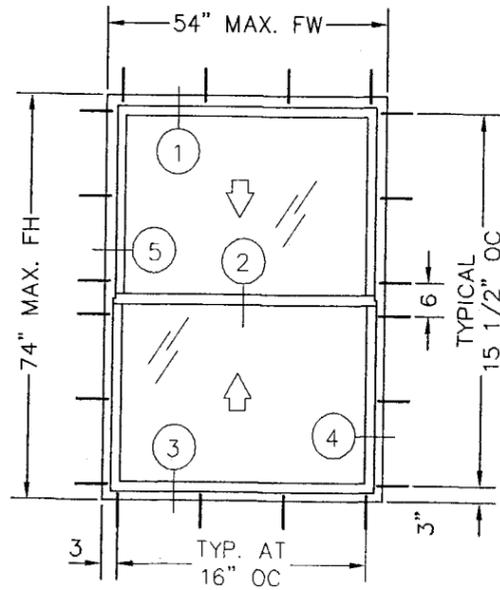


ANCHORS SCHEDULE

TYPE	DESCRIPTION	SUBSTRATUM	EMBEDMENT	EDGE DIST.
A	1/4" TAPCONS	2000 PSI CONC.	1.00"	1.50"
B	1/4" TAPCONS	WOOD SG>=.55	1.375"	1.00"
C	1/4"-14 GRADE 5 SDS	1/8" METAL	.125"	0.625"

Note: 1/8" Metal made of 6063-T6 aluminum or ASTM A36 Steel  
Embedment is beyond wall dressing

WEATHERSTRIPPING

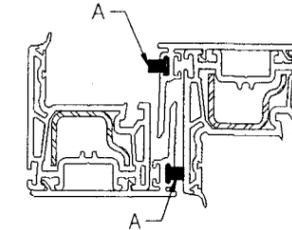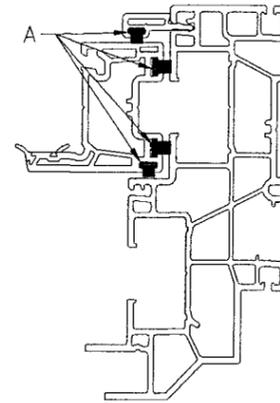

WEATHERSTRIPPING:  
A- ROW PILE WITH INTEGRAL PLASTIC FIN AT PERIMETER OF VENT AND AT FIXED MEETING RAIL

CONSTRUCTION

FRAME CONSTRUCTION:  
FOUR 3320 VINYL EXTRUDED SHAPES WERE MITTER CUT AND JOINTS WELDED.

VENT CONSTRUCTION:  
FOUR 5752 VINYL EXTRUDED SHAPES WERE MITTER CUT AND JOINTS WELDED.

MANUFACTURER:  
**GALAXY**  
Window & Door  
1900 N ANDREWS AVE # C  
POMPANO BEACH, FL-33069  
TEL: (954) 978-2400  
FAX: (954) 978-2403

PRODUCT:  
**TROPICAL FORCE**  
VINYL DOUBLE HUNG  
TILT WINDOW

Engineering:  
**EngCo Inc.**  
CA 8116  
6971 W. Sunrise Blvd. 104  
Plantation, Fl. 33313  
ENGCO@AOL.COM

*[Signature]*  
**AUG 08 2008**

Engineer Seal  
Pedro De Figueiredo, PE 52609

DRAFTING:  
**PK DRAFTING & MORE**

MIAMI-DADE BCCD:

Approved as complying with the  
Florida Building Code  
Date 10/30/2008  
NOAH 08-0709.19  
Miami Dade Product Control  
By *Manuel Perez*



Date: 03/24/08  
Scale: NA  
Design by: PPMF

Drawing Number  
**08-081**

Sheet  
**3 of 6**

### MULLION ANCHORAGE



MULLIONS ARE PART OF THE WINDOW REINFORCING FRAMING AND THEY CAN BE USE ONLY WITH APPROVED WINDOWS MANUFACTURED BY GALAXY WINDOW & DOOR

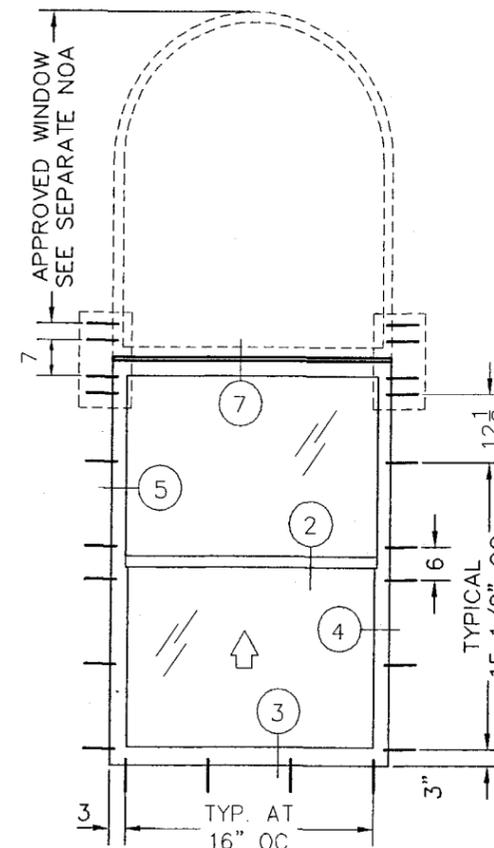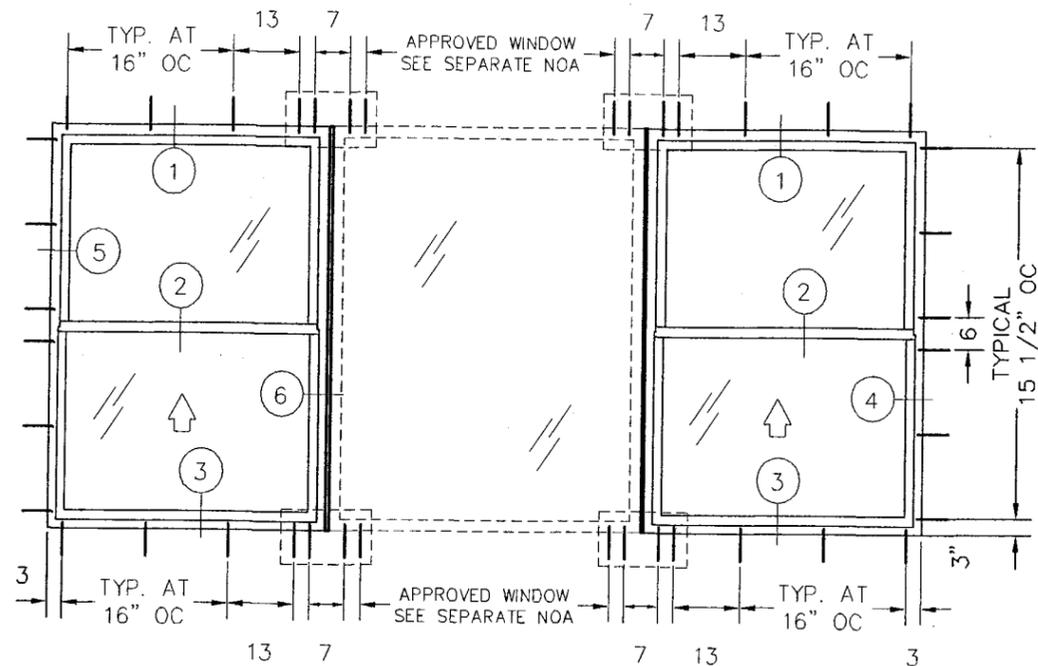

ANCHORS SCHEDULE

TYPE	DESCRIPTION	SUBSTRATUM	EMBEDMENT	EDGE DIST.
A	1/4" TAPCONS	2000 PSI CONC.	1.00"	1.50"
B	1/4" TAPCONS	WOOD SG>=.55	1.375"	1.00"
C	1/4"-14 GRADE 5 SDS	1/8" METAL	.125"	0.625"

Note: 1/8" Metal made of 6063-T6 aluminum or ASTM A36 Steel Embedment is beyond wall dressing

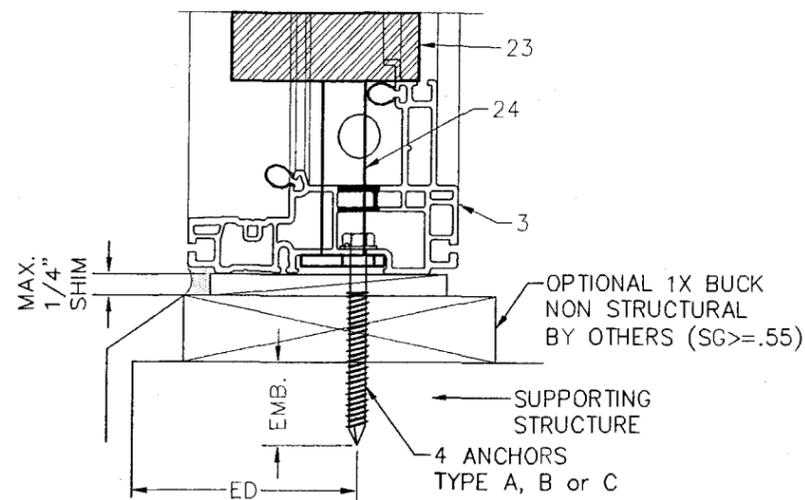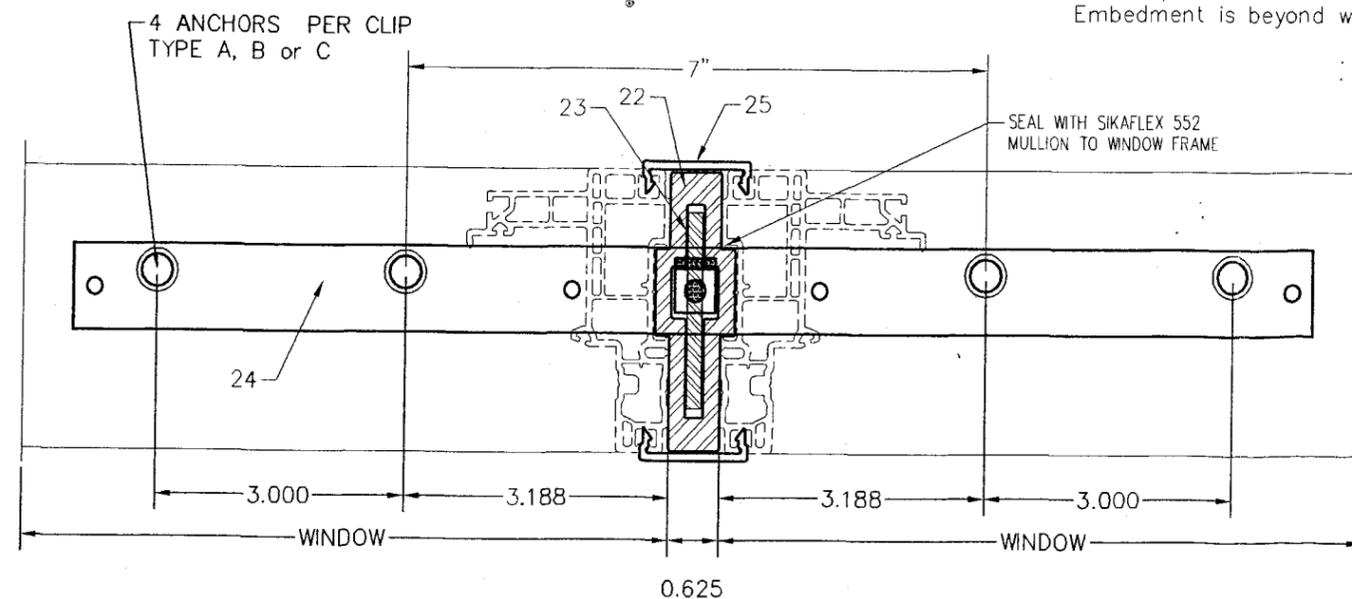

MANUFACTURER:  
**GALAXY**  
Window & Door  
1900 N ANDREWS AVE # C  
POMPANO BEACH, FL-33069  
TEL: (954) 978-2400  
FAX: (954) 978-2403

PRODUCT:  
**TROPICAL FORCE**  
VINYL DOUBLE HUNG  
TILT WINDOW

Engineering:  
**EngCo Inc.**  
CA 8116  
6971 W. Sunrise Blvd. 104  
Plantation, Fl. 33313  
ENGCO@AOL.COM

AUG 08 2008

Engineer Seal  
Pedro De Figueiredo, PE 52609

DRAFTING:  
**PK DRAFTING & MORE**

MIAMI-DADE BCCD:


Approved as complying with the  
Florida Building Code  
Date 10/30/2008  
NOA# 08-0709.10  
Miami Dade Model Control  
Division  
By: *Manuel Perez*

Date: 03/24/08  
Scale: NA  
Design by: PPMF


Drawing Number  
**08-081**

Sheet  
**4 of 6**

**GLAZING OPTIONS**

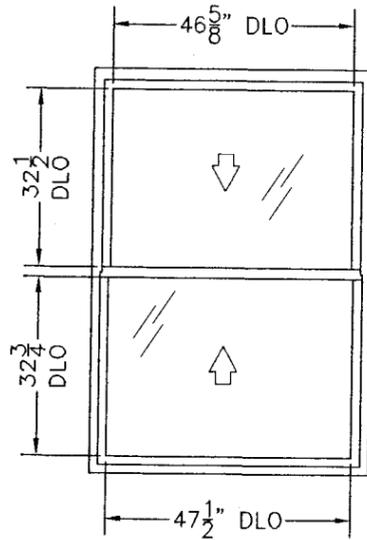

APPROVED INTERLAYERS	
1-	.09 SAFLEX IIIIG FILM
2-	.075 VANCEVA FILM

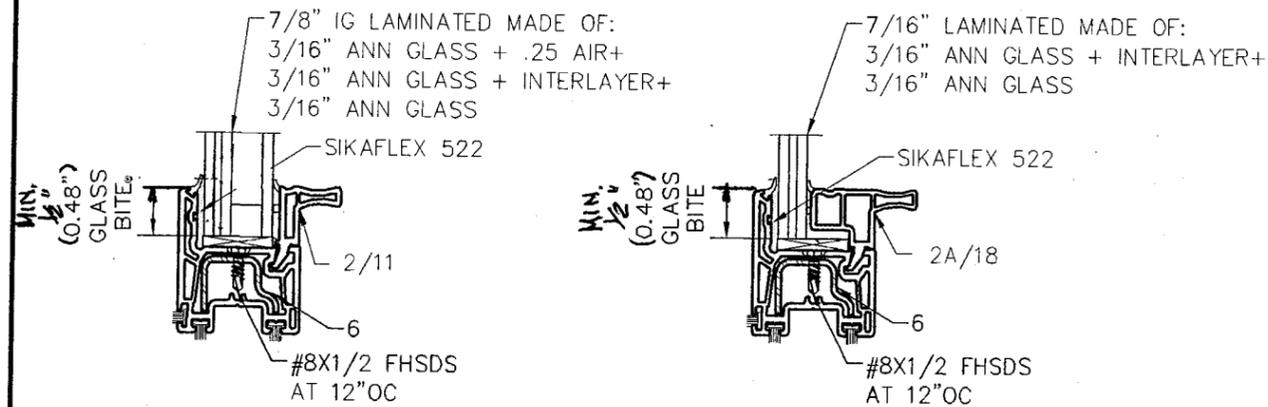

**HARDWARE SCHEDULE:**

H1- (2) SURFACE MOUNT METTALIC PULL PUSH CAM LOCKS WITH PLASTIC CAP, AT VENT BOTTOM VENTMEETING RAIL LOCATED 12 3/4" FROM EACH END, EACH FASTENED WITH (4) #8X1 1/4" FHWWS

H2- (2) SURFACE MOUNT KEEPERS, AT TOP VENT MEETING RAIL LOCATED 12" FROM EACH END, EACH FASTENED WITH (2) #6X1 1/2" FHSMS.

H3- (4) SURFACE MOUNT ALUMINUM TILT LATCHES, ONE AT EACH END OF THE TOP VENT TOP RAIL AND BOTTOM VENT MEETING RAIL, FASTENED WITH (2) #10X1/2" PHSMS

H4- (4) METALLIC PIVOT BARS, ONE AT EACH END OF THE TOP AND BOTTOM VENT MEETING RAIL, FASTENED WITH (3) #10X1/2" PHSMS.


H5- (4) CONSTANT FORCE BALANCES, BY CALDWELL, TWO AT EACH FRAME JAMB, FASTENED WITH (1) #10X3/4" PHSMS

H6- (2) 2" LONG PLASTIC VENT STOPS, ONE AT EACH LOWER FRAME CORNER.

H7- (2) 2" LONG PLASTIC VENT STOPS, ONE AT EACH UPPER FRAME CORNER.

H8- (2) METALLIC HOOK CLIPS, ONE AT EACH FRAME JAMB LOCATED 37 5/8" FROM THE BOTTOM, EACH FASTENED WITH (2) #8X2" FHSMS.

H9- (8) 7/8" NYLON SNUBBERS, ONE AT EACH VENT JAMB, LOCATED 6 3/4" FROM EACH END, EACH FASTENED WITH ONE #10X1/2" FHSMS

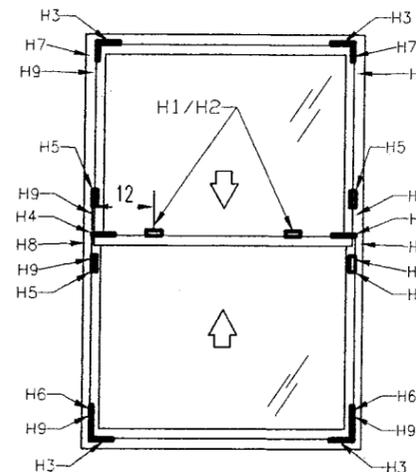

MANUFACTURER:  
**GALAXY**  
**Window & Door**  
 1900 N ANDREWS AVE # C  
 POMPANO BEACH, FL-33069  
 TEL: (954) 978-2400  
 FAX: (954) 978-2403

PRODUCT:  
**TROPICAL FORCE**  
**VINYL DOUBLE HUNG**  
**TILT WINDOW**

Engineering:  
**EngCo Inc.**  
 CA 8116  
 6971 W. Sunrise Blvd. 104  
 Plantation, FL. 33313  
 ENGCO@AOL.COM



**AUG 08 2008**

Engineer Seal  
 Pedro De Figueiredo, PE 52609

DRAFTING:  
**PK DRAFTING & MORE**

MIAMI-DADE BCCD:


Approved as complying with the  
 Florida Building Code  
 Date 10/30/2008  
 NOA# 08-0709.19  
 Miami Dade Pesticide Control  
 Division  
 By *Manuel Perez*

Date: 03/24/08  
 Scale: NA  
 Design by: PPMF


Drawing Number  
**08-081**

Sheet  
**5 of 6**


TYPICAL WINDOW COMPONENTS

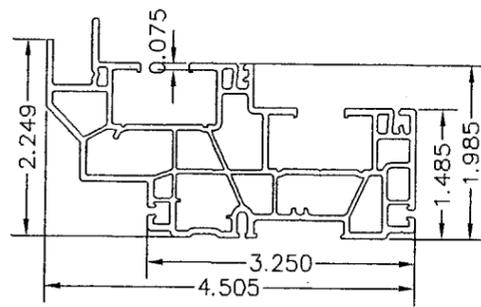


7- 3320  
DOUBLE HUNG / HOR. ROLLER  
PERIMETER FRAMING

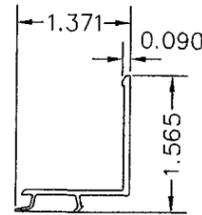


9- 5836  
SASH RETAINER

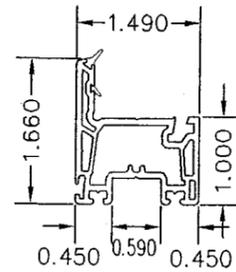


8- 5752  
SASH PROFILE

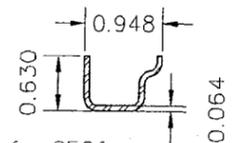


6- 9536  
SASH STEEL REINF.

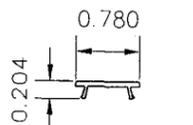


17- 5827  
COVERING CAP

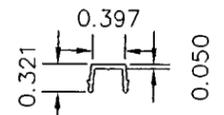


14- 5833- 2" LONG  
SCREEN SUPPORT

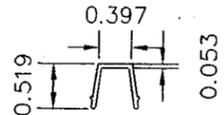


15- 5834 - 2" LONG  
SCREEN SUPPORT

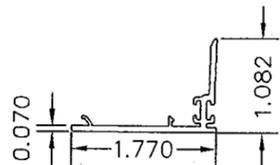


10- 5980  
INTERLOCK

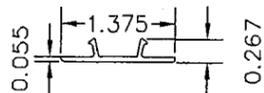


13- 5832  
COVERING CAP

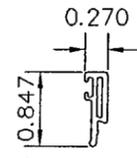


5- 5830  
SASH RETAINER

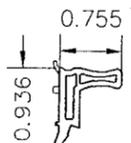


11- 5810  
IG HANDLE  
GLAZING BEAD

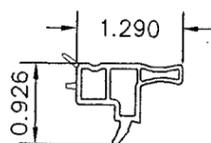


18- 5816  
HANDLE  
GLAZING BEAD

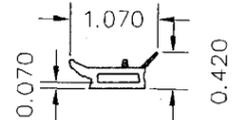


2- 5800  
IG GLASS STOP

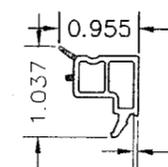


2A- 5806  
GLASS STOP

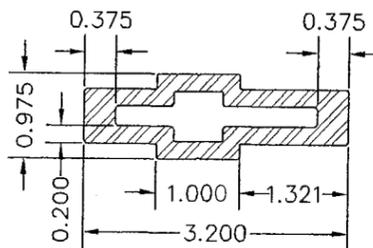


22- 8937 MULL  
ALUMINUM ALLOY 6005A-T61

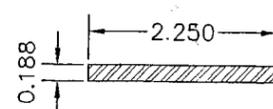

23- 7000075  
MULL REINF.  
STEEL ASTM A36

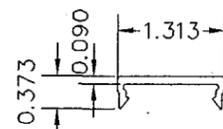

25- 5929  
MULL CAP

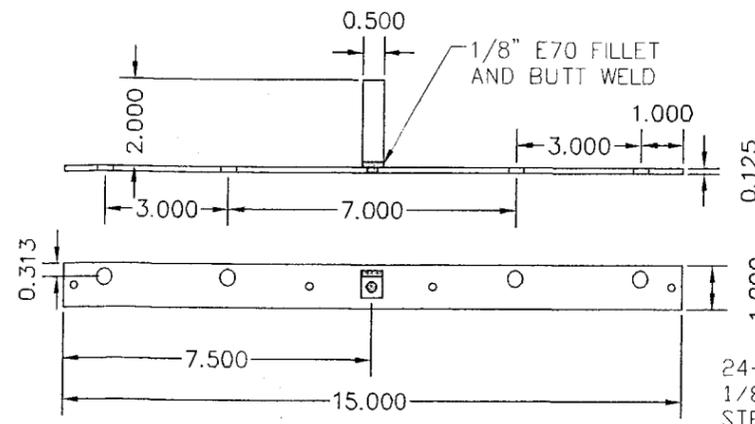

24- 9850  
1/8X1X15 MULL CLIP  
STEEL ASTM A36

BILL OF MATERIAL

ID	PART #	DESCRIPTION	VENDOR
7	3320	DOUBLE HUNG MAIN FRAME	PH TECH
8	5752	DOUBLE HUNG SASH	PH TECH
6	9536	SASH REINF.	PH TECH
5	5830	SASH RETAINER	PH TECH
9	5836	SASH RETAINER SILL	PH TECH
2A	5806	GLAZE BEAD	PH TECH
2	5800	IG GLAZE BEAD	PH TECH
11	5810	IG GLAZE BEAD HANDLE	PH TECH
18	5816	GLAZE BEAD HANDLE	PH TECH
10	5980	INTERLOCK	PH TECH
16	5872	SASH STOP	PH TECH
	522	ADHESIVE GLAZING	SIKA
	552	ADHESIVE GLAZING (MULL ONLY)	SIKA
17	5827	COVERING CAP	PH TECH
13	5832	MEETING RAIL COVERING CAP	PH TECH
	8870	WEEP HOLE COVER	PH TECH
	8872-S	TILT LATCH ASSEMBLY SPRING	PH TECH
	8872-P	TILT LATCH ASSEMBLY PIVOT BAR	PH TECH
	8872-B	TILT LATCH BUTTON	PH TECH
	70200000	LOCKING COLLAR / CAM	CALDWELL
	9628	SETTING BLOCK	PH TECH
	G002	2. 221X1. 053X. 175 PVC BLOCK	LOCAL
	975	#8X0. 625 TRUSS HEAD SCREW	PH TECH
		#8X3 SS PH SCREW	BROWARD BOLT
		#8X3. 5 SS PH SCREW	BROWARD BOLT
		1X. 188 WASHER	BROWARD BOLT
		#8X2 SS FH SCREW	BROWARD BOLT
	13884-899	HIGH PERFORMANCE SS J-HOOK	ASHLAND
	9774	WEATHERSTRIP	PH TECH
		7/16 OR 7/8 IMPACT GLASS	VARIOUS
14	5833	2" SCREEN SUPPORT	PH TECH
15	5834	12" SCREEN SUPPORT	PH TECH
	1-15	SCREEN FRAME	FLORIDA SCREEN
	FSC-6316-A	SCREEN MESH	FLORIDA SCREEN
	2-15	SCREEN CORNER KEY	FLORIDA SCREEN
	5959	SCREEN RETAINER	PH TECH
		SPLINE	FLORIDA SCREEN
23	7000075	3/16" BAR MULL REINF.	ALRO
22	8937	MULLION	PH TECH
25	5929	MULLION COVER	PH TECH
24	9850	STACKING PLATE	PH TECH

MANUFACTURER :  
**GALAXY**  
Window & Door  
1900 N ANDREWS AVE # C  
POMPANO BEACH, FL-33069  
TEL: (954) 978-2400  
FAX: (954) 978-2403

PRODUCT:  
**TROPICAL FORCE**  
VINYL DOUBLE HUNG  
TILT WINDOW

Engineering:  
**EngCo Inc.**  
CA 8116  
6971 W. Sunrise Blvd. 104  
Plantation, Fl. 33313  
ENGCO@AOL.COM

*(Signature)*  
**AUG 08 2008**  
Engineer Seal  
Pedro De Figueiredo, PE 52609

DRAFTING:  
**PK DRAFTING & MORE**

MIAMI-DADE BCCD:

Approved as complying with the  
Florida Building Code  
Date 10/30/2008  
MOA 08-0709-19  
Miami Dade Product Control  
By *(Signature)*

Date: 03/24/08  
Scale: NA  
Design by: PPMF

Drawing Number  
**08-081**

Sheet  
**6 of 6**