



MIAMI-DADE COUNTY
BUILDING CODE COMPLIANCE OFFICE (BCCO)
PRODUCT CONTROL DIVISION

MIAMI-DADE COUNTY, FLORIDA
METRO-DADE FLAGLER BUILDING
140 WEST FLAGLER STREET, SUITE 1603
MIAMI, FLORIDA 33130-1563
(305) 375-2901 FAX (305) 375-2908

www.miamidade.gov/buildingcode

NOTICE OF ACCEPTANCE (NOA)

TEEM USA, LLC
418 North Segrave street
Daytona Beach, Florida, 32114

SCOPE:

This NOA is being issued under the applicable rules and regulations governing the use of construction materials. The documentation submitted has been reviewed by Miami-Dade County Product Control Division and accepted by the Board of Rules and Appeals (BORA) to be used in Miami Dade County and other areas where allowed by the Authority Having Jurisdiction (AHJ).

This NOA shall not be valid after the expiration date stated below. The Miami-Dade County Product Control Division (In Miami Dade County) and/or the AHJ (in areas other than Miami Dade County) reserve the right to have this product or material tested for quality assurance purposes. If this product or material fails to perform in the accepted manner, the manufacturer will incur the expense of such testing and the AHJ may immediately revoke, modify, or suspend the use of such product or material within their jurisdiction. BORA reserves the right to revoke this acceptance, if it is determined by Miami-Dade County Product Control Division that this product or material fails to meet the requirements of the applicable building code.

This product is approved as described herein, and has been designed to comply with the Florida Building Code, including High Velocity Hurricane Zone of the Florida Building Code.

DESCRIPTION: Series "CORONA 70" Vinyl (PVC) Sliding Glass Door W/ Reinforcements-L. M. Impact

APPROVAL DOCUMENT: Drawing No. **TEEM005**, titled "CORONA 70" series Tilt & Slide Door, sheets 1 through 8 of 8, prepared by PTC, LLC, dated 02/01/09 and last revised on 06-03-2009, signed and sealed by Paul E. Winter, P.E., bearing the Miami-Dade County Product Control Approval stamp with the Notice of Acceptance number and approval date by the Miami-Dade County Product Control Division.

MISSILE IMPACT RATING: Large and Small Missile Impact Resistant

Limitation:

1. Not approved where Air & Water infiltration are needed.
2. Dow Corning 995 to be used for item #21 as a glazing silicone compound.

LABELING: Each unit shall bear a permanent label with the manufacturer's name or logo, city, state and following statement: "Miami-Dade County Product Control Approved", unless otherwise noted herein.

RENEWAL of this NOA shall be considered after a renewal application has been filed and there has been no change in the applicable building code negatively affecting the performance of this product.

TERMINATION of this NOA will occur after the expiration date or if there has been a revision or change in the materials, use, and/or manufacture of the product or process. Misuse of this NOA as an endorsement of any product, for sales, advertising or any other purposes shall automatically terminate this NOA. Failure to comply with any section of this NOA shall be cause for termination and removal of NOA.

ADVERTISEMENT: The NOA number preceded by the words Miami-Dade County, Florida, and followed by the expiration date may be displayed in advertising literature. If any portion of the NOA is displayed, then it shall be done in its entirety.

INSPECTION: A copy of this entire NOA shall be provided to the user by the manufacturer or its distributors and shall be available for inspection at the job site at the request of the Building Official.

This NOA consists of this page 1 and evidence page E-1, as well as approval document mentioned above. The submitted documentation was reviewed by **Ishaq I. Chanda, P.E.**

NOA No 08-1015.06

Expiration Date: July 01, 2014

Approval Date: July 01, 2009

Page 1



Handwritten signature and date: 6/11/09

NOTICE OF ACCEPTANCE: EVIDENCE SUBMITTED

A. DRAWINGS

1. Manufacturer's die drawings and sections
2. Drawing No. **TEEM005**, titled "CORONA 70" series Tilt & Slide Door, sheets 1 through 8 of 8, prepared by PTC, LLC, dated 02/01/09 and last revised on 06-03-2009, signed and sealed by Paul E. Winter, P.E.

B. TESTS

1. Test reports on
 - 1) Air Infiltration Test, per FBC, TAS 202-94 (Not conducted)
 - 2) Uniform Static Air Pressure Test, Loading per FBC, TAS 202-94
 - 3) Water Resistance Test, per FBC, TAS 202-94 (Not conducted)
 - 4) Forced Entry Test per FBC, TAS 202-94
 - 5) Large Missile Impact Test per FBC, TAS 201-94,
 - 6) Cyclic Wind Pressure Loading per FBC, TAS 203-94

along with marked-up drawings and installation diagram of PVC sliding glass door, prepared by Certified Testing Laboratories, Test Report No. **CTL-1789 W**, dated 01/16/08, signed and sealed by Ramesh C. Patel, P.E.

Note: This test report have been revised by an addendum letters dated April 14, 2009 and 06/01/09, issued by Certified Testing lab, signed and sealed by Ramesh C. Patel, P.E.

C. CALCULATIONS

1. Anchor verification calculations dated 02/16/09, prepared by PTC, LLC, signed and sealed by Paul E. Winter, P.E.
2. Complies with ASTM-E1300-02 &-04

D. QUALITY ASSURANCE

1. Miami Dade Building Code Compliance Office (BCCO).

E. MATERIAL CERTIFICATIONS


1. Notice of Acceptance No. **07-1116.04** issued to E.I. DuPont De Nemours & CO., Inc. for "DuPont SentryGlas® Plus", expiring on 01/14/2012.
2. Test Report No. **HETI-08-A100** w/ revision dated Sep. 02, 2008, issued by Hurricane Engineering & Testing Inc for "White PVC" for "Accelerated Weathering using Xenon Arc" per ASTM G-155-04, signed by Candido F. Font, P.E.
3. Test Report No. **HETI-08-T116A** & **HETI-08-T117** dated April 18, 2008, issued by Hurricane Engineering & Testing Inc for "White PVC" for "Tensile test" per ASTM D638-03 for un-exposed and 4500 Hours exposed samples, signed by Candido F. Font, P.E.
4. Test Report No. **ETC-08-1024-20733.0**, dated March 28, 2009, issued by ETC lab, for "Surface Burning Characteristics" per ASTM D-1929, "Smoke Density" per ASTM D-2843 and "Rate of Burning" per ASTM D-635, all signed by Joseph L. Doland, P.E.

F. STATEMENTS

1. Statement letters of Compliance and "no financial interest", dated 02/16/09, signed and sealed by Paul E. Winter, P.E.
2. Statement letter of lab compliance, part of the above referenced test reports.

G. OTHER

1. None

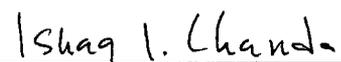

Ishaq I. Chanda, P.E.
Product Control Examiner
NOA No 08-1015.06
Expiration Date: July 01, 2014
Approval Date: July 01, 2009

TEEEM USA

CORONA 70 SERIES TILT & SLIDE DOOR - L.M.I.

INSTALLATION ANCHORAGE DETAILS

GENERAL NOTES:

1. THE PRODUCT ANCHORAGE SHOWN HEREIN IS DESIGNED TO COMPLY WITH THE 2007 FLORIDA BUILDING CODE (FBC) AT THE DESIGN PRESSURE(S) STATED HEREIN.
2. THE PRODUCT DETAILS CONTAINED HEREIN ARE BASED UPON SIGNED AND SEALED TEST REPORT # CTLA 1789W (LMI) DATED 01/16/08 AND ASSOCIATED LABORATORY STAMPED DRAWINGS AND WERE TESTED IN ACCORDANCE WITH DADE COUNTY PROTOCOLS.
3. THE PRODUCT HAS BEEN EVALUATED FOR CONFORMANCE TO THE STANDARDS LISTED IN THE CURRENT FLORIDA BUILDING CODE (FBC) AND IS IN COMPLIANCE WITH SAID STANDARDS, INCLUDING HIGH VELOCITY HURRICANE ZONE (HVHZ) REQUIREMENTS.
4. ADEQUACY OF THE EXISTING STRUCTURAL CONCRETE MASONRY AND 2X FRAMING AS A MAIN WIND FORCE RESISTING SYSTEM CAPABLE OF WITHSTANDING AND TRANSFERRING APPLIED PRODUCT LOADS TO THE STRUCTURE IS THE RESPONSIBILITY OF THE ENGINEER OR ARCHITECT OF RECORD.
5. 1X AND 2X BUCKS (WHEN USED) SHALL BE DESIGNED AND ANCHORED TO PROPERLY TRANSFER ALL LOADS TO THE STRUCTURE. BUCK DESIGN AND INSTALLATION IS THE RESPONSIBILITY OF THE ENGINEER OR ARCHITECT OF RECORD.
6. THE INSTALLATION DETAILS DESCRIBED HEREIN ARE GENERIC AND MAY NOT REFLECT ACTUAL CONDITIONS FOR A SPECIFIC SITE. IF SITE CONDITIONS CAUSE INSTALLATION TO DEVIATE FROM THE REQUIREMENTS DETAILED HEREIN, THEN THE BUILDING OFFICIAL MAY ELECT ONE OF THE FOLLOWING OPTIONS:
 - A. OUTSIDE HVHZ: REQUIRE THAT A LICENSED ENGINEER OR ARCHITECT PREPARE AND SUBMIT SITE SPECIFIC DOCUMENTS FOR USE WITH THIS DOCUMENT.
 - B. INSIDE HVHZ: REQUIRE THAT A ONE-TIME SITE SPECIFIC APPROVAL BE APPLIED FOR AND OBTAINED FROM THE MIAMI-DADE COUNTY PRODUCT CONTROL DIVISION.
7. WINDOW FRAME MATERIAL: WHITE VINYL Δ

8. GLASS MEETS THE REQUIREMENTS OF ASTM E1300. SEE SHEET 6 FOR GLAZING DETAIL.
9. DESIGNATIONS "X" AND "O" STAND FOR THE FOLLOWING:
X: OPERABLE PANEL
O: FIXED PANEL
10. A 1/3 INCREASE IN ALLOWABLE STRESS FOR WIND LOADS WAS NOT USED IN THE DESIGN OF THE PRODUCT(S) SHOWN HEREIN. WIND LOAD DURATION FACTOR ($C_d = 1.6$) HAS BEEN USED FOR WOOD ANCHOR DESIGN.

INSTALLATION NOTES:

1. TWO (2) INSTALLATION ANCHORS ARE REQUIRED AT EACH ANCHOR LOCATION SHOWN.
2. THE NUMBER OF INSTALLATION ANCHORS DEPICTED IS THE MINIMUM NUMBER OF ANCHORS TO BE USED FOR PRODUCT INSTALLATION.
3. SHIM AS REQUIRED AT EACH INSTALLATION ANCHOR WITH LOAD BEARING SHIM(S). MAXIMUM ALLOWABLE SHIM SIZE IS 1/4 INCH. SHIM WHERE SPACE OF 1/16 INCH OR GREATER OCCURS. SHIM(S) SHALL BE CONSTRUCTED OF HIGH DENSITY PLASTIC OR BETTER.
4. FOR INSTALLATION INTO WOOD FRAMING, USE #12 WOOD SCREWS OF SUFFICIENT LENGTH TO ACHIEVE 1 1/2 INCH MINIMUM EMBEDMENT. MINIMUM EDGE DISTANCE IS 2 1/2 INCHES. MINIMUM ANCHOR SEPARATION IS 1 1/2 INCHES.
5. FOR INSTALLATION THROUGH 1X BUCK (TO BE PROPERLY SECURED) TO CONCRETE / MASONRY, OR DIRECTLY INTO CONCRETE / MASONRY, USE 1/4 INCH ITW TAPCONS OF SUFFICIENT LENGTH TO ACHIEVE 1 1/4 INCH MINIMUM EMBEDMENT. MINIMUM EDGE DISTANCE IS 2 1/2 INCHES. MINIMUM ANCHOR SEPARATION IS 2 5/16 INCHES.
6. MINIMUM EMBEDMENT AND EDGE DISTANCE EXCLUDE WALL FINISHES, INCLUDING BUT NOT LIMITED TO STUCCO, FOAM, BRICK VENEER AND SIDING.

7. INSTALLATION ANCHORS AND ASSOCIATED HARDWARE MUST BE MADE OF CORROSION RESISTANT MATERIAL OR HAVE A CORROSION RESISTANT COATING.
8. FOR CONCRETE BLOCK, DO NOT INSTALL INSTALLATION ANCHORS INTO MORTAR JOINTS. EDGE DISTANCE IS MEASURED FROM FREE EDGE OF BLOCK OR EDGE OF MORTAR JOINT INTO FACE SHELL OF BLOCK.
9. INSTALLATION ANCHORS SHALL BE INSTALLED IN ACCORDANCE WITH ANCHOR MANUFACTURER'S INSTALLATION INSTRUCTIONS AND ANCHORS SHALL NOT BE USED IN SUBSTRATES WITH STRENGTHS LESS THAN THE MINIMUM STRENGTH SPECIFIED BY THE ANCHOR MANUFACTURER.
10. INSTALLATION ANCHOR CAPACITIES FOR PRODUCTS HEREIN ARE BASED ON SUBSTRATE MATERIALS WITH THE FOLLOWING PROPERTIES:
 - Δ A. WOOD - PT SOUTHERN YELLOW PINE. MINIMUM SPECIFIC GRAVITY OF 0.55.
 - B. CONCRETE - MINIMUM COMPRESSIVE STRENGTH OF 3192 psi AND COMPLIES WITH ACI 301, ACI 318-05 AND ACI-355
 - C. MASONRY - STRENGTH CONFORMANCE TO ASTM C-90 AND ACI 530-05, GRADE N, TYPE 1 (OR GREATER).

Δ TABLE OF CONTENTS		
SHEET	REV.	SHEET DESCRIPTION
1	A	GENERAL AND INSTALLATION NOTES
2	A	ELEVATION AND ANCHOR LAYOUT
3	A	VERTICAL SECTIONS
4	A	VERTICAL SECTIONS
5	A	HORIZONTAL SECTIONS
Δ 6	B	HORIZONTAL SECT., BOM, ANCHOR STRAP & GLAZING DETAIL
7	A	COMPONENTS
8	-	LIFT AND SLIDE HARDWARE

Δ DESIGN PRESSURE RATING (PSF)	IMPACT RATING
WHERE WATER INFILTRATION REQUIREMENT IS NOT NEEDED	LARGE MISSLE IMPACT
±120.0	

APPROVED BY: PAUL WINTER	DATE: 02/10/09
B	PER MIAMI DADE COMMENTS 03/19/09
A	PER MIAMI DADE COMMENTS 11/16/08
REV	DESCRIPTION
	DATE
	BY

TEEEM USA
418 N. SEAGRAVE ST., C
DAYTONA BEACH, FL. 32114


CORONA 70 SERIES TILT & SLIDE DOOR - L.M.I.
GENERAL AND INSTALLATION NOTES

PREPARED BY: P.T.C. LLC
DATE: 10/07/08
DRAWING NO.: TEEEM0005
SCALE: N.T.S.
REV: B
SHEET: 1 OF 8


PHONE 321.690.1788 FAX 321.690.1789

PROJECT #307-0308
Paul E. Winter
Florida P.E. No. 22893
1535 Cogswell Street, Suite C25
Rockledge, Florida 32955
FBPE Certificate of Authorization No. 25995

Approved as complying with the
Florida Building Code
Date July 1, 2009
NOA# 08-1015-06
Miami Dade Product Control
Division
By Ishag J. Chavala

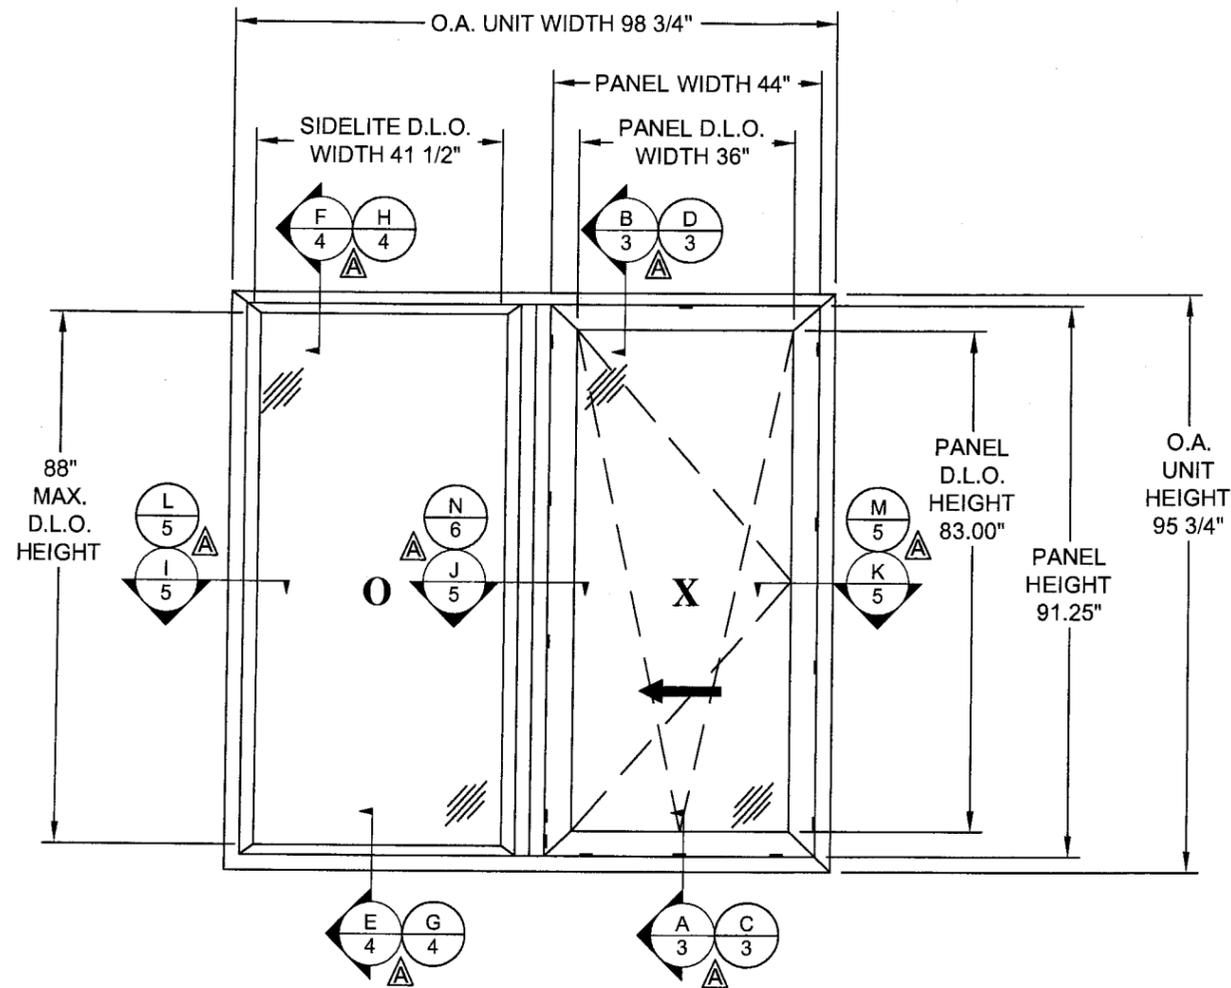

ELEVATION
OX OR XO (REVERSIBLE)

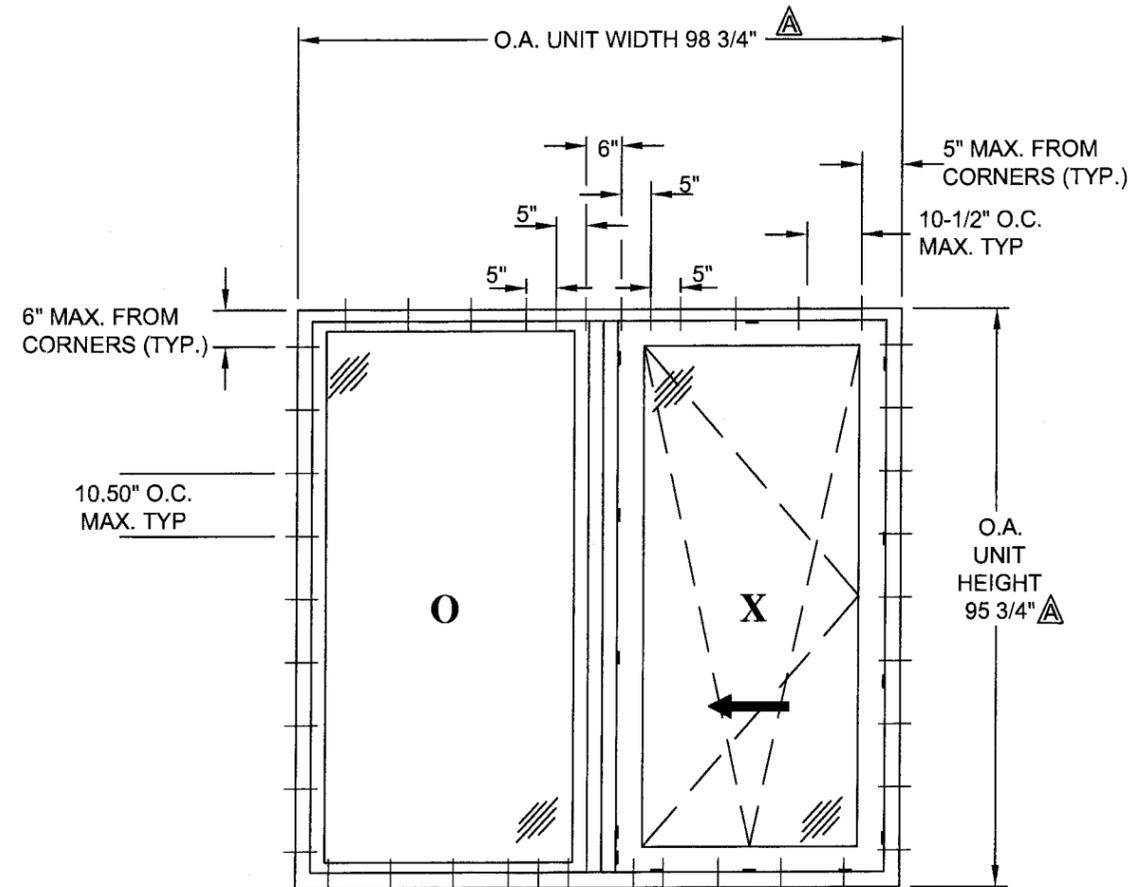

ANCHOR LAYOUT
NOTE: FOR MULLION ANCHOR LAYOUT, SEE SHEET 6.

APPROVED BY: PAUL WINTER	DATE: 02/10/09
REV: A	DESCRIPTION: PER MIAMI DADE COMMENTS 11/16/08
REV: BY	DATE: 02/11/09 SMC

TEEM USA
418 N. SEAGRAVE ST., C
DAYTONA BEACH, FL. 32114

TITLE: CORONA 70 SERIES TILT & SLIDE DOOR - L.M.I.
ELEVATION AND ANCHOR LAYOUT

PREPARED BY: PTC, LLC
1535 Cogswell Street, Suite C25
Rockledge, Florida 32955
Phone 321.690.1788 Fax 321.690.1789

FBPE Certificate of Authorization NO. 25935


DRAWN BY: CB DATE: 10/07/08
SCALE: N.T.S. DRAWING NO.: TEEM0005
REV: A SHEET: 2 OF 8

PROJECT #307-0308
Paul E. Winter
Florida P.E. No. 22693



Signature

PTC, LLC
1535 Cogswell Street, Suite C25
Rockledge, Florida 32955
FBPE Certificate of Authorization NO. 25935


Approved as complying with the
Florida Building Code
Date July 01, 2009
NOA# 08-1015-06
Miami Dade Product Control
Division
By Shaghl. Ghandi

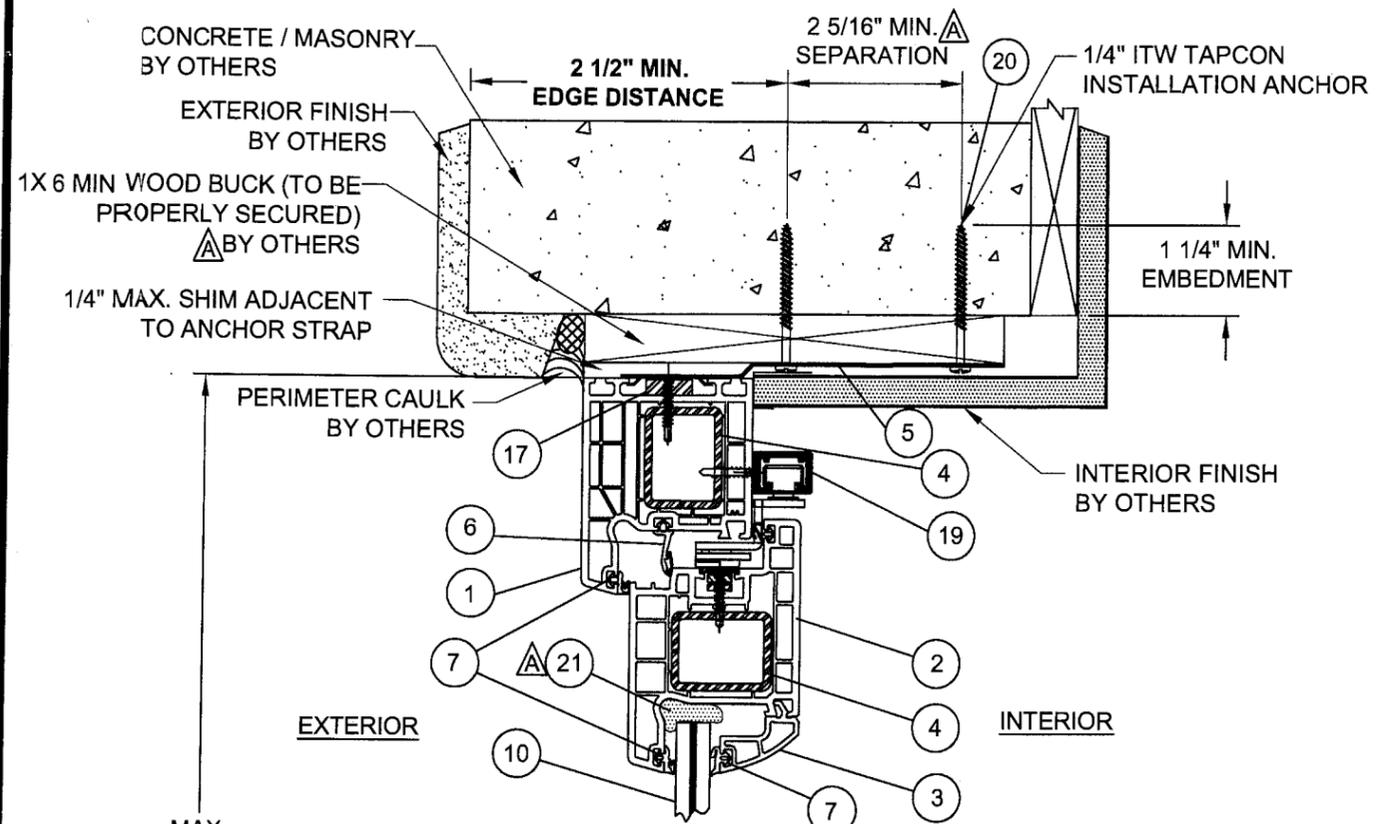



A VERTICAL SECTION
OPERABLE PANEL

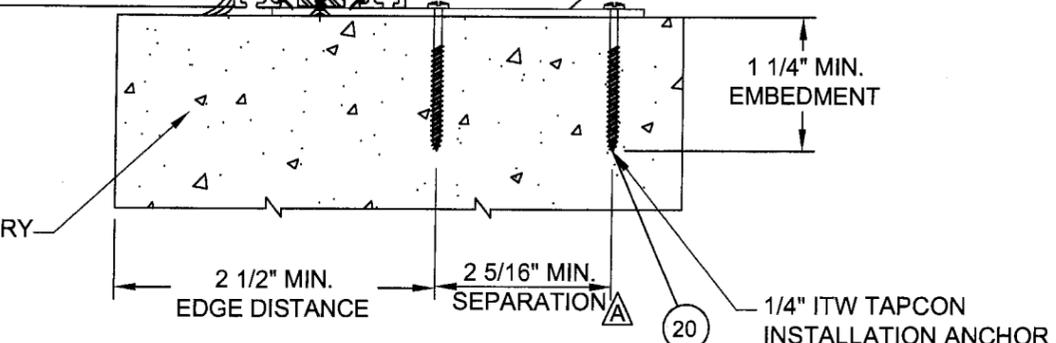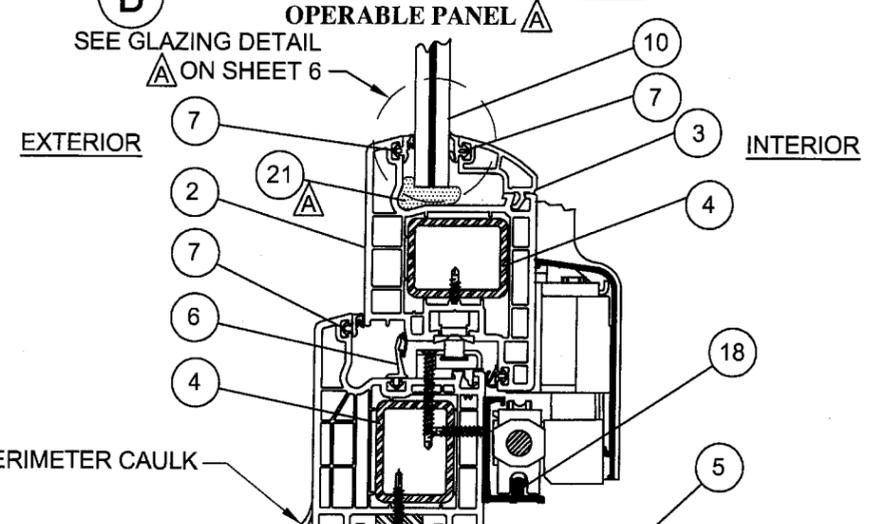

B VERTICAL SECTION
OPERABLE PANEL

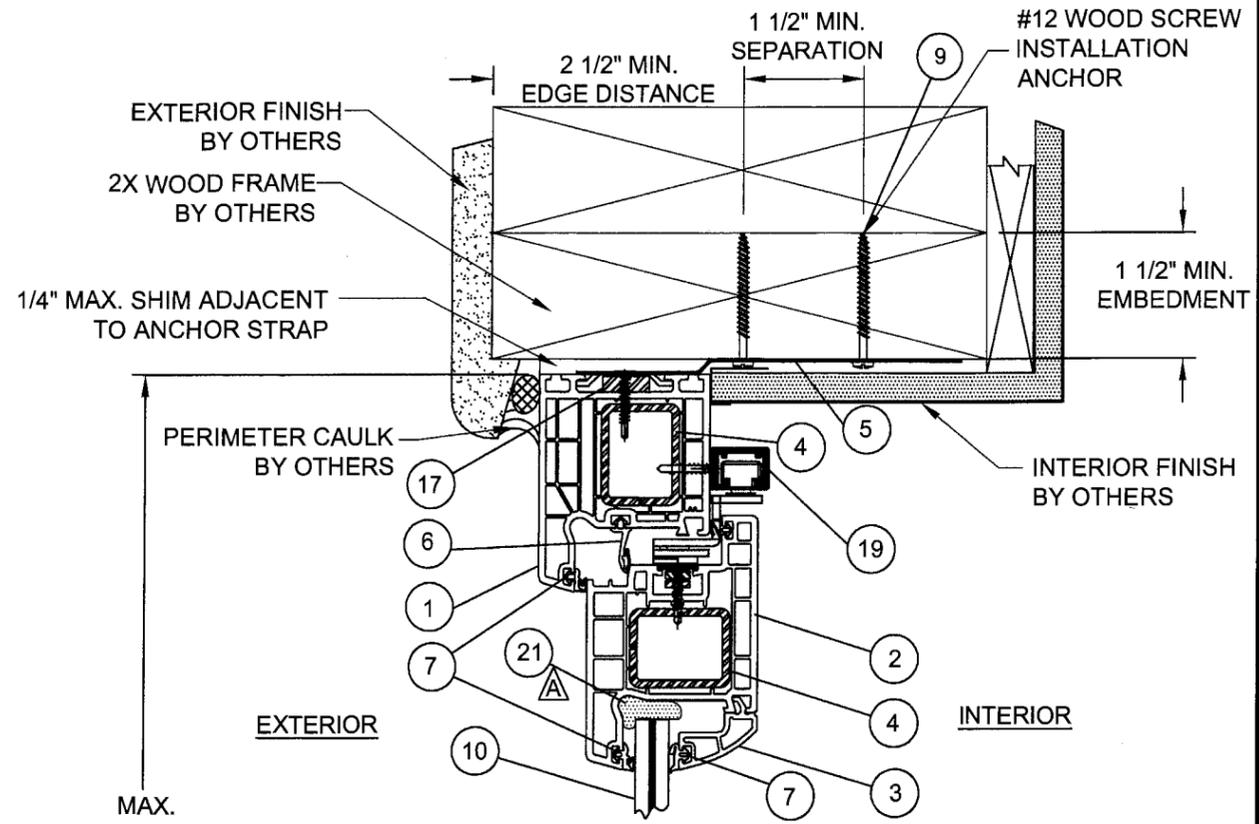

D VERTICAL SECTION
OPERABLE PANEL

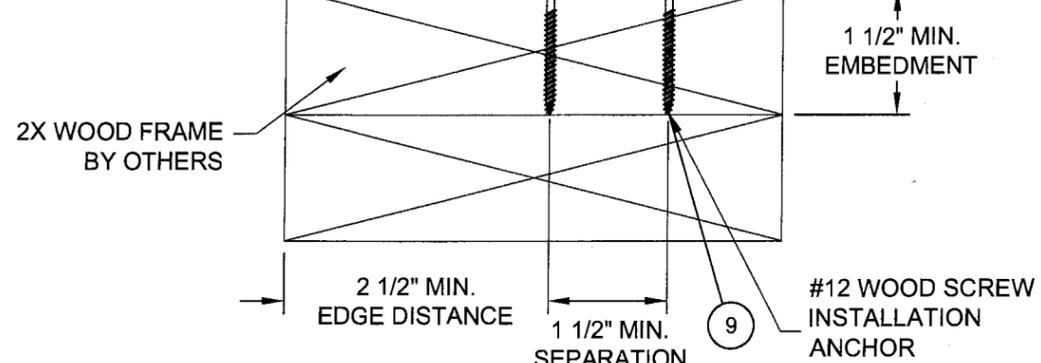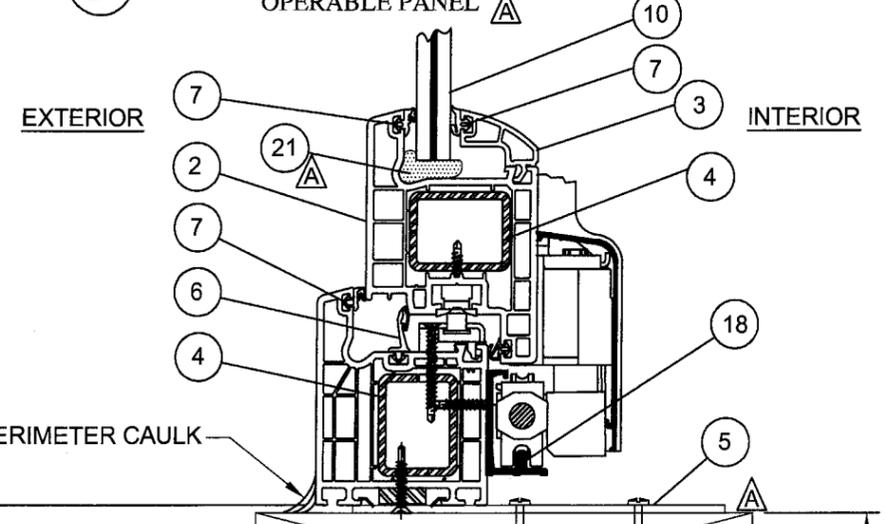

C VERTICAL SECTION
OPERABLE PANEL


DATE:	02/10/08
APPROVED BY:	PAUL WINTER
PER MIAMI DADE COMMENTS:	11/16/08
REV:	A
DESCRIPTION:	
DATE:	02/11/09
BY:	SMC

PROJECT:	TEEM USA
ADDRESS:	418 N. SEAGRAVE ST., C DAYTONA BEACH, FL. 32114
TITLE:	CORONA 70 SERIES TILT & SLIDE DOOR - L.M.I. VERTICAL SECTIONS
DRAWN BY:	CB
DATE:	10/07/08
SCALE:	N.T.S.
DRAWING NO.:	TEEM0005
REV:	A
SHEET:	3 OF 8




PROJECT #307-0308
 Paul E. Winter
 Florida P.E. No. 22693
 PTC, LLC
 1535 Cogswell Street, Suite C25
 Rockledge, Florida 32955
 FBPE Certificate of Authorization NO. 25535

Approved as complying with the Florida Building Code
 Date July 01, 2009
 NOA# 08-1015-06
 Miami Dade Product Control Division
 By (Shaq) L. Gaud...

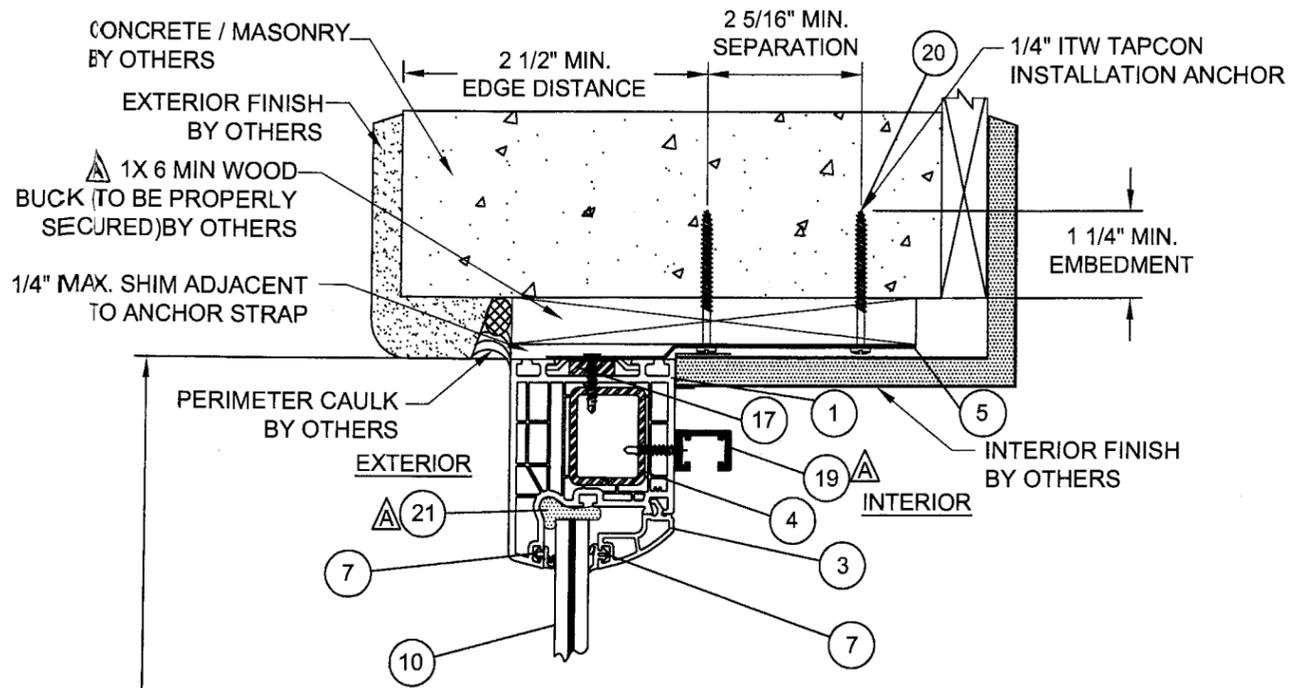


F VERTICAL SECTION
FIXED PANEL

MAX. FRAME / UNIT HEIGHT 95 3/4"

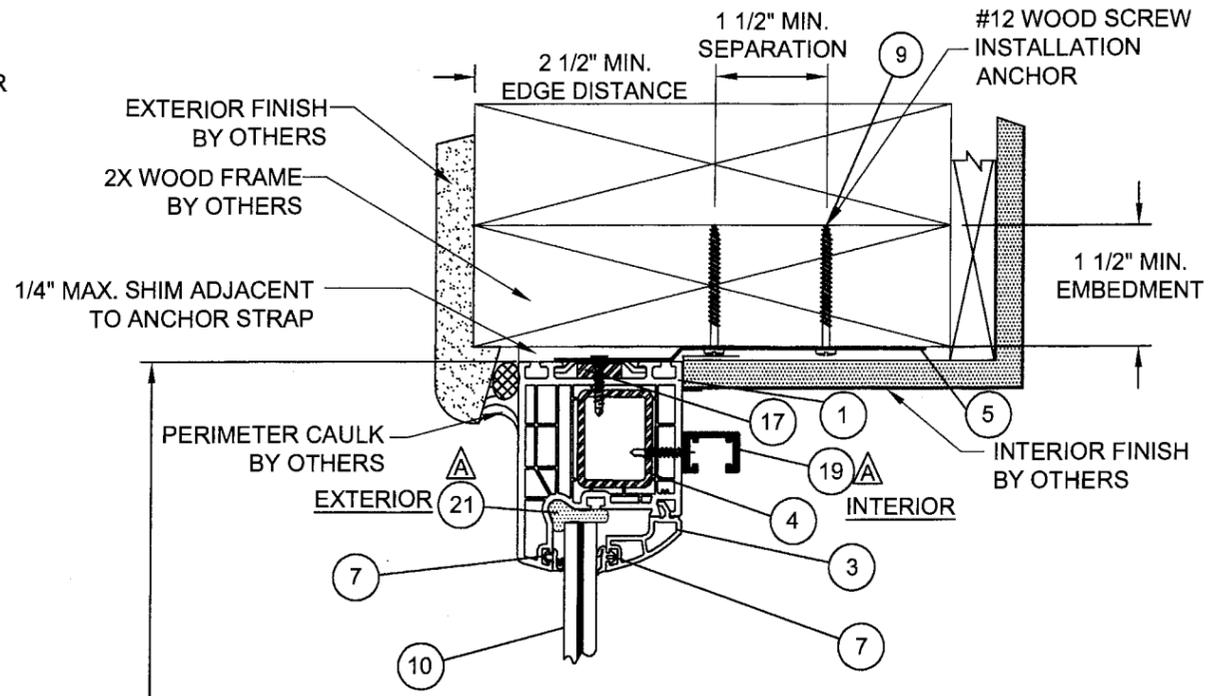


H VERTICAL SECTION
FIXED PANEL

MAX. FRAME / UNIT HEIGHT 95 3/4"

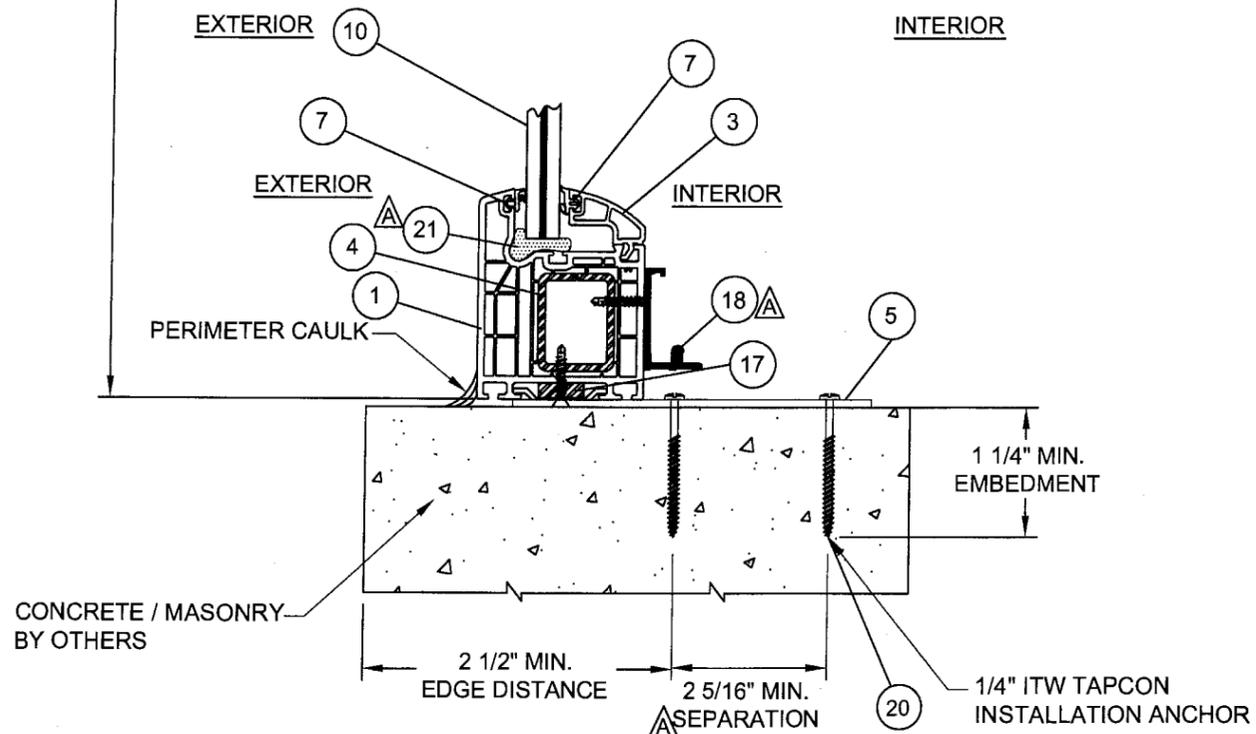

E VERTICAL SECTION
FIXED PANEL

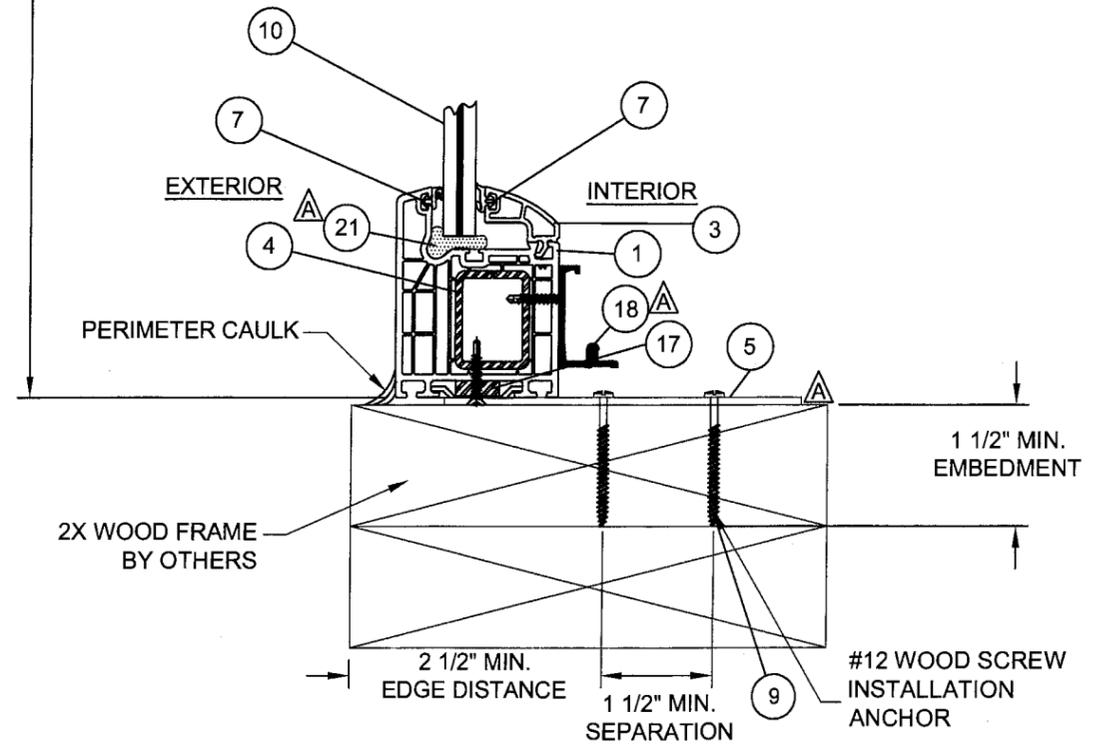

G VERTICAL SECTION
FIXED PANEL



DATE:	02/10/08
APPROVED BY:	PAUL WINTER
PER MIAMI DADE COMMENTS	11/16/08
REV	A
DESCRIPTION	
DATE	02/11/09
BY	SMC

TEEM USA	DATE:	10/07/08	
418 N. SEAGRAVE ST., C	DRAWN BY:	CB	
DAYTONA BEACH, FL. 32114	SCALE:	N.T.S.	
TITLE:	CORONA 70 SERIES TILT & SLIDE DOOR - L.M.I. VERTICAL SECTIONS	DRAWING NO.:	TEEM0005
		REV:	A
		SHEET:	4 OF 8




PROJECT #307-0308
 Paul E. Winter
 Florida P.E. No. 22983
 PTC, LLC
 1535 Cugsweil Street, Suite C25
 Rockledge, Florida 32355
 FBPE Certificate of Authorization NO. 25935


Approved as complying with the Florida Building Code
 Date July 01, 2009
 NOA# 08-1015-06
 Miami Dade Product Control Division
 By Ishag Chanda

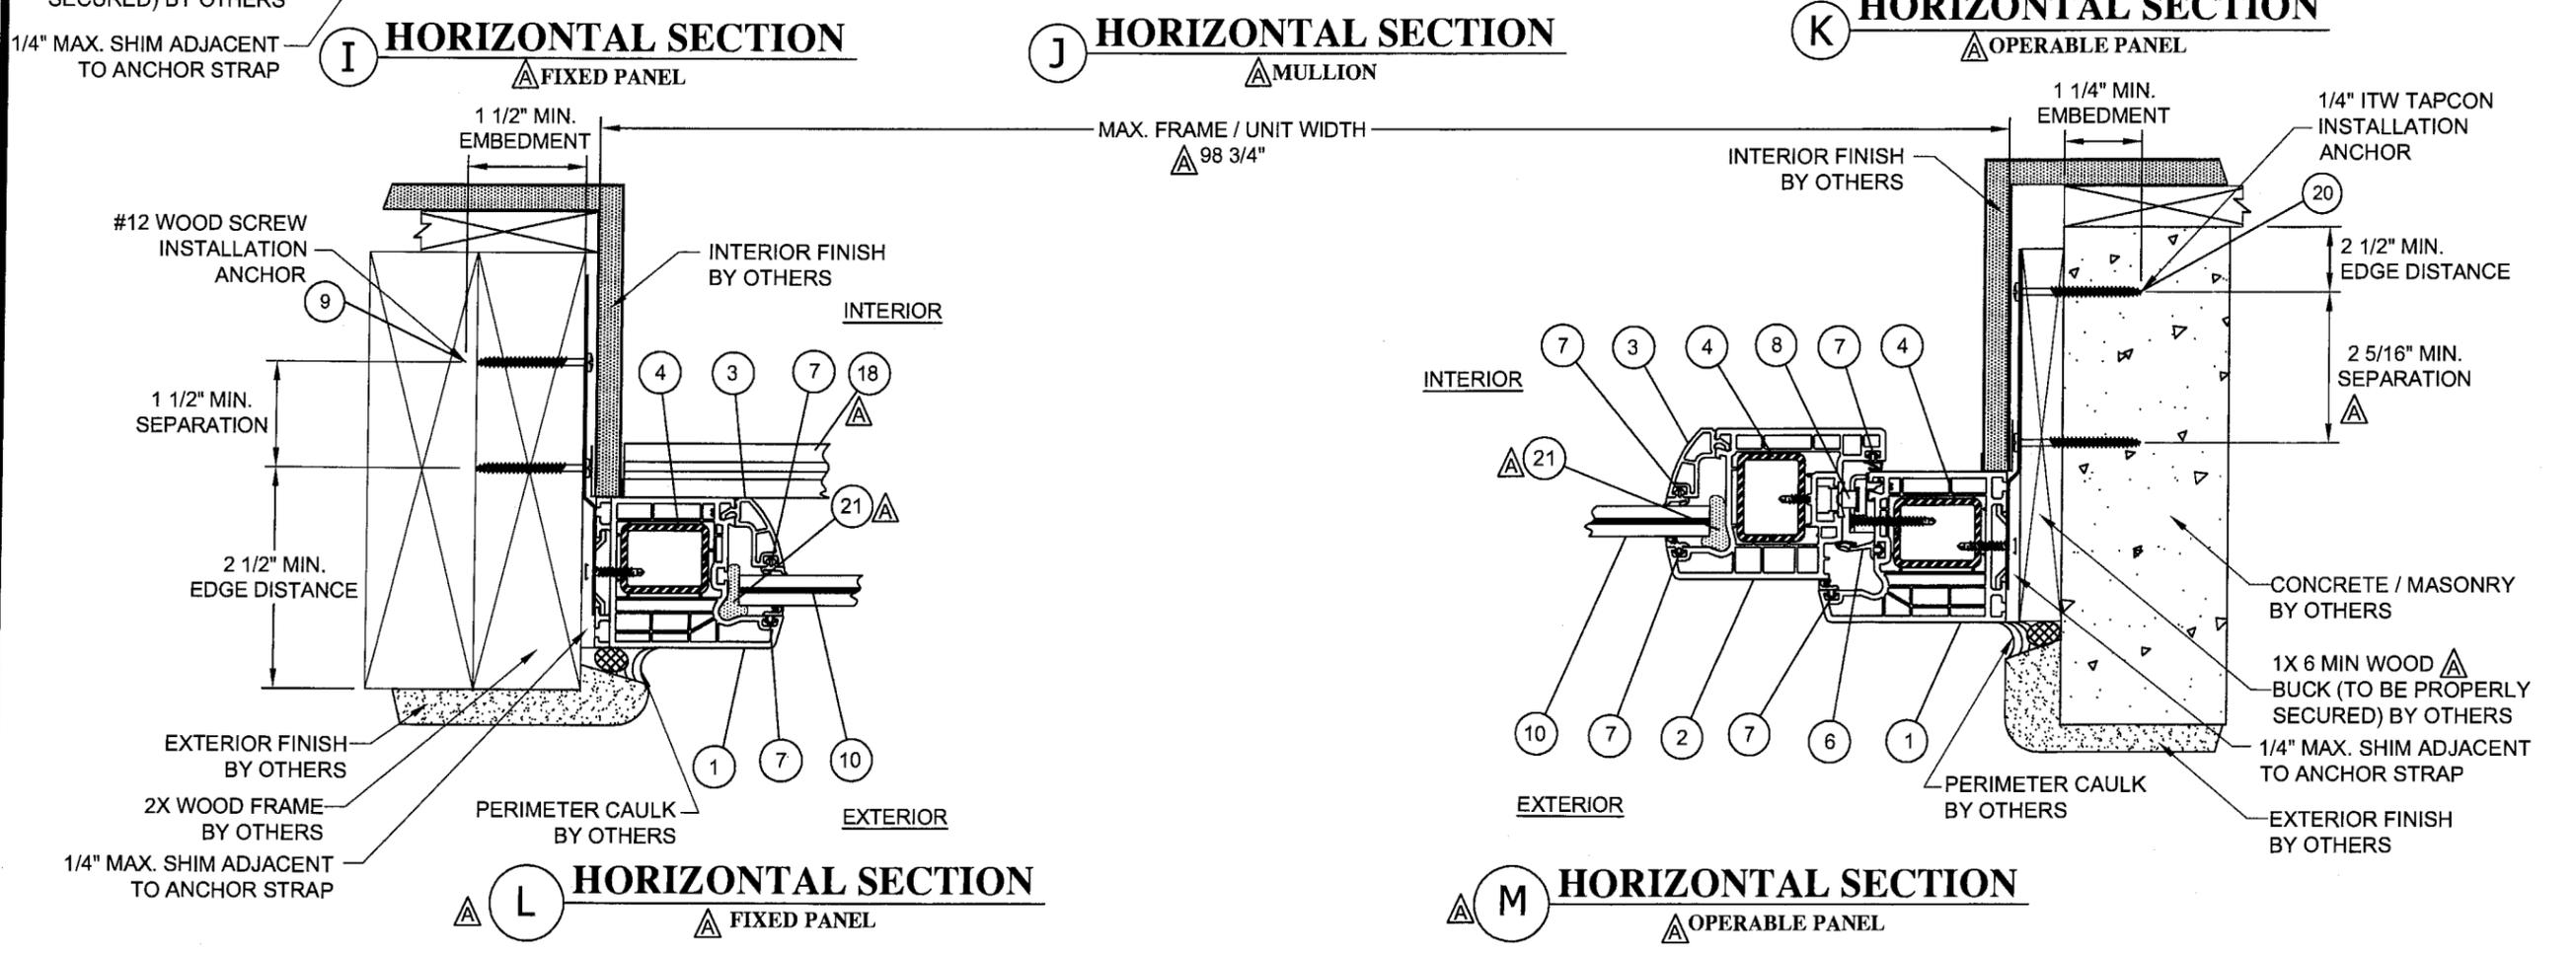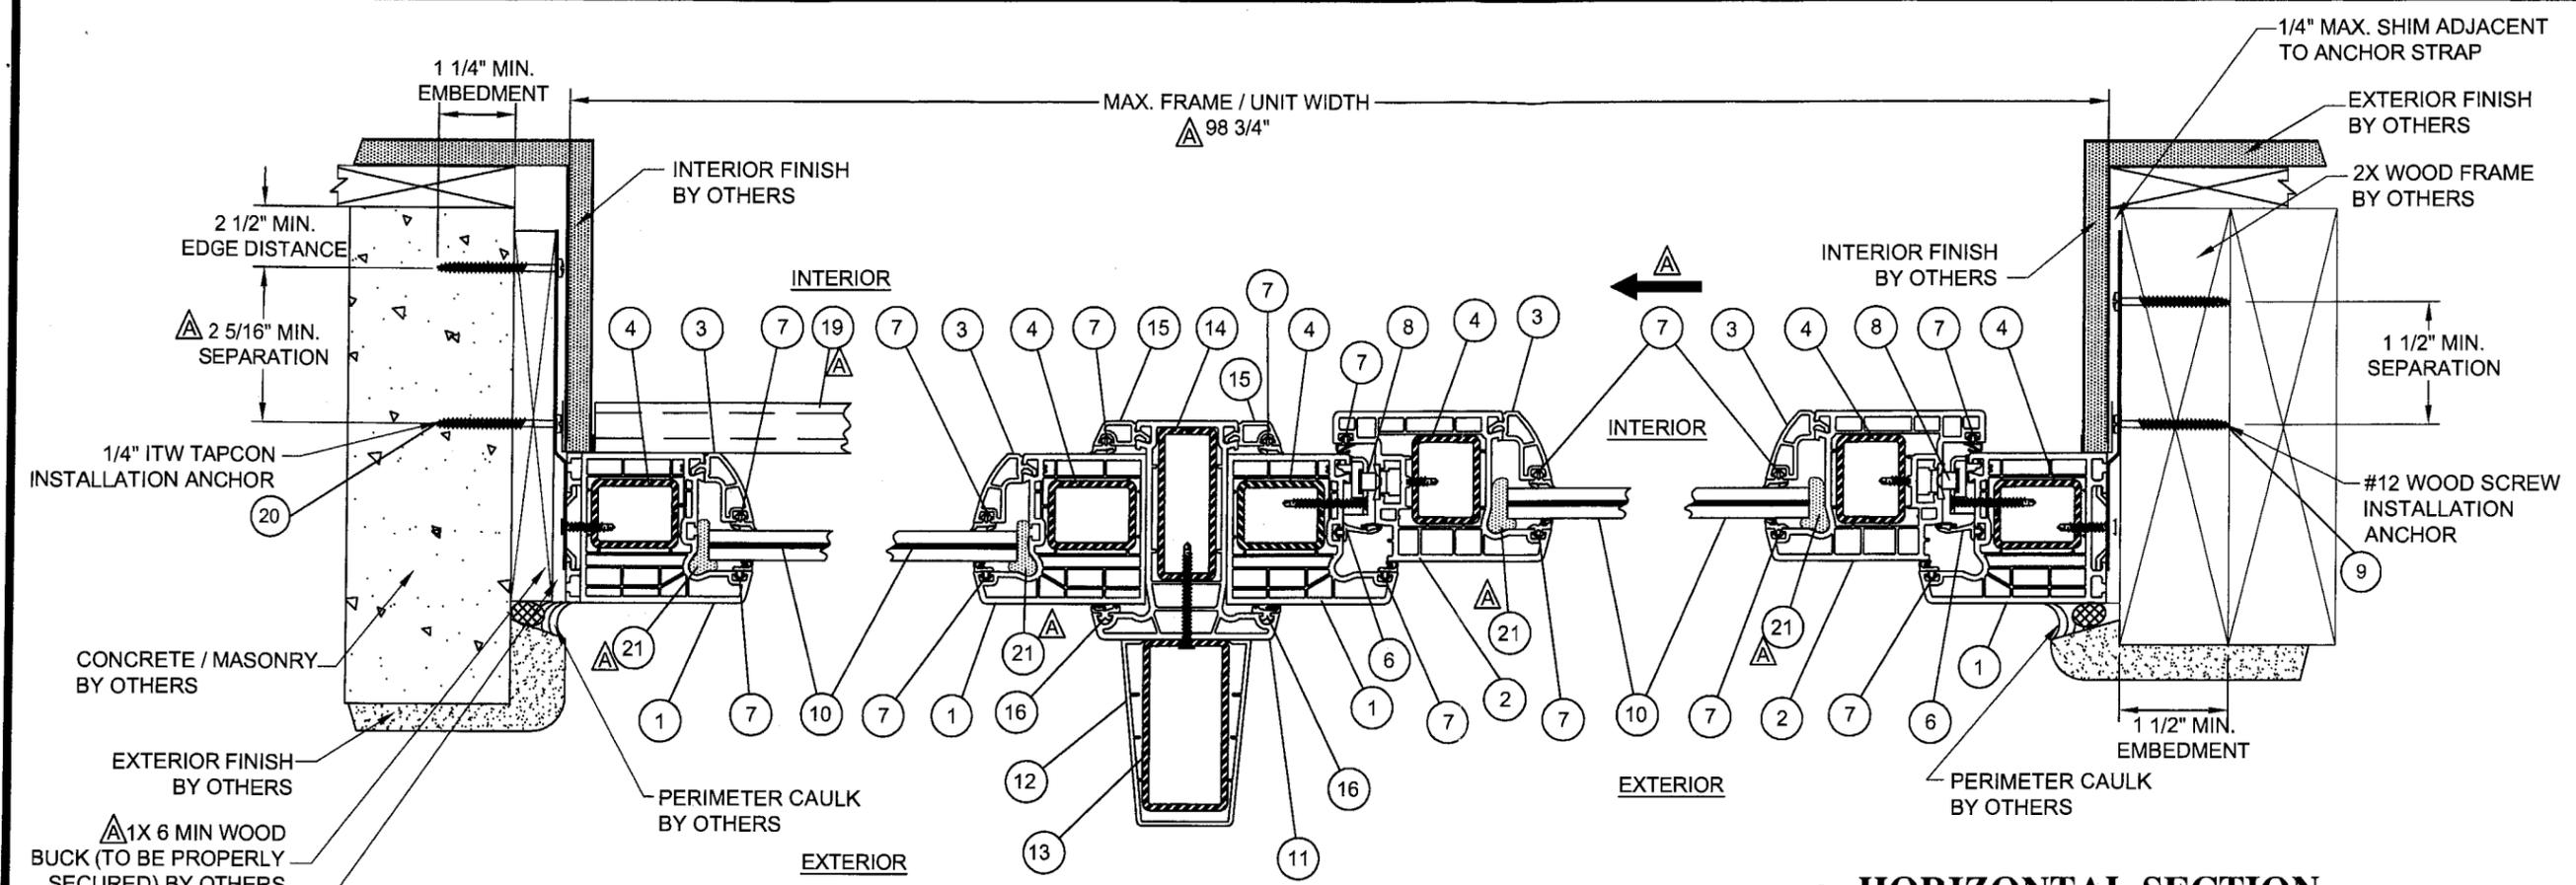

DATE: 02/10/09	APPROVED BY: PAUL WINTER	PER MIAMI DADE COMMENTS 11/16/08	SMC 02/11/09	BY
				DATE
				DESCRIPTION
TEEM USA	DATE: 10/07/08	DRAWING NO.: TEEM0005	SHEET: 5 OF 8	
418 N. SEAGRAVE ST., C DAYTONA BEACH, FL. 32114	SCALE: N.T.S.	REV: A		
TITLE: CORONA 70 SERIES TILT & SLIDE DOOR - L.M.I. HORIZONTAL SECTIONS	PREPARED BY: PTC, LLC	PHONE: 321.690.1788	FAX: 321.690.1789	
PROJECT #307-0308	Paul E. Winter Florida P.E. No. 22606	PTC, LLC 1535 Cogswell Street, Suite C25 Rockledge, Florida 32955	FBPE Certificate of Authorization No. 25935	
Approved as complying with the Florida Building Code Date: July 01, 2009 NOA# 08-7015-06 Miami Dade Product Control Division By: [Signature]				

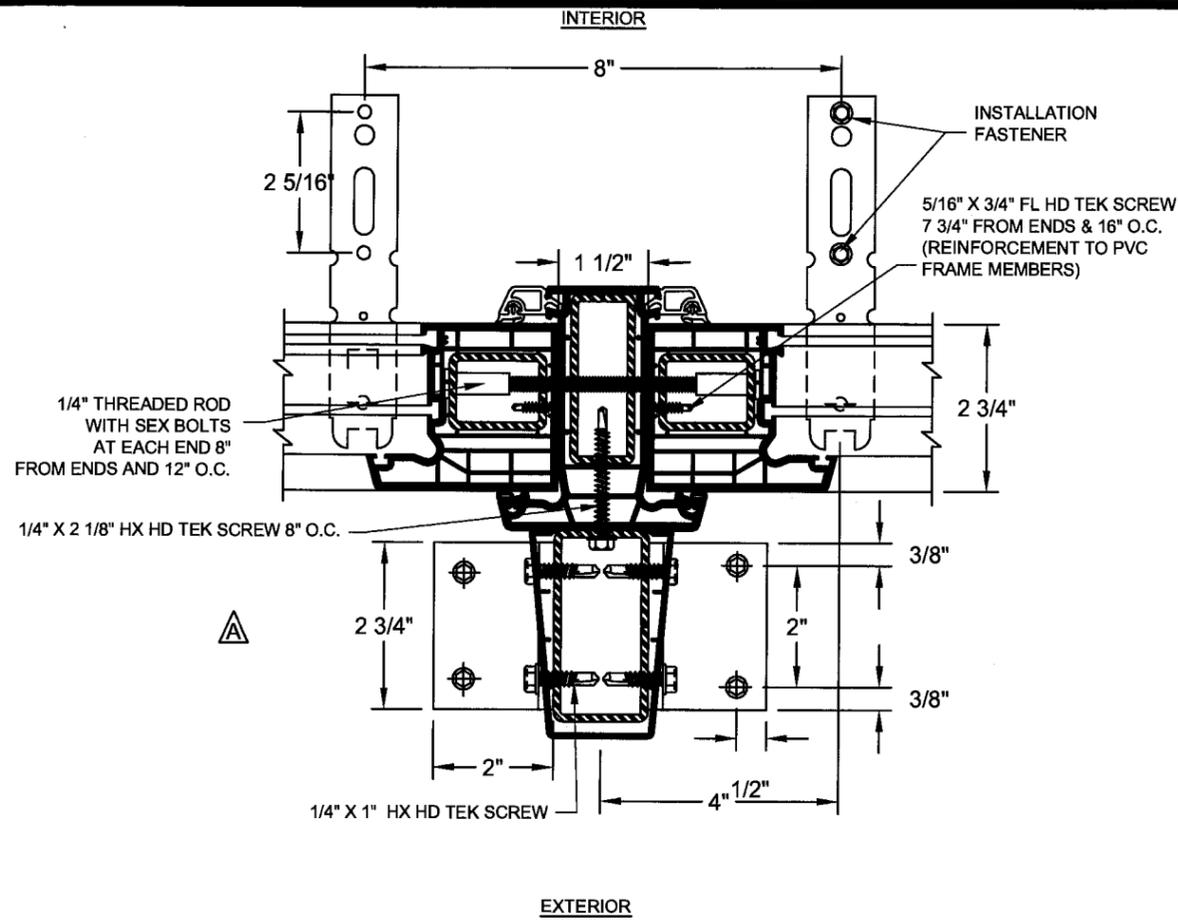

(N) HORIZONTAL SECTION
@ MULLION CLIP (TYP. BOTH ENDS)

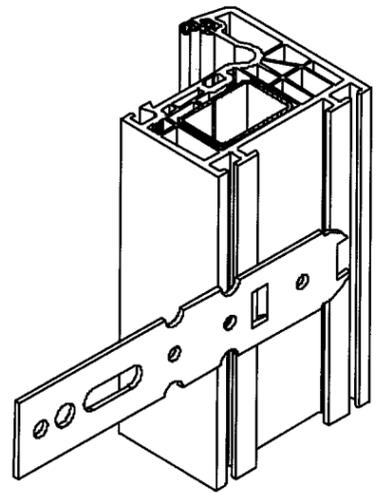


ANCHOR STRAP DETAIL

BILL OF MATERIALS

ITEM #	DESCRIPTION	MATERIAL	SUPPLIER
1	FRAME	WHITE PVC Δ	SCHUCO
2	SASH	WHITE PVC Δ	SCHUCO
3	GLAZING BEAD	WHITE PVC Δ	SCHUCO
4	REINFORCEMENT	GALVANIZED STEEL *	SCHUCO
5	ANCHOR STRAP	GALVANIZED STEEL *	SCHUCO
6	FRAME VINYL FLAP	VINYL Δ	SCHUCO
7	WEATHER STRIPPING	VINYL Δ	SCHUCO
8	TILT & SLIDE LOCK ASSEMBLY		SCHUCO
9	#12 WOOD SCREW W/ 1 1/2" MIN. EMBEDMENT		N/A
10	9/16" O.A. LAMINATED GLASS CONSISTING OF: 1/4" HEAT STRENGTHENED GLASS, 0.090" LAMINATE BY CENTRY GLASS PLUS, 1/4" HEAT STRENGTHENED GLASS		N/A
11	MULLION	WHITE PVC Δ	SCHUCO
12	MULLION COVER	WHITE PVC Δ	SCHUCO
13	EXTERIOR MULLION REINFORCEMENT	GALVANIZED STEEL *	SCHUCO
14	INTERIOR MULLION REINFORCEMENT	GALVANIZED STEEL *	SCHUCO
15	MULLION SNAP IN BEAD	WHITE PVC Δ	SCHUCO
16	MULLION BEAD GLASS STOP	WHITE PVC Δ	SCHUCO
17	HEAD & SILL REINFORCEMENT BAR	GALVANIZED STEEL	NA
18	TILT AND SLIDE BOTTOM TRACK	ALUMINUM	SCHUCO
19	TILT AND SLIDE TOP TRACK	ALUMINUM	SCHUCO
20	1/4" ITW TAPCON W/ 1 1/4" EMBEDMENT		N/A
Δ 21	SILICONE BACK BEDDING COMPOUND	SILICONE	N/A

NOTE: ALL GALVANIZED STEEL IS DIN 10142 (Fy MIN. 33,400 PSI) Δ

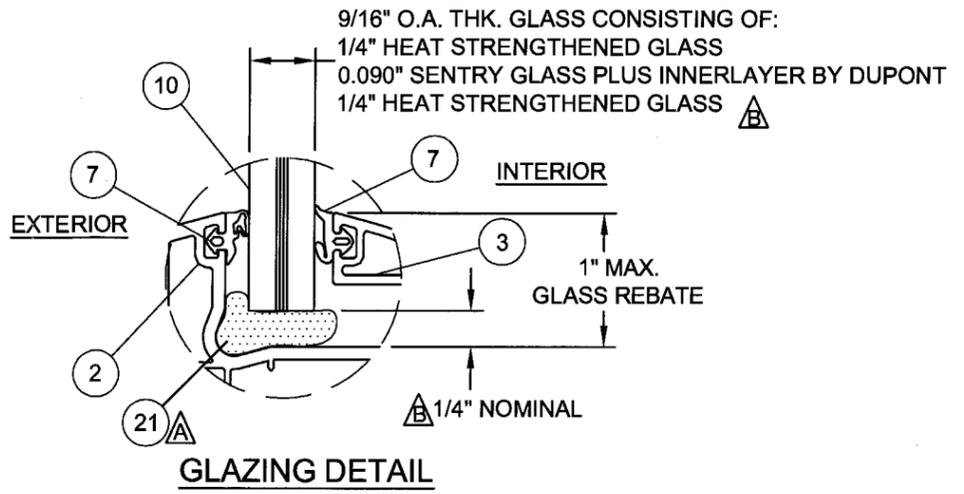

GLAZING DETAIL

DATE: 02/10/09

APPROVED BY: PAUL WINTER

PER MIAMI DADE COMMENTS 03/19/09	BB	06/03/09
PER MIAMI DADE COMMENTS 11/16/08	A	02/11/09
REV	DESCRIPTION	DATE

TEEM USA
418 N. SEAGRAVE ST., C
DAYTONA BEACH, FL. 32114

TITLE: CORONA 70 SERIES TILT & SLIDE DOOR - L.M.I.
HORIZONTAL SECT., BOM, ANCHOR STRAP & GLAZING DETAIL

DATE: 10/07/08
DRAWING NO.: TEEM0005
SHEET: 6 OF 8

DRAWN BY: CB
SCALE: N.T.S.
REV: B














PREPARED BY: PTC, LLC
Phone 321.680.1788 Fax 321.680.1788

PROJECT #307-C308
Paul E. Winter
Florida P.E. No. 22384

PTC, LLC
1535 Cogswell Street, Suite C-25
Rockledge, Florida 32955
FBPE Certificate of Authorization NO. 25935

Approved as complying with the
Florida Building Code
Date July 01, 2009
NOA# 08-1015-06
Miami Dade Product Control
Division
By Shag J. Chaudhry

COMPONENTS

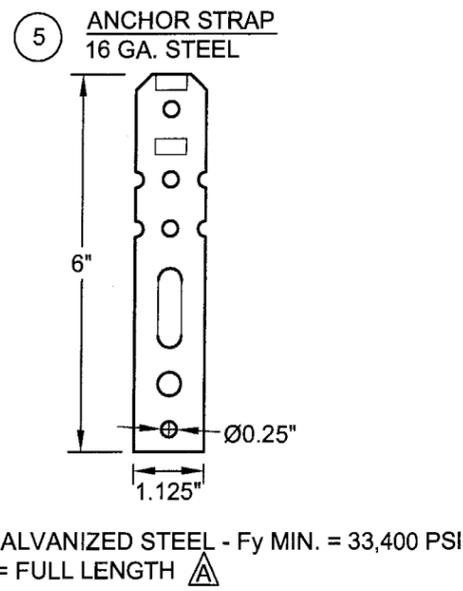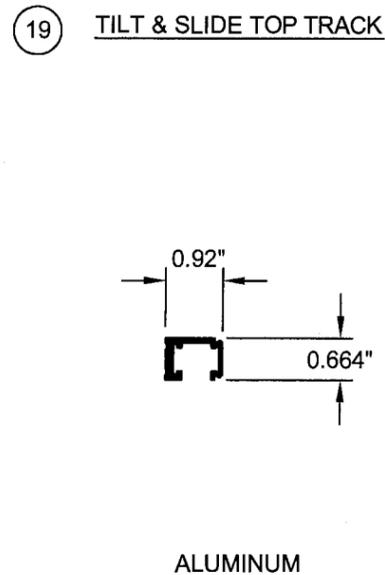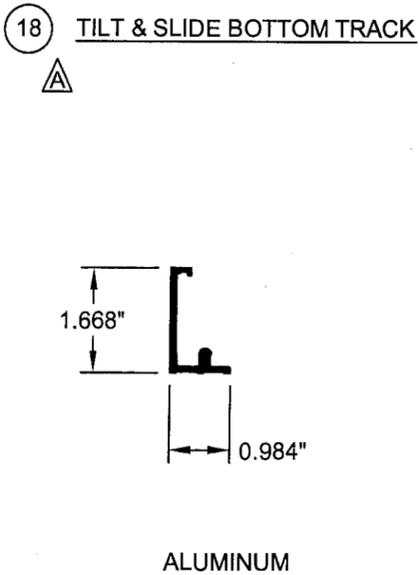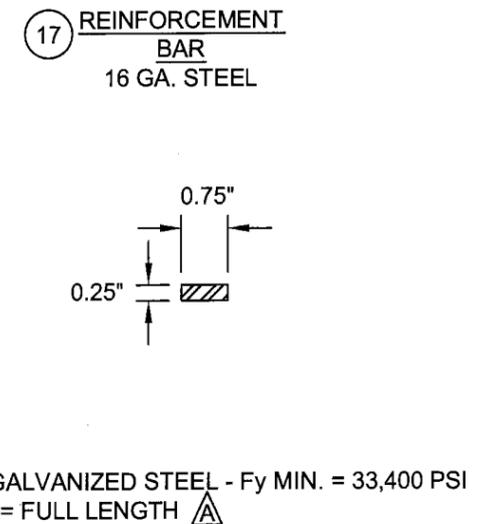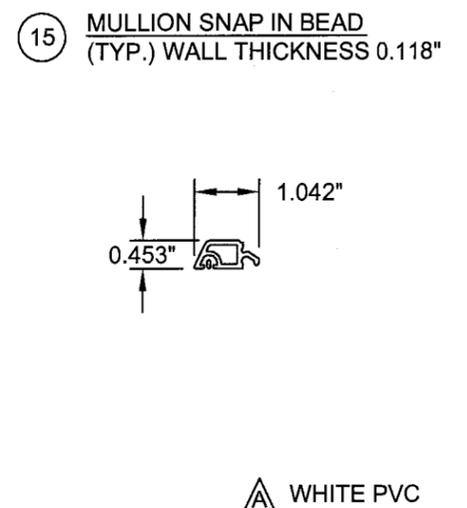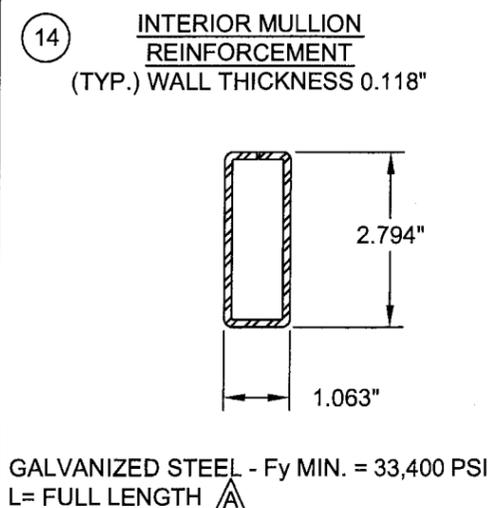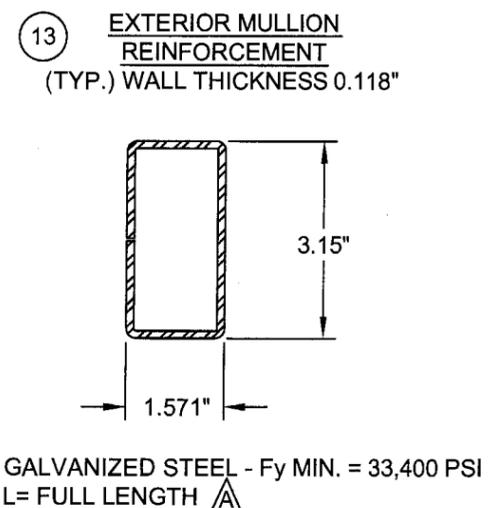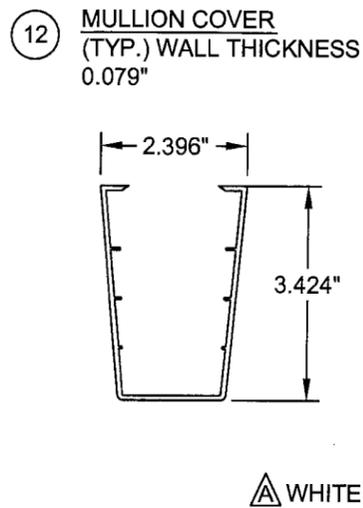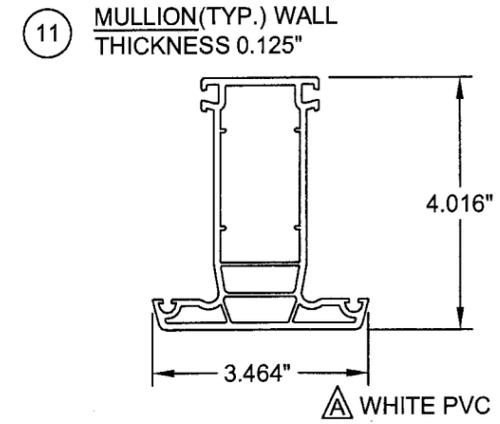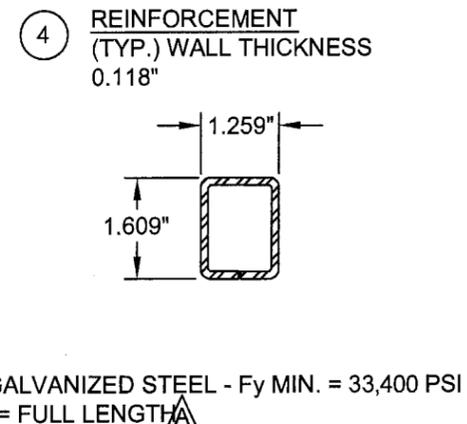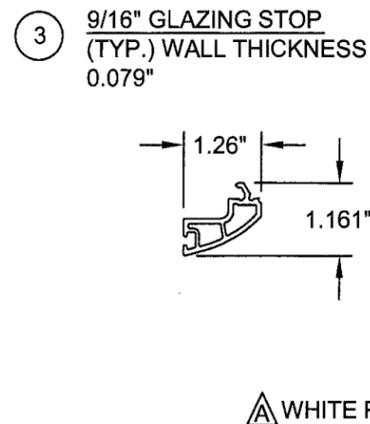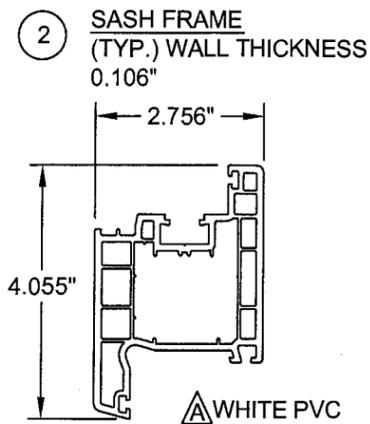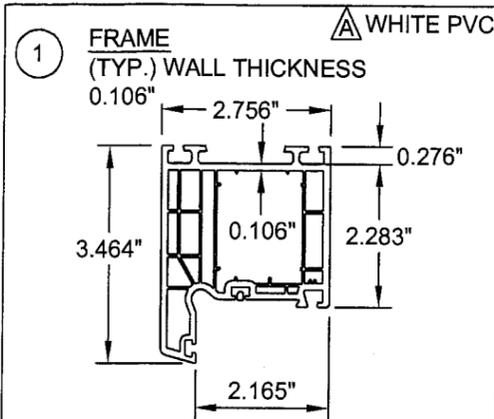

DATE:	02/10/09
APPROVED BY:	PAUL WINTER
PER MIAMI DADE COMMENTS	11/16/08
REV	A
DESCRIPTION	PER MIAMI DADE COMMENTS
DATE	02/11/09
BY	SMC

TEEM USA
418 N. SEAGRAVE ST., C
DAYTONA BEACH, FL. 32114

TITLE: CORONA 70 SERIES TILT & SLIDE DOOR - L.M.I.
COMPONENTS

DRAWN BY: CB DATE: 10/07/08
SCALE: N.T.S. DRAWING NO.: TEEM0005
REV: A SHEET: 7 OF 8


PREPARED BY: **PTE**
PTC, LLC
Phone 321.690.1788 Fax 321.690.1789

PROJECT #307-0308
Paul E. Winter
Florida E.I. No. 22693

1535 Cogswell Street, Suite C25
Rockledge, Florida 32955
FBPE Certificate of Authorization NO. 25935

DATE: 02/13/09

Approved as complying with the
Florida Building Code
Date: July 01, 2009
NOA# 08-1015-06
Miami Dade Product Control
Division
By: *Sheryl L. ...*

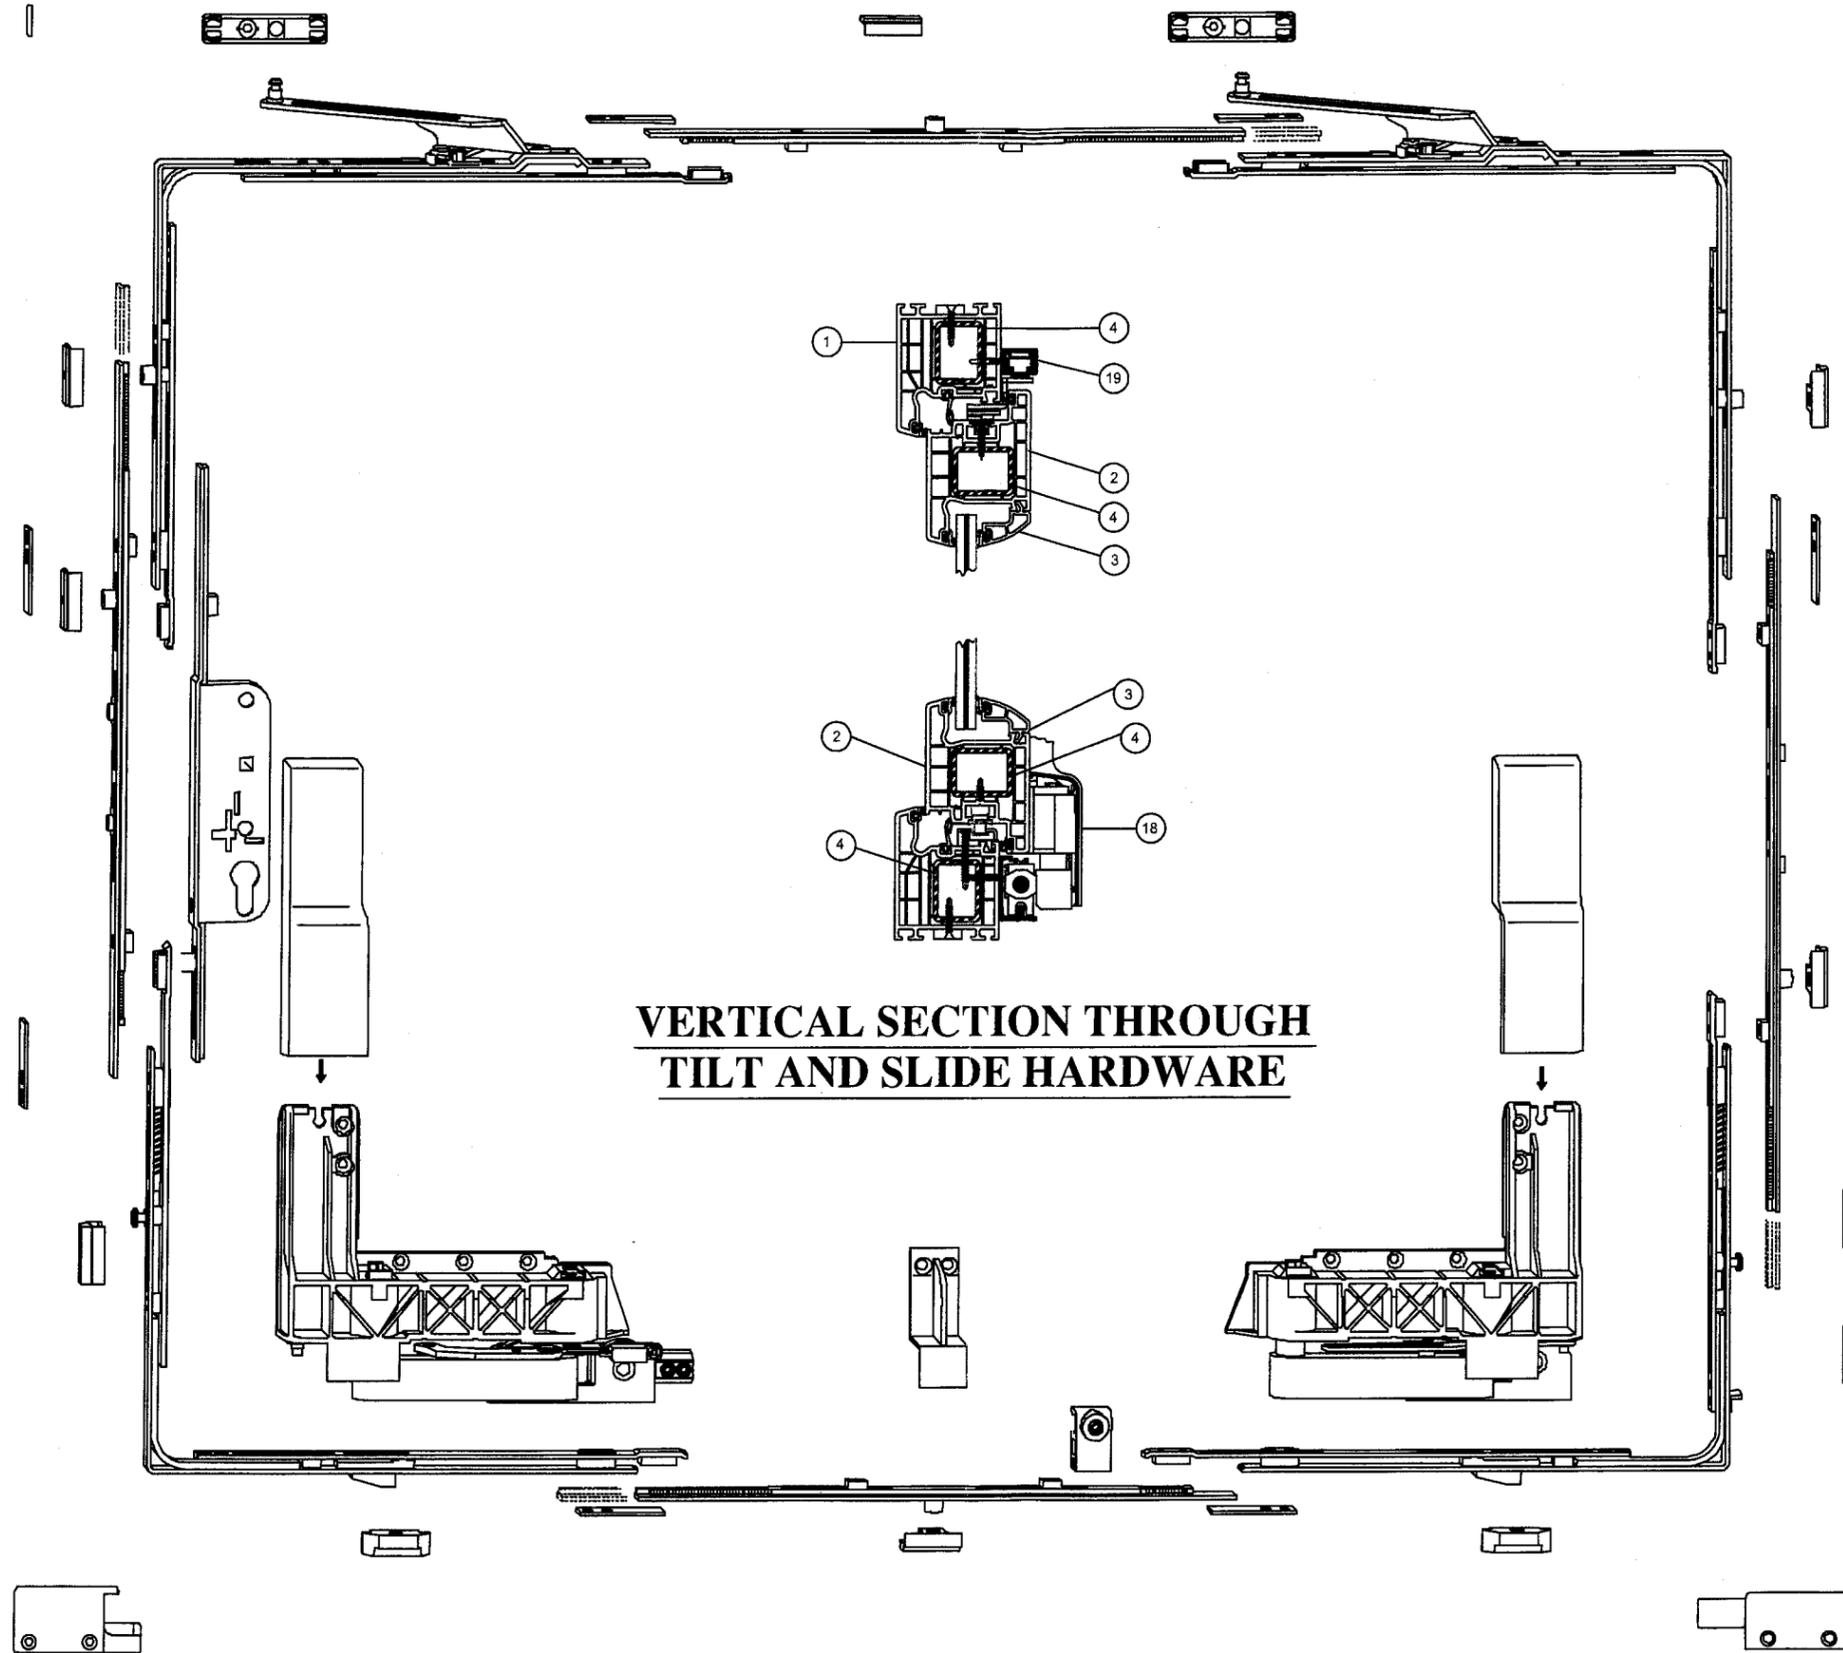

**VERTICAL SECTION THROUGH
TILT AND SLIDE HARDWARE**

**ELEVATION VIEW OF
TILT AND SLIDE HARDWARE**

PROJECT #207-0308

Paul E. Winter
Florida P.E. No. 22893

[Signature]
PTC, LLC
1535 Cogswell Street, Suite C25
Rockledge, Florida 32355
FBPE Certificate of Authorization NO. 25935

Approved as complying with the
Florida Building Code
Date July 01, 2009
NOA# 09-1015-06
Miami Dade Product Control
Division
By Ishaq I. Chauhan

TEEM USA
418 N. SEAGRAVE ST., C
DAYTONA BEACH, FL. 32114

TITLE: CORONA 70 SERIES TILT & SLIDE DOOR - L.M.I.
LIFT AND SLIDE HARDWARE

PREPARED BY: PTC, LLC
Phone 321.690.1788 Fax 321.690.1789

DATE: 10/07/08
DRAWING NO.: TEEM0005
SHEET: 8 OF 8

SCALE: N.T.S.
REV: -

REV	DESCRIPTION	DATE	BY

APPROVED BY: PAUL WINTER
DATE: 02/10/08