



**MIAMI-DADE COUNTY**  
**BUILDING CODE COMPLIANCE OFFICE (BCCO)**  
**PRODUCT CONTROL DIVISION**

**MIAMI-DADE COUNTY, FLORIDA**  
**METRO-DADE FLAGLER BUILDING**  
**140 WEST FLAGLER STREET, SUITE 1603**  
**MIAMI, FLORIDA 33130-1563**  
**(305) 375-2901 FAX (305) 372-6339**

**NOTICE OF ACCEPTANCE (NOA)**

[www.miamidade.gov/buildingcode](http://www.miamidade.gov/buildingcode)

**Regency Plus, Inc.**  
**1024 Locust Gap Highway**  
**Mt. Camel, PA 17851**

**SCOPE:**

This NOA is being issued under the applicable rules and regulations governing the use of construction materials. The documentation submitted has been reviewed by Miami-Dade County Product Control Division and accepted by the Board of Rules and Appeals (BORA) to be used in Miami Dade County and other areas where allowed by the Authority Having Jurisdiction (AHJ).

This NOA shall not be valid after the expiration date stated below. The Miami-Dade County Product Control Division (In Miami Dade County) and/or the AHJ (in areas other than Miami Dade County) reserve the right to have this product or material tested for quality assurance purposes. If this product or material fails to perform in the accepted manner, the manufacturer will incur the expense of such testing and the AHJ may immediately revoke, modify, or suspend the use of such product or material within their jurisdiction. BORA reserves the right to revoke this acceptance, if it is determined by Miami-Dade County Product Control Division that this product or material fails to meet the requirements of the applicable building code. This product is approved as described herein, and has been designed to comply with the Florida Building Code, including the High Velocity Hurricane Zone.

**DESCRIPTION: Series "5205 Vinyl" Outswing White PVC Casement Window – L.M.I.**

**APPROVAL DOCUMENT:** Drawing No. **RPLS0061**, titled "Series 5205 Vinyl Impact Casement Window – LMI", sheets 1 through 5 of 5, dated 10/14/08 with revision "D" dated 04/01/09, prepared by PTC, LLC, signed and sealed by Paul E. Winter, P. E., bearing the Miami-Dade County Product Control Approval stamp with the Notice of Acceptance number and Approval date by the Miami-Dade County Product Control Division.

**MISSILE IMPACT RATING: Large and Small Missile Impact Resistant**

**LABELING:** Each unit shall bear a permanent label with the manufacturer's name or logo, city, state and following statement: "Miami-Dade County Product Control Approved", unless otherwise noted herein.

**RENEWAL** of this NOA shall be considered after a renewal application has been filed and there has been no change in the applicable building code negatively affecting the performance of this product.

**TERMINATION** of this NOA will occur after the expiration date or if there has been a revision or change in the materials, use, and/or manufacture of the product or process. Misuse of this NOA as an endorsement of any product, for sales, advertising or any other purposes shall automatically terminate this NOA. Failure to comply with any section of this NOA shall be cause for termination and removal of NOA.

**ADVERTISEMENT:** The NOA number preceded by the words Miami-Dade County, Florida, and followed by the expiration date may be displayed in advertising literature. If any portion of the NOA is displayed, then it shall be done in its entirety.

**INSPECTION:** A copy of this entire NOA shall be provided to the user by the manufacturer or its distributors and shall be available for inspection at the job site at the request of the Building Official. This NOA consists of this page 1 and evidence pages E-1 and E-2, as well as approval document mentioned above.

The submitted documentation was reviewed by **Manuel Perez, P.E.**



**NOA No. 08-1118.10**  
**Expiration Date: May 6, 2014**  
**Approval Date: May 6, 2009**  
**Page 1**

NOTICE OF ACCEPTANCE: EVIDENCE SUBMITTED

**A. DRAWINGS**

1. Manufacturer's die drawings and sections.
2. Drawing No **RPLS0061**, titled "Series 5205 Vinyl Impact Casement Window – LMI", sheets 1 through 5 of 5, dated 10/14/08 with revision "**D**" dated 04/01/09, prepared by PTC, LLC, signed and sealed by Paul E. Winter, P. E.

**B. TESTS**

1. Test report on: 1) Air Infiltration Test, per FBC, TAS 202-94  
2) Uniform Static Air Pressure Test, Loading per FBC TAS 202-94  
3) Water Resistance Test, per FBC, TAS 202-94  
4) Large Missile Impact Test per FBC, TAS 201-94  
5) Cyclic Wind Pressure Loading per FBC, TAS 203-94  
6) Forced Entry Test, per FBC 2411 3.2.1, TAS 202-94  
along with marked-up drawings and installation diagram of series 5205 vinyl casement window, prepared by National Certified Testing Laboratories, Test Report No. **NCTL-110-11618-1**, dated 10/02/08, addendum letter I dated 10/02/08, and addendum letter II dated 01/20/09, all signed and sealed by Harold E. Rupp, P. E.

**C. CALCULATIONS**

1. Anchor verification calculations and structural analysis, complying with FBC 2007, prepared by PTC, LLC, dated 11/12/08 and 03/12/09, signed and sealed by Paul E. Winter, P. E.  
**Complies with ASTM E1300-02/ 04**

**D. QUALITY ASSURANCE**


1. Miami Dade Building Code Compliance Office (BCCO).

**E. MATERIAL CERTIFICATIONS**

1. Notice of Acceptance No. **05-1208.02** issued to E.I. DuPont DeNemours & Co., Inc. for their "**DuPont Butacite PVB, Interlayer**" dated 01/05/06, expiring on 12/11/10.
2. No. **07-1016.05**, issued to Dominion Plastics, Inc. for their Series "**White Rigid PVC Exterior Extrusions for Windows and Doors**", approved on 11/15/07 and expiring on 10/24/12.

**F. STATEMENTS**

1. Statement letter of conformance and independence, dated 02/17/09, signed and sealed by Paul E. Winter, P. E.
2. Statement letter of no financial interest, dated 02/17/09, signed and sealed by Paul E. Winter, P. E.

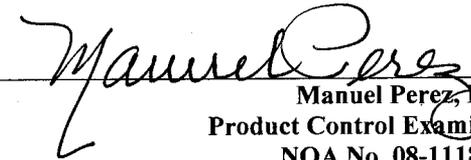  
Manuel Perez, P.E.  
Product Control Examiner  
NOA No. 08-1118.10

Expiration Date: May 6, 2014  
Approval Date: May 6, 2009

Regency Plus, Inc.


NOTICE OF ACCEPTANCE: EVIDENCE SUBMITTED

**F. STATEMENTS (CONTINUED)**

3. Laboratory compliance letter in the Test Report No. **NCTL-110-11618-1**, issued by National Certified Testing Laboratories, dated 10/02/08, signed and sealed by Harold E. Rupp, P.E.

**G. OTHERS**

1. None.

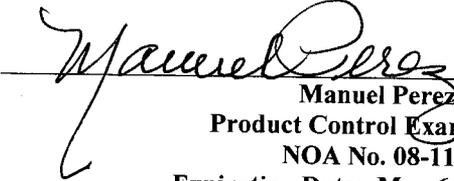  
Manuel Perez, P.E.  
Product Control Examiner  
NOA No. 08-1118.10  
Expiration Date: May 6, 2014  
Approval Date: May 6, 2009

# REGENCY PLUS, INC.

## *SERIES "5205" VINYL IMPACT CASEMENT WINDOW - LMI*

### *INSTALLATION ANCHORAGE DETAILS*

DATE: 04/01/09  
 APPROVED BY: PAUL E. WINTER

REV	DESCRIPTION	DATE	BY
D	PER MIAMI DADE COMMENTS 3/18/09	4/1/09	SMC
B	PER MIAMI DADE COMMENTS DATED 3/4/09	02/12/09	BB
A	PER MIAMI DADE COMMENTS DATED 1/7/09	02/05/09	SMC

**GENERAL NOTES:**

- THIS PRODUCT IS DESIGNED TO COMPLY WITH THE HIGH VELOCITY HURRICANE ZONE (HVHZ) OF THE 2007 FLORIDA BUILDING CODE (FBC) AT THE DESIGN PRESSURE(S) STATED HEREIN.
- THE PRODUCT DETAILS CONTAINED HEREIN ARE BASED UPON SIGNED AND SEALED TEST REPORT # NCTL-110-11618-1, DATED 10/02/08, ADDENDUM DATED 11/05/09 AND ADDENDUM II DATED 01/20/09 AND ASSOCIATED LABORATORY STAMPED DRAWINGS.
- ADEQUACY OF THE EXISTING STRUCTURAL CONCRETE / MASONRY AND 2X FRAMING AS A MAIN WIND FORCE RESISTING SYSTEM CAPABLE OF WITHSTANDING AND TRANSFERRING APPLIED PRODUCT LOADS TO THE FOUNDATION IS THE RESPONSIBILITY OF THE ENGINEER OR ARCHITECT OF RECORD AND TO BE REVIEWED BY AHJ.
- 1X AND 2X BUCKS (WHEN USED) SHALL BE DESIGNED AND ANCHORED TO PROPERLY TRANSFER ALL LOADS TO THE STRUCTURE. BUCK DESIGN AND INSTALLATION IS THE RESPONSIBILITY OF THE ENGINEER OR ARCHITECT OF RECORD AND TO BE REVIEWED BY AHJ.
- THE INSTALLATION DETAILS DESCRIBED HEREIN ARE GENERIC AND MAY NOT REFLECT ACTUAL CONDITIONS FOR A SPECIFIC SITE. IF SITE CONDITIONS CAUSE INSTALLATION TO DEVIATE FROM THE REQUIREMENTS DETAILED HEREIN, THEN THE BUILDING OFFICIAL MAY ELECT ONE OF THE FOLLOWING OPTIONS:
  - OUTSIDE HVHZ: REQUIRE THAT A LICENCED ENGINEER OR ARCHITECT PREPARE AND SUBMIT SITE SPECIFIC DOCUMENTS FOR USE WITH THIS DOCUMENT TO BE REVIEWED BY AHJ.
  - INSIDE HVHZ: REQUIRE THAT A ONE TIME SITE SPECIFIC APPROVAL BE APPLIED FOR AND OBTAINED FROM THE MIAMI-DADE COUNTY PRODUCT CONTROL DIVISION.

- IN AREAS WHERE WIND-BORNE DEBRIS PROTECTION REQUIREMENTS EXIST, USE OF AN IMPACT PROTECTIVE SYSTEM IS NOT REQUIRED.
- WINDOW FRAME MATERIAL: WHITE PVC (DOMINION PLASTICS, INC. N.O.A. 07-1016.05)
- GLASS MEETS THE REQUIREMENTS OF ASTM E1300.
- DESIGNATION "X" STANDS FOR THE FOLLOWING:  
X: OPERABLE PANEL
- A 1/3 INCREASE IN ALLOWABLE STRESS FOR WIND LOADS WAS NOT USED IN THE DESIGN OF THE PRODUCT SHOWN HEREIN. WIND LOAD DURATION FACTOR (Cd = 1.6) HAS BEEN USED FOR WOOD ANCHOR DESIGN.

**INSTALLATION NOTES:**

- ONE (1) INSTALLATION ANCHOR IS REQUIRED AT EACH ANCHOR LOCATION SHOWN.
- THE NUMBER OF INSTALLATION ANCHORS DEPICTED IS THE MINIMUM NUMBER OF ANCHORS TO BE USED FOR PRODUCT INSTALLATION.
- SHIM AS REQUIRED AT EACH INSTALLATION ANCHOR WITH LOAD BEARING SHIM(S). MAXIMUM ALLOWABLE SHIM SIZE IS 1/4 INCH. SHIM WHERE SPACE OF 1/16 INCH OR GREATER OCCURS. SHIM(S) SHALL BE CONSTRUCTED OF HIGH DENSITY PLASTIC OR BETTER.
- FOR INSTALLATION INTO WOOD FRAMING, USE #12 WOOD SCREWS OF SUFFICIENT LENGTH TO ACHIEVE 1 1/2 INCH MINIMUM EMBEDMENT. MINIMUM EDGE DISTANCE IS 7/8 INCH.
- FOR INSTALLATION THROUGH 1X BUCK TO CONCRETE / MASONRY, OR DIRECTLY INTO CONCRETE / MASONRY, USE 1/4 INCH ITW TAPCONS OF SUFFICIENT LENGTH TO ACHIEVE 1 1/4 INCH MINIMUM EMBEDMENT. MINIMUM EDGE DISTANCE IS 2-1/2 INCHES. MINIMUM CENTER TO CENTER DISTANCE IS 3 INCHES.
- MINIMUM EMBEDMENT AND EDGE DISTANCE EXCLUDE WALL FINISHES, INCLUDING BUT NOT LIMITED TO STUCCO, FOAM, BRICK VENEER AND SIDING.

- INSTALLATION ANCHORS AND ASSOCIATED HARDWARE MUST BE MADE OF CORROSION RESISTANT MATERIAL OR HAVE A CORROSION RESISTANT COATING.
- FOR CONCRETE BLOCK, DO NOT INSTALL INSTALLATION ANCHORS INTO MORTAR JOINTS. EDGE DISTANCE IS MEASURED FROM FREE EDGE OF BLOCK OR EDGE OF MORTAR JOINT INTO FACE SHELL OF BLOCK.
- INSTALLATION ANCHORS SHALL BE INSTALLED IN ACCORDANCE WITH ANCHOR MANUFACTURER'S INSTALLATION INSTRUCTIONS AND ANCHORS SHALL NOT BE USED IN SUBSTRATES WITH STRENGTHS LESS THAN THE MINIMUM STRENGTH SPECIFIED BY THE ANCHOR MANUFACTURER.
- INSTALLATION ANCHOR CAPACITIES FOR PRODUCTS HEREIN ARE BASED ON SUBSTRATE MATERIALS WITH THE FOLLOWING PROPERTIES:
  - WOOD - PRESSURE TREATED (PT) SOUTHERN YELLOW PINE. MINIMUM SPECIFIC GRAVITY OF 0.55. LUMBER MUST COMPLY WITH FBC SECTIONS 2411.3.3.3 AND 2326.2 AS TO WOOD PROTECTION.
  - CONCRETE - MINIMUM COMPRESSIVE STRENGTH OF 3192 psi AND COMPLIES WITH ACI 301, ACI 318-05 AND ACI 355.
  - MASONRY - STRENGTH CONFORMANCE TO ASTM C-90 AND ACI 530-05, GRADE N, TYPE 1 (OR GREATER).

**REGENCY PLUS, INC.**  
 1024 LOCUST GAP HIGHWAY  
 MT. CARMEL, PA 17851

TITLE: SERIES "5205" VINYL IMPACT CASEMENT WINDOW - LMI  
 GENERAL AND INSTALLATION NOTES

DATE: 10/14/08  
 DRAWING NO: RPLS0061  
 SHEET: 1 OF 5

PREPARED BY:   
 DRAWN BY: CB  
 SCALE: N.T.S.  
 REV: D

**FTC, LLC**  
 Phone 321.690.1788  
 Fax 321.690.1789


PROJECT #308-0738.21  
 Paul E. Winter  
 Florida, P.E. No. 22693

1535 r. Cogswell Street, Suite C2b  
 Rockledge, Florida 32955  
 FBPE Certificate of Authorization NO. 25935


Approved as complying with the Florida Building Code  
 Date 05/06/2009  
 NOA# 08-1118-JO  
 Miami Dade Product Control Division  
 By

TABLE OF CONTENTS		
SHEET	REV.	SHEET DESCRIPTION
1	D	GENERAL AND INSTALLATION NOTES
2	D	ELEVATIONS
3	D	VERTICAL SECTIONS
4	D	HORIZONTAL SECTIONS & GLAZING DETAIL
5	D	COMPONENTS, BILL OF MATERIALS & CORNER DETAIL

DESIGN PRESSURE RATING (PSF)	IMPACT RATING
+55.0	LMI

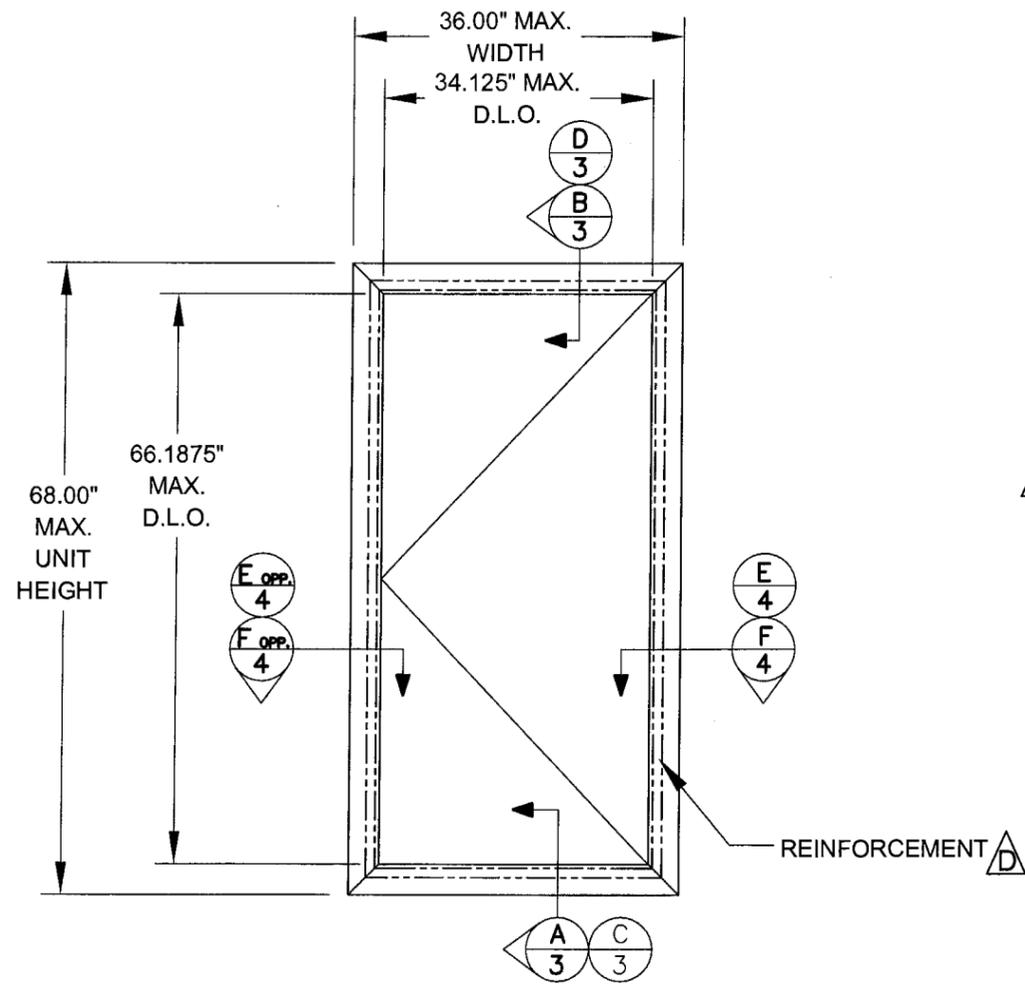

ELEVATION  
EXTERIOR VIEW

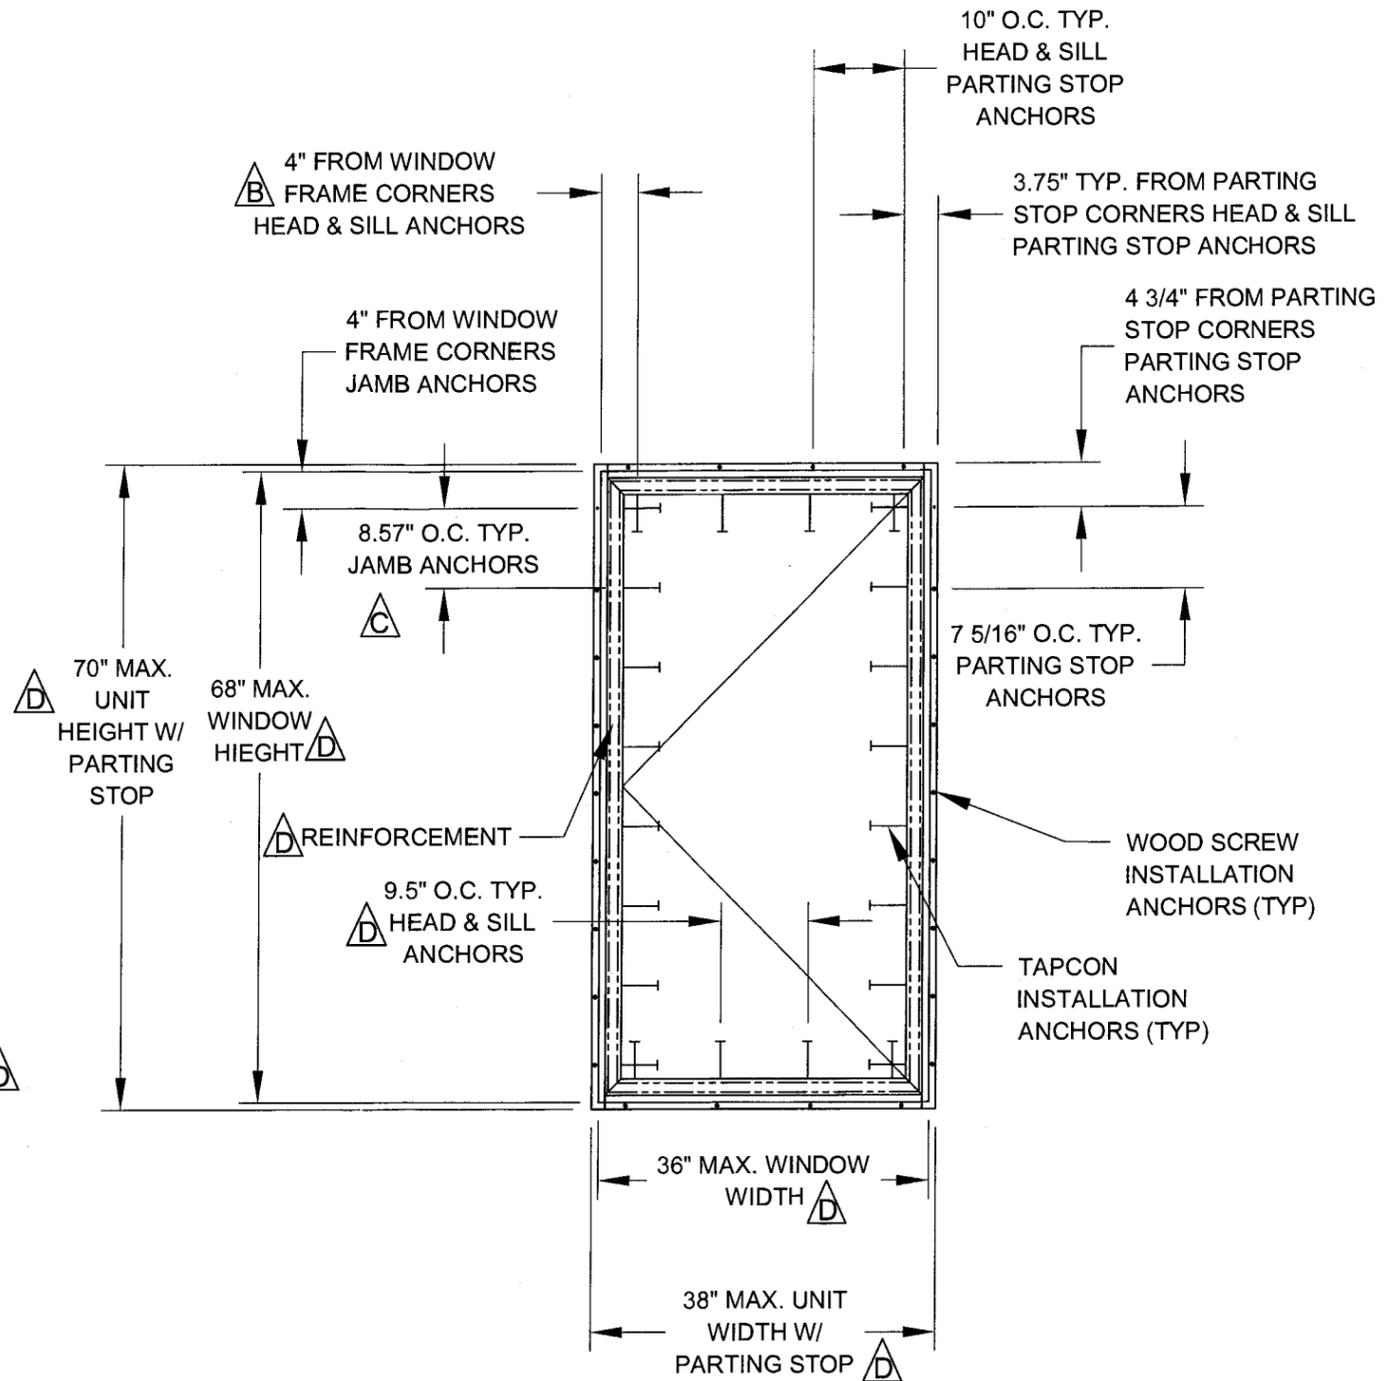

ANCHOR LAYOUT  
EXTERIOR VIEW

APPROVED BY: PAUL E. WINTER  
DATE: 04/01/09

REV	DESCRIPTION	DATE	BY
D	PER MIAMI DADE COMMENTS 3/18/09	4/1/09	SMC
C	PER MIAMI DADE COMMENTS	03/12/09	BB
B	PER MIAMI DADE COMMENTS	02/27/09	SMC
A	PER MIAMI DADE COMMENTS DATED 1/7/09	02/05/09	SMC

REGENCY PLUS, INC.  
1024 LOCUST GAP HIGHWAY  
MT. CARMEL, PA 17851



TITLE: SERIES "5205" VINYL IMPACT CASEMENT WINDOW - LMI  
ELEVATION AND ANCHOR LAYOUT

PREPARED BY:   
DATE: 10/14/08  
SCALE: N.T.S.  
SHEET: 2 OF 5

PROJECT #308-0738.21  
Paul E. Winter  
Florida P.E. No. 2693

1535 N. Gogswell Street, Suite C25  
Rockledge, Florida 32955  
FBPE Certificate of Authorization NO. 25935

Approved as complying with the  
Florida Building Code  
Date 05/06/2009  
NOA# 08-1118.10  
Miami Dade Product Control  
Division  
By

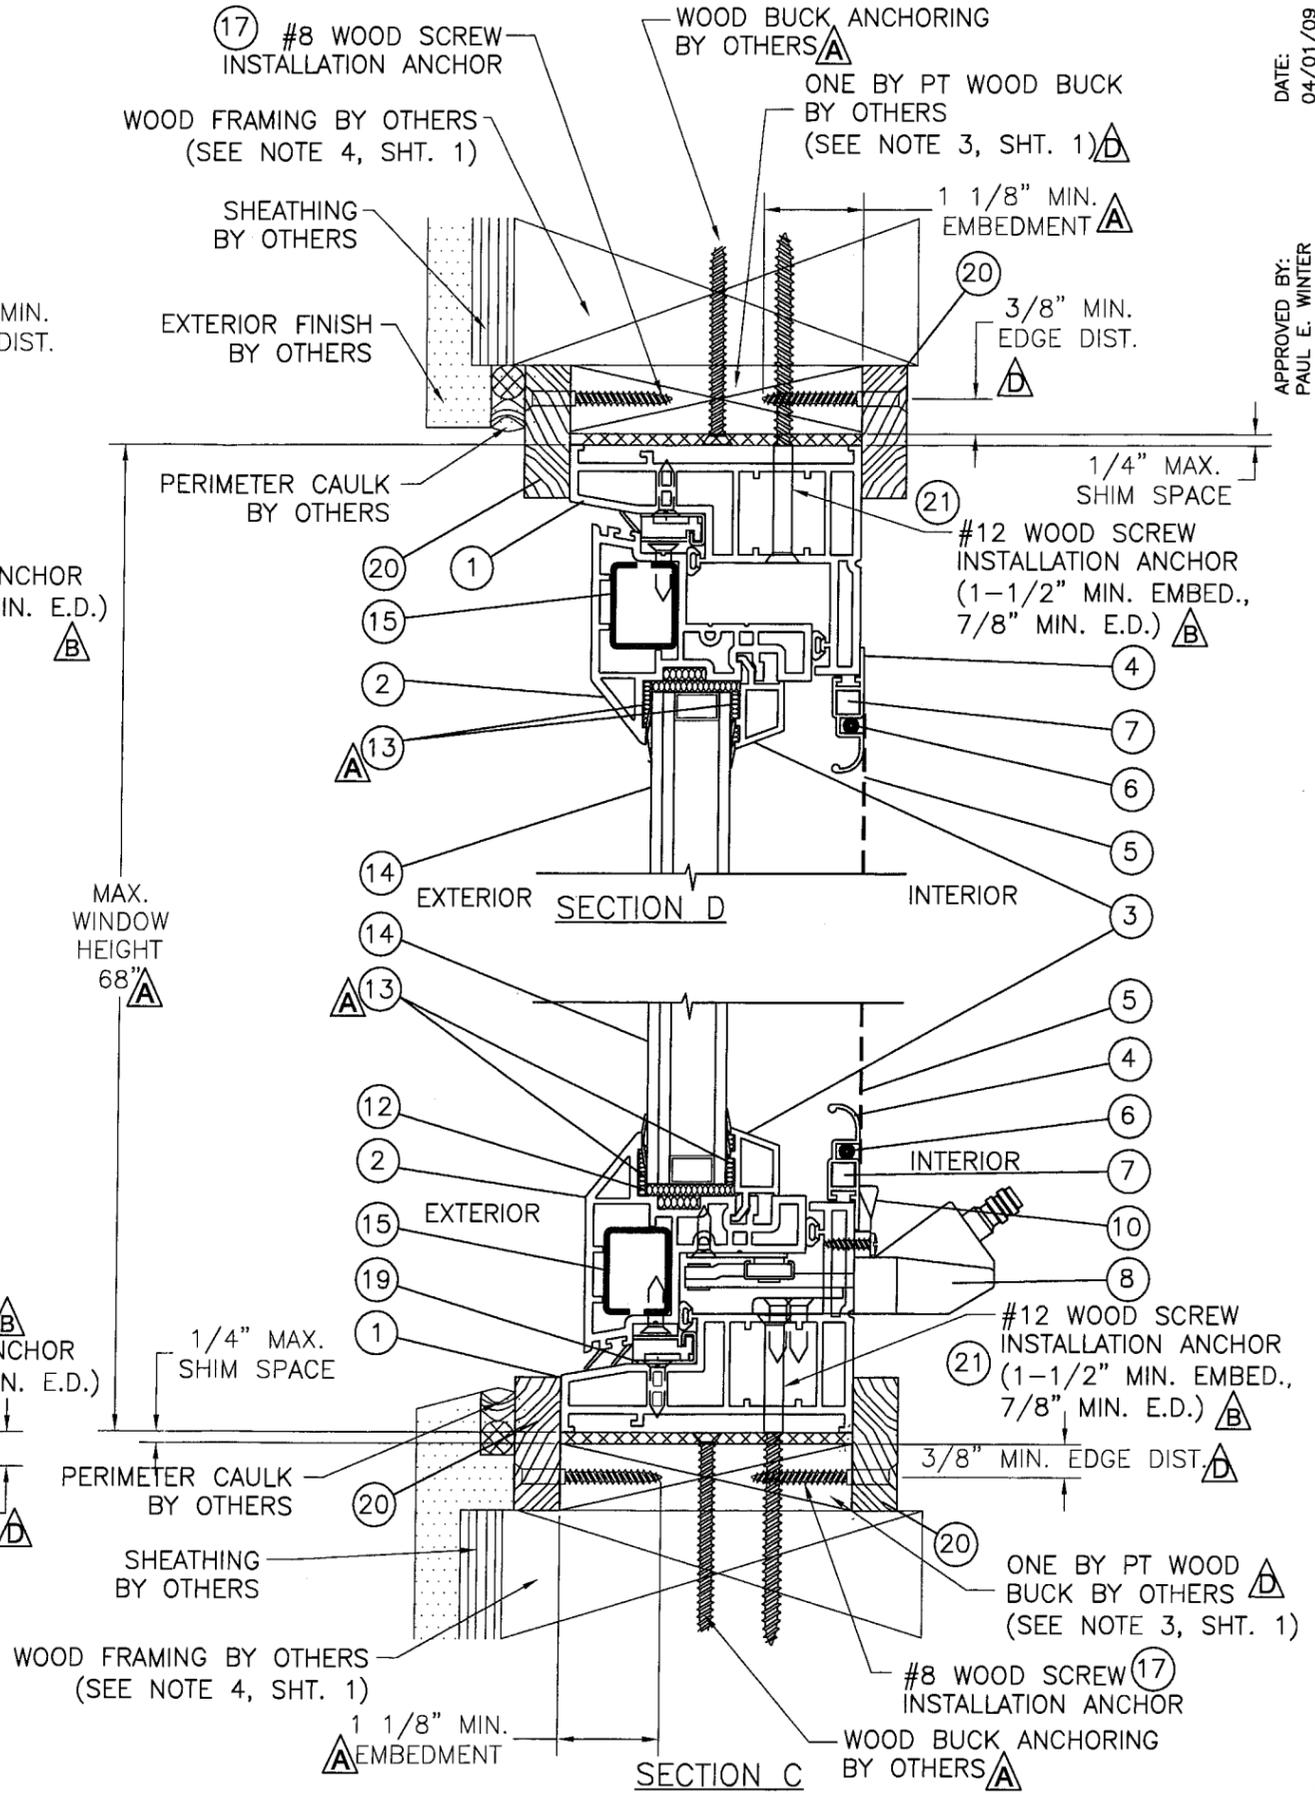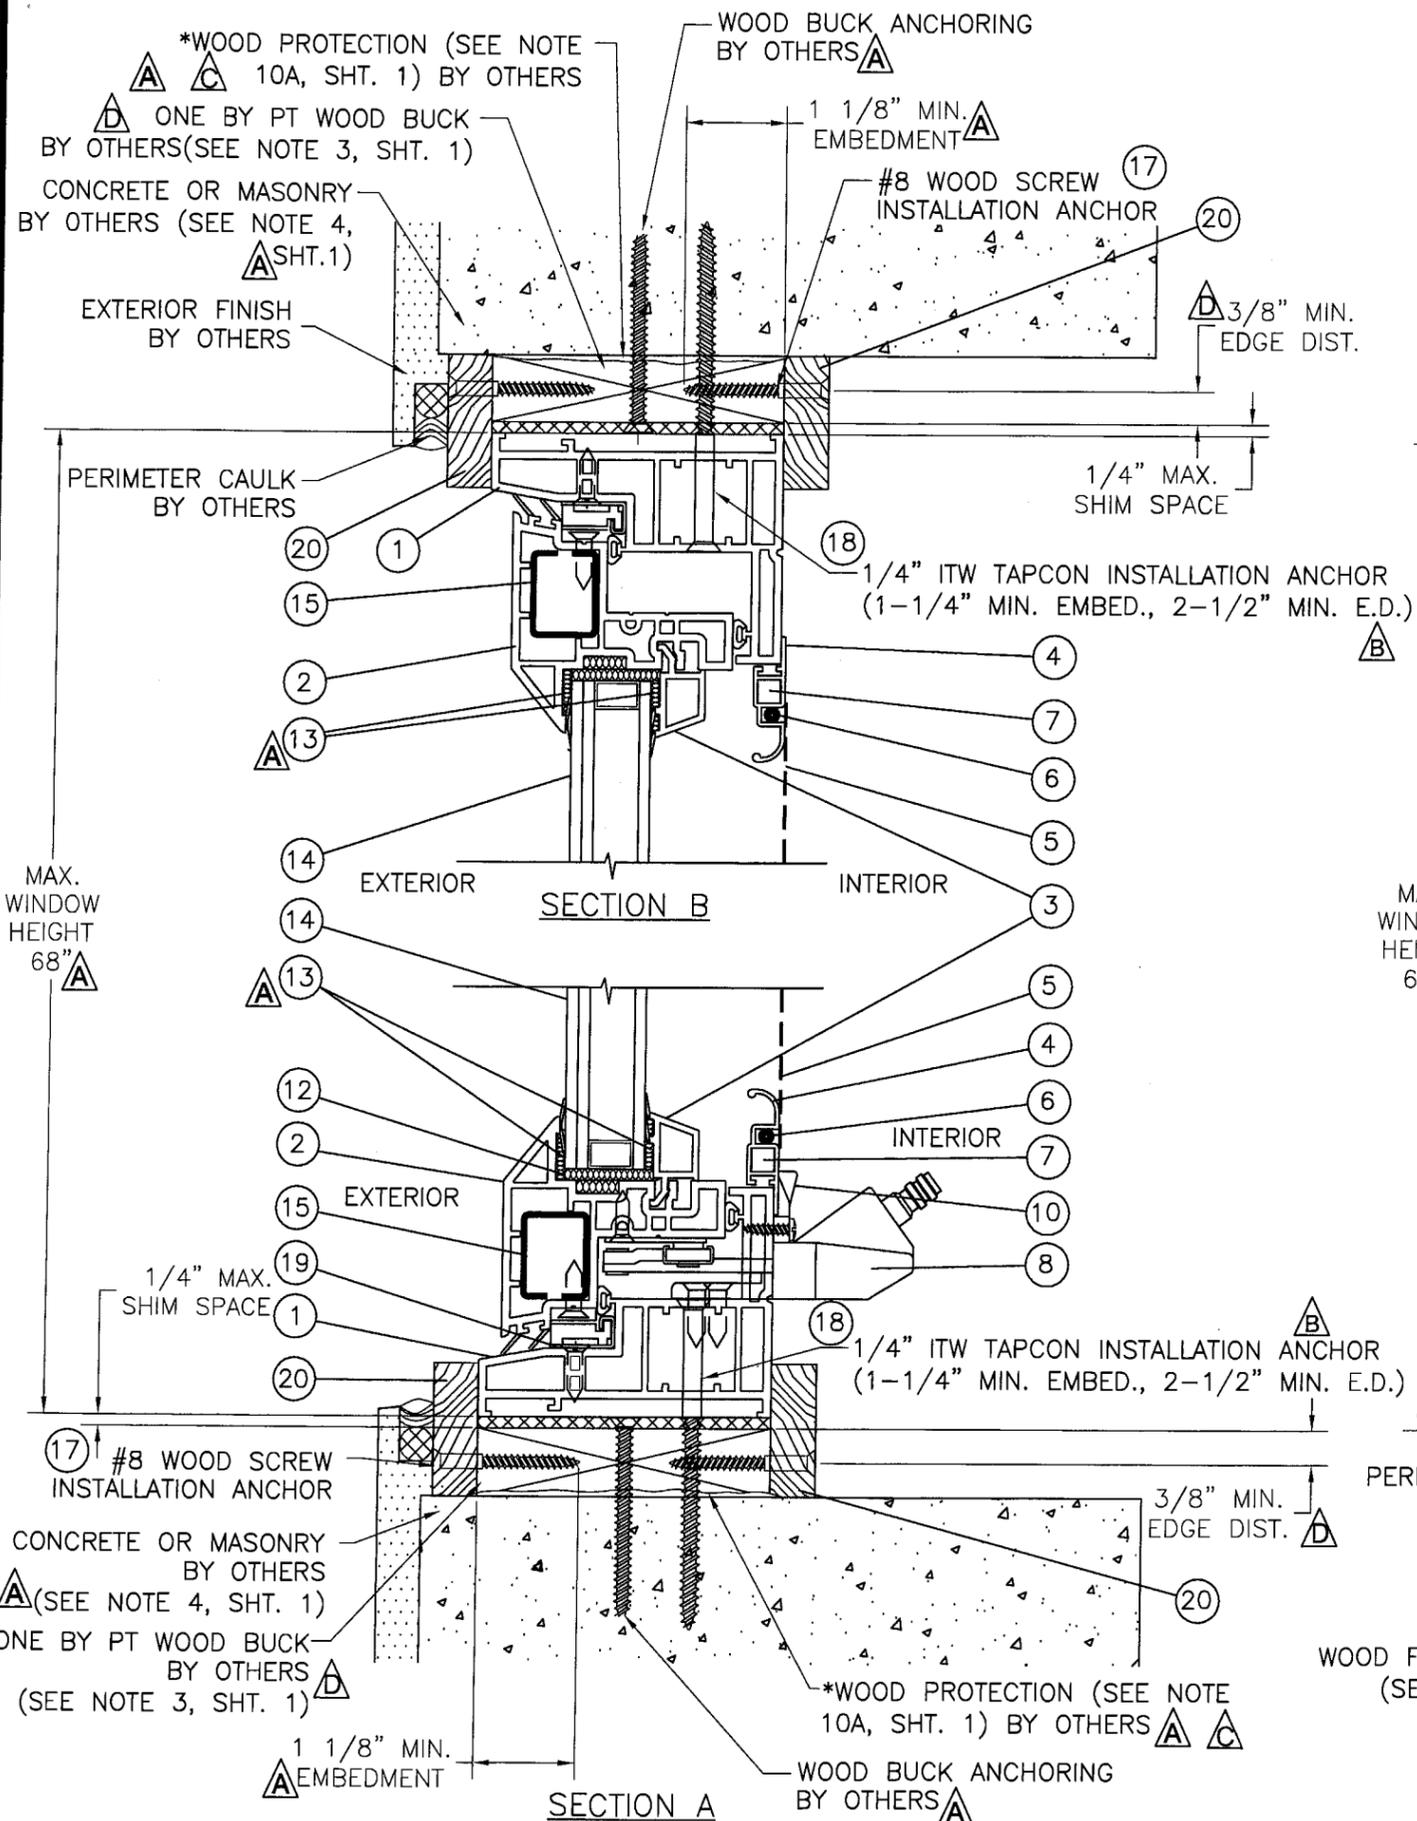

DATE: 04/01/09  
 APPROVED BY: PAUL E. WINTER

REV	DESCRIPTION	DATE	BY
D	PER MIAMI DADE COMMENTS 3/18/09	4/1/09	SMC
C	PER MIAMI DADE COMMENTS	03/12/09	BB
B	PER MIAMI DADE COMMENTS	02/27/09	SMC
A	PER MIAMI DADE COMMENTS DATED 1/7/09	02/05/09	SMC

REGENCY PLUS, INC.  
 1024 LOCUST GAP HIGHWAY  
 MT. CARMEL, PA 17851

TITLE: SERIES "5205" VINYL IMPACT CASEMENT WINDOW - LMI VERTICAL SECTIONS

DATE: 10/14/08  
 DRAWING NO: RPLS0061  
 SCALE: N.T.S.  
 SHEET: 3 OF 5

PREPARED BY: PTC, LLC  
 Phone: 321.680.1788  
 Fax: 321.680.1789


PROJECT #308-0738.21

Paul E. Winter  
 Florida P.E. No. 22693

PTC, LLC  
 1535 J. Cogswell Street, Suite C25  
 Rockledge, Florida 32955


FBPE Certificate of Authorization NO. 25935

Approved as complying with the Florida Building Code  
 Date: 05/06/2009  
 NOA# 08-118-10  
 Division Miami Dade Product Control  
 By: Manuel Perez

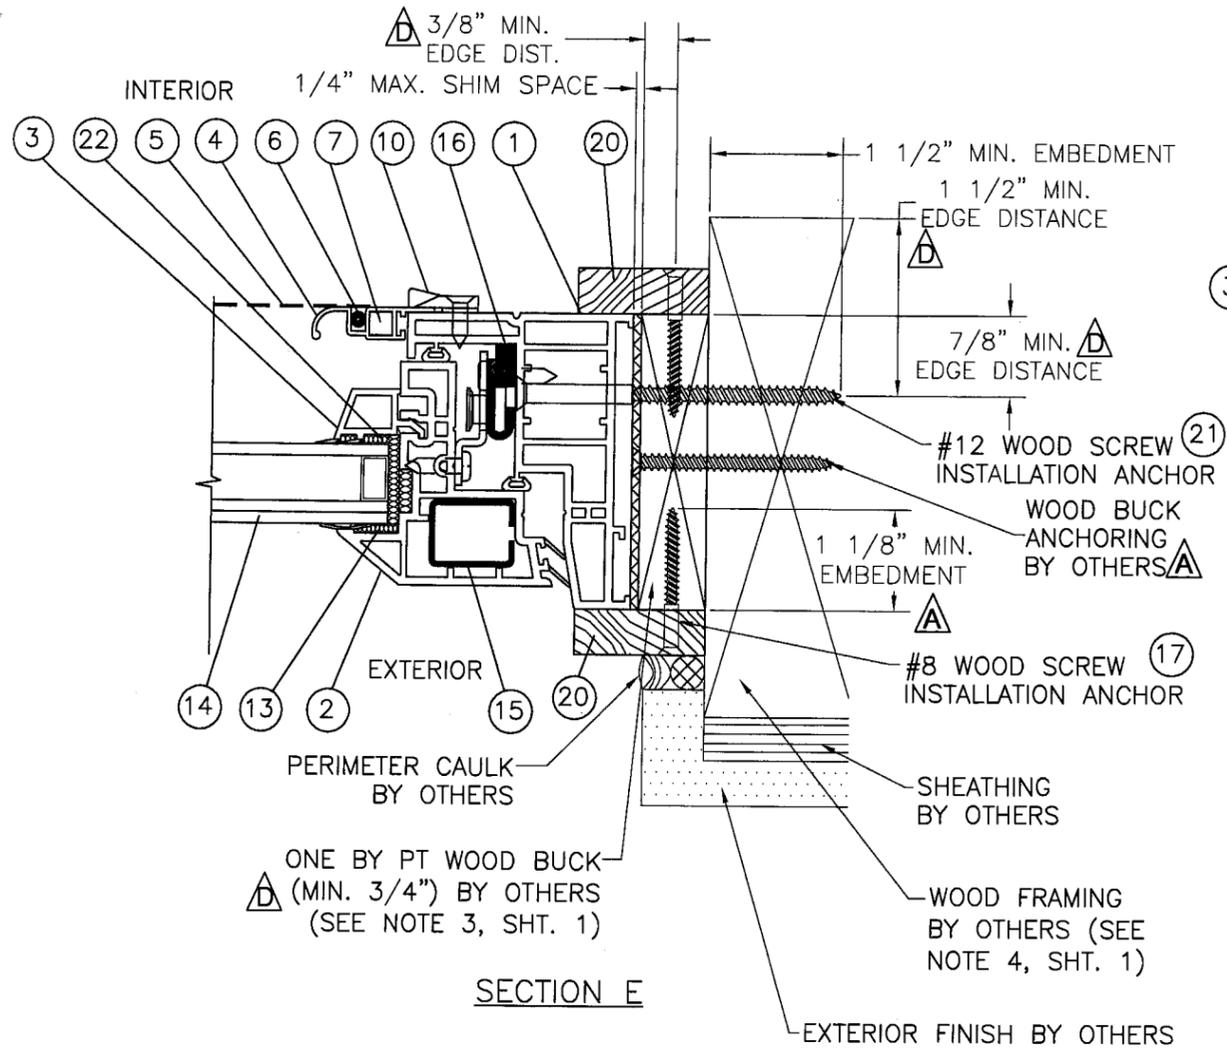


SECTION E

7/8" O.A. GLASS CONSISTING OF:  
 EXTERIOR LAMINATED GLASS W/ THE FOLLOWING MAKE UP:  
 1/8" DSB ANNEALED GLASS/ 0.090" DUPONT "BUTACITE" INTERLAYER/  
 1/8" DSB ANNEALED GLASS W/ A 1/2" AIR SPACE USING  
 A DESICCANT MATRIX STEEL SPACER SYSTEM & AN INTERIOR  
 1/8" TEMPERED DSB GLASS

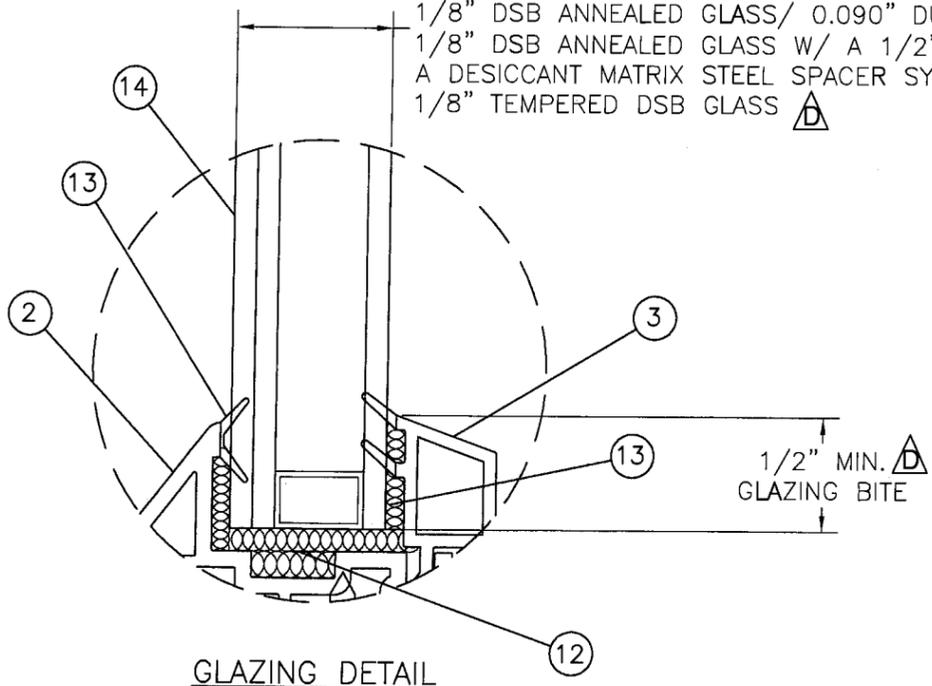

GLAZING DETAIL

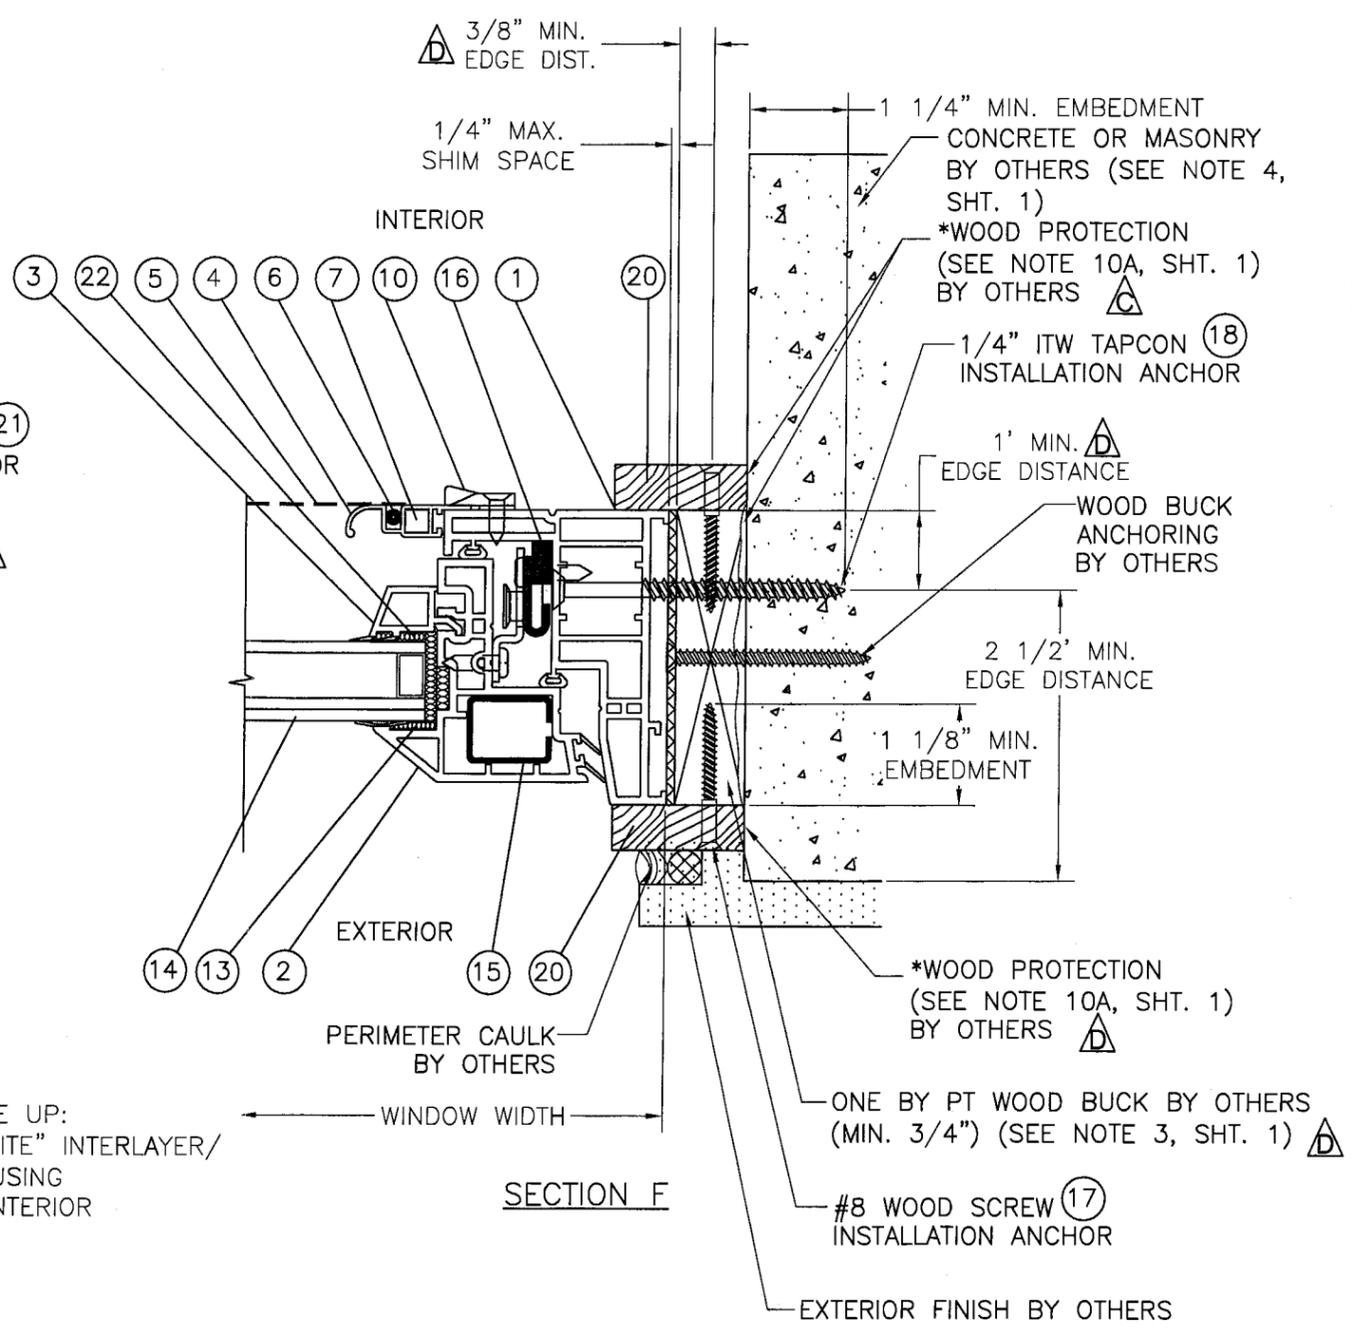

SECTION F

DATE: 04/01/09  
 APPROVED BY: PAUL E. WINTER

PER MIAMI DADE COMMENTS 3/18/09	SMC	4/1/09
PER MIAMI DADE COMMENTS	BB	03/12/09
PER MIAMI DADE COMMENTS	SMC	02/27/09
PER MIAMI DADE COMMENTS DATED 1/17/09	SMC	02/05/09
DESCRIPTION	REV	DATE

REGENCY PLUS, INC.  
 1024 LOCUST GAP HIGHWAY  
 MT. CARMEL, PA 17851

TITLE: SERIES "5205" VINYL IMPACT CASEMENT WINDOW - LMI HORIZONTAL SECTIONS & GLAZING DETAIL

DATE: 10/14/08  
 DRAWING NO: RPLS0061  
 SHEET: 4 OF 5

DRAWN BY: CB  
 SCALE: N.T.S.  
 REV: D


PREPARED BY: PTC, LLC  
 Phone 321.690.1788  
 Fax 321.690.1789

PROJECT #308-0738.21  
 Paul E. Winter  
 Florida P.E. No. 22693


1535 N. Cogswell Street, Suite C25  
 Rockledge, Florida 32955  
 FBPE Certificate of Authorization NO. 25835

Approved as complying with the  
 Florida Building Code  
 Date 05/06/2009  
 NOA# 08-1118.10  
 Division Miami Dade Product Control  
 By *[Signature]*

① MAIN FRAME  
0.090" TYP. WALL THICKNESS

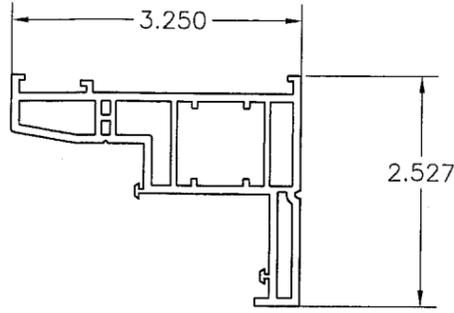


② SASH FRAME  
0.090" TYP. WALL THICKNESS

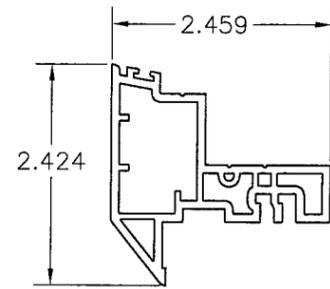


③ GLAZING BEAD  
0.070" TYP. WALL THICKNESS




④ SCREEN FRAME  
0.045" TYP. WALL THICKNESS

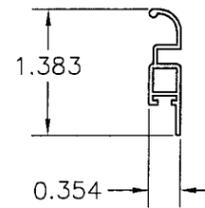

⑮ VENT REINFORCEMENT  
0.055" TYP. WALL THICKNESS

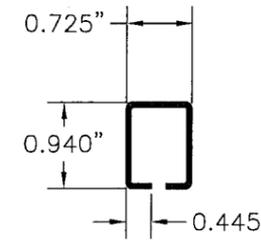


⑳ PARTING STOP  
N.A. TYP. WALL THICKNESS

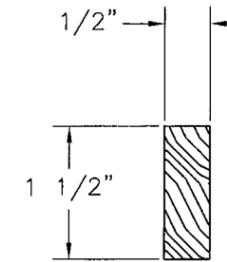

DATE: 04/01/09  
APPROVED BY: PAUL E. WINTER

SMC	4/1/09	PER MIAMI DADE COMMENTS 3/18/09
BB	03/12/09	PER MIAMI DADE COMMENTS
SMC	02/27/09	PER MIAMI DADE COMMENTS
SMC	02/05/09	PER MIAMI DADE COMMENTS DATED 1/7/09
REV	DATE	DESCRIPTION
D		
C		
B		
A		

WELDED MITERED CORNER CONSTRUCTION  $\Delta$

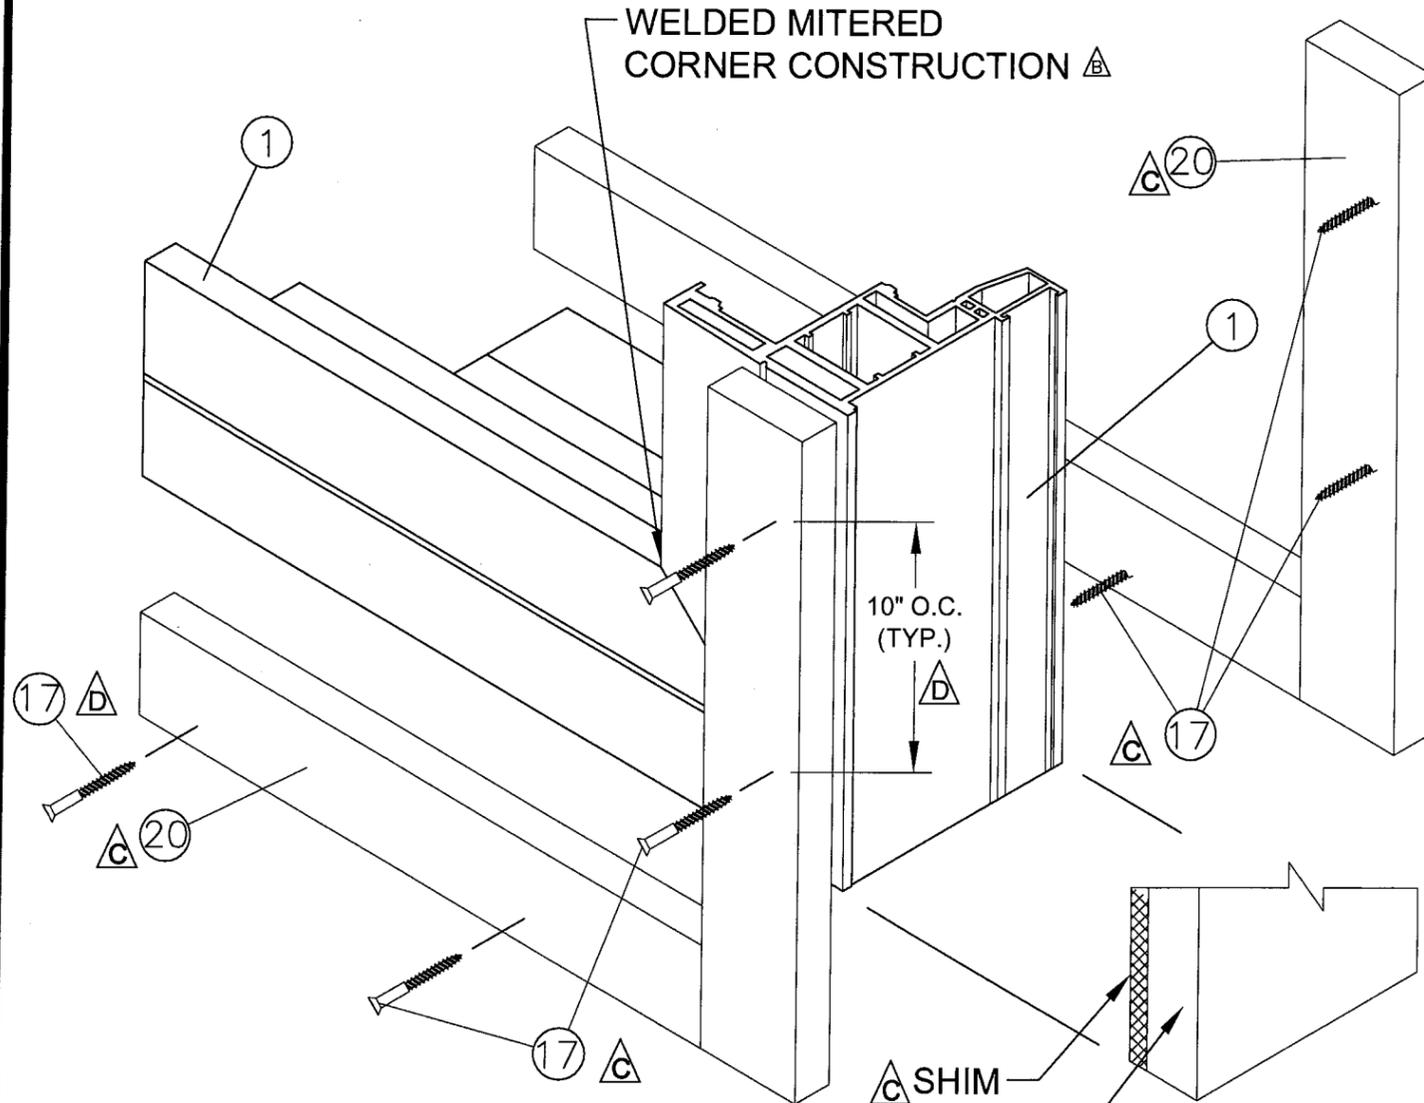

NOTE:  
PARTING STOP EXTERIOR PERIMETER TO BE SEALED TO 1X PT WOOD BUCK WITH SIKA 551 SILICONE  $\Delta$

DETAIL 1

1X PT WOOD BUCK  $\Delta$  BY OTHERS

BILL OF MATERIALS

ITEM #	PART #	QTY	DESCRIPTION	SUPPLIER	MATERIAL
1	1083 WHITE	4	MAIN FRAME	DOMINION PLASTICS	WHITE PVC
2	1084 WHITE	4	SASH FRAME	DOMINION PLASTICS	WHITE PVC
3	1103 WHITE	4	GLAZING BEAD	DOMINION PLASTICS	WHITE PVC
4	HJB172-NW	4	SCREEN FRAME	SHAPED UNLIMITED	RIGID VINYL
5	FG18X16.011	1	FIBERGLASS SCREEN	HANOVER WIIRE	FIBERGLASS MESH
6	EX-FLX-Q165-RK	1	SCREEN SPLINE	IMPERIAL PLASTICS	HOLLOW VINYL
7	.250" X .260"	4	SCREEN CORNER KEYS	SUMMIT METAL	-----
8	50.01.78.011	1	OPERATOR HARDWARE ASSEMBLY	TRUTH	-----
9	24-84-32-002	1	RIGHT LOCK ASSEMBLY	TRUTH	-----
10	8702-046	6	SCREEN CLIP	ASHLAND	RIGID VINYL
11	1" X 1/2" X 1/2"	1	FOAM WEEP FILTER	WHITEMAN TOVER	FOAM
12	2NB-BK-.125-028-026	4	GLAZING PADS	FRANK LOVE	-----
13	SIKA FLEX 552	-	IMPACT GLAZING SEALANT	SIKA CORP.	SILICONE
14	-----	1	IMPACT INSULATED LAMINATED GLASS	A.F.G.	GLASS
15	-----	4	VENT REINFORCEMENT AISI 1015 HOT DIPPED GALVANIZED G40	-----	GALVANIZED STEEL $\Delta$
16	21642.92	10	SNUBBER INTERLOCK	TRUTH	METAL
17	-----	-	#8 x 1 5/8" WOOD INSTALLATION SCREW	-----	STEEL $\Delta$
18	-----	-	1/4" TAPCON INSTALLATION ANCHOR	ITW (NOA 07-0315.03)	STEEL
19	32384.92	1	11.5 TRACK OPERATOR	TRUTH	-----
20	-----	8	PARTING STOP (WOOD 1/2" X 1 1/2") (SEE NOTE 10A, SHT. 1)	PT PINE WOOD $\Delta$	G = 0.55 MIN. $\Delta$
21	-----	-	#12 WOOD INSTALLATION SCREW	-----	STEEL

REGENCY PLUS, INC.  
1024 LOCUST GAP HIGHWAY  
MT. CARMEL, PA 17851

TITLE: SERIES "5205" VINYL IMPACT CASEMENT WINDOW - LMI COMPONENTS, BILL OF MATERIALS & CORNER DETAIL

DATE: 10/14/08  
DRAWN BY: CB  
SCALE: N.T.S.  
REV: D  
DRAWING NO: RPLS00061  
SHEET: 5 OF 5



PROJECT # 308-0736.21  
Paul E. Winter  
Florida P.E. No. 722693

PTC, LLC  
1535 N. Cogswell Street, Suite C25  
Rockledge, Florida 32955  
Phone 321.690.1788  
Fax 321.690.1789

Approved as complying with the Florida Building Code  
Date 05/06/2009  
NOA # 08-1118.1D  
Division  
By *Maureen Ross*