



**MIAMI-DADE COUNTY**  
**BUILDING CODE COMPLIANCE OFFICE (BCCO)**  
**PRODUCT CONTROL DIVISION**

**MIAMI-DADE COUNTY, FLORIDA**  
**METRO-DADE FLAGLER BUILDING**  
**140 WEST FLAGLER STREET, SUITE 1603**  
**MIAMI, FLORIDA 33130-1563**  
**(305) 375-2902 FAX (305) 372-6339**

**NOTICE OF ACCEPTANCE (NOA)**

[www.miamidade.gov/buildingcode](http://www.miamidade.gov/buildingcode)

**Regency Plus, Inc.**  
**1024 Locust Gap Highway**  
**Mt. Camel, PA 17851**

**SCOPE:**

This NOA is being issued under the applicable rules and regulations governing the use of construction materials. The documentation submitted has been reviewed by Miami-Dade County Product Control Division and accepted by the Board of Rules and Appeals (BORA) to be used in Miami Dade County and other areas where allowed by the Authority Having Jurisdiction (AHJ).

This NOA shall not be valid after the expiration date stated below. The Miami-Dade County Product Control Division (In Miami Dade County) and/or the AHJ (in areas other than Miami Dade County) reserve the right to have this product or material tested for quality assurance purposes. If this product or material fails to perform in the accepted manner, the manufacturer will incur the expense of such testing and the AHJ may immediately revoke, modify, or suspend the use of such product or material within their jurisdiction. BORA reserves the right to revoke this acceptance, if it is determined by Miami-Dade County Product Control Division that this product or material fails to meet the requirements of the applicable building code. This product is approved as described herein, and has been designed to comply with the Florida Building Code, including the High Velocity Hurricane Zone.

**DESCRIPTION: Series "5305 Tilt Vinyl" White PVC Double Hung Window – L.M.I.**

**APPROVAL DOCUMENT:** Drawing No. **RPLS0064**, titled "Series 5305 Tilt Double Hung Impact Vinyl Window", sheets 1 through 8 of 8, dated 01/12/09 with revision "C" dated 04/01/09, prepared by PTC, LLC, signed and sealed by Paul E. Winter, P. E., bearing the Miami-Dade County Product Control Approval stamp with the Notice of Acceptance number and Approval date by the Miami-Dade County Product Control Division.

**MISSILE IMPACT RATING: Large and Small Missile Impact Resistant**

**LABELING:** Each unit shall bear a permanent label with the manufacturer's name or logo, city, state and following statement: "Miami-Dade County Product Control Approved", unless otherwise noted herein.

**RENEWAL** of this NOA shall be considered after a renewal application has been filed and there has been no change in the applicable building code negatively affecting the performance of this product.

**TERMINATION** of this NOA will occur after the expiration date or if there has been a revision or change in the materials, use, and/or manufacture of the product or process. Misuse of this NOA as an endorsement of any product, for sales, advertising or any other purposes shall automatically terminate this NOA. Failure to comply with any section of this NOA shall be cause for termination and removal of NOA.

**ADVERTISEMENT:** The NOA number preceded by the words Miami-Dade County, Florida, and followed by the expiration date may be displayed in advertising literature. If any portion of the NOA is displayed, then it shall be done in its entirety.

**INSPECTION:** A copy of this entire NOA shall be provided to the user by the manufacturer or its distributors and shall be available for inspection at the job site at the request of the Building Official. This NOA consists of this page 1 and evidence page E-1, as well as approval document mentioned above. The submitted documentation was reviewed by **Manuel Perez, P.E.**



**NOA No. 09-0122.05**  
**Expiration Date: May 6, 2014**  
**Approval Date: May 6, 2009**  
**Page 1**

Regency Plus, Inc.

NOTICE OF ACCEPTANCE: EVIDENCE SUBMITTED

- A. DRAWINGS**
1. Manufacturer's die drawings and sections.
  2. Drawing No **RPLS0064**, titled "Series 5305 Tilt Double Hung Impact Vinyl Window", sheets 1 through 8 of 8, dated 01/12/09 with revision "C" dated 04/01/09, prepared by PTC, LLC, signed and sealed by Paul E. Winter, P. E.
- B. TESTS**
1. Test report on: 1) Air Infiltration Test, per FBC, TAS 202-94  
2) Uniform Static Air Pressure Test, Loading per FBC TAS 202-94  
3) Water Resistance Test, per FBC, TAS 202-94  
4) Large Missile Impact Test per FBC, TAS 201-94  
5) Cyclic Wind Pressure Loading per FBC, TAS 203-94  
6) Forced Entry Test, per FBC 2411 3.2.1, TAS 202-94  
along with marked-up drawings and installation diagram of series 5305 tilt double hung vinyl window, prepared by National Certified Testing Laboratories, Test Report No. **NCTL-110-11422-2**, dated 10/02/08 with revision dated 01/08/09, and addendum letter dated 03/12/09, all signed and sealed by Harold E. Rupp, P. E.
- C. CALCULATIONS**
1. Anchor verification calculations and structural analysis, complying with FBC 2007, prepared by PTC, LLC, dated 01/12/09 and 04/02/09, signed and sealed by Paul E. Winter, P. E. **Complies with ASTM E1300-02/ 04**
- D. QUALITY ASSURANCE**
1. Miami Dade Building Code Compliance Office (BCCO).
- E. MATERIAL CERTIFICATIONS**
1. Notice of Acceptance No. **05-1208.02** issued to E.I. DuPont DeNemours & Co., Inc. for their "**DuPont Butacite PVB, Interlayer**" dated 01/05/06, expiring on 12/11/10.
  2. Notice of Acceptance No. **07-1016.05**, issued to Dominion Plastics, Inc. for their Series "**White Rigid PVC Exterior Extrusions for Windows and Doors**", approved on 11/15/07 and expiring on 10/24/12.
- F. STATEMENTS**
1. Statement letter of conformance and of no financial interest, dated 01/12/09, signed and sealed by Paul E. Winter, P. E.
  2. Laboratory compliance letter in the Test Report no. **NCTL-110-11422-2**, issued by National Certified Testing Laboratories, dated 10/02/08 revision dated 01/08/09, signed and sealed by Harold E. Rupp, P. E.
- G. OTHERS**
1. None.

  
Manuel Perez, P.E.  
Product Control Examiner  
NOA No. 09-0122.05  
Expiration Date: May 6, 2014  
Approval Date: May 6, 2009

# REGENCY PLUS

## SERIES 5305 TILT DOUBLE HUNG IMPACT VINYL WINDOW

### INSTALLATION ANCHORAGE DETAILS

**GENERAL NOTES:**

1. THE PRODUCT ANCHORAGE SHOWN HEREIN IS DESIGNED TO COMPLY WITH THE HIGH VELOCITY HURRICANE ZONE (HVHZ) OF THE 2007 FLORIDA BUILDING CODE (FBC) AND AT THE DESIGN PRESSURE STATED HEREIN.
2. THE PRODUCT DETAILS CONTAINED HEREIN ARE BASED UPON SIGNED AND SEALED TEST REPORT # NCTL-110-11422-2 DATED 12/01/08, ADDENDUM DATED 11/05/08 AND ADDENDUM II DATED 03/10/09 AND ASSOCIATED LABORATORY STAMPED DRAWINGS AND WERE TESTED IN ACCORDANCE WITH CURRENT DADE COUNTY PROTOCOLS.
3. ADEQUACY OF THE EXISTING STRUCTURAL CONCRETE MASONRY AND 2X FRAMING AS A MAIN WIND FORCE RESISTING SYSTEM CAPABLE OF WITHSTANDING AND TRANSFERRING APPLIED PRODUCT LOADS TO THE STRUCTURE IS THE RESPONSIBILITY OF THE ENGINEER OR ARCHITECT OF RECORD AND TO BE REVIEWED BY AGENCY HAVING JURISDICTION (AHJ).
4. 1X AND 2X BUCKS (WHEN USED) SHALL BE DESIGNED AND ANCHORED TO PROPERLY TRANSFER ALL LOADS TO THE STRUCTURE. BUCK DESIGN AND INSTALLATION IS THE RESPONSIBILITY OF THE ENGINEER OR ARCHITECT OF RECORD AND TO BE REVIEWED BY AHJ.

5. IN AREAS WHERE WIND-BORNE DEBRIS PROTECTION REQUIREMENTS EXIST, USE OF AN APPROVED IMPACT PROTECTIVE SYSTEM IS NOT REQUIRED.
6. WINDOW FRAME AND PANEL MATERIAL: WHITE RIGID PVC (N.O.A. 07-1016.05)
7. GLASS MEETS THE REQUIREMENTS OF ASTM E1300. SEE SHEET 6 FOR GLAZING DETAIL.
8. DESIGNATION "X" STANDS FOR THE FOLLOWING:  
X: OPERABLE PANEL
9. A 1/3 INCREASE IN ALLOWABLE STRESS FOR WIND LOADS WAS NOT USED IN THE DESIGN OF THE PRODUCT(S) SHOWN HEREIN. WIND LOAD DURATION FACTOR (Cd = 1.0) HAS BEEN USED FOR WOOD ANCHOR DESIGN.

**INSTALLATION NOTES:**

1. ONE (1) INSTALLATION ANCHOR IS REQUIRED AT EACH ANCHOR LOCATION SHOWN.
2. THE NUMBER OF INSTALLATION ANCHORS DEPICTED IS THE MINIMUM NUMBER OF ANCHORS TO BE USED FOR PRODUCT INSTALLATION.
3. SHIM AS REQUIRED AT EACH INSTALLATION ANCHOR WITH LOAD BEARING SHIM(S). MAXIMUM ALLOWABLE SHIM SIZE IS 1/4 INCH. SHIM WHERE SPACE OF 1/16 INCH OR GREATER OCCURS. SHIM(S) SHALL BE CONSTRUCTED OF HIGH DENSITY PLASTIC OR BETTER.
4. FOR INSTALLATION INTO WOOD FRAMING, USE #12 WOOD SCREWS OF SUFFICIENT LENGTH TO ACHIEVE 1 1/2 INCH MINIMUM EMBEDMENT. MINIMUM EDGE DISTANCE IS 7/8 INCHES.
5. FOR INSTALLATION THROUGH 1X BUCK TO CONCRETE / MASONRY, OR DIRECTLY INTO CONCRETE / MASONRY, USE 3/16 INCH ITW TAPCONS OF SUFFICIENT LENGTH TO ACHIEVE 1 1/4 INCH MINIMUM EMBEDMENT. MINIMUM EDGE DISTANCE IS 2-5/8 INCHES. MINIMUM ANCHOR SEPARATION IS 2 1/4 INCH.
6. MINIMUM EMBEDMENT AND EDGE DISTANCE EXCLUDE WALL FINISHES, INCLUDING BUT NOT LIMITED TO STUCCO, FOAM, BRICK VENEER AND SIDING.

7. FOR CONCRETE BLOCK, DO NOT INSTALL INSTALLATION ANCHORS INTO MORTAR JOINTS. EDGE DISTANCE IS MEASURED FROM FREE EDGE OF BLOCK OR EDGE OF MORTAR JOINT INTO FACE SHELL OF BLOCK.
8. INSTALLATION ANCHOR CAPACITIES FOR PRODUCTS HEREIN ARE BASED ON SUBSTRATE MATERIALS WITH THE FOLLOWING PROPERTIES:
  - A. WOOD - PRESSURE TREATED (PT) SOUTHERN YELLOW PINE. MINIMUM SPECIFIC GRAVITY OF 0.55. LUMBER MUST COMPLY WITH FBC SECTIONS 2411.3.3.3 AND 2326.2 AS TO WOOD PROTECTION.
  - B. CONCRETE - MINIMUM COMPRESSIVE STRENGTH OF 3192 psi, AND COMPLIES WITH ACI 301, ACI 318-05 AND ACI 355.
  - C. MASONRY - STRENGTH CONFORMANCE TO ASTM C-90 AND ACI 530-05, GRADE N, TYPE 1 (OR GREATER)

TABLE OF CONTENTS		
SHEET	REV.	SHEET DESCRIPTION
1	C	GENERAL NOTES, INSTALLATION NOTES & D.P. CHART
2	C	ELEVATION & ANCHOR LAYOUT
3	C	ELEVATION & ANCHOR LAYOUT
4	C	VERTICAL SECTIONS
5	C	VERTICAL SECTIONS
6	C	HORIZONTAL SECTIONS & GLAZING DETAIL
7	C	BILL OF MATERIALS AND COMPONENTS
8	C	COMPONENTS & CORNER DETAIL

DESIGN PRESSURE RATING (PSF)	IMPACT RATING
±55.0	LARGE MISSILE IMPACT

REV	DESCRIPTION	DATE	BY
C	PER MIAMI DADE COMMENTS 3/18/09	4/1/09	SMC
B	PER MIAMI DADE COMMENTS 2/18/09	03/12/09	BB
A	PER MIAMI DADE COMMENTS 2/18/09	02/26/09	SMC

**REGENCY PLUS**  
1024 LOCUST GAP HIGHWAY  
MT. CARMEL, PA 17851

TITLE: SERIES 5305 TILT DOUBLE HUNG IMPACT VINYL WINDOW  
GENERAL AND INSTALLATION NOTES


DRAWN BY: BB	DATE: 1/12/09
SCALE: N.T.S.	DRAWING NO: RPLS0064
REV: C	SHEET: 1 OF 8

**PREPARED BY:**  
  
PFC, LLC  
Phone: 321.690.1788  
Fax: 321.690.1789


PROJECT #08-1006.21  
Paul E. Winter  
Florida P.E. No. 22698

PFC, LLC  
1535 N. Cogswell Street, Suite C25  
Rockledge, Florida 32955  
FBPE Certificate of Authorization NO. 25935

Approved as complying with the  
Florida Building Code  
Date 6/5/06/2009  
NOA# 04-012-05  
Miami Dade Product Control  
Division  
By:

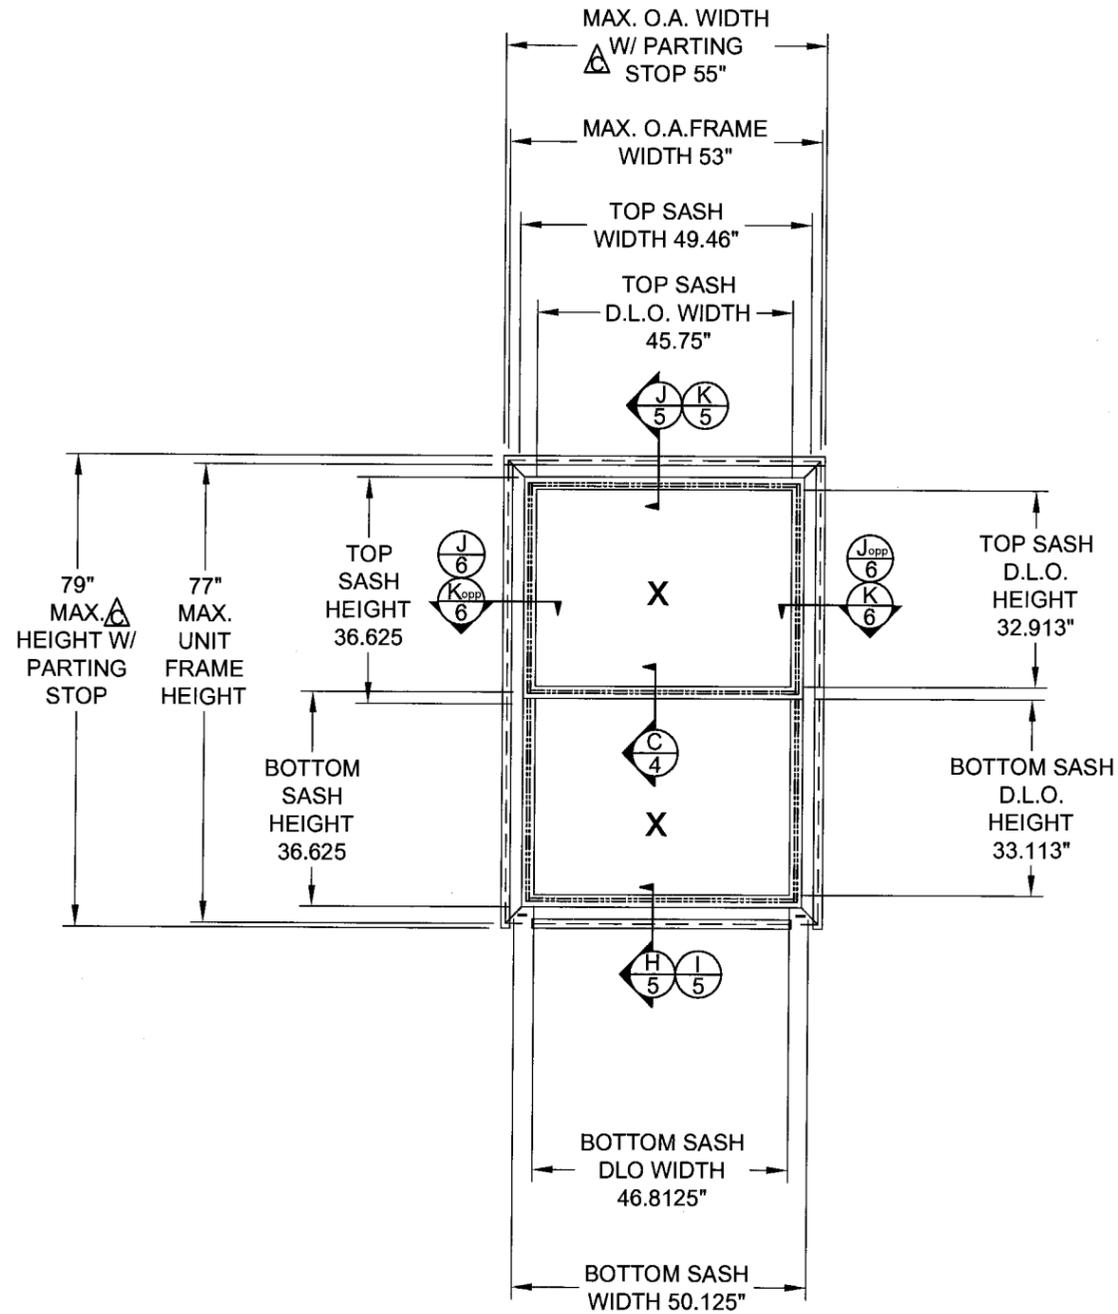

**ELEVATION**  
EXTERIOR VIEW  
W/ PARTING STOPS

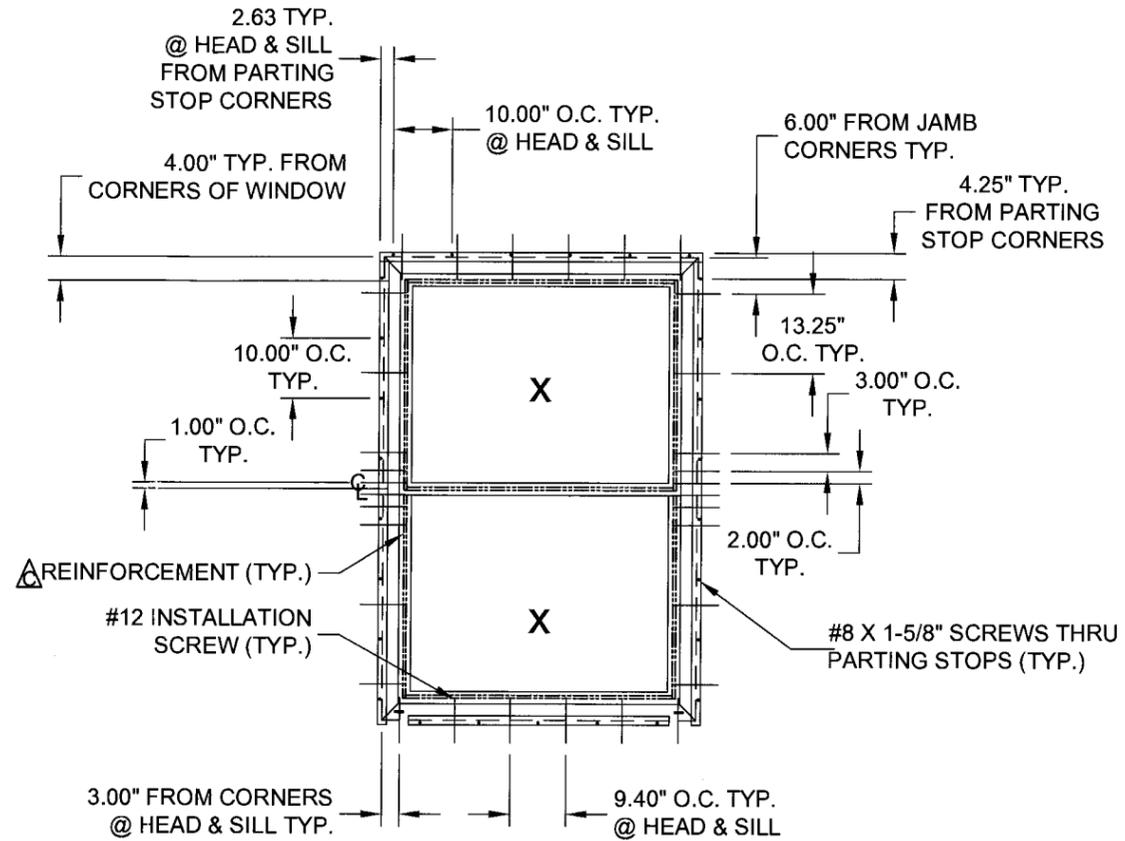

**ANCHOR LAYOUT**  
EXTERIOR VIEW  
W/ PARTING STOPS

APPROVED BY: Paul E. Winter	DATE: 4/1/09			
		PER MIAMI DADE COMMENTS 3/18/09	4/1/09	SMC
		PER MIAMI DADE COMMENTS 2/18/09	02/26/09	SMC
		DESCRIPTION	DATE	BY

PROJECT #308-1006.21

REGENCY PLUS  
1024 LOCUST GAP HIGHWAY  
MT. CARMEL, PA 17851

TITLE: SERIES 5305 TILT DOUBLE HUNG IMPACT VINYL WINDOW ELEVATION & ANCHOR LAYOUT

DATE: 1/12/09

DRAWN BY: BB

SCALE: N.T.S.

REV: C

DRAWING NO.: RPLS0064

SHEET: 2 OF 8

PREPARED BY: **FIE**

FIE, LLC  
Phone: 321.690.1788  
Fax: 321.690.1789


Paul E. Winter  
Florida E. No. 22993

*Signature*


1535 N. Coagwell Street, Suite C25  
Rockledge, Florida 32955

FBPE Certificate of Authorization NO. 25935

Approved as complying with the  
Florida Building Code  
Date 03/02/09  
NOA# 09-0122-05  
Miami Dade Product Control  
Division  
By *Signature*

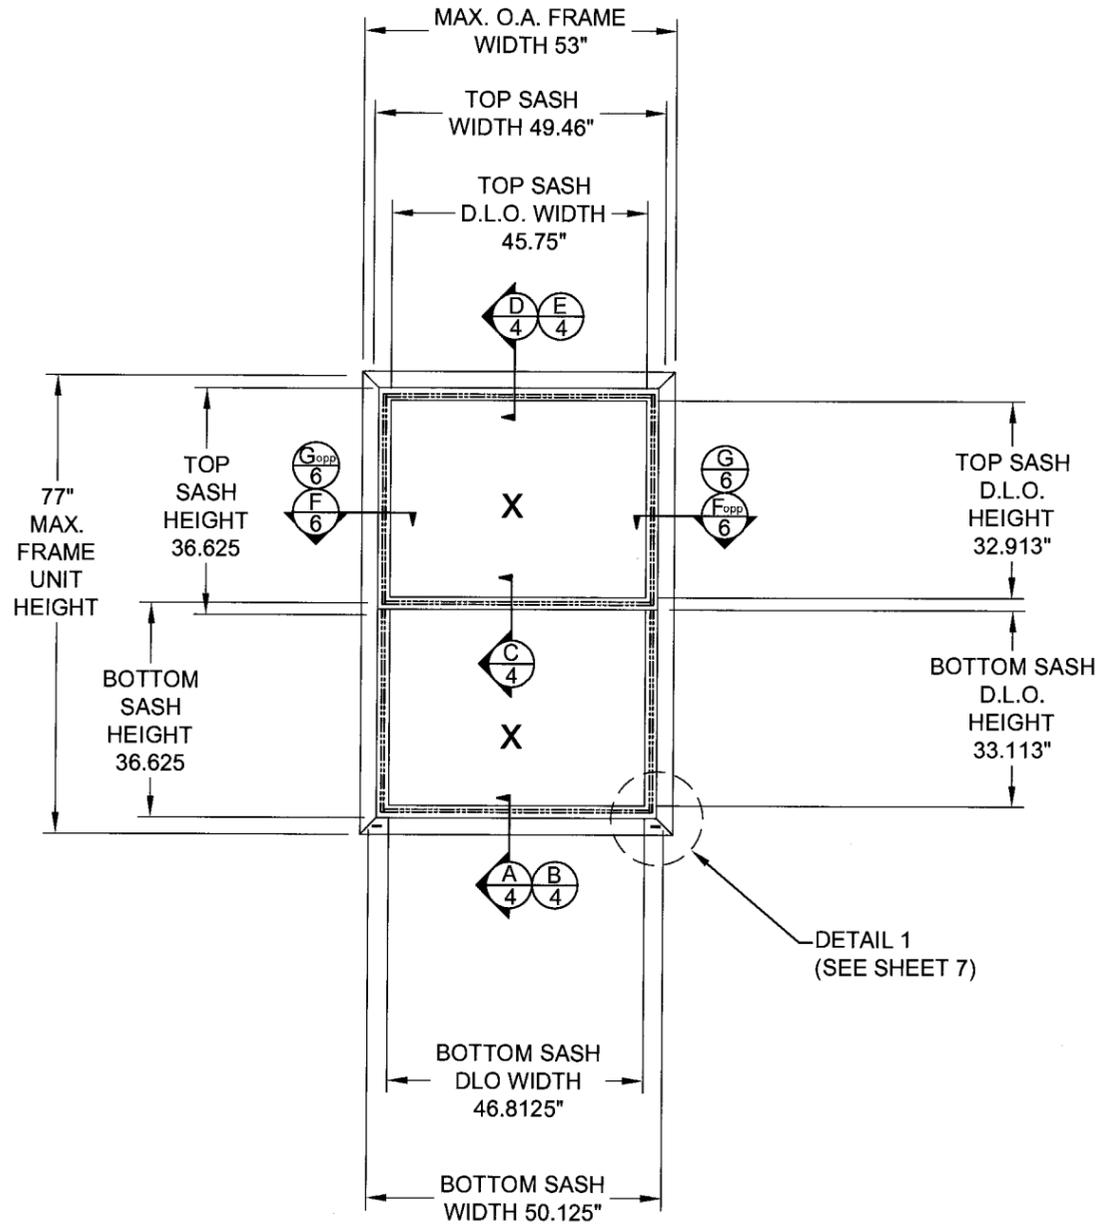

**ELEVATION**  
EXTERIOR VIEW  
W/O PARTING STOPS

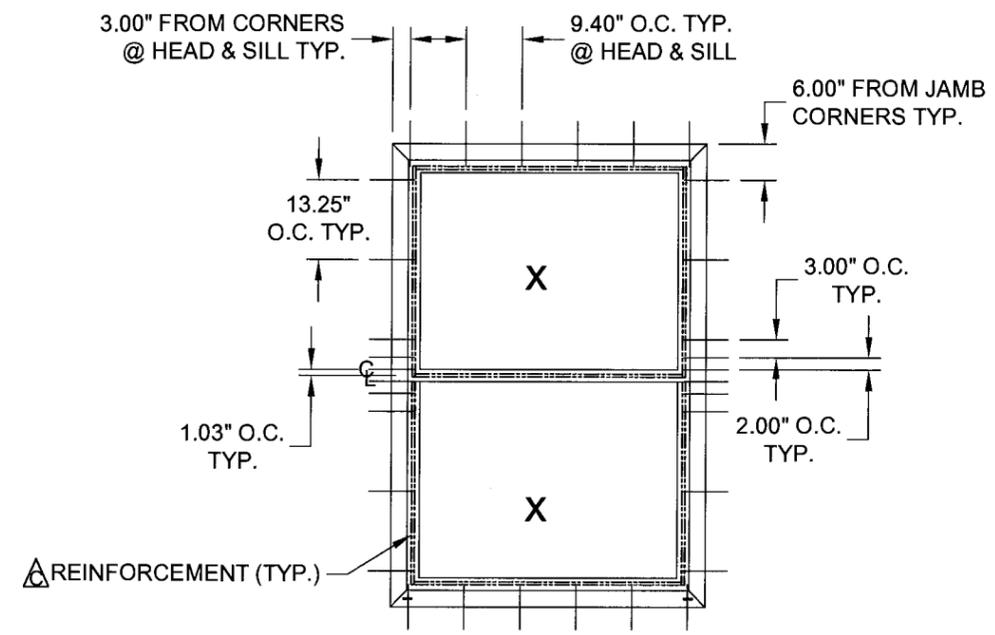

**ANCHOR LAYOUT**  $\Delta$   
EXTERIOR VIEW  
W/O PARTING STOPS

APPROVED BY: Paul E. Winter	DATE: 4/1/09		
C	PER MIAMI DADE COMMENTS 3/18/09	SMC	4/1/09
A	PER MIAMI DADE COMMENTS 2/18/09	SMC	02/26/09
REV	DESCRIPTION	DATE	BY

**REGENCY PLUS**  
1024 LOCUST GAP HIGHWAY  
MT. CARMEL, PA 17851

TITLE: SERIES 5305 TILT DOUBLE HUNG IMPACT VINYL WINDOW ELEVATION & ANCHOR LAYOUT

DATE: 1/12/09

DRAWING NO.: RPLS0064

SHEET: 3 OF 8

PREPARED BY: BB

SCALE: N.T.S.

REV: C

**FPE**  
F.P.C. LLC  
Phone: 321.690.1788  
Fax: 321.690.1789

PROJECT #308-1006.21

Paul E. Winter  
Florida P.E. No. 22692

*Paul E. Winter*


F.P.C. LLC  
1535 N. Cogswell Street, Suite C25  
Rockledge, Florida 32955  
FBPE Certificate of Authorization N.C. 26935

Approved as complying with the  
Florida Building Code  
Date 05/06/2009

NOA# 07-0122-05

Miami Dade Product Control  
Division


By *Manuel Lopez*

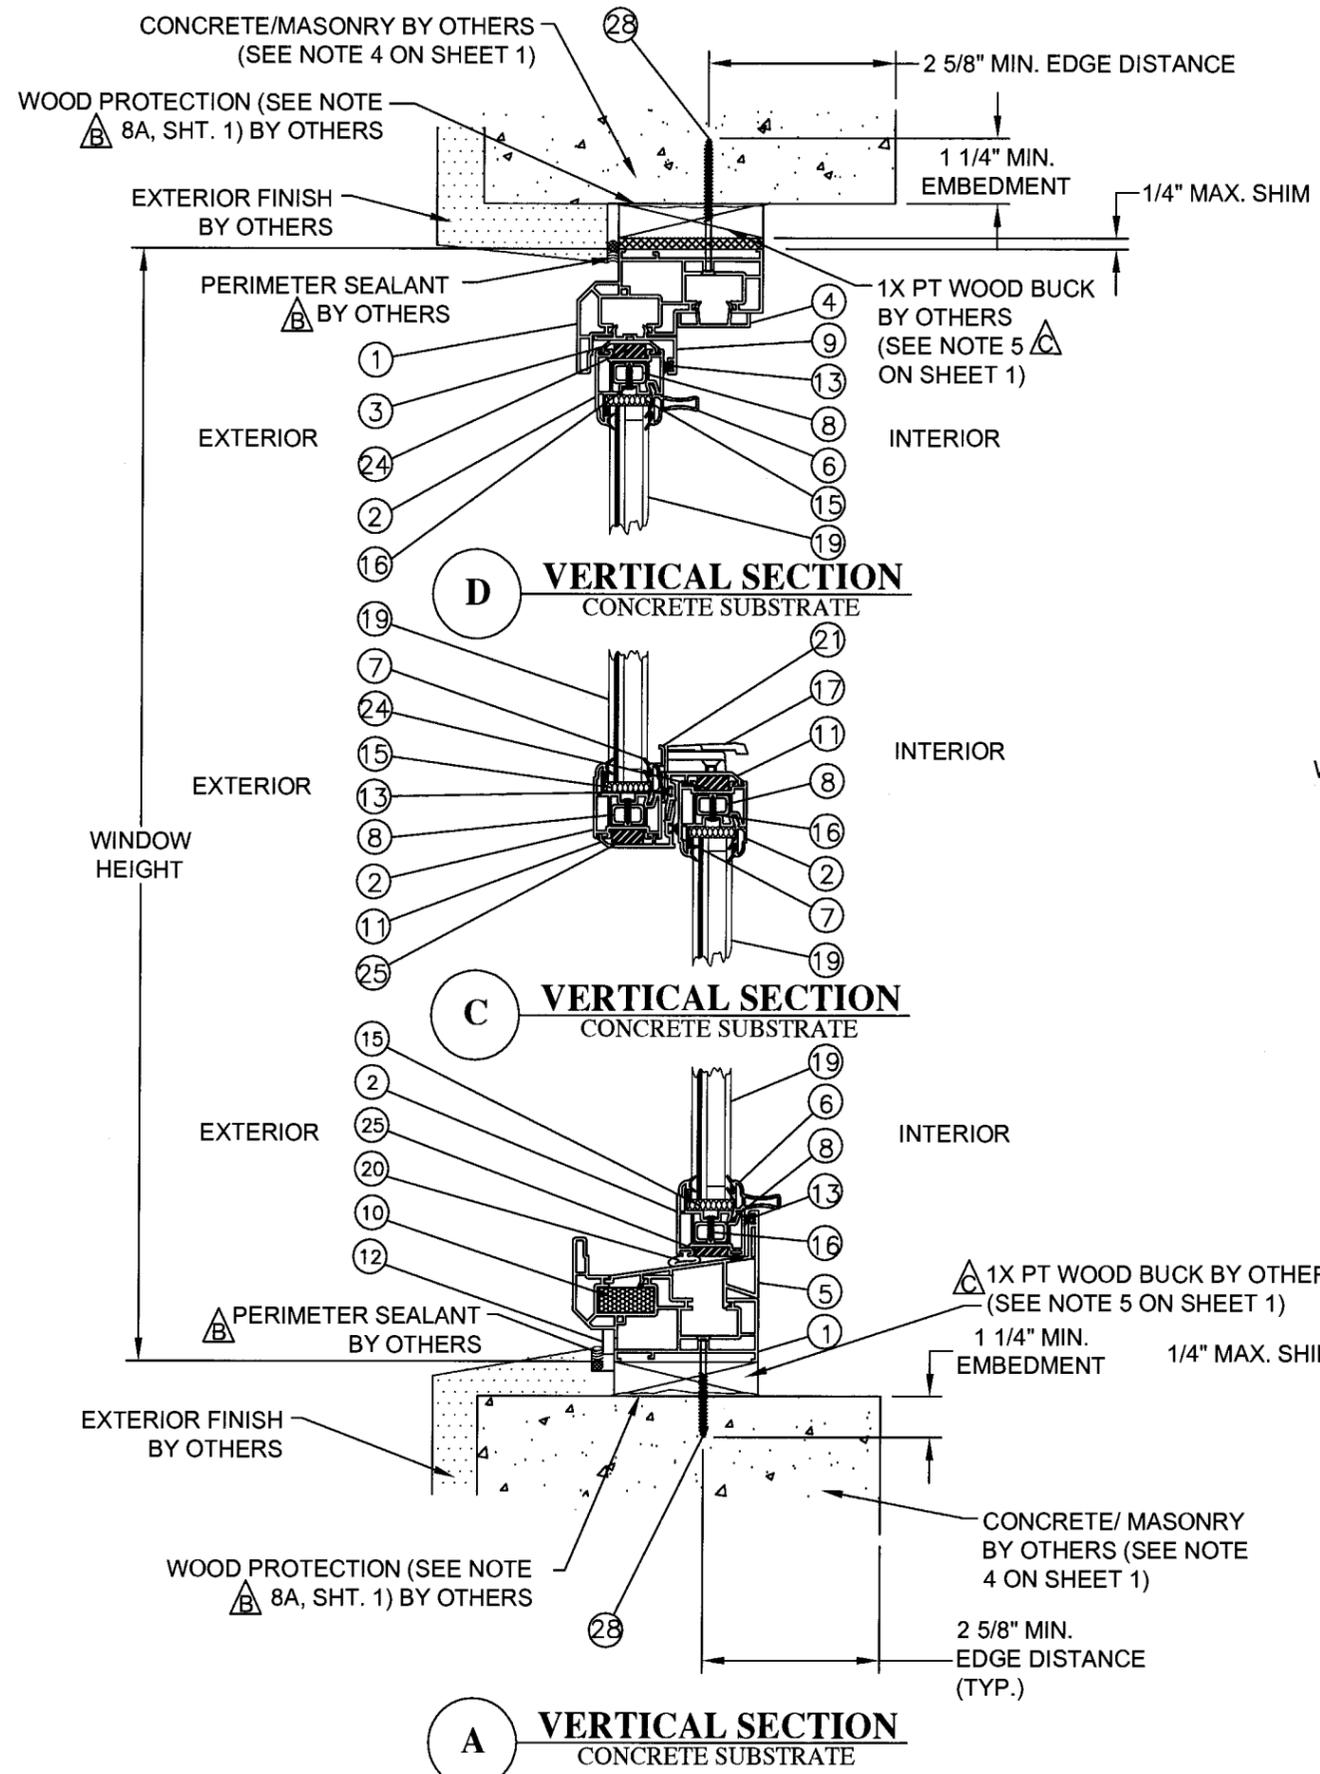


**A VERTICAL SECTION**  
CONCRETE SUBSTRATE

**D VERTICAL SECTION**  
CONCRETE SUBSTRATE

**C VERTICAL SECTION**  
CONCRETE SUBSTRATE

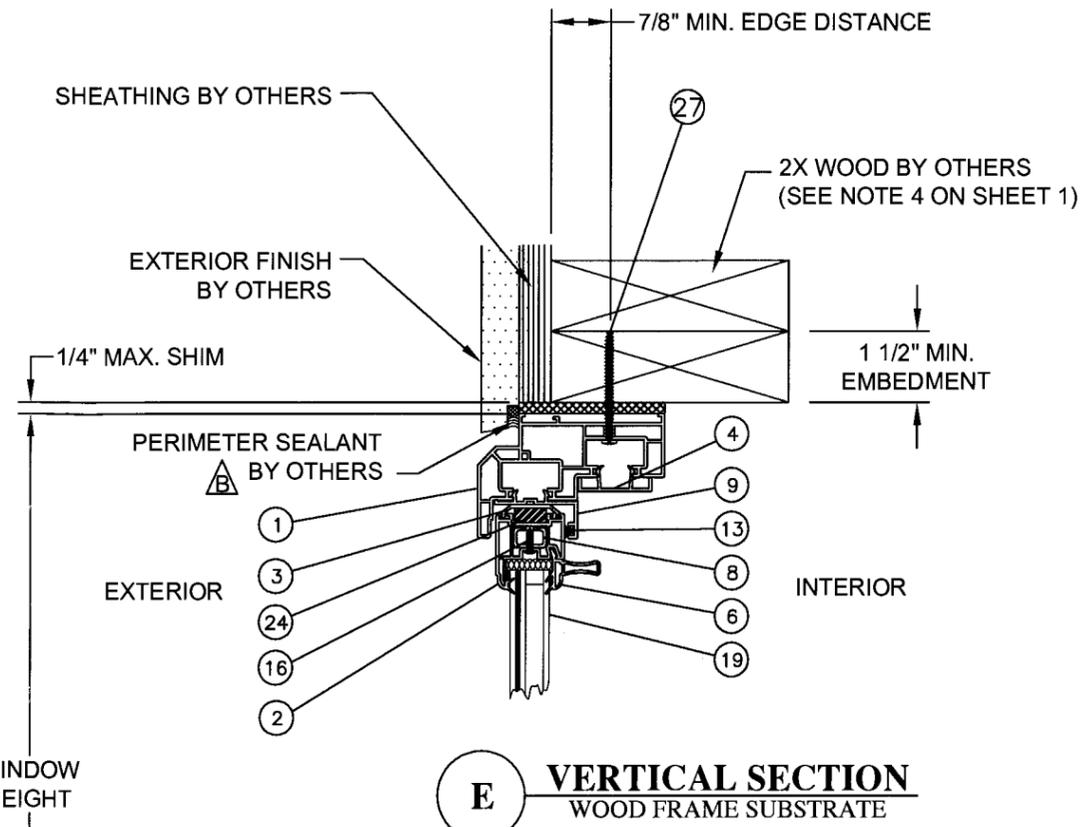

**E VERTICAL SECTION**  
WOOD FRAME SUBSTRATE

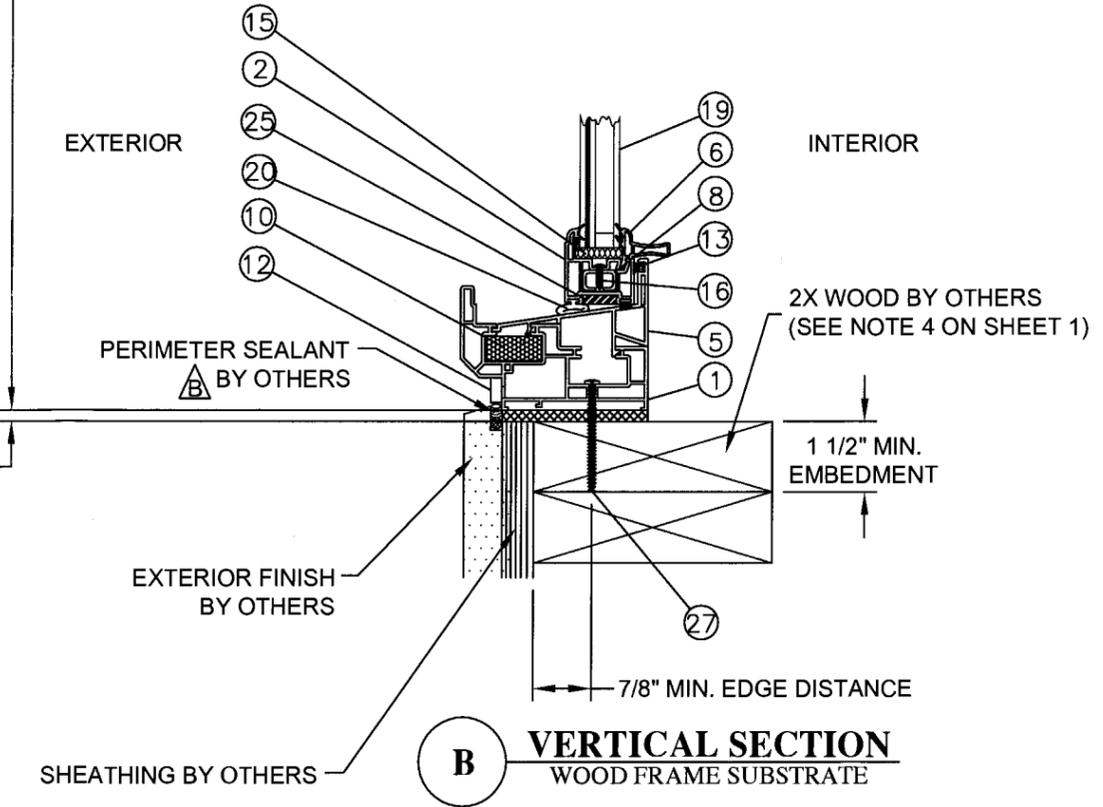

**B VERTICAL SECTION**  
WOOD FRAME SUBSTRATE

DATE:	4/1/09
APPROVED BY:	Paul E. Winter
PER MIAMI DADE COMMENTS 3/18/09	SMC
PER MIAMI DADE COMMENTS 2/18/09	BB
DESCRIPTION	DATE
REV	BY

**REGENCY PLUS**  
1024 LOCUST GAP HIGHWAY  
MT. CARMEL, PA 17851

TITLE: SERIES 5305 TILT DOUBLE HUNG IMPACT VINYL WINDOW VERTICAL SECTIONS

DATE: 1/12/09  
DRAWING NO: RPLS0064  
SCALE: N.T.S.  
REV: 4 OF 8

PREPARED BY: **FPE**  
PTC, LLC  
Phone 321.690.1788  
Fax 321.690.1789


PROJECT #308-1006.21

Paul E. Winter  
Florida P.E. No. 27693


*Signature*

PTC, LLC  
1535 N. Cogswell Street, Suite C25  
Rockledge, Florida 32955  
FBPE Certificate of Authorization NO. 25935


Approved as complying with the  
Florida Building Code  
Date *03/02/2009*  
NOA# *09-01226*  
Division  
By *Manuel Bay*

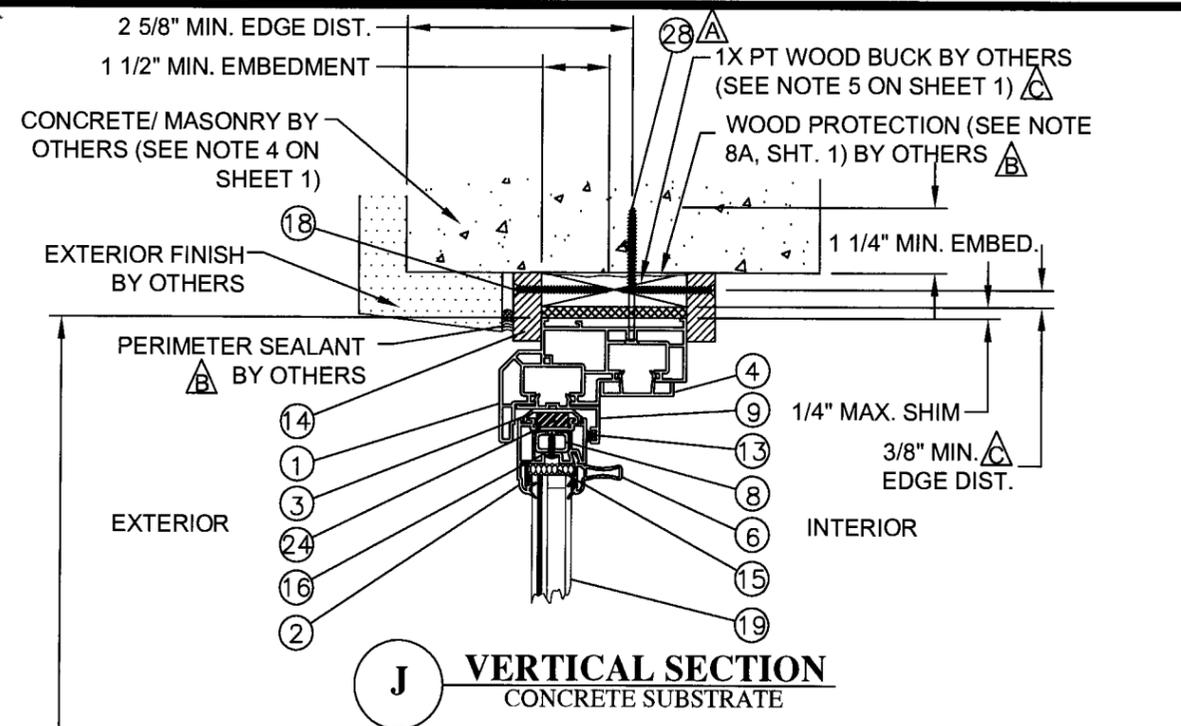


**J** VERTICAL SECTION  
CONCRETE SUBSTRATE

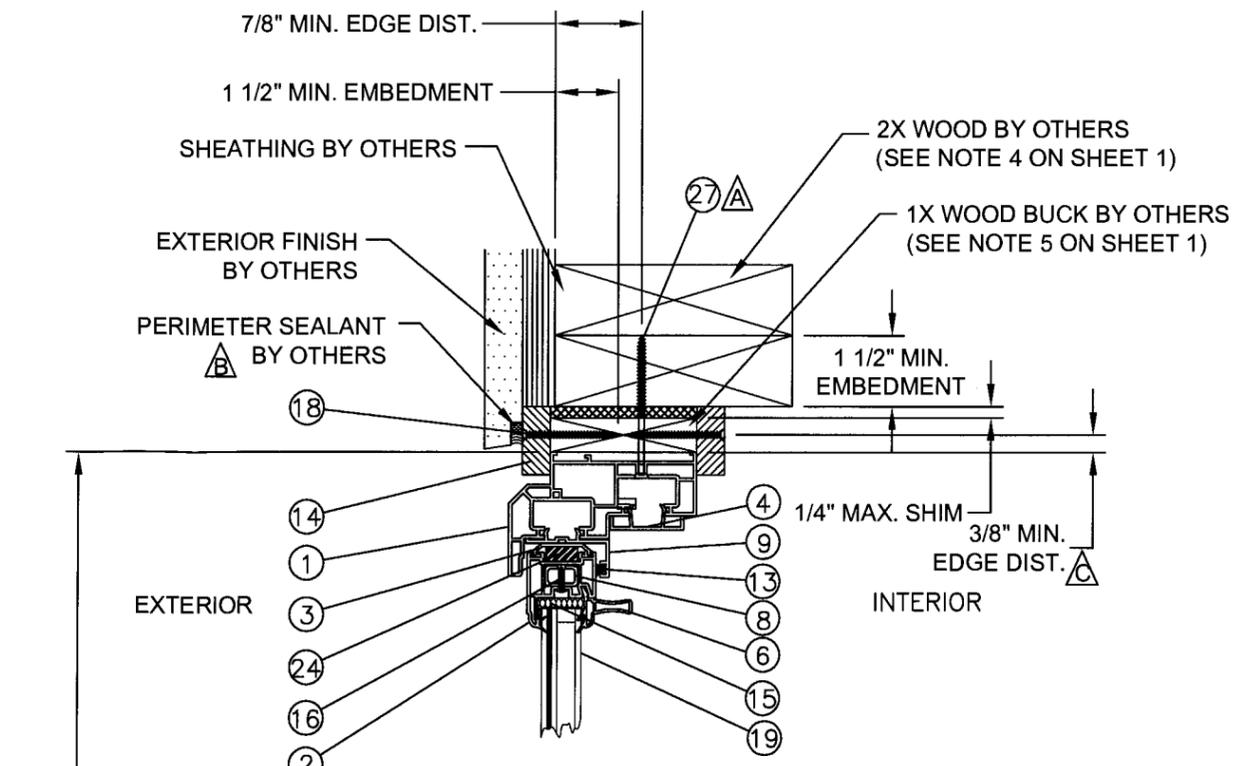

**K** VERTICAL SECTION  
WOOD FRAME SUBSTRATE

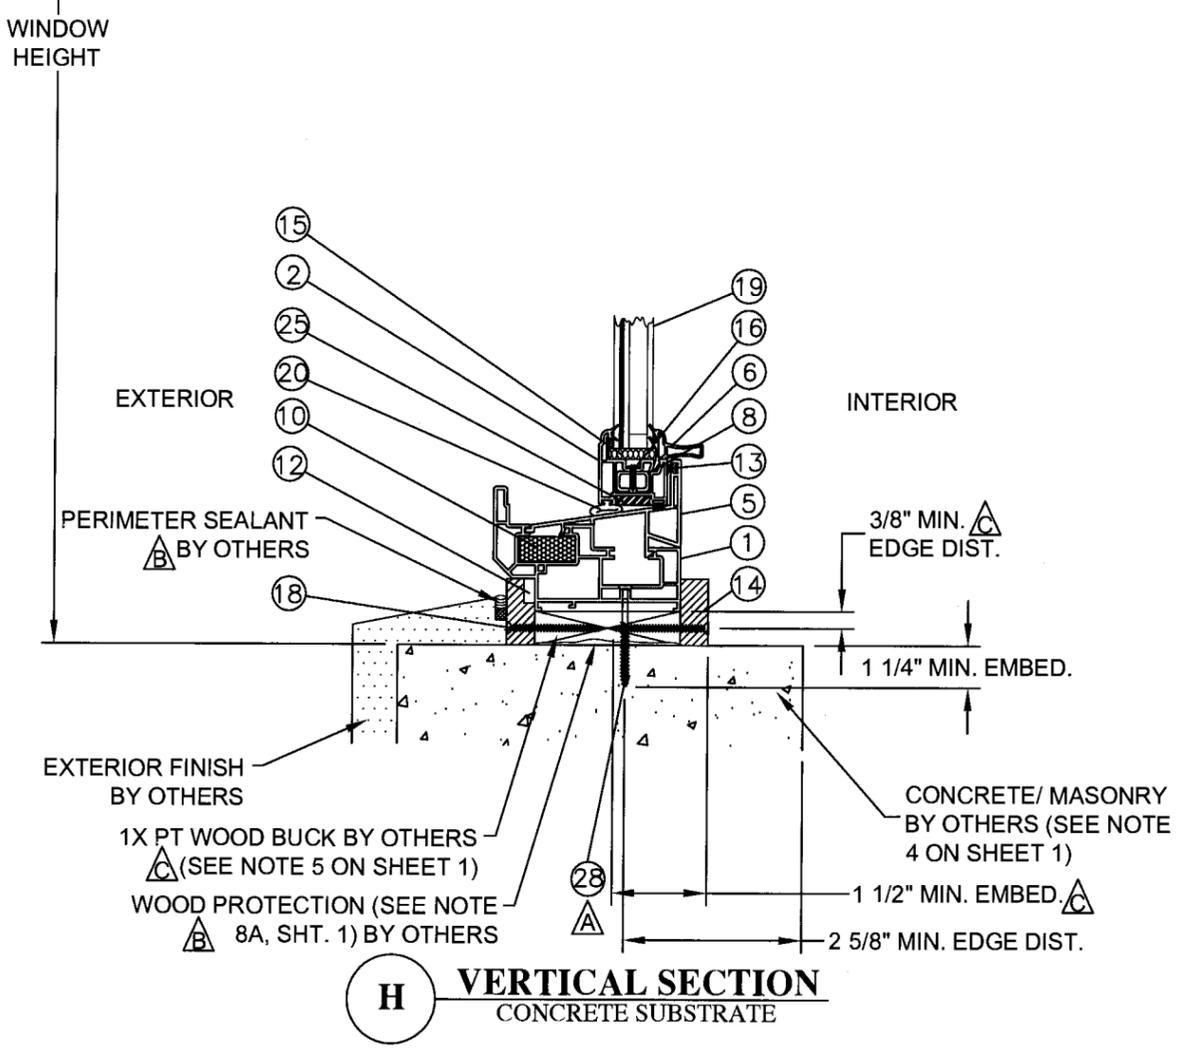

**H** VERTICAL SECTION  
CONCRETE SUBSTRATE

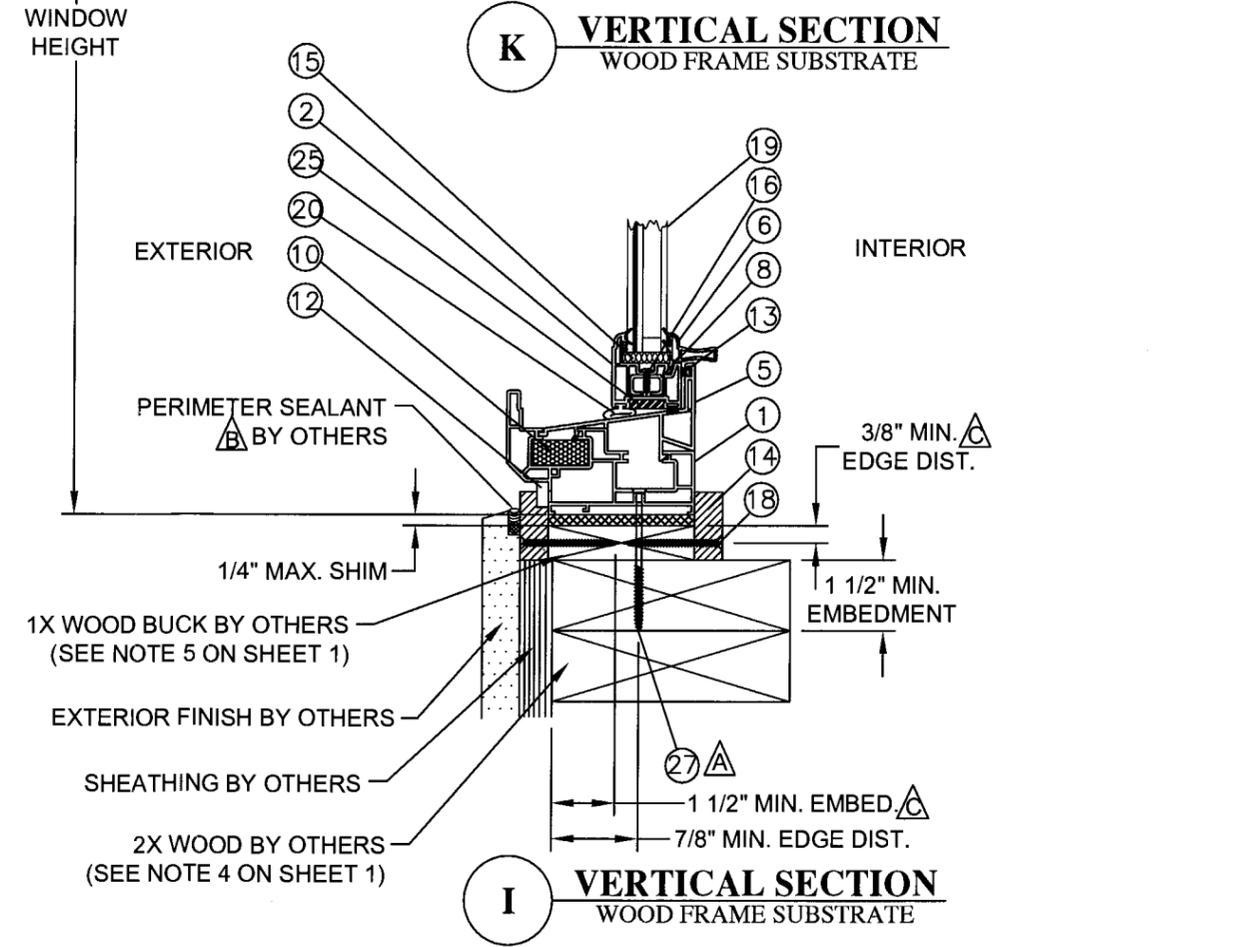

**I** VERTICAL SECTION  
WOOD FRAME SUBSTRATE

DATE:	4/1/09
APPROVED BY:	Paul E. Winter
PER MIAMI DADE COMMENTS 3/18/09	SMC
PER MIAMI DADE COMMENTS	BB
PER MIAMI DADE COMMENTS 2/18/09	SMC
REV	DATE

REGENCY PLUS  
1024 LOCUST GAP HIGHWAY  
MT. CARMEL, PA 17851

TITLE: SERIES 5305 TILT DOUBLE HUNG IMPACT VINYL WINDOW VERTICAL SECTIONS

DATE: 1/12/09  
DRAWING NO: RPLS0064  
SCALE: N.T.S.  
SHEET: 5 OF 8

PREPARED BY: PTC, LLC  
Phone: 321.690.1788  
Fax: 321.690.1789


PROJECT #308-1006-21

Paul E. Winter  
Florida P.E. No. 7993


PTC, LLC  
1565 N. Cogswell Street, Suite C25  
Rockledge, Florida 32955

FBPE Certificate of Authorization NO. 25935


Approved as complying with the  
Florida Building Code  
Date: 05/05/2009  
NOA#: 09-012-05  
Division: Division 2  
By: [Signature]

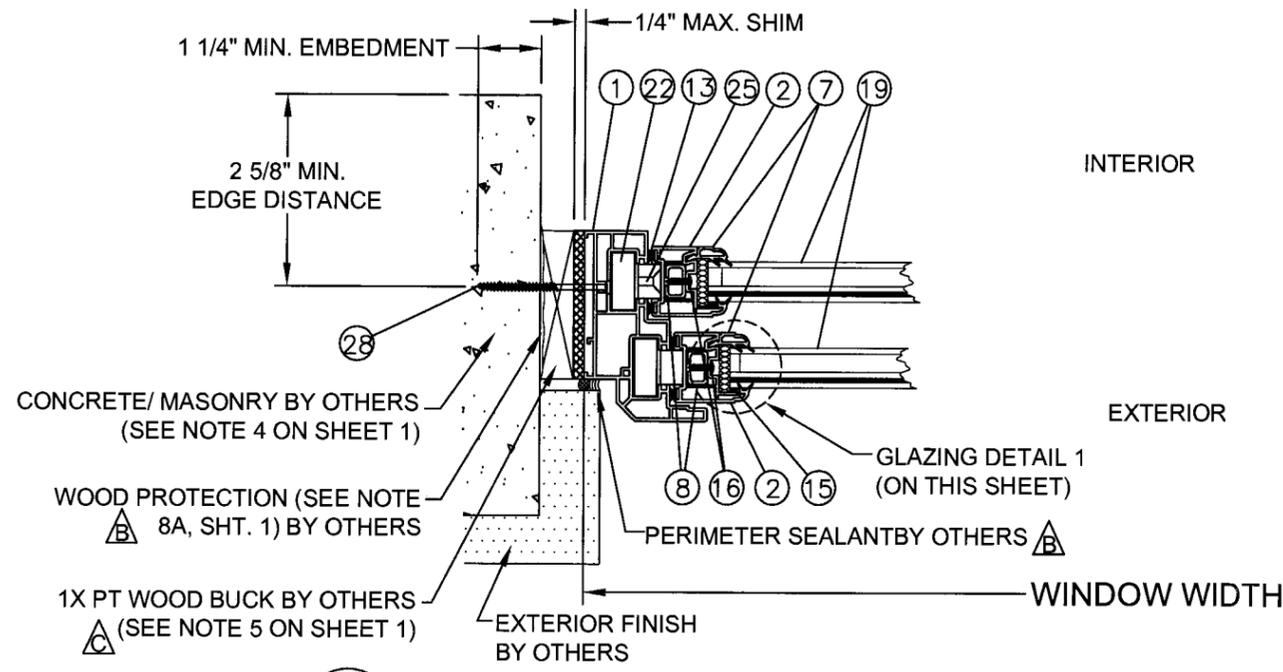


**F HORIZONTAL SECTION**  
CONCRETE / MASONRY SUBSTRATE

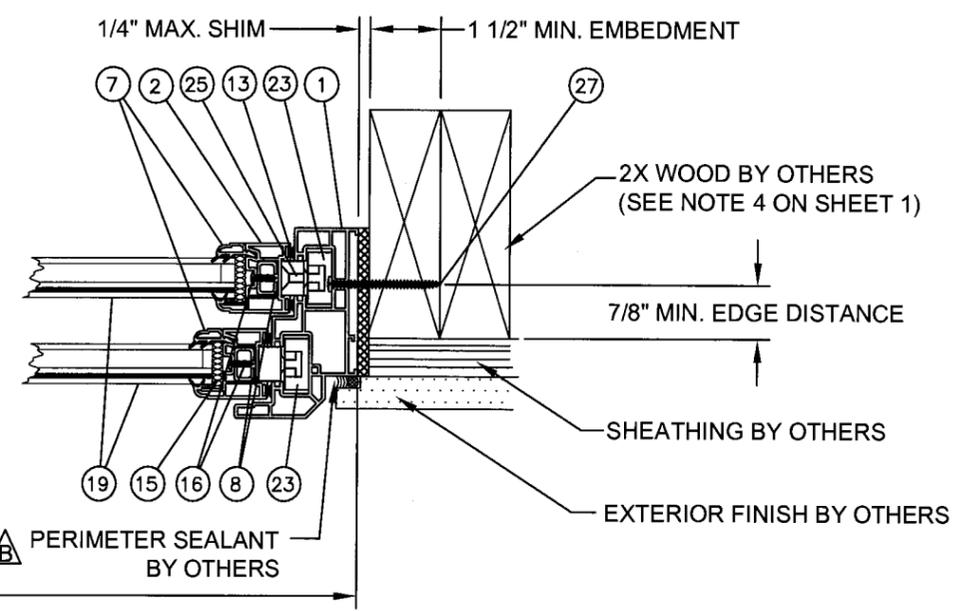


**G HORIZONTAL SECTION**  
WOOD FRAME SUBSTRATE

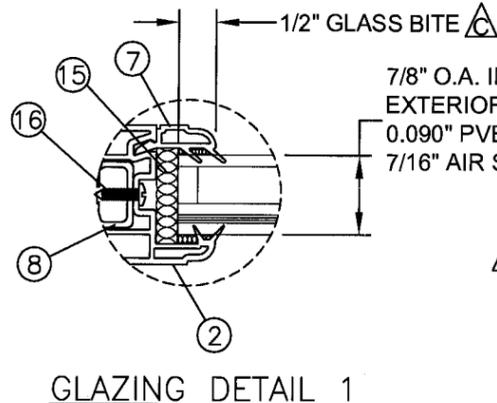

7/8" O.A. INSULATED GLASS CONSISTING OF:  $\Delta$   
 EXTERIOR LAMINATED GLASS: DSB ANNEALED GLASS,  
 0.090" PVB INTERLAYER "BUTACITE" BY DUPONT, DSB ANNEALED GLASS,  
 7/16" AIR SPACE, DESICCANT MATRIX STEEL SPACER, INTERIOR DSB TEMPERED GLASS

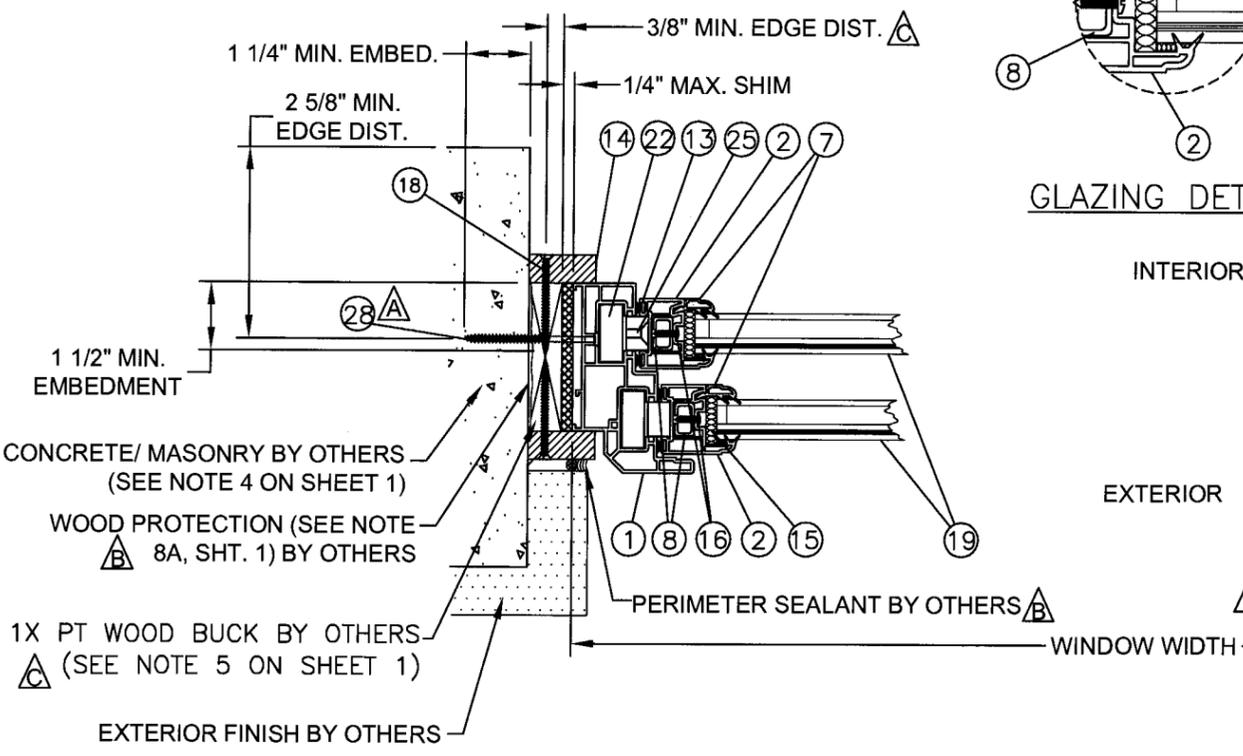

**J HORIZONTAL SECTION**  
CONCRETE / MASONRY SUBSTRATE

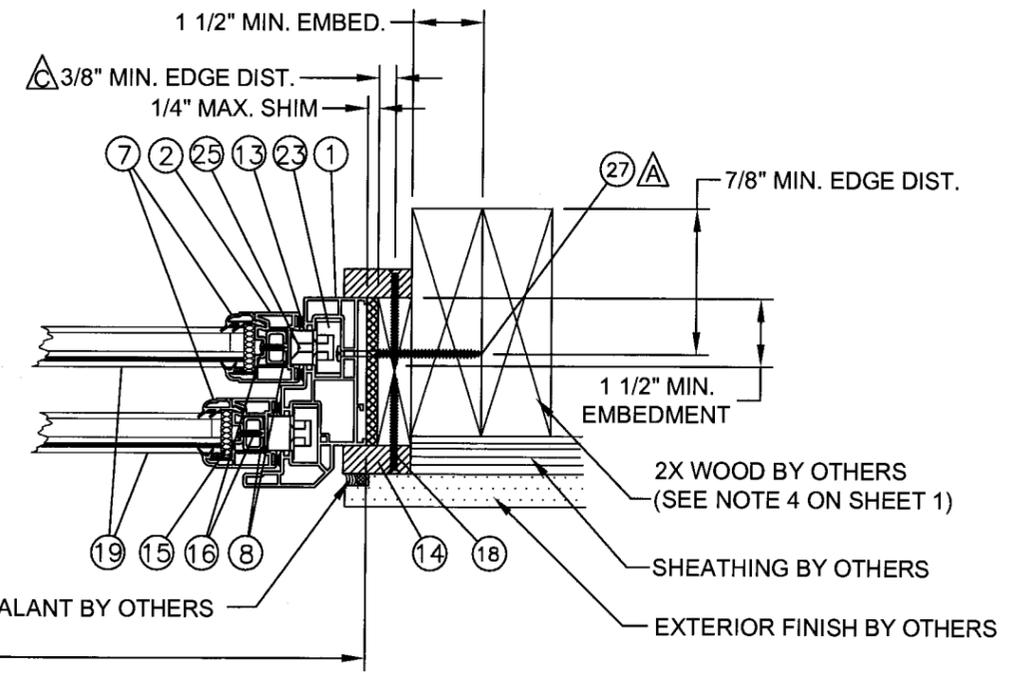

**K HORIZONTAL SECTION**  
WOOD FRAME SUBSTRATE

DATE:	4/1/09	SMC	BY
APPROVED BY:	Paul E. Winter	PER MIAMI DADE COMMENTS 3/18/09	BB
		PER MIAMI DADE COMMENTS 2/18/09	SMC
		PER MIAMI DADE COMMENTS 2/18/09	SMC
		DESCRIPTION	DATE

**REGENCY PLUS**  
 1024 LOCUST GAP HIGHWAY  
 MT. CARMEL, PA 17851

TITLE: SERIES 5305 TILT DOUBLE HUNG IMPACT VINYL WINDOW  
 HORIZONTAL SECTIONS

PREPARED BY: BB  
 SCALE: N.T.S.  
 REV: C

DATE: 1/12/09  
 DRAWING NO: RPLS0064  
 SHEET: 6 OF 8

**RPL**  
 P.T.C., LLC  
 Phone 321.690.1788  
 Fax 321.690.1789

PROJECT #308-1006 21

Paul E. Winter  
 Florida P.E. No. 22833

1535 N. Cogswell Street, Suite C25  
 Rockledge, Florida 32955  
 FBPE Certificate of Authorization NO. 25935


05/12/09

Approved as complying with the  
 Florida Building Code  
 Date 05/06/2009  
 NOA# 09-0122-06  
 Division Miami Dade Product Control  
 By *Maureen*















**BILL OF MATERIALS**

ITEM #	DESCRIPTION	MATERIAL	MANUFACTURER
1	MAIN FRAME	WHITE RIGID PVC	DOMINION PLASTICS
2	SASH PANEL FRAME	WHITE RIGID PVC	DOMINION PLASTICS
3	SASH COVER	WHITE RIGID PVC	DOMINION PLASTICS
4	PANEL STOP / FRAME COVER	WHITE RIGID PVC	DOMINION PLASTICS
5	SLOPED SILL COVER	WHITE RIGID PVC	DOMINION PLASTICS
6	GLAZING STOP WITH HANDLE	WHITE RIGID PVC	DOMINION PLASTICS
7	GLAZING STOP (OPERABLE SASH)	WHITE RIGID PVC	DOMINION PLASTICS
8	REINFORCEMENT	STEEL	ROLL TECH INDUSTRIES
9	POCKET COVER #1	WHITE RIGID PVC	DOMINION PLASTICS
10	BUG STRIP	VINYL	----
11	INTERLOCK COVER	WHITE RIGID PVC	DOMINION PLASTICS
12	WEEP COVER	NYLON	CUSTOM CRAFT
13	0.210" / 0.187" x 0.300" CENTER FIN WEATHERSTRIP	----	ULTRAFAB
14	3/4" X 1 1/2" PARTING STOP (SEE NOTE 8A, SHT. 1) G= 0.55 MIN. $\triangle$	PT PINE WOOD $\triangle$	----
15	SIKAFLEX 552 SILICONE	SILICONE	SIKA CORP.
16	#8 X 1/2" TEK SCREW	STEEL	----
17	CAM TYPE SWEEP LOCK	STEEL	TRUTH HARDWARE
18	#8 WOOD SCREW	STEEL	----
19	7/8" O.A. INSULATED GLASS CONSISTING OF: DSB ANNEALED GLASS, 0.090" INTERLAYER BY DUPONT, DSB ANNEALED GLASS, AIR SPACE, DSB TEMPERED GLASS	GLASS	----
20	BULB VINYL WEATHERSTRIP	VINYL	UNIVERSAL POLYMERE & RUBBER
21	FACE MOUNTED KEEPER	STEEL	TRUTH HARDWARE
22	SPRING BALANCE	----	BSI HARDWARE
23	LOCKING TILT SHOE	NYLON	BSI BALANCE SYSTEMS
24	TILT LATCH	ZINC	VISION INDUSTRIES
25	PIVOT BAR	METAL	VISION INDUSTRIES
26	SIKAFLEX 552 BACKBEDDING	SILICONE	SIKA CORP.
27	#12 WOOD SCREW	STEEL	----
28	3/16" ITW TAPCON SCREWS	STEEL	ITW

⑰ **SASH LOCK**  
STEEL  
TYP. WALL THICKNESS NA

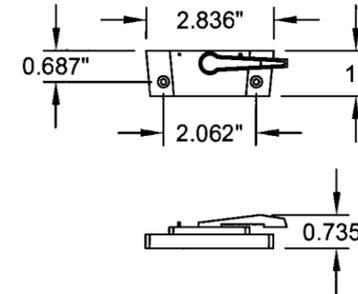

⑳ **LOCKING TILT SHOE**  
NYLON  
TYP. WALL THICKNESS NA

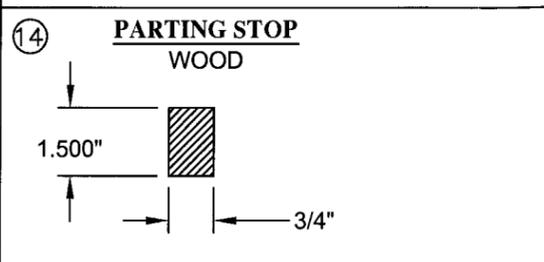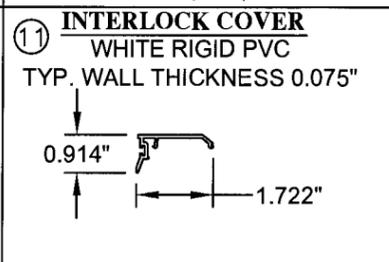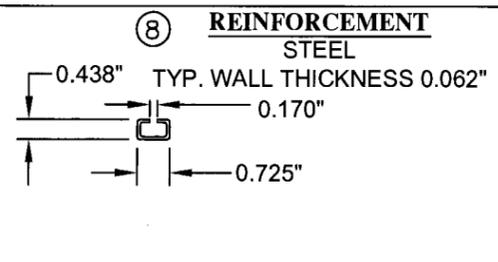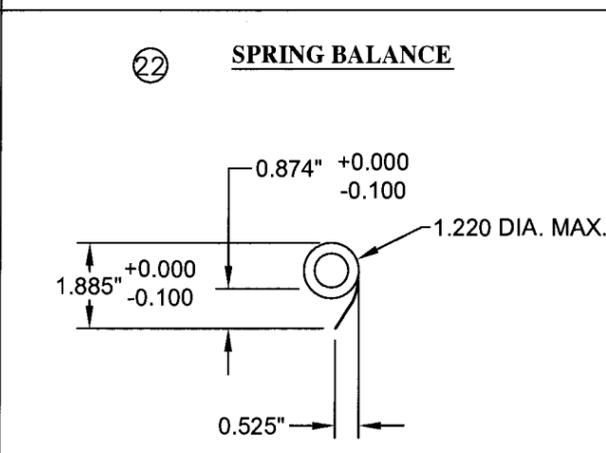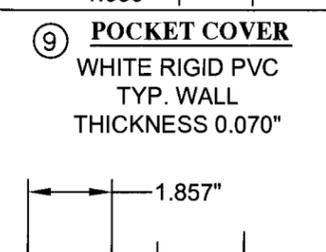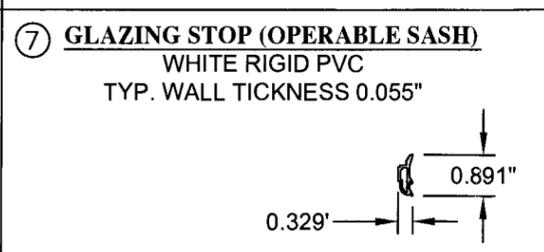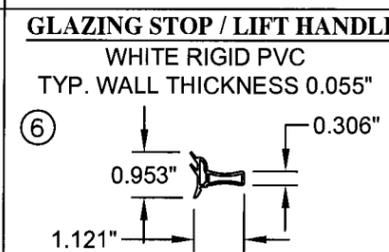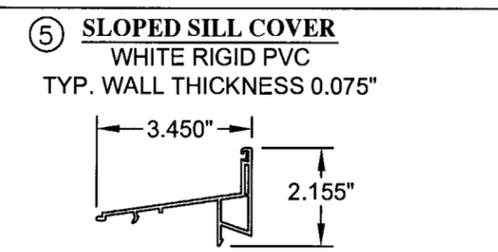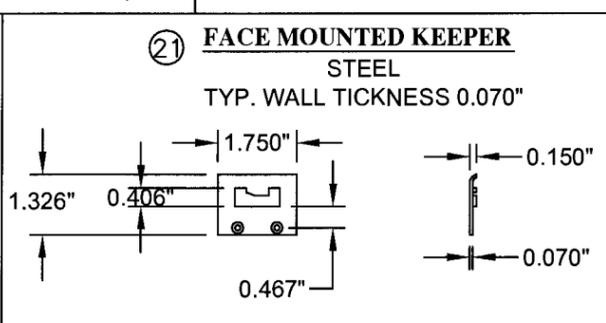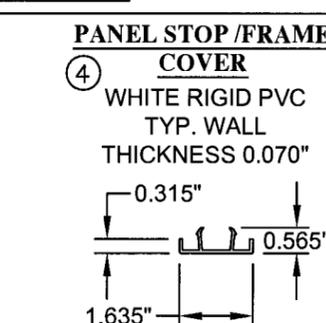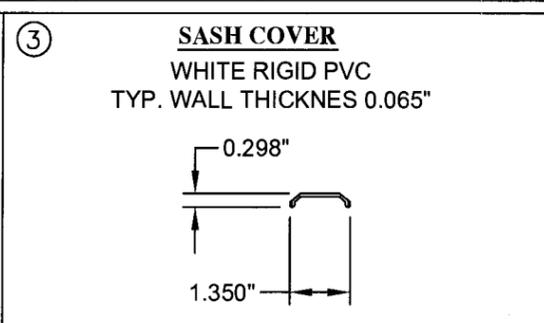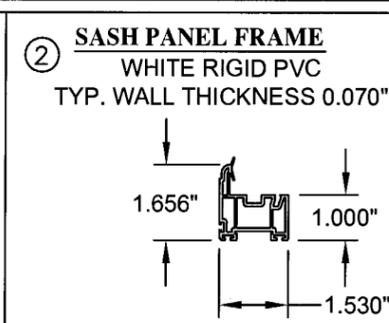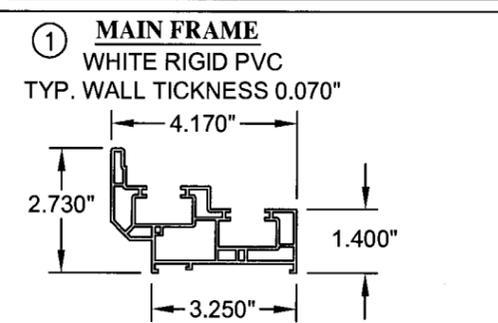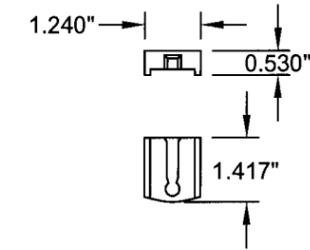

DATE: 4/1/09

APPROVED BY: Paul E. Winter

SMC	4/1/09
BB	03/12/09
REV	DESCRIPTION
C	PER MIAMI DADE COMMENTS 3/18/09
B	PER MIAMI DADE COMMENTS

REGENCY PLUS  
1024 LOCUST GAP HIGHWAY  
MT. CARMEL, PA 17851

TITLE: SERIES 5305 TILT DOUBLE HUNG IMPACT VINYL WINDOW  
BILL OF MATERIALS & COMPONENTS

DATE: 1/12/09  
DRAWING NO: RPLS0064  
SHEET: 7 OF 8

PREPARED BY: BB  
SCALE: N.T.S.  
REV: C

**PTE**  
PTC, LLC  
Phone 321.650.1788  
Fax 321.650.1789

PROJECT #308-1006.21


Paul E. Winter  
Florida P.E. No. 22663

PTC, LLC  
1535 N. Cogswell Street, Suite C25  
Rockledge, Florida 32955  
FBPE Certificate of Authorization No. 25935



4/1/09

Approved as complying with the Florida Building Code  
Date 05/06/2009  
NOA# 09-0122105  
Miami Dade Product Control Division  
By *Manuel Diaz*

24 **TILT LATCH**  
ZINCTYP. WALL TICKNESS NA

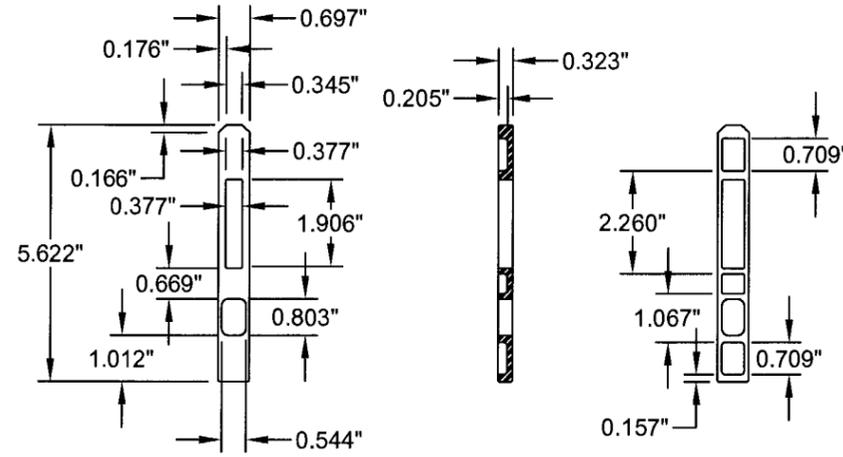

25 **PIVOT BAR**  
METALTYP. WALL TICKNESS NA

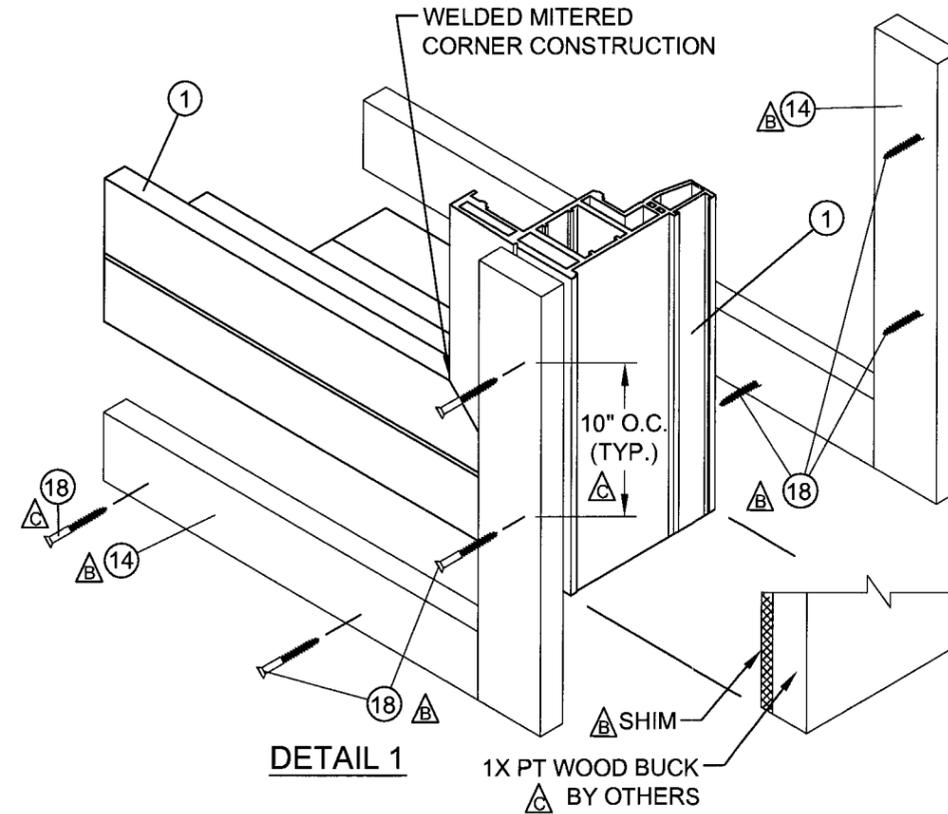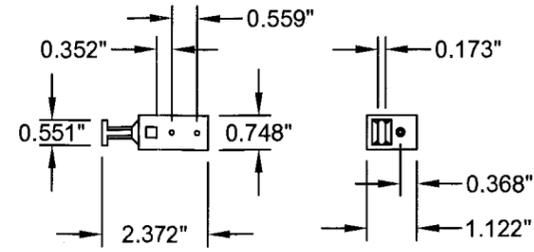

NOTE:  
PARTING STOP EXTERIOR PERIMETER  
TO BE SEALED TO 1X PT WOOD BUCK  
WITH SIKA 551 SILICONE  $\triangle$

DATE:	4/1/09
APPROVED BY:	Paul E. Winter
PER MIAMI DADE COMMENTS	3/18/09
PER MIAMI DADE COMMENTS	03/12/09
REV	DESCRIPTION
C	
B	
BY	DATE
SMC	4/1/09
BB	03/12/09
BY	DATE

**REGENCY PLUS**  
1024 LOCUST GAP HIGHWAY  
MT. CARMEL, PA 17851

TITLE: SERIES 5305 TILT DOUBLE HUNG IMPACT VINYL WINDOW COMPONENTS & CORNER DETAIL

PREPARED BY: **FIC**  
PTC, LLC  
Phone 321.690.1788  
Fax 321.690.1789

DATE: 1/12/09  
DRAWING NO: RPLS0064  
SCALE: N.T.S.  
REV: C

SHHEET: 8 OF 8

PROJECT #308-1006.21

Paul E. Winter  
Florida P.E. No. 22693

*Paul E. Winter*

1535 N. Zogswell Street, Suite C25  
Rockledge, Florida 32955  
FBPE Certificate of Authorization NO. 25935

Approved as complying with the  
Florida Building Code  
Date 05/06/2009  
NO. # 04-0122-05  
Miami Dade Product Control  
Division  
By *William Davis*