

NOTICE OF ACCEPTANCE (NOA)www.miamidade.gov/building/home/asp

Arch Windows, LLC dba AWP
8130 NW 74th Avenue
Medley, FL 33166

SCOPE:

This NOA is being issued under the applicable rules and regulations governing the use of construction materials. The documentation submitted has been reviewed by Miami-Dade County Product Control Section and accepted by the Board of Rules and Appeals (BORA) to be used in Miami Dade County and other areas where allowed by the Authority Having Jurisdiction (AHJ).

This NOA shall not be valid after the expiration date stated below. The Miami-Dade County Product Control Section (In Miami Dade County) and/or the AHJ (in areas other than Miami Dade County) reserve the right to have this product or material tested for quality assurance purposes. If this product or material fails to perform in the accepted manner, the manufacturer will incur the expense of such testing and the AHJ may immediately revoke, modify, or suspend the use of such product or material within their jurisdiction. BORA reserves the right to revoke this acceptance, if it is determined by Miami-Dade County Product Control Section that this product or material fails to meet the requirements of the applicable building code.

This product is approved as described herein, and has been designed to comply with the Florida Building Code, including the High Velocity Hurricane Zone.

DESCRIPTION: Series "4100" Aluminum Sliding Glass Door(Steel-reinforced)-L.M.I.

APPROVAL DOCUMENT: Drawing No. W09-17, titled "Series 4100 Alum Sld. Glass Door (L.M.I.)", sheets 1 through 6 of 6, dated JAN 11, 2011, prepared by AL-Farooq Corporation, signed and sealed by Javad Ahmad, P.E., bearing the Miami-Dade County Product Control Revision stamp with the Notice of Acceptance number and expiration date by the Miami-Dade County Product Control Section.

MISSILE IMPACT RATING: Large Missile Impact Resistant

Limitation:

1. OX, XO or OXO configurations.

LABELING: Each unit shall bear a permanent label with the manufacturer's name or logo, city, state and following statement: "Miami-Dade County Product Control Approved", unless otherwise noted herein.

RENEWAL of this NOA shall be considered after a renewal application has been filed and there has been no change in the applicable building code negatively affecting the performance of this product.

TERMINATION of this NOA will occur after the expiration date or if there has been a revision or change in the materials, use, and/or manufacture of the product or process. Misuse of this NOA as an endorsement of any product, for sales, advertising or any other purposes shall automatically terminate this NOA. Failure to comply with any section of this NOA shall be cause for termination and removal of NOA.

ADVERTISEMENT: The NOA number preceded by the words Miami-Dade County, Florida, and followed by the expiration date may be displayed in advertising literature. If any portion of the NOA is displayed, then it shall be done in its entirety.

INSPECTION: A copy of this entire NOA shall be provided to the user by the manufacturer or its distributors and shall be available for inspection at the job site at the request of the Building Official.

This NOA revises NOA # 09-0324.16 (AWP, LLC) and consists of this page 1 and evidence pages E-1 & E-2, as well as approval document mentioned above.

The submitted documentation was reviewed by **Ishaq I. Chanda, P.E.**



NOA No 10-0804.04
Expiration Date: July 08, 2014
Approval Date: March 31, 2011
Page 1

3/31/11

NOTICE OF ACCEPTANCE: EVIDENCE SUBMITTED

A. DRAWINGS (transferred from file # 09-0324.16)

1. Manufacturer's die drawings and sections.
2. Drawing No. **W09-17**, titled "Series 4100 Alum Sld. Glass Door (L.M.I.)", sheets 1 through 6 of 6, dated JAN 11, 2011, prepared by AL-Farooq Corporation, signed and sealed by Javad Ahmad, P.E.

B. TESTS (transferred from file # 09-0324.16)

1. Test reports on:
 - 1) Air Infiltration Test, per FBC, TAS 202-94
 - 2) Uniform Static Air Pressure Test, Loading per FBC TAS 202-94
 - 3) Water Resistance Test, per FBC, TAS 202-94
 - 4) Large Missile Impact Test per FBC, TAS 201-94
 - 5) Cyclic Wind Pressure Loading per FBC, TAS 203-94
 - 6) Forced Entry Test, per FBC 2411 3.2.1, TAS 202-94

Along with marked-up drawings and installation diagram of an OXO aluminum Sliding glass door, prepared by Fenestration Testing Lab., Test Report No. **FTL-5766**, dated 01/23/09, signed and sealed by Michael S. Wenzel, P. E.

C. CALCULATIONS (transferred from file # 09-0324.16)

1. Anchor verification calculations and structural analysis, complying with FBC-2007, prepared by Al Farooq Corporation, dated 03/19/09 and last revised on June 03, 2010, signed and sealed by Javad Ahmad, P.E
2. Glazing complies w/ ASTM E-1300-02 & -04

D. QUALITY ASSURANCE


1. Miami Dade Building and Neighborhood Compliance Department (BNC).

E. MATERIAL CERTIFICATIONS

1. Notice of Acceptance No. **08-0514.08** issued to Solutia, for "Vanceva Composite interlayer", expiring on 12/11/2013.

F. STATEMENTS

1. Statement letter of conformance and letter of no financial interest, prepared by Al Farooq Corporation, dated 05/07/10, signed and sealed by Javad Ahmad, P.E.
2. Statement letter of compliance, part of the above referenced test reports.
3. Sales agreement between AWP, LLC (seller) and Arch Aluminum & Glass Enterprise, a Delaware Corp (purchaser) dated Jan 14, 2010, signed by Leon J. Silverstein and Wm, Robert Wright, respectively.
4. Certificate of registration of Arch Windows, LLC in State of Delaware, dated 02-03-10.
5. Certificate of registration of Arch Windows, LLC (Delaware) in State of Florida dated 02-04, 2010, managed by Arch Intermediate Holding, LLC.

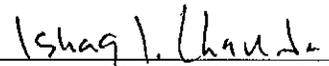

Ishaq I. Chanda, P.E.

Product Control Examiner

NOA No 10-0804.04

Expiration Date: July 08, 2014

Approval Date: March 31, 2011


NOTICE OF ACCEPTANCE: EVIDENCE SUBMITTED

F STATEMENTS (continue):

6. Florida Dept of State, listing of Arch Window, LLC (Foreign Limited Liability Co.), managed by Arch Intermediate Holding, LLC, Tamarac, Fl.
7. Statement letter dated March 25, 2010, issued by Arch Windows, LLC that it has purchased all assets of AWP, LLC effectively Jan 29, 2010, signed by Leon Silverstein, President/CEO (Arch Windows, LLC).

G. OTHER


1. This NOA revises NOA # 09-0324.16 (AWP, LLC), expired on July 08, 2014.

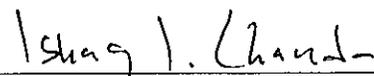

Ishaq I. Chanda, P.E.
Product Control Examiner
NOA No 10-0804.04
Expiration Date: July 08, 2014
Approval Date: March 31, 2011

(OX, XO) INCHES	(OXO) INCHES	DOOR HEIGHT INCHES	EXT. (+)	INT. (-)
72	108	80	60.0	60.0
80	120		60.0	60.0
88	132		60.0	60.0
96	144		60.0	60.0
104	156		60.0	60.0
112	168	60.0	60.0	
72	108	84	60.0	60.0
80	120		60.0	60.0
88	132		60.0	60.0
96	144		60.0	60.0
104	156		60.0	60.0
72	108	90	60.0	60.0
80	120		60.0	60.0
88	132		60.0	60.0
96	144		60.0	60.0
104	156		60.0	60.0
72	108	95-1/2	60.0	60.0
80	120		60.0	60.0
88	132		60.0	60.0
96	144		60.0	60.0

VERIFY COMPLIANCE WITH EGRESS LIMITATIONS WHERE REQUIRED.

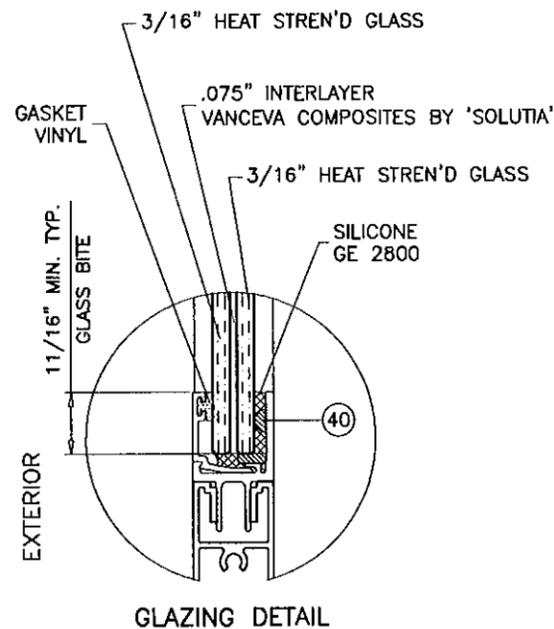

DAYLITE OPENINGS:

D.L.O. HEIGHT = PANEL HEIGHT - 6.625"
D.L.O. WIDTH (FIX. PANEL) = PANEL WIDTH - 5.750"
D.L.O. WIDTH (OPER. PANEL) = PANEL WIDTH - 6.000"
PANEL HEIGHT = DOOR HEIGHT - 0.875"

SERIES 4100 ALUMINUM SLIDING GLASS DOOR

DESIGN LOAD CAPACITY FOR DOORS TO BE AS PER CHARTS SHOWN ABOVE.

THIS PRODUCT HAS BEEN DESIGNED AND TESTED TO COMPLY WITH THE REQUIREMENTS OF THE FLORIDA BUILDING CODE 2007 EDITION INCLUDING HIGH VELOCITY HURRICANE ZONE (HVHZ).


WOOD BUCKS BY OTHERS, MUST BE ANCHORED PROPERLY TO TRANSFER LOADS TO THE STRUCTURE.

ANCHORS SHALL BE AS LISTED, SPACED AS SHOWN ON DETAILS, ANCHORS EMBEDMENT TO BASE MATERIAL SHALL BE BEYOND WALL DRESSING OR STUCCO.

ANCHORING OR LOADING CONDITIONS NOT SHOWN IN THESE DETAILS ARE NOT PART OF THIS APPROVAL.

A LOAD DURATION INCREASE IS USED IN DESIGN OF ANCHORS INTO WOOD ONLY.


MATERIALS INCLUDING BUT NOT LIMITED TO STEEL/METAL SCREWS, THAT COME INTO CONTACT WITH OTHER DISSIMILAR MATERIALS SHALL MEET THE REQUIREMENTS OF 2007 FLORIDA BLDG. CODE SECTION 2003.8.4.

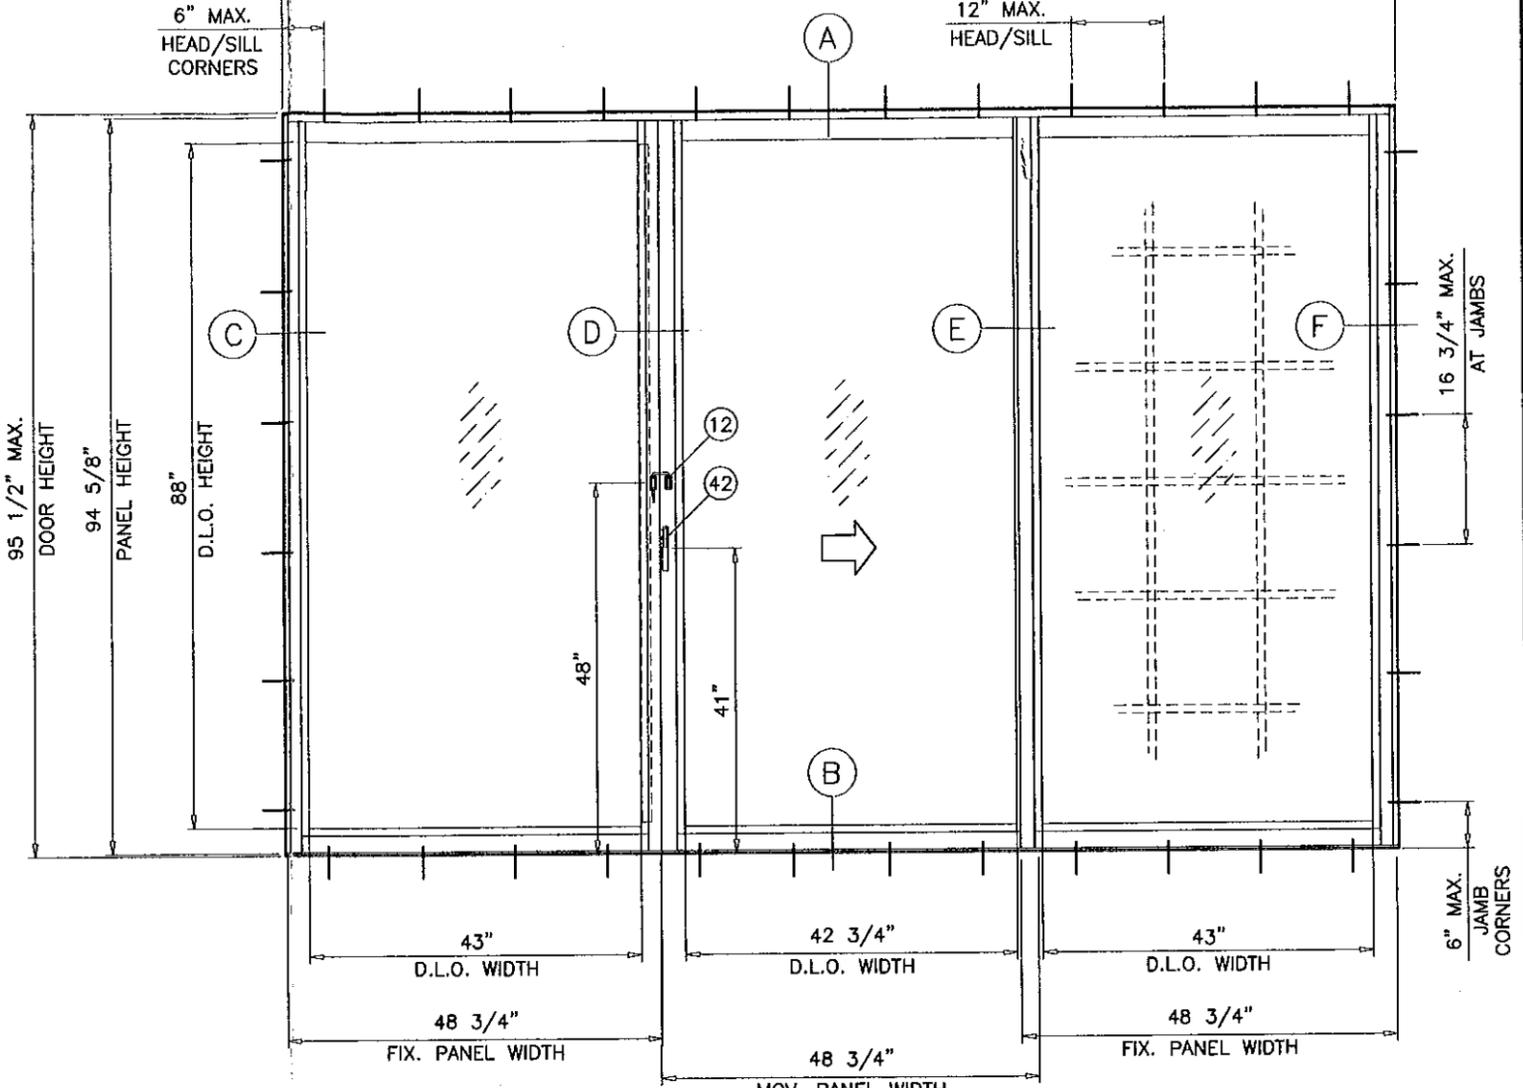

TYPICAL ELEVATION TESTED UNITS

NOTE:
GLASS CAPACITIES ON THIS SHEET ARE BASED ON ASTM E1300-04 (3 SEC. GUSTS) AND FLORIDA BUILDING COMMISSION DECLARATORY STATEMENT DCA05-DEC-219

THESE DOORS ARE RATED FOR LARGE & SMALL MISSILE IMPACT AND REQUIRE NO SHUTTERS.

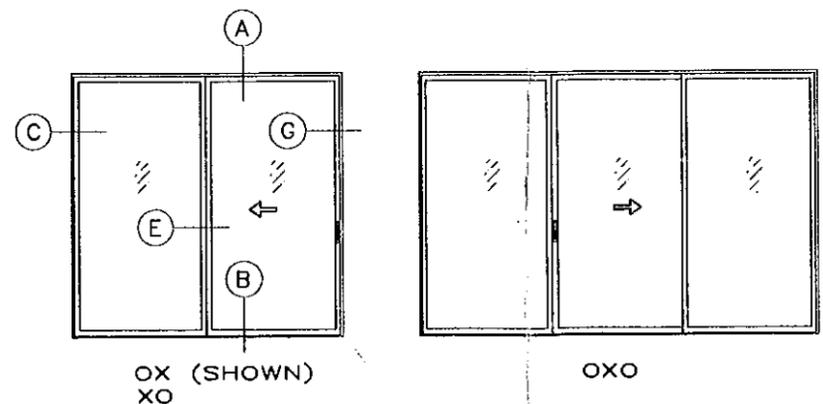

APPROVED CONFIGURATIONS

Engr: JAYAD AHMAD
CIVIL
FLA. PE # 70592
C.A.N. 3638
JAN 11 2011







PRODUCT REVISED
as complying with the Florida Building Code
Acceptance No. 10-0804-04
Expiration Date 02/08/2014
By: *Shag J. Khan*
Miami Dade Product Council

AL-FAROOQ CORPORATION
ENGINEERS & PRODUCT DEVELOPMENT
1235 S.W. 87 AVE
MIAMI, FLORIDA 33174
TEL (305) 264-8100 FAX (305) 262-6978
COMP-ANL\W09

SERIES 4100 ALUM SLD. GLASS DOOR (L.M.I.)
ARCH WINDOWS, LLC dba AWP
8130 N.W. 74TH AVE.
MEDLEY, FL. 33166
TEL (305) 887-2646 FAX (305) 883-1309

no	date	description	by
A	06.10.09	REV. PER BCCO COMMENTS	
B	05.27.10	MANUF. NAME REVISED	
C	11.18.10	REV. PER BCCO COMMENTS	

revisions:
date: 03-11-09
scale: 1/2"=1'-0"
dr. by: HAMID
chk. by:
drawing no. W09-17
sheet 1 of 6

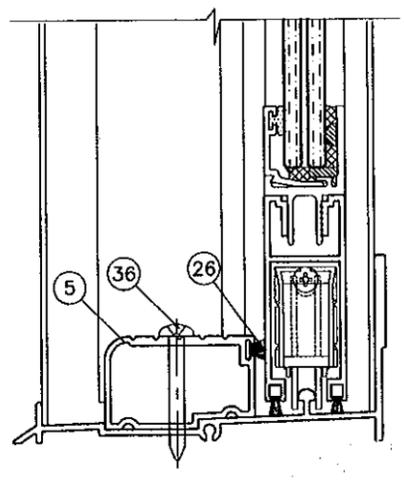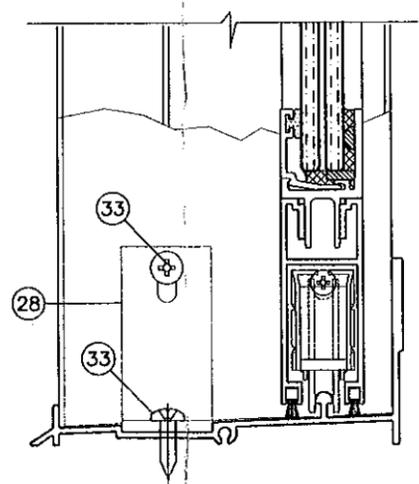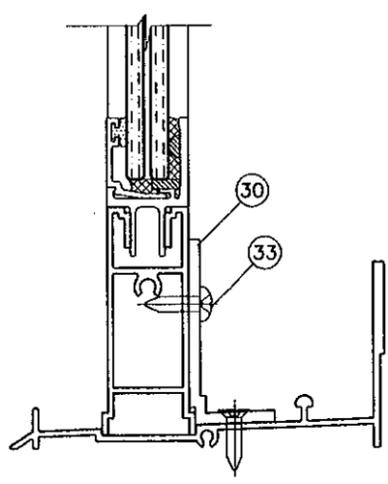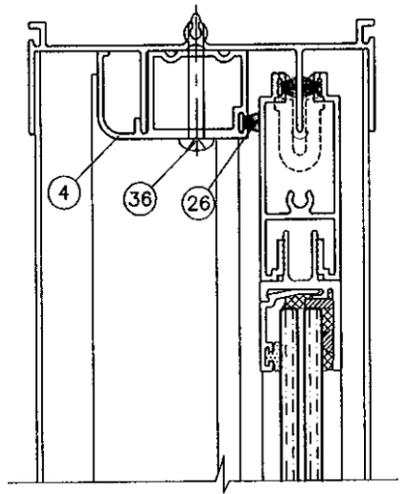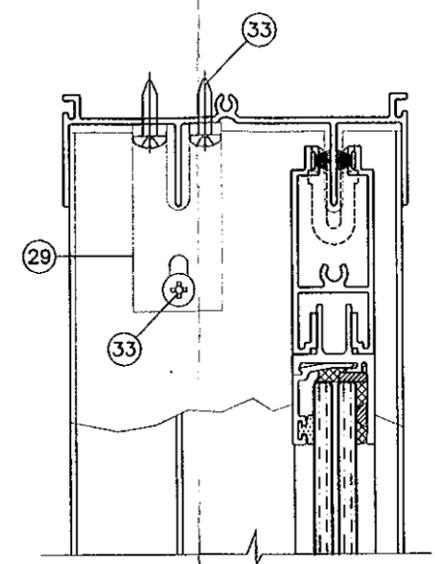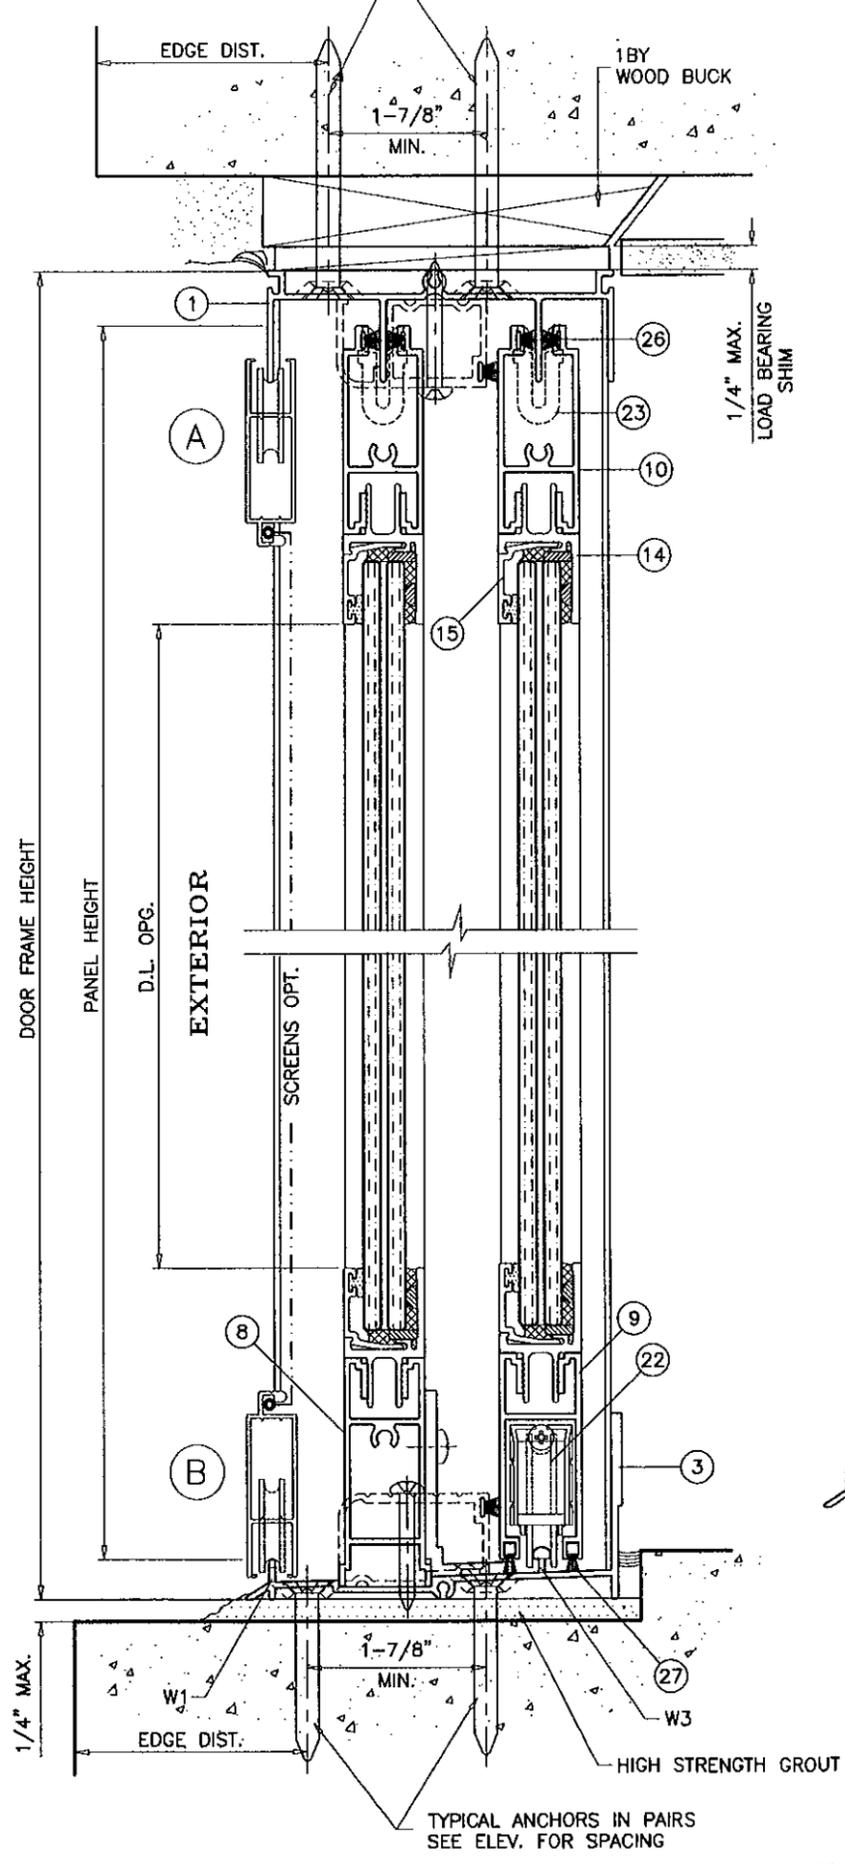

Engr: JAVAD AHMAD
CIVIL
FLA. PE # 70592
C.A.N. 3530

JA

JAN 11 2011

PRODUCT REVISED
as complying with the Florida
Building Code
Acceptance No. 10-0804.04
Expiration Date 07/08/2014

By *Shahid Chaudhry*
Miami Dade Product Control


AL-FAROOQ CORPORATION
ENGINEERS & PRODUCT DEVELOPMENT
1235 S.W. 87 AVE
MIAMI, FLORIDA 33174
TEL. (305) 264-8100 FAX (305) 262-6978
COMP-ANL\W09

SERIES 4100 ALUM SLD. GLASS DOOR (L.M.I.)
ARCH WINDOWS, LLC dba AWP
8130 N.W. 74TH AVE.
MEDLEY, FL. 33166
TEL. (305) 887-2646 FAX (305) 883-1309


no	date	description	BY
A	06.10.09	REV. PER BCCO COMMENTS	
B	05.27.10	MANUF. NAME REVISED	
C	11.18.10	REV. PER BCCO COMMENTS	

date: 03-11-09
scale: 1/2" = 1"
dr. by: HAMID
chk. by:


drawing no.
W09-17
sheet 2 of 6

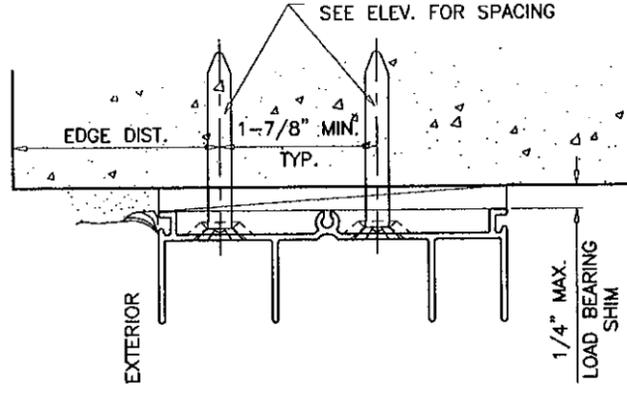


TYPICAL ANCHORS IN PAIRS
SEE ELEV. FOR SPACING

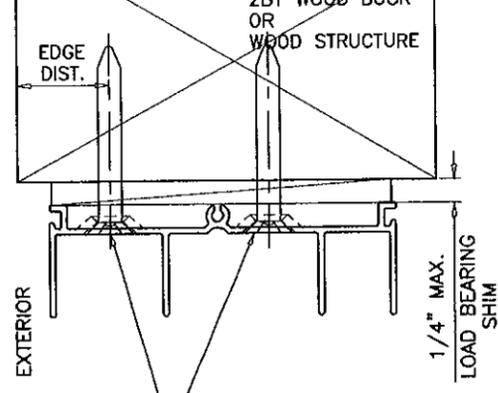

TYPICAL ANCHORS IN PAIRS
SEE ELEV. FOR SPACING

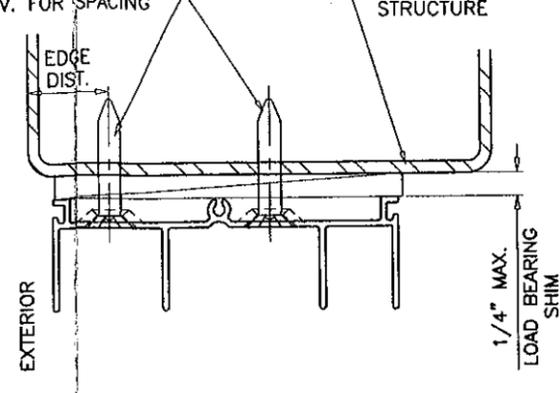

TYPICAL ANCHORS IN PAIRS
SEE ELEV. FOR SPACING

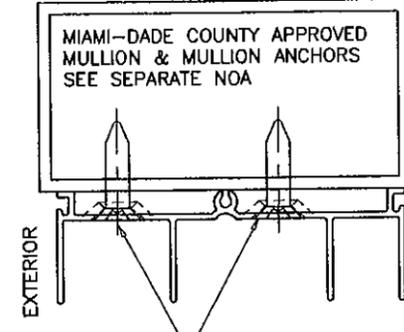

WOOD BUCKS AND METAL STRUCTURE NOT BY AWP WDW.
MUST SUSTAIN LOADS IMPOSED BY GLAZING SYSTEM
AND TRANSFER THEM TO THE BUILDING STRUCTURE.

TYPICAL ANCHORS: SEE ELEV. FOR SPACING

1/4" DIA. TAPCONS BY 'ITW'

1/4" DIA. ULTRACON BY 'ELCO' (Fu=177 KSI, Fy=155 KSI)

INTO 2BY WOOD BUCKS OR WOOD STRUCTURES

1-3/8" MIN. PENETRATION INTO WOOD

THRU 1BY BUCKS INTO CONC. OR MASONRY

1-1/4" MIN. EMBED INTO CONC. OR MASONRY

DIRECTLY INTO CONC. OR MASONRY

1-1/4" MIN. EMBED INTO CONC. OR MASONRY

#14 SMS OR SELF DRILLING SCREWS (GRADE 2 CRS)

INTO METAL STRUCTURES

STEEL : 12 GA. MIN. (Fy = 36 KSI MIN.)

ALUMINUM : 1/8" THK. MIN. (6063-T5 MIN.)

(STEEL IN CONTACT WITH ALUMINUM TO BE PLATED OR PAINTED)

#12 SMS OR SELF DRILLING SCREWS

INTO MIAMI-DADE COUNTY APPROVED MULLIONS (MIN. THK. = 1/8")

(NO SHIM SPACE)

TYPICAL EDGE DISTANCE

INTO CONCRETE AND MASONRY = 2-1/2" MIN.

INTO WOOD STRUCTURE = 1" MIN.

INTO METAL STRUCTURE = 1/2" MIN.

CONCRETE f'c = 3000 PSI MIN.
MASONRY f'm = 2000 PSI MIN.

Engr. JAVAD AHMAD
CIVIL
FLA. PE # 70592
C.A.N. 3538
JAN 11 2011

PRODUCT REVISED
as complying with the Florida
Building Code
Acceptance No. 10-0804.04
Expiration Date 07/08/2014
By: *[Signature]*
Miami Dade Product Control


no	date	description	REV. PER BCCO COMMENTS	MANUF. NAME REVISED	REV. PER BCCO COMMENTS
A	06.10.09				
B	05.27.10				
C	11.18.10				

date: 03-11-09
scale: 1/2" = 1"
dr. by: HAMID
chk. by:


drawing no.
W09-17
sheet 3 of 6

SERIES 4100 ALUM SLD. GLASS DOOR (L.M.I.)
ARCH WINDOWS, LLC dba AWP
8130 N.W. 74TH AVE.
MEDLEY, FL. 33166
TEL. (305) 887-2646 FAX (305) 883-1309

AL-FAROOQ CORPORATION
ENGINEERS & PRODUCT DEVELOPMENT
1235 S.W. 87 AVE
MIAMI, FLORIDA 33174
TEL. (305) 264-8100 FAX (305) 262-6978
COMP-ANL W09

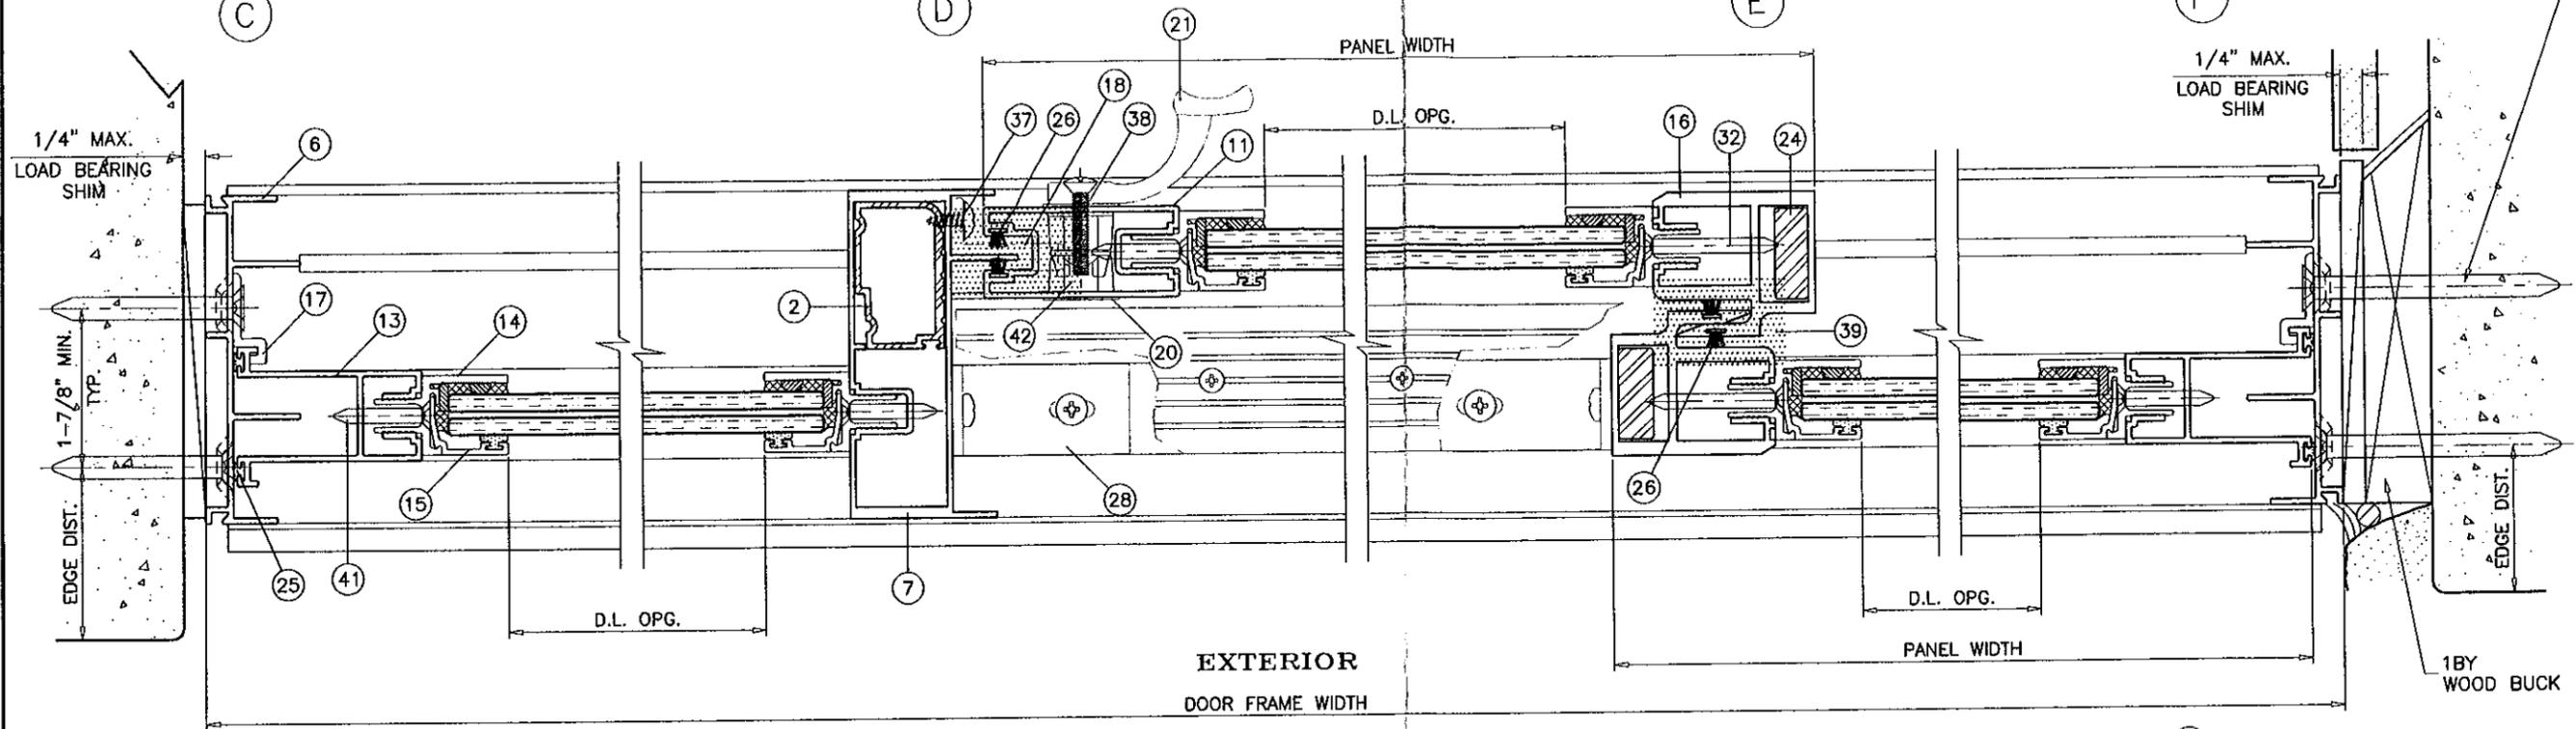


EXTERIOR
DOOR FRAME WIDTH

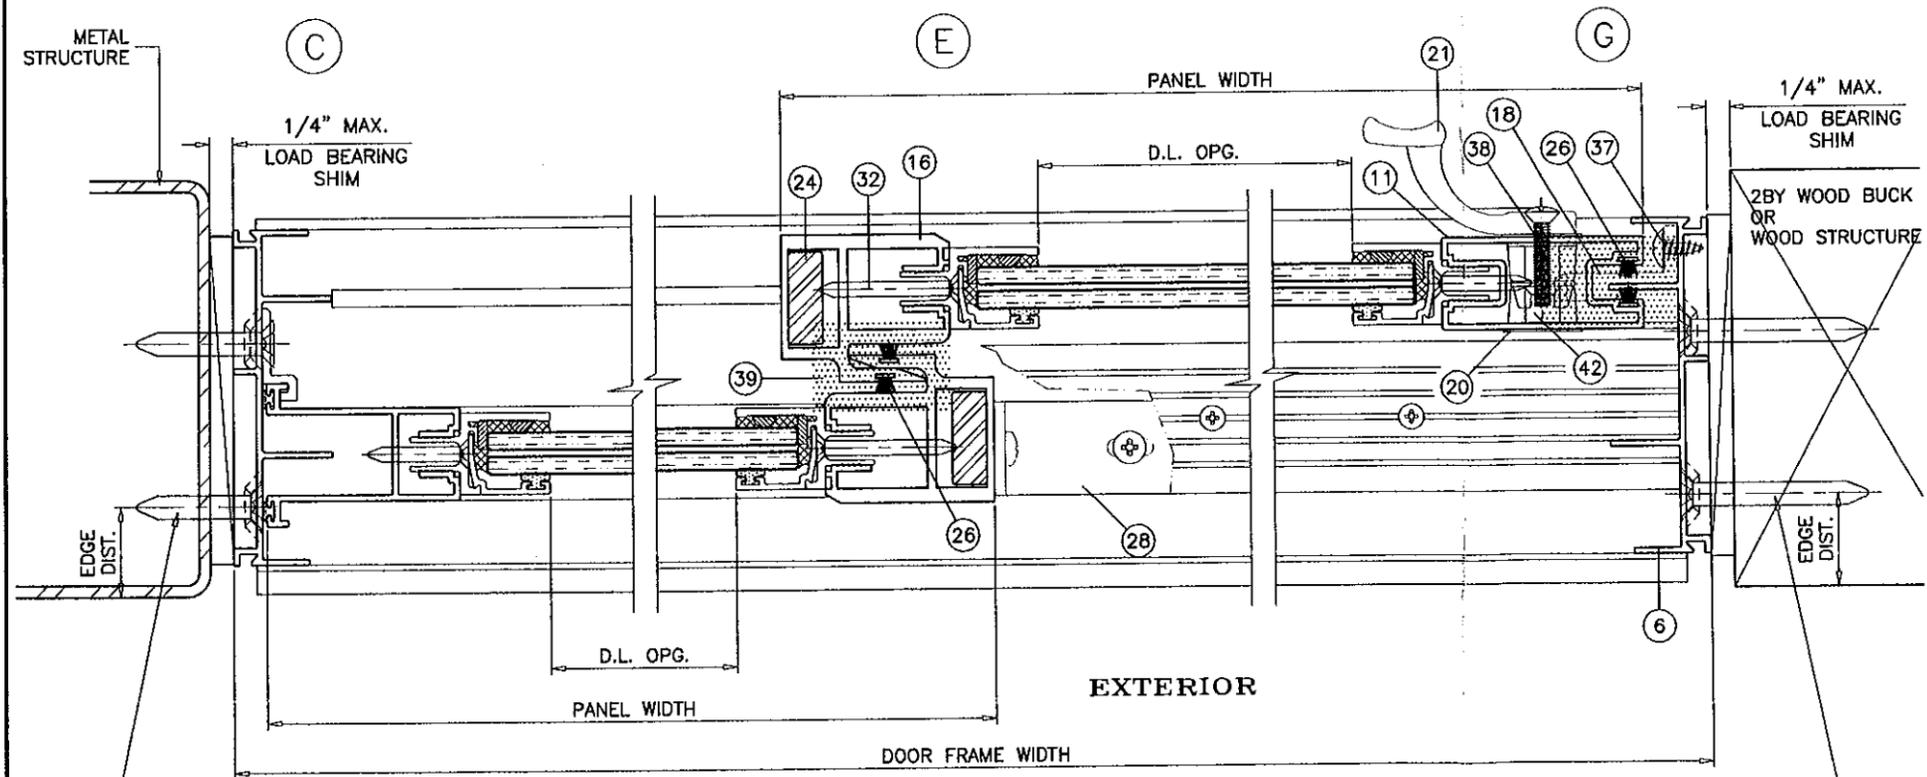

EXTERIOR

TYPICAL ANCHORS IN PAIRS
SEE ELEV. FOR SPACING

TYPICAL ANCHORS IN PAIRS
SEE ELEV. FOR SPACING

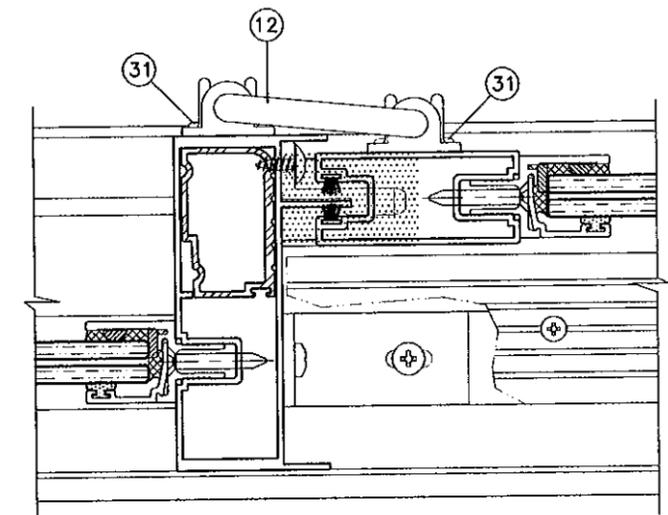

SECURITY LOCK AT ASTRAGAL STILE
SEE SHEET 1 FOR LOCATION
SEE SHEET 6 FOR DESCRIPTION

Engr: JAVAD AHMAD
CIVIL
FLA. PE # 70592
C.A.N. 3538

JAN 11 2011


PRODUCT REVISED
as complying with the Florida
Building Code
Acceptance No 10-0804.04
Expiration Date 07/08/2014
By *J. Ahmad*
Miami Dade Product Control

AL-FAROQ CORPORATION
ENGINEERS & PRODUCT DEVELOPMENT
1235 S.W. 87 AVE
MIAMI, FLORIDA 33174
TEL (305) 264-8100 FAX (305) 262-6978
COMP-ANL W09


SERIES 4100 ALUM SLD. GLASS DOOR (L.M.I.)
ARCH WINDOWS, LLC dba AWP
8130 N.W. 74TH AVE.
MEDLEY, FL. 33166
TEL (305) 887-2646 FAX (305) 883-1309

no	date	by	description
A	06.10.09	REV. PER BCCO COMMENTS	
B	05.27.10	MANUF. NAME REVISED	
C	11.18.10	REV. PER BCCO COMMENTS	


date: 03-11-09	scale: 1/2" = 1"	drawing no.
dr. by: HAMID	chk. by:	W09-17
		sheet 4 of 6

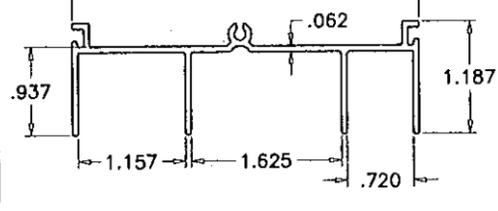


① FRAME HEAD

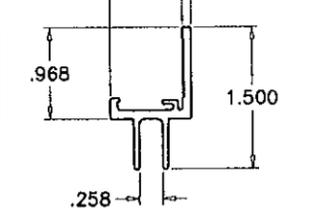


⑭ INSERT ADAPTER

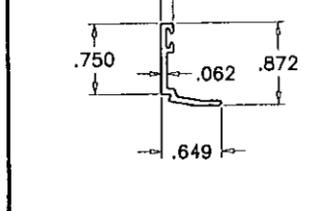


⑮ GLAZING STOP

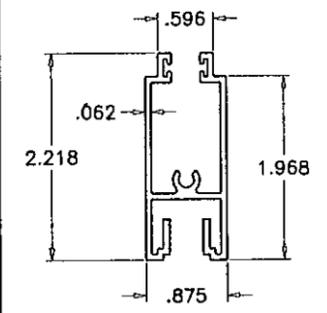


⑩ PANEL TOP RAIL

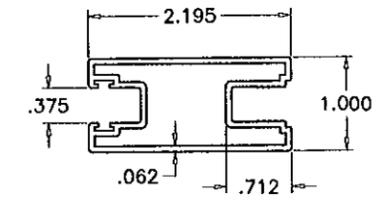


⑪ LOCK STILE

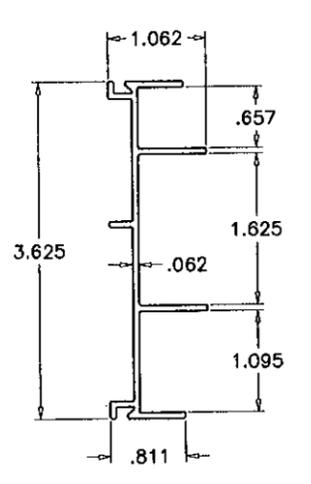


⑥ FRAME JAMB

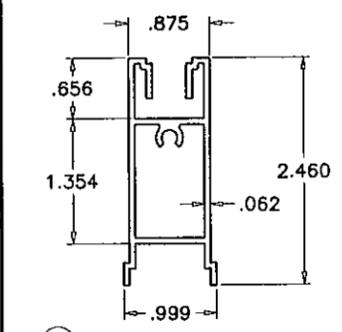


⑧ FIXED PANEL BOTTOM RAIL

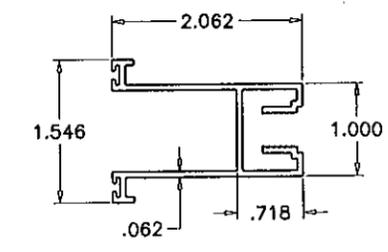


⑬ FIXED PANEL STILE

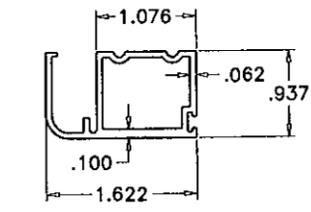


④ HEAD COVER

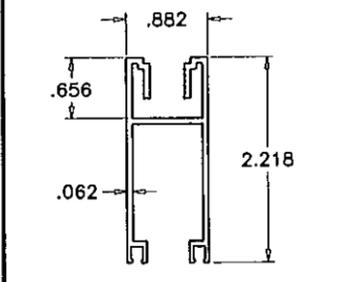


⑨ MOVING PANEL BOTTOM RAIL

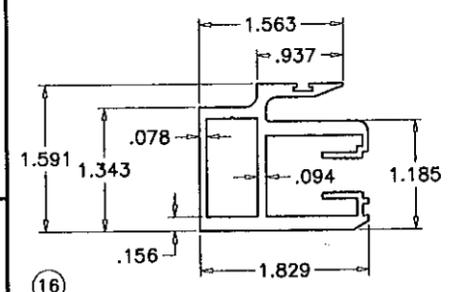


⑯ PANEL HEAVY INTERLOCK STILE

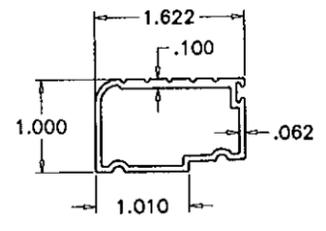


⑤ SILL COVER

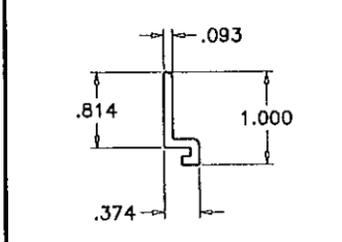


⑰ FIXED PANEL CLIP

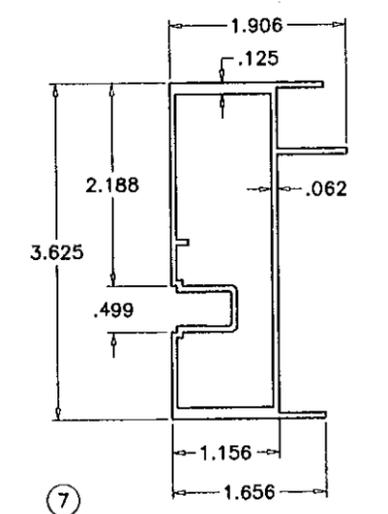


⑦ PANEL ASTRAGAL STILE

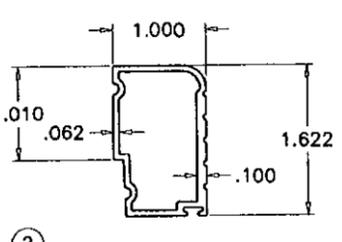

② ASTRAGAL STILE REINFORCING

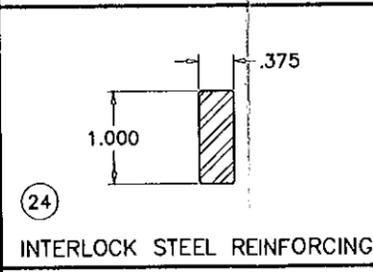

⑳ INTERLOCK STEEL REINFORCING

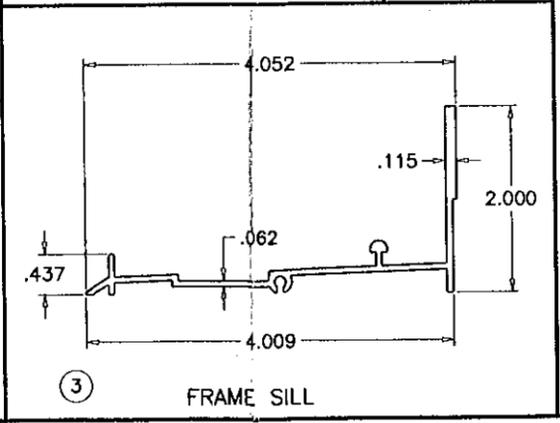

③ FRAME SILL

Engr: JAVAD AHMAD
 CIVIL
 FLA. PE. # 70592
 C.A.N. 3538
 JAN 11 2011

PRODUCT REVISED
 as complying with the Florida
 Building Code
 Acceptance No. 10-0904-04
 Expiration Date 07/08/2014
 By: *[Signature]*
 Miami Dade Product Control

no	date	description	REV. PER	COMMENTS
A	06.10.09			
B	05.27.10			MANUF. NAME REVISED
C	11.18.10			NO CHANGE THIS SHEET


date: 03-11-09
 scale: 1/2" = 1"
 dr. by: HAMID
 chk. by:

drawing no.
W09-17
 sheet 5 of 6


SERIES 4100 ALUM SLD. GLASS DOOR (L.M.I.)
 ARCH WINDOWS, LLC dba AWP
 8130 N.W. 74TH AVE.
 MEDLEY, FL. 33166
 TEL. (305) 887-2646 FAX (305) 883-1309

AL-FAROOQ CORPORATION
 ENGINEERS & PRODUCT DEVELOPMENT
 1235 S.W. 87 AVE
 MIAMI, FLORIDA 33174
 TEL (305) 264-8100 FAX (305) 262-6978
 COMP-ANL\WO

2	YE-3010	1	ASTRAGAL REINF. (FULL LENGTH)	ALUM. (6063-T5)
3	YE-373	1	FRAME SILL	ALUM. (6063-T5)
4	YE-309	1	HEAD COVER	ALUM. (6063-T5)
5	YE-3010	1	SILL COVER	ALUM. (6063-T5)
6	YE-303	2	FRAME JAMB	ALUM. (6063-T5)
7	YE-344	1	PANEL HEAVY ASTRAGAL STILE	ALUM. (6063-T5)
8	YE-379	2	PANEL BOTTOM RAIL (FIXED)	ALUM. (6063-T5)
9	YE-306	1	PANEL BOTTOM RAIL (MOVING)	ALUM. (6063-T5)
10	YE-307	3	PANEL TOP RAIL (FIXED & MOVING)	ALUM. (6063-T5)
11	YE-301	1	PANEL LOCKING STILE	ALUM. (6063-T5)
12	YH-4044	1	SECURITY LOCK @ 48" FROM BOTTOM, FASTENED W/ (4) #8 X 1" PH SMS	STEEL CHROME
13	YE-302	2	PANEL FIXED END STILE	ALUM. (6063-T5)
14	YE-382	12	INSERT ADAPTER (7/16" GLASS)	ALUM. (6063-T6)
15	YE-383	12	GLAZING STOP (7/16" GLASS)	ALUM. (6063-T6)
16	YE-325	2	PANEL HEAVY INTERLOCK STILE	ALUM. (6063-T5)
17	YE-377	2	FIXED PANEL CLIP (95" LONG)	ALUM. (6063-T5)
18	YH-4003	1	KEEPER	CAST (ZAMAK)
19	YH-4016	1	EXTERIOR CONCEALED HANDLE	CAST (ZAMAK)
20	YH-4017	1	INTERIOR CONCEALED HANDLE	CAST (ZAMAK)
21	YH-4022	1	DOOR HANDLE	CAST (ZAMAK)
22	YH-3023	2	ROLLER ASSEMBLY, FASTENED W/ (1) #10-24 X 7/8" PH MS	STEEL
23	YH-4002	2	PANEL TOP SLIDE GUIDE	NYLON
24	YH-4027	2	1 x .375" x FULL LG. REINF. BAR	STEEL (A36)
25	YH-4010	AS REQ'D	BULB VINYL WEATHERSTRIP (DUROMETER +/- 75 SHORE A)	PVC
26	YH-4004	AS REQ'D.	.187" x .250" WEATHERSTRIP	-
27	YH-6006	AS REQ'D.	.115" x .500" WEATHERSTRIP	-
28	YH-4034	1	TYPE B CLIP (2 x 2 x 1 x 1/8")	ALUMINUM
29	YH-4055	1	TYPE C CLIP (2 x 2 x 1 x 1/8")	ALUMINUM
30	YH-4054	6	TYPE D CLIP (2 x 7/8 x 1/8 x 3")	ALUM. (6063-T6)
31	-	8	#8 x 3/4" PH. P.H. SMS.	CAD PLATED
32	-	AS REQ'D	#8 x 1-1/2" FH. SMS.	CAD PLATED
33	YF-2	46	#10 x 1" PH. SMS. (PANELS/CLIPS)	CAD PLATED
34	YF-17	1/WHEEL	#10-24 x 7/8" PH. MS.(WHEEL ADJ)	CAD PLATED
35	YF-10	4/FRAME	#8 x 1" PH. SMS. (FRAME ASSY.)	CAD PLATED
36	-	6	#10 x 1-1/4" P.H. SMS.	CAD PLATED
37	YF-18	2	#10 x 3/8" TRUSS HEAD SMS.	CAD PLATED
38	YF-27	2	#10-32 x 1" OVAL HEAD. SS. MS.	STAINLESS STEEL
39	YH-4013	4	PAD (INTRLK/ASTRAGAL (TOP/BOTTOM)	-
40	GB125375	AS REQ'D	GLAZING SPACER	-
41	-	AS REQ'D	#10 x 1-1/4" FH. SMS.	CAD PLATED
42	-	1	HOOK LOCK	METALLIC

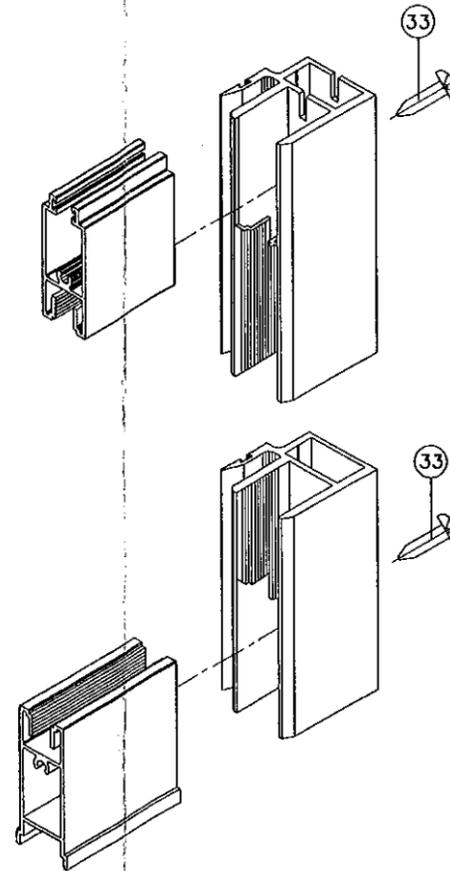

PANEL CORNER DETAILS

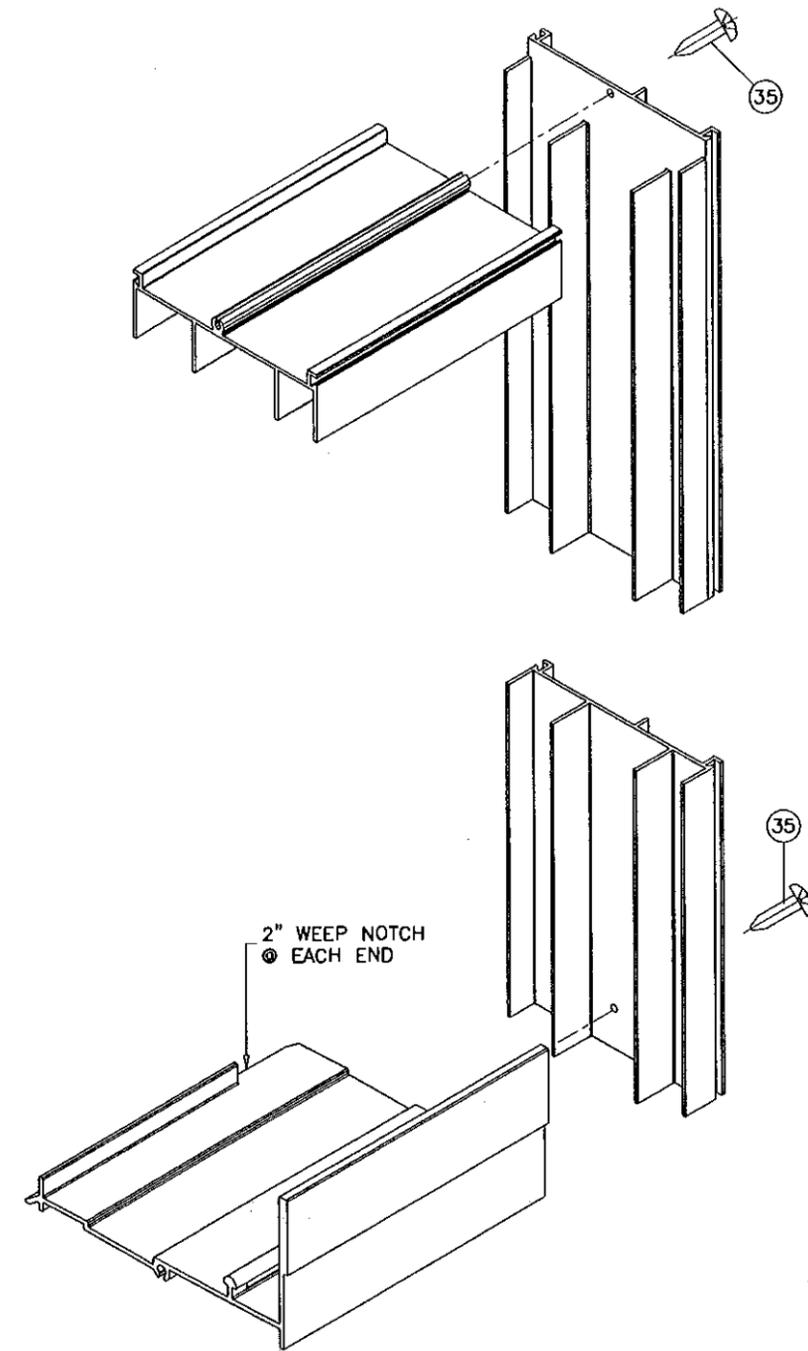

FRAME CORNER DETAIL

Engr: JAVAD AHMAD
 CIVIL
 FLA. PE # 70592
 C.A.N. 3538

JA
 JAN 11 2011

PRODUCT REVISED
 as complying with the Florida
 Building Code
 Acceptance No. 10-0804-04
 Expiration Date 07/08/2014

By *Ishak L. Chaudhary*
 Miami Dade Product Control

AL-FAROOQ CORPORATION
 ENGINEERS & PRODUCT DEVELOPMENT
 1235 S.W. 87 AVE
 MIAMI, FLORIDA 33174
 TEL (305) 264-8100 FAX (305) 262-6978
 COMP-ANL W09

SERIES 4100 ALUM SLD. GLASS DOOR (L.M.I.)
 ARCH WINDOWS, LLC dba AWP
 8130 N.W. 74TH AVE.
 MEDLEY, FL. 33166
 TEL (305) 887-2646 FAX (305) 883-1309

no	date	by	description
A	06.10.09		NO CHANGE THIS SHEET
B	05.27.10		MANUF. NAME REVISED
C	11.18.10		REV. PER BCCO COMMENTS

date: 03-11-09
 scale: 1/2" = 1"
 dr. by: HAMID
 chk. by:

drawing no.
W09-17
 sheet 6 of 6