



BUILDING AND NEIGHBORHOOD COMPLIANCE DEPARTMENT (BNC)
BOARD AND CODE ADMINISTRATION DIVISION

MIAMI-DADE COUNTY
PRODUCT CONTROL SECTION
11805 SW 26 Street, Room 208
Miami, Florida 33175-2474
T (786) 315-2590 F (786) 315-2599

NOTICE OF ACCEPTANCE (NOA)

www.miamidade.gov/building/home/asp

Coastal Innovative Products, Inc.
941 N. Alm Street Suite-C
Orange, CA. 92867

SCOPE:

This NOA is being issued under the applicable rules and regulations governing the use of construction materials. The documentation submitted has been reviewed and accepted by Miami-Dade County BNC -Product Control Section to be used in Miami Dade County and other areas where allowed by the Authority Having Jurisdiction (AHJ).

This NOA shall not be valid after the expiration date stated below. The Miami-Dade County Product Control Section (In Miami Dade County) and/or the AHJ (in areas other than Miami Dade County) reserve the right to have this product or material tested for quality assurance purposes. If this product or material fails to perform in the accepted manner, the manufacturer will incur the expense of such testing and the AHJ may immediately revoke, modify, or suspend the use of such product or material within their jurisdiction. BNC reserves the right to revoke this acceptance, if it is determined by Miami-Dade County Product Control Section that this product or material fails to meet the requirements of the applicable building code.

This product is approved as described herein, and has been designed to comply with the Florida Building Code, including the High Velocity Hurricane Zone.

DESCRIPTION: LANAI Series Aluminum Out folding Doors-L.M.I.

APPROVAL DOCUMENT: Drawing No. CIP001, titled "E-3 Hurricane" Bi-folding Door", sheets 1 through 11 of 11, prepared by Certworks, LLC, dated 10/06/10 and last revised on 07-05-11, signed and sealed by Alex Spyrou, P.E., bearing the Miami-Dade County Product Control Approval stamp with the Notice of Acceptance number and approval date by the Miami-Dade County Product Control Section.

MISSILE IMPACT RATING: Large and Small Missile Impact Resistant

Limitation:

- 1. See design Pressure rating Vs sill type, in sheet 1.

LABELING: Each unit shall bear a permanent label with the manufacturer's name or logo, city, state and Series/Model and following statement: "Miami-Dade County Product Control Approved", unless otherwise noted herein.

RENEWAL of this NOA shall be considered after a renewal application has been filed and there has been no change in the applicable building code negatively affecting the performance of this product.

TERMINATION of this NOA will occur after the expiration date or if there has been a revision or change in the materials, use, and/or manufacture of the product or process. Misuse of this NOA as an endorsement of any product, for sales, advertising or any other purposes shall automatically terminate this NOA. Failure to comply with any section of this NOA shall be cause for termination and removal of NOA.

ADVERTISEMENT: The NOA number preceded by the words Miami-Dade County, Florida, and followed by the expiration date may be displayed in advertising literature. If any portion of the NOA is displayed, then it shall be done in its entirety.

INSPECTION: A copy of this entire NOA shall be provided to the user by the manufacturer or its distributors and shall be available for inspection at the job site at the request of the Building Official.

This NOA and consists of this page 1 and evidence pages E-1, as well as approval document mentioned above. The submitted documentation was reviewed by **Ishaq I. Chanda, P.E.**



7/14/11

NOA No 10-1019.01
Expiration Date: July 21, 2016
Approval Date: July 21, 2011

NOTICE OF ACCEPTANCE: EVIDENCE SUBMITTED

A. DRAWINGS

1. Manufacturer's die drawings and sections.
2. Drawing No. **CIP001**, titled "E-3 Hurricane" Bi-folding Door", sheets 1 through 11 of 11, prepared by Certworks, LLC, dated 10/06/10 and last revised on 07-05-11, signed and sealed by Alex Spyrou, P.E.

B. TESTS

1. Test reports on:
 - 1) Air Infiltration Test, per FBC, TAS 202-94
 - 2) Uniform Static Air Pressure Test, Loading per FBC TAS 202-94
 - 3) Water Resistance Test, per FBC, TAS 202-94
 - 4) Large Missile Impact Test per FBC, TAS 201-94
 - 5) Cyclic Wind Pressure Loading per FBC, TAS 203-94
 - 6) Forced Entry Test, per FBC 2411 3.2.1, TAS 202-94

along with marked-up drawings and installation diagram of out folding aluminum doors, prepared by Architectural Testing, Test Report No. **A0896.01-301-18**, dated 09/29/10, signed and sealed by Joseph A. Reed, P. E.

Note: This test report was revised by an addendum letter dated 02/01/11, issued by Architectural Testing, signed and sealed by Joseph A. Reed, P. E.

C. CALCULATIONS

1. Anchor verification calculations and structural analysis, complying with FBC-2007, prepared by CertWorks, dated 01/27/11 and last revised on 07-05-11, signed and sealed by Alex Spyrou, P.E
2. Glazing complies w/ ASTM E-1300-02 & -04

D. QUALITY ASSURANCE

1. Miami Dade Building and Neighborhood Compliance Department (BNC).

E. MATERIAL CERTIFICATIONS


1. Notice of Acceptance No. **07-1116.04** issued to E.I. DuPont DeNemours & Co., Inc. for their "**DuPont Sentry Glass @ Plus**", expiring on 01/14/12.
2. Thermoplastic properties of Santoprene 101-64 per ASTM D 412, ASTM D 395, ASTM D 624 and ASTM D 792

F. STATEMENTS

1. Statement letter of conformance and letter of no financial interest, prepared by CertWorks, LLC, dated 03/23/11, signed and sealed by Alex Spyrou, P.E.
2. Lab statement of compliance, as part of test report.

G. OTHER

1. Test proposal #**10-0393**, dated June 14, 2010, approved by BCCO.

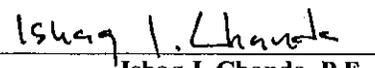

Ishaq I. Chanda, P.E.
Product Control Examiner
NOA No 10-1019.01
Expiration Date: July 21, 2016
Approval Date: July 21, 2011

INSTALLATION NOTES:

- ONE (1) INSTALLATION ANCHOR IS REQUIRED AT EACH ANCHOR LOCATION SHOWN. (SEE ANCHOR LAYOUT SHEETS 2 - 4)
- THE NUMBER OF INSTALLATION ANCHORS DEPICTED IS THE MINIMUM NUMBER OF ANCHORS TO BE USED FOR PRODUCT INSTALLATION.
- INSTALL INDIVIDUAL INSTALLATION ANCHORS WITHIN A TOLERANCE OF ±1/16 INCH OF THE DEPICTED LOCATION IN THE ANCHOR LAYOUT DETAIL (I.E., WITHOUT CONSIDERATION OF TOLERANCES). TOLERANCES ARE NOT CUMULATIVE FROM ONE INSTALLATION ANCHOR TO THE NEXT.
- SHIM AS REQUIRED AT EACH INSTALLATION ANCHOR WITH LOAD BEARING SHIM(S). MAXIMUM ALLOWABLE SHIM STACK TO BE 1/4 INCH. SHIM WHERE SPACE OF 1/16 INCH OR GREATER OCCURS. SHIM(S) SHALL BE CONSTRUCTED OF HIGH DENSITY PLASTIC OR BETTER.
- FOR INSTALLATION INTO WOOD FRAMING USE #14 WOOD SCREWS OF SUFFICIENT LENGTH TO ACHIEVE 2 INCH MINIMUM EMBEDMENT INTO WOOD SUBSTRATE WITH MINIMUM 1 INCH EDGE DISTANCE.
- FOR INSTALLATION THROUGH 1X BUCK TO CONCRETE/MASONRY, OR DIRECTLY INTO CONCRETE/MASONRY, USE 1/4 INCH DIAMETER ITW TAPCONS OF SUFFICIENT LENGTH TO ACHIEVE 1 3/4 INCH MINIMUM EMBEDMENT AND WITH MINIMUM 2-1/2 INCH EDGE DISTANCE.
- FOR INSTALLATION INTO 33 KSI STEEL STUD USE 1/4-14 TEK SCREWS (GRADE 5) OF SUFFICIENT LENGTH TO ACHIEVE THREE (3) THREADS MINIMUM PENETRATION BEYOND THE METAL STRUCTURE.
- MINIMUM EMBEDMENT AND EDGE DISTANCE EXCLUDE WALL FINISHES, INCLUDING BUT NOT LIMITED TO STUCCO, FOAM, BRICK VENEER, AND SIDING.
- INSTALLATION ANCHORS AND ASSOCIATED HARDWARE MUST BE MADE OF CORROSION RESISTANT MATERIAL OR HAVE A CORROSION RESISTANT COATING.
- FOR GROUT FILLED BLOCK, DO NOT INSTALL INSTALLATION ANCHORS INTO MORTAR JOINTS. EDGE DISTANCE IS MEASURED FROM FREE EDGE OF BLOCK OR EDGE OF MORTAR JOINT INTO FACE SHELL OF BLOCK.
- INSTALLATION ANCHORS SHALL BE INSTALLED IN ACCORDANCE WITH ANCHOR MANUFACTURER'S INSTALLATION INSTRUCTIONS, AND ANCHORS SHALL NOT BE USED IN SUBSTRATES WITH STRENGTHS LESS THAN THE MINIMUM STRENGTH SPECIFIED IN THIS APPROVAL.
- INSTALLATION ANCHOR CAPACITIES FOR PRODUCTS HEREIN ARE BASED ON SUBSTRATE MATERIALS WITH THE FOLLOWING PROPERTIES:
 - WOOD - MINIMUM SPECIFIC GRAVITY OF 0.55.
 - CONCRETE - MINIMUM COMPRESSIVE STRENGTH OF 2700 PSI.
 - GROUT-FILLED CMU- UNIT STRENGTH CONFORMS TO ASTM C-90 AND GROUT CONFORMS TO ASTM C 476, MINIMUM GROUT COMPRESSIVE STRENGTH OF 2000 PSI.
 - STEEL - MINIMUM YIELD STRENGTH OF 33 KSI. MINIMUM WALL THICKNESS OF 33 MILS (20 GAUGE OR 0.033 IN.) MUST BE DESIGNED TO ADEQUATELY TRANSFER LOADS APPLIED.
- THRESHOLD/SILL INSTALLATION: FLUSH GUIDE SILL (DETAIL D/5) & LOW-RISE SILL (DETAIL K/6) ARE LIMITED TO INSTALLATIONS AS SHOWN ON SHEET 11 INTO WOOD OR CONCRETE SUBSTRATES.

COASTAL INNOVATIVE PRODUCTS

LANAI SERIES E3 HURRICANE OUTWARD OPENING BI-FOLD DOOR

GENERAL NOTES:

- THE PRODUCT SHOWN HEREIN IS DESIGNED AND MANUFACTURED TO COMPLY WITH THE 2007 FLORIDA BUILDING CODE (FBC), INCLUDING HVHZ AND HAS BEEN EVALUATED ACCORDING TO THE FOLLOWING:
 - TAS 201-94
 - TAS 202-94
 - TAS 203-94
- ADEQUACY OF THE EXISTING STRUCTURAL CONCRETE/MASONRY AND 2X FRAMING AS A MAIN WIND FORCE RESISTING SYSTEM CAPABLE OF WITHSTANDING AND TRANSFERRING APPLIED PRODUCT LOADS TO THE FOUNDATION IS THE RESPONSIBILITY OF THE ENGINEER OR ARCHITECT OF RECORD FOR THE PROJECT OF INSTALLATION.
- 1X AND 2X BUCKS (WHEN USED) SHALL BE DESIGNED AND ANCHORED TO PROPERLY TRANSFER ALL LOADS TO THE STRUCTURE. BUCK DESIGN AND INSTALLATION IS THE RESPONSIBILITY OF THE ENGINEER OR ARCHITECT OF RECORD FOR THE PROJECT OF INSTALLATION.
- THE INSTALLATION DETAILS DESCRIBED HEREIN ARE GENERIC AND MAY NOT REFLECT ACTUAL CONDITIONS FOR A SPECIFIC SITE. IF SITE CONDITIONS CAUSE INSTALLATION TO DEVIATE FROM THE REQUIREMENTS DETAILED HEREIN, A LICENSED ENGINEER OR ARCHITECT SHALL PREPARE SITE SPECIFIC DOCUMENTS FOR USE WITH THIS DOCUMENT. FOR NON-HVHZ AREA, INSTALLATION TO BE REVIEWED BY AHJ (AUTHORITY HAVING JURISDICTION).
- DEVIATION FROM THE APPROVED NOA IN HVHZ AREA REQUIRE A ONE TIME APPROVAL FROM MIAMI-DADE COUNTY.
- APPROVED IMPACT PROTECTIVE SYSTEM IS **NOT REQUIRED** ON THIS PRODUCT IN AREAS REQUIRING IMPACT RESISTANCE.
- DOOR FRAME MATERIAL: ALUMINUM 6063-T5
- GLASS MEETS THE REQUIREMENTS OF ASTM E 1300-04 GLASS CHARTS. SEE SHEET 6 FOR GLAZING DETAILS.
- SILICONE SEALANT TO BE APPLIED BETWEEN GLASS AND FRAME AND BETWEEN FRAME CORNERS AND PANEL CORNERS.
- FOR INSTALLATION OF LOW-RISE AND FLUSH SILL 2X8 WOOD BUCK OR CONCRETE MUST BE RECESSED AND/OR ROUTED TO ACCOMMODATE THESE COMPONENTS PRIOR TO INSTALLATION.

TABLE OF CONTENTS		
SHEET	REVISION	SHEET DESCRIPTION
1	-	INSTALLATION & GENERAL NOTES
2	-	ELEVATION & ANCHOR LAYOUT
3	-	ELEVATION & ANCHOR LAYOUT
4	-	ELEVATION & ANCHOR LAYOUT
5	-	VERTICAL SECTIONS
6	-	VERTICAL SECTIONS & GLAZING DETAILS
7	-	HORIZONTAL SECTIONS
8	-	COMPONENTS & BILL OF MATERIALS
9	-	COMPONENTS
10	-	CORNER DETAILS & CONFIGURATIONS
11	-	INSTALLATION PREPARATION DETAILS

DESIGN PRESSURE RATING			
GLAZE TYPE	DESIGN PRESSURE		MISSILE IMPACT RATING
1 & 2	+55.0 / -55.0 PSF	W/ WATER INFILTRATION (STANDARD SILL ONLY)	LARGE AND SMALL MISSILE IMPACT RATED
	+70.0 / -70.0 PSF *	W/O WATER INFILTRATION (STANDARD, FLUSH, & LOW RISE SILL)	


*UNIT SHALL BE INSTALLED AT LOCATION PROTECTED BY OVERHANG SUCH THE OVERHANG RATIO (OH) = OH LENGTH/OH HEIGHT GREATER THAN 1.0 WHERE WATER INFILTRATION IS REQUIRED.



COASTAL INNOVATIVE PRODUCTS
941 NORTH ELM STREET, STE. C
ORANGE, CA 92867
PH: (714) 744-6020 FX: (714) 744-6030

TITLE: HURRICANE BIFOLD DOOR
E3 INSTALLATION & GENERAL NOTES
PREPARED BY: CERTWORKS, LLC
127 W. FAIRBANKS AVE., STE. 438
WINTER PARK, FL 32789
PH: (407) 644-6957 FX: (407) 644-2366

REVISIONS	DESCRIPTION	DATE	
		BY	DATE
NO.			

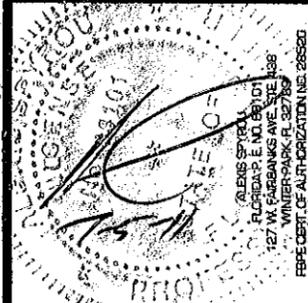

Approved as complying with the Florida Building Code
Date: July 21, 2011
NOA# 10-1019-01
Miami Trade Product Control
By: *kyng l. charnd*


DATE: 10.6.10
DWN BY: JLA
CHK BY: KSD
SCALE: NTS
DWG #: CIP001
SHEET: 1 OF 11

P:\projects\coastal_innovative_products\lmd-5-30-0412 (lanai doors - folding doors)\dwg\Cip001.dwg 7/1/2011 1:01 PM




COASTAL INNOVATIVE PRODUCTS
 941 NORTH ELM STREET, STE. C
 ORANGE, CA 92867
 PH: (714) 744-6020 FX: (714) 744-6030

TITLE: E3 HURRICANE BIFOLD DOOR
 ELEVATION &
 ANCHOR LAYOUT
 PREPARED BY:
 CERTWORKS, LLC
 127 W. FAIRBANKS AVE., STE. 438
 WINTER PARK, FL 32789
 PH: (407) 644-6957 FX: (407) 644-2366

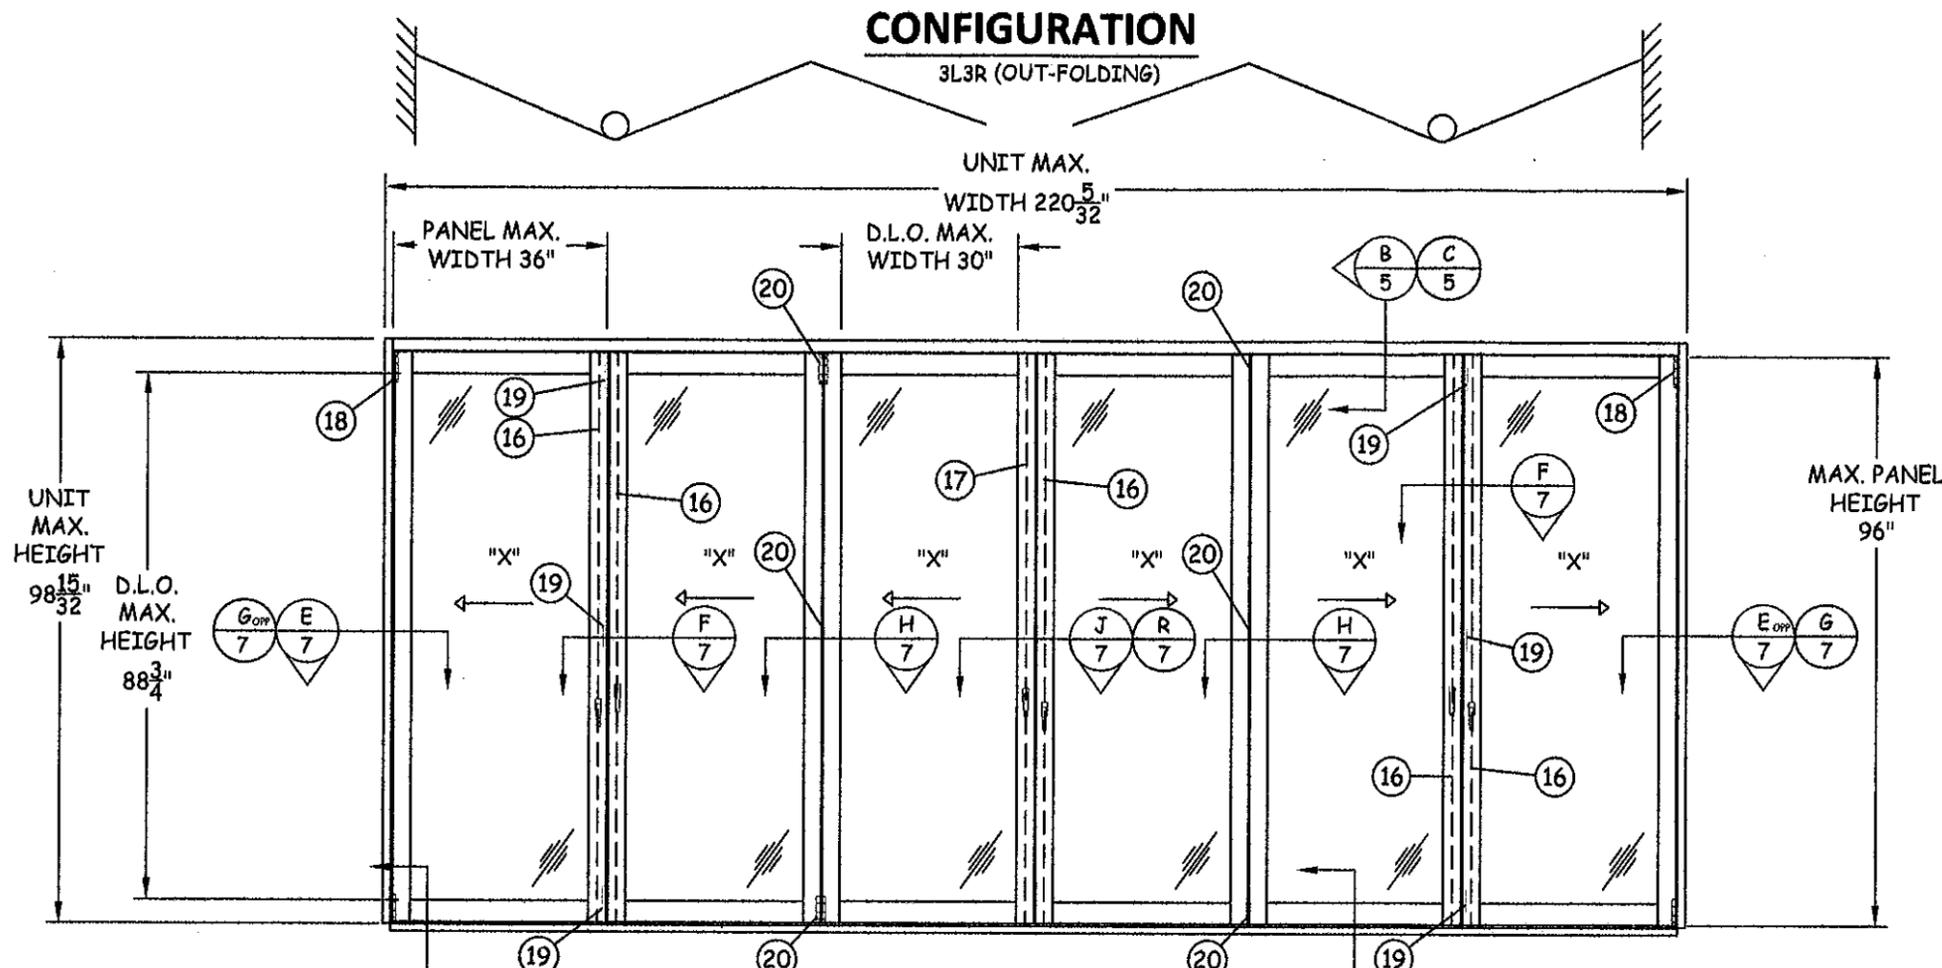

ELEVATION
 3L3R (OUT-FOLDING)

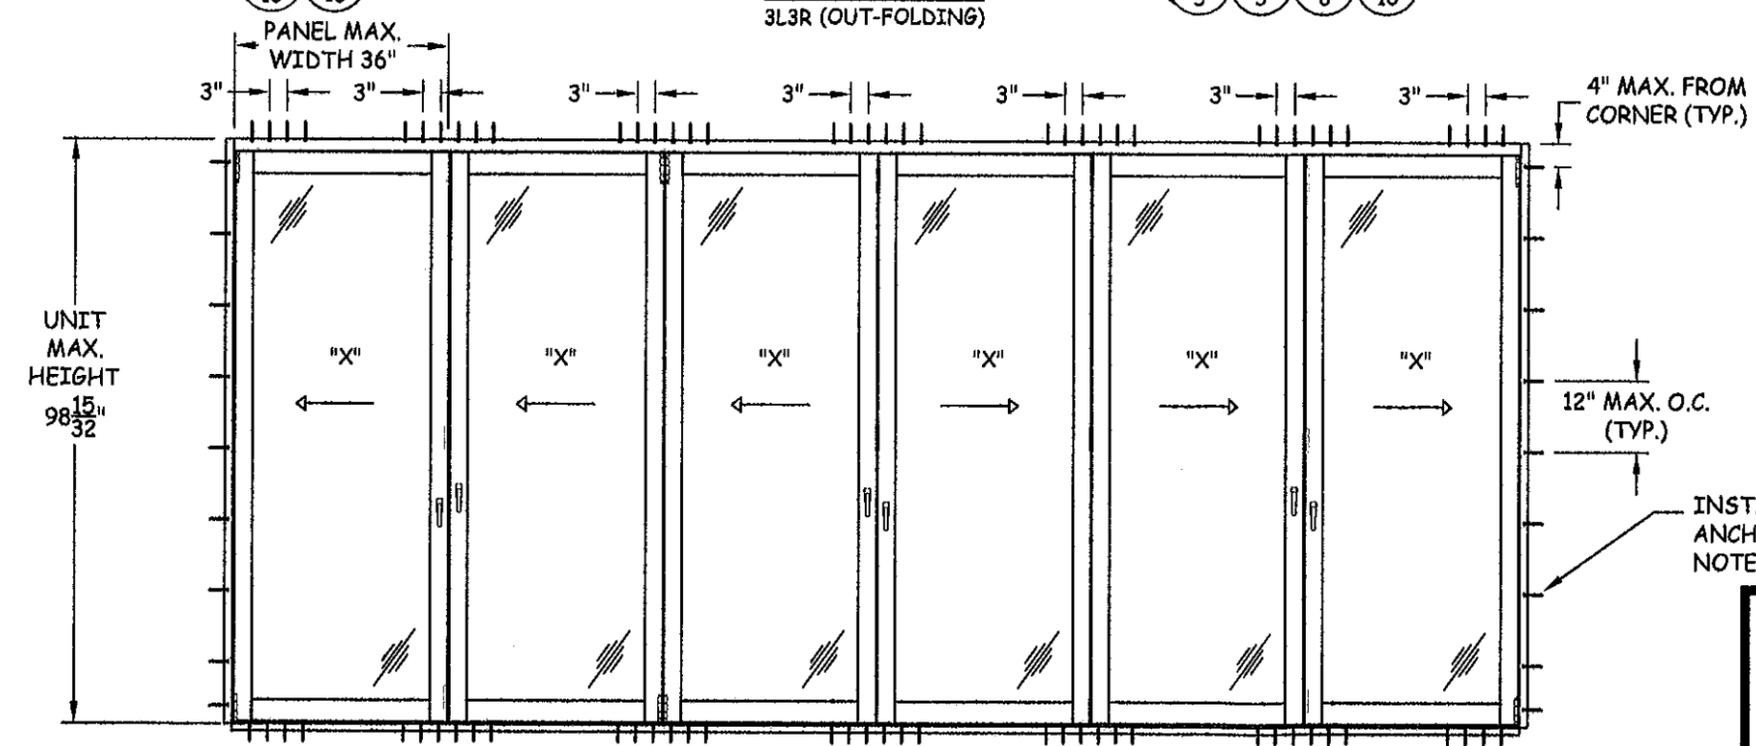

ANCHOR LAYOUT
 3L3R (OUT-FOLDING)

NO.	DESCRIPTION	BY	DATE




Approved as complying with the
 Florida Building Code
 Date: 7/21/11
 NOA# 10-1019.01
 Lantai Door Product Control
 By: *Isaac J. Chan*

DATE: 10.6.10
 DWN BY: JLA
 CHK BY: KSD
 SCALE: NTS
 DWG #: CIP001
 SHEET: 2 OF 11


CONFIGURATION

6R (OUT-FOLDING)

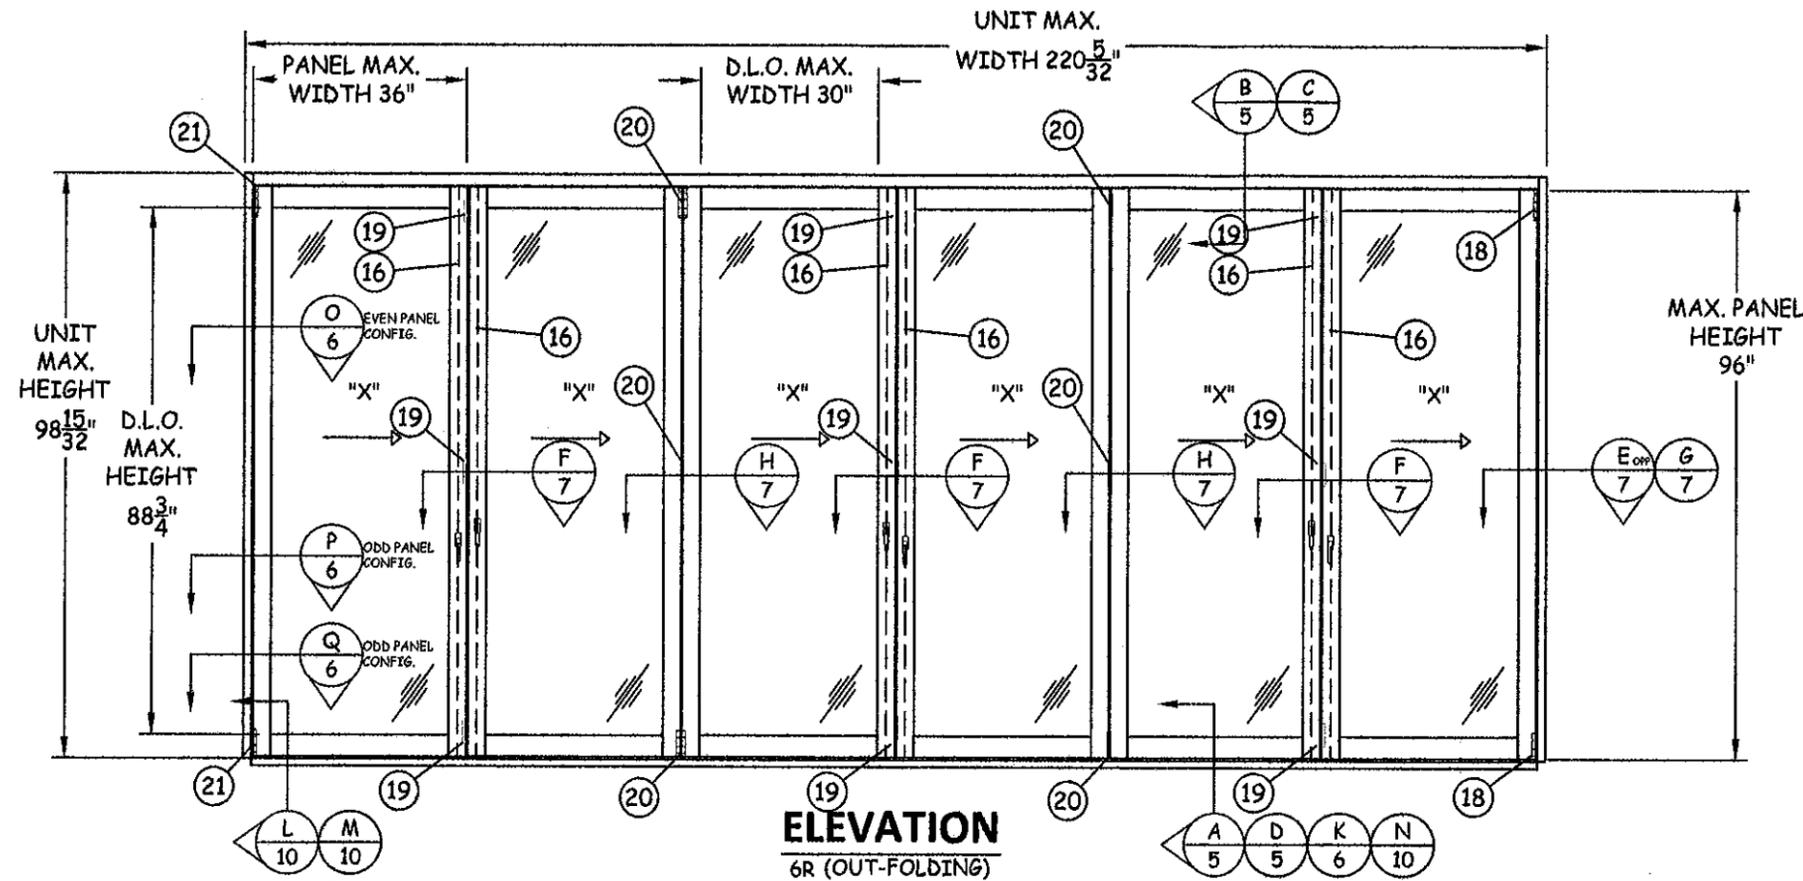

ELEVATION

6R (OUT-FOLDING)

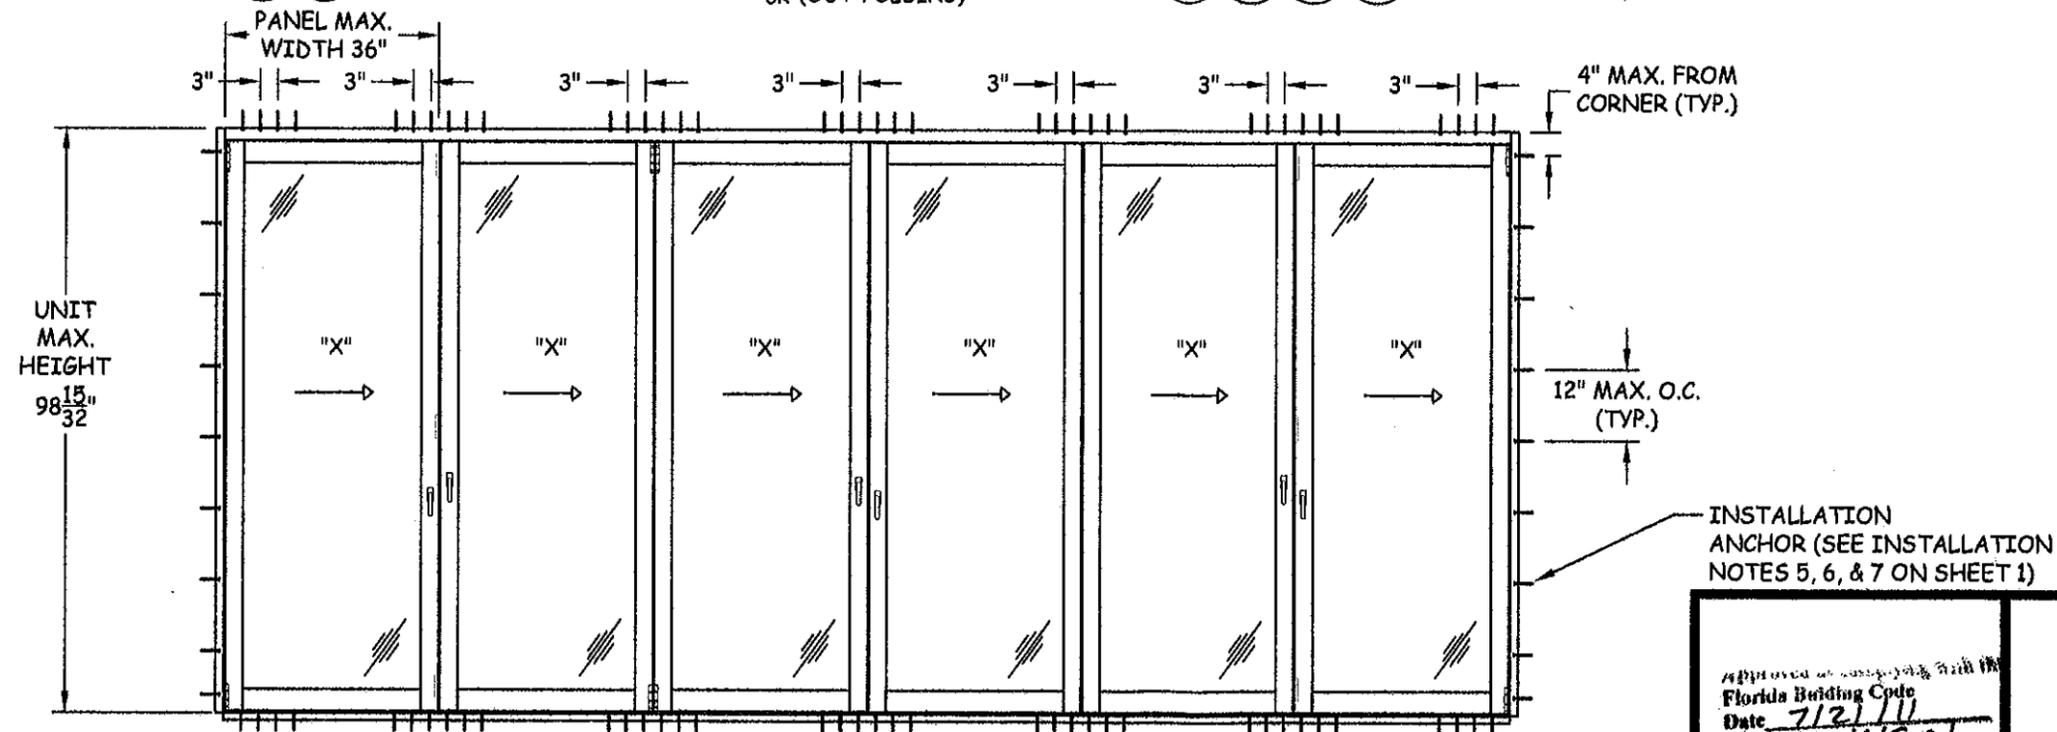

ANCHOR LAYOUT

6R (OUT-FOLDING)




COASTAL INNOVATIVE PRODUCTS
941 NORTH ELM STREET, STE. C
ORANGE, CA 92867
PH: (714) 744-6020 FX: (714) 744-6030

TITLE: E3 HURRICANE BIFOLD DOOR
ELEVATION &
ANCHOR LAYOUT

PREPARED BY:
CERTWORKS, LLC
127 W. FAIRBANKS AVE., STE. 438
WINTER PARK, FL 32789
PH: (407) 644-6957 FX: (407) 644-2366

REVISIONS

NO.	DESCRIPTION	BY	DATE

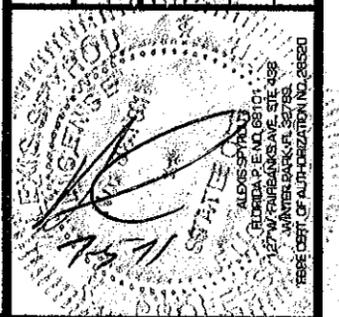

INSTALLATION ANCHOR (SEE INSTALLATION NOTES 5, 6, & 7 ON SHEET 1)


Approved as per code with the Florida Building Code
Date 7/21/11
NOA# 16-1019-01
Miami Dade Product Control
By *[Signature]*

DATE: 10.6.10
DWN BY: JLA
CHK BY: KSD
SCALE: NTS
DWG #: CIP001
SHEET: 4 OF 11




COASTAL INNOVATIVE PRODUCTS
941 NORTH ELM STREET, STE. C
ORANGE, CA 92867
PH: (714) 744-6020 FX: (714) 744-6030

TITLE: E3 HURRICANE BIFOLD DOOR VERTICAL SECTIONS
PREPARED BY: CERTWORKS, LLC
127 W. FAIRBANKS AVE., STE. 438
WINTER PARK, FL 32789
PH: (407) 644-6957 FX: (407) 644-2366

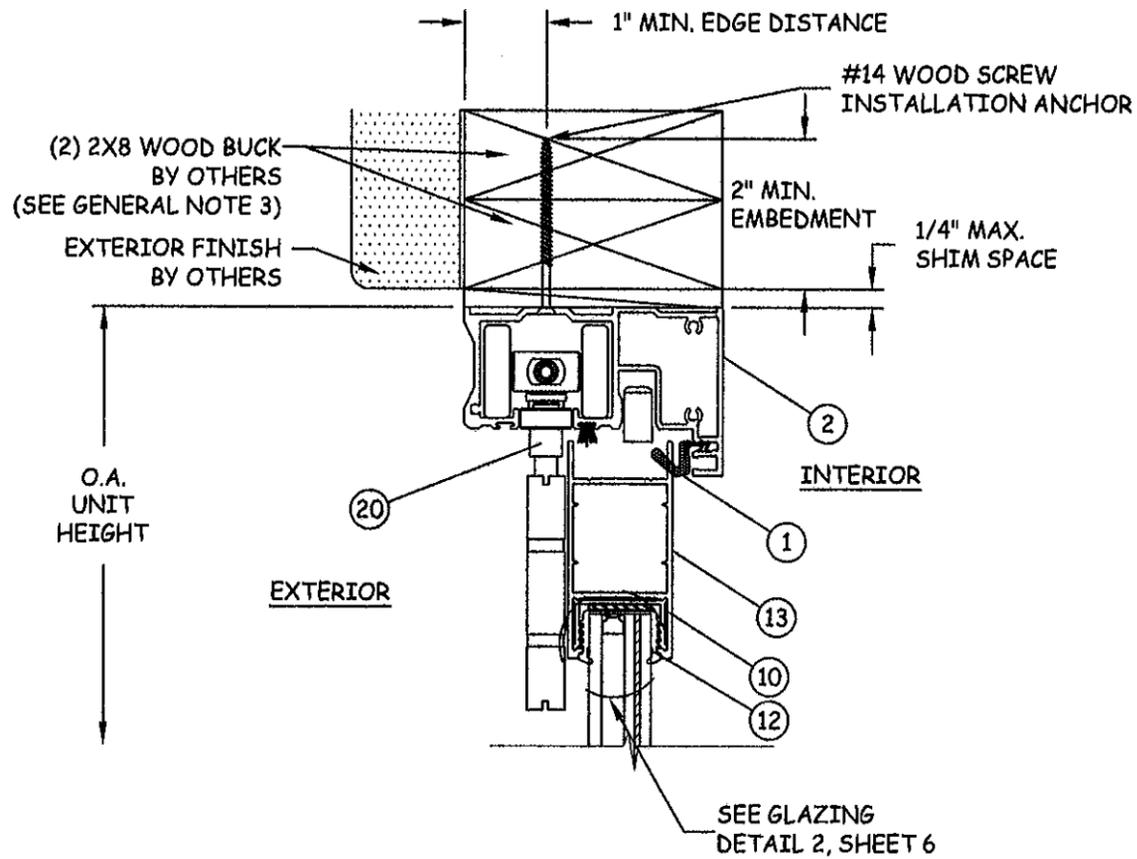


MAX UNIT HEIGHT
98-15/32"

B
5 VERTICAL SECTION
HEAD - 2X WOOD FRAME

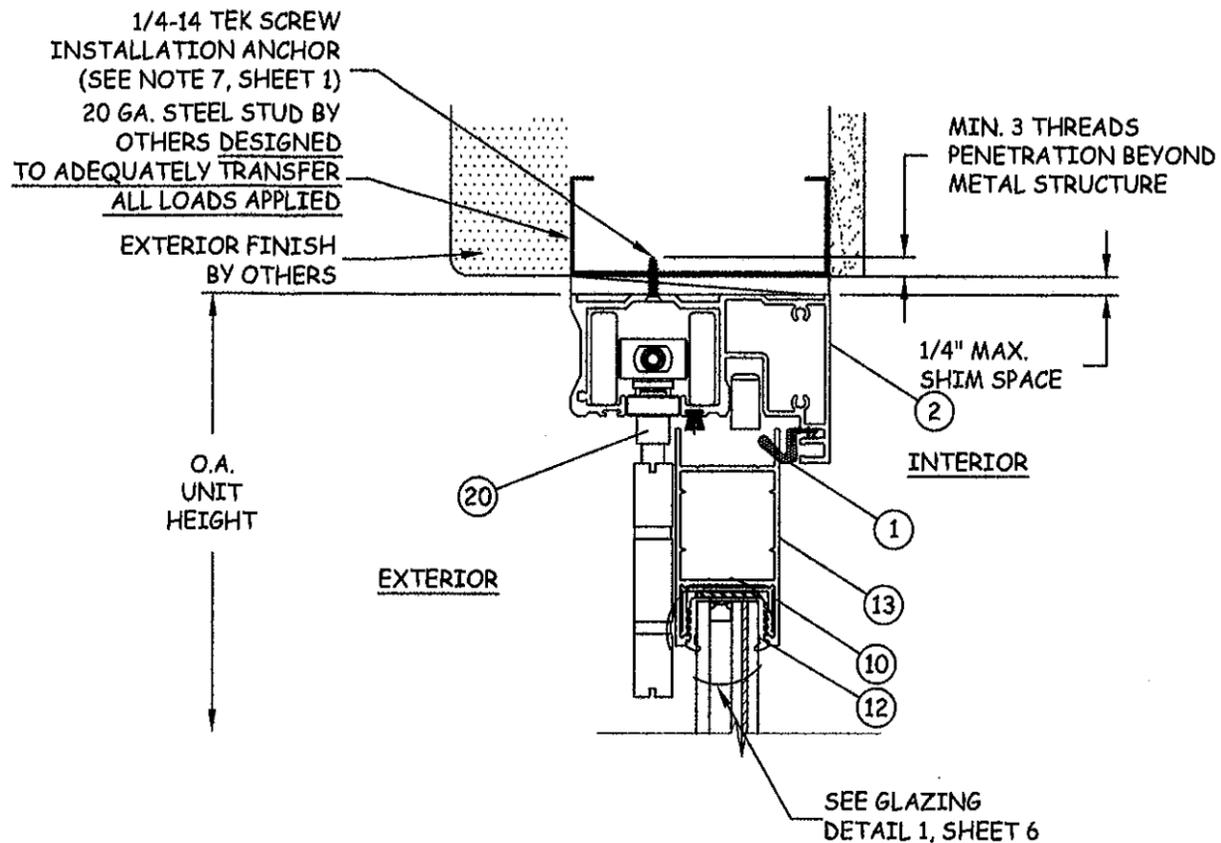


MAX UNIT HEIGHT
98-15/32"

C
5 VERTICAL SECTION
HEAD - STEEL STUD

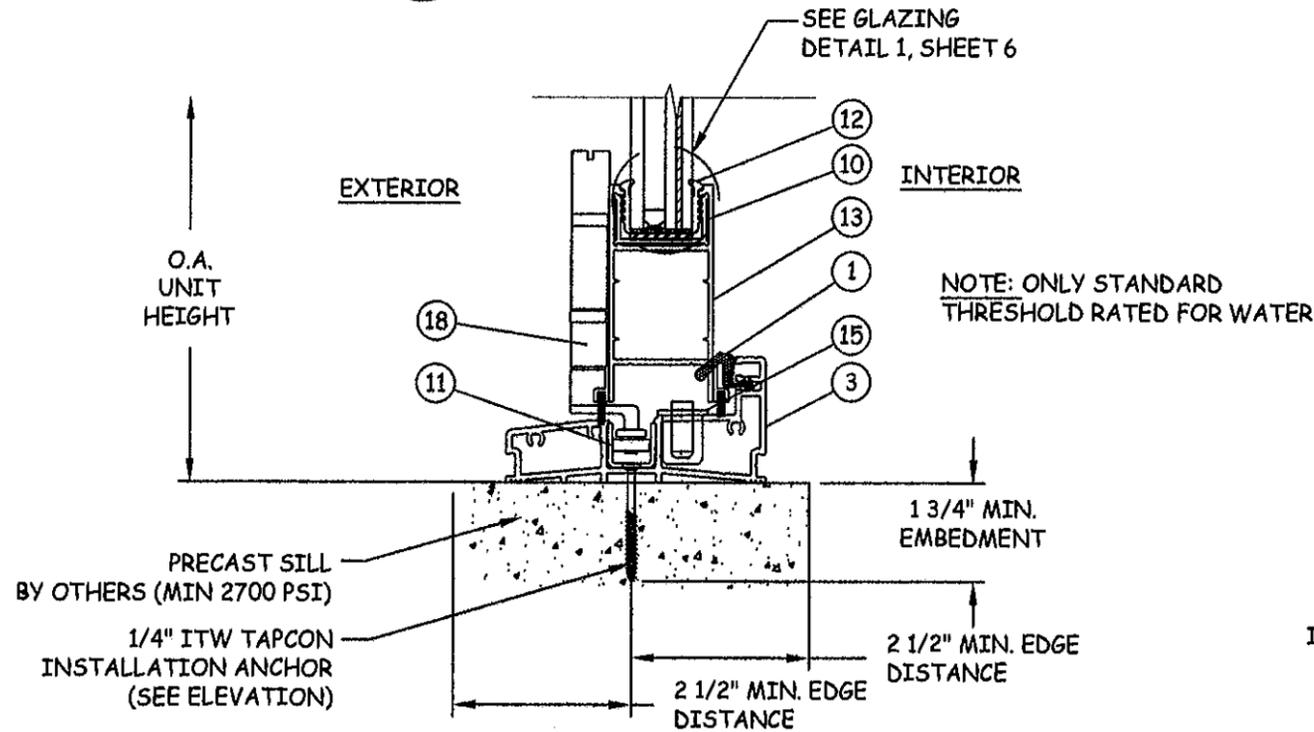

A
5 VERTICAL SECTION
SILL - CONCRETE/MASONRY
STANDARD THRESHOLD

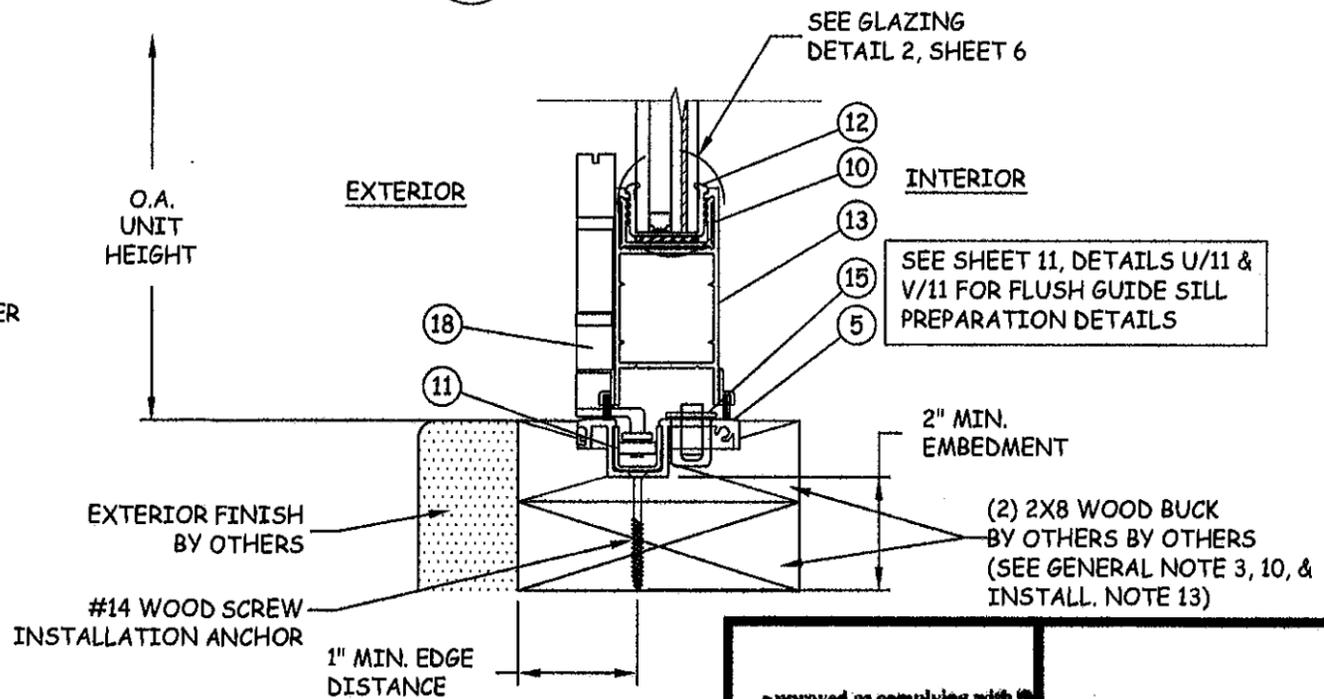

D
5 VERTICAL SECTION
SILL - 2X WOOD FRAME
FLUSH GUIDE THRESHOLD

Approved as complying with the
Florida Building Code
Date: 7/21/11
NGA: 10-1019-01
By: [Signature]

REVISIONS	DESCRIPTION	DATE	BY




DATE: 10.6.10
DWN BY: JLA
CHK BY: KSD
SCALE: NTS
DWG #: CIP001
SHEET: 5 OF 11




COASTAL INNOVATIVE PRODUCTS
941 NORTH ELM STREET, STE. C
ORANGE, CA 92667
PH: (714) 744-6020 FX: (714) 744-6030


TITLE: E3 HURRICANE BIFOLD DOOR
VERTICAL SECTIONS
& GLAZING DETAILS
PREPARED BY:
CERTWORKS, LLC
127 W. FAIRBANKS AVE., STE. 438
WINTER PARK, FL 32789
PH: (407) 644-6957 FX: (407) 644-2366

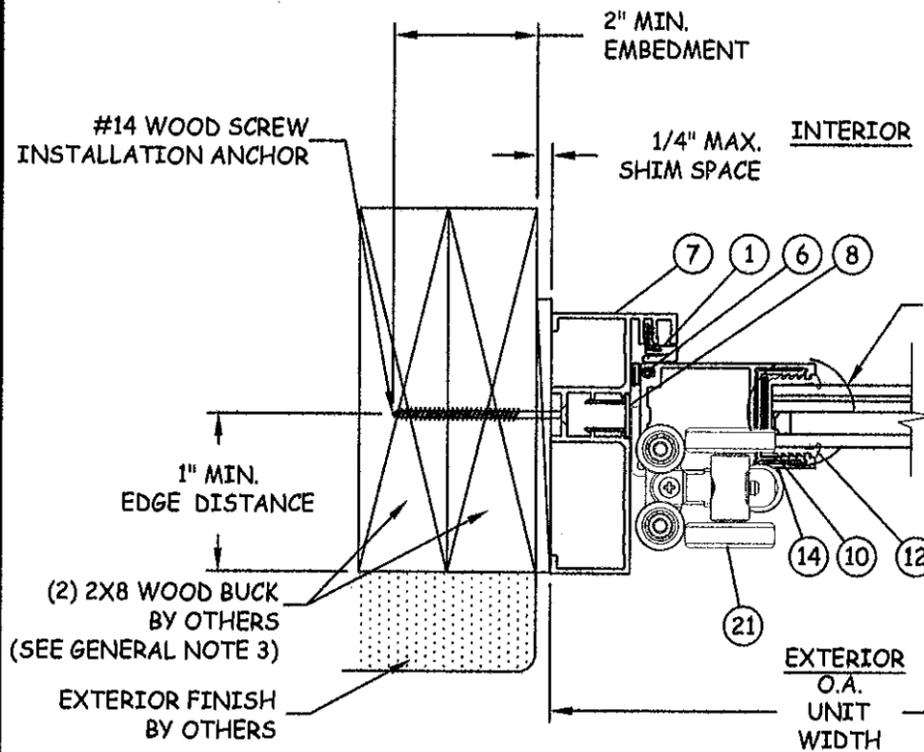


O6 HORIZONTAL SECTION
JAMB - 2X WOOD FRAME
END CARRIER TO JAMB
(ONLY ON EVEN NUMBER CONFIGURATIONS, SEE SCHEDULE SHEET 10)

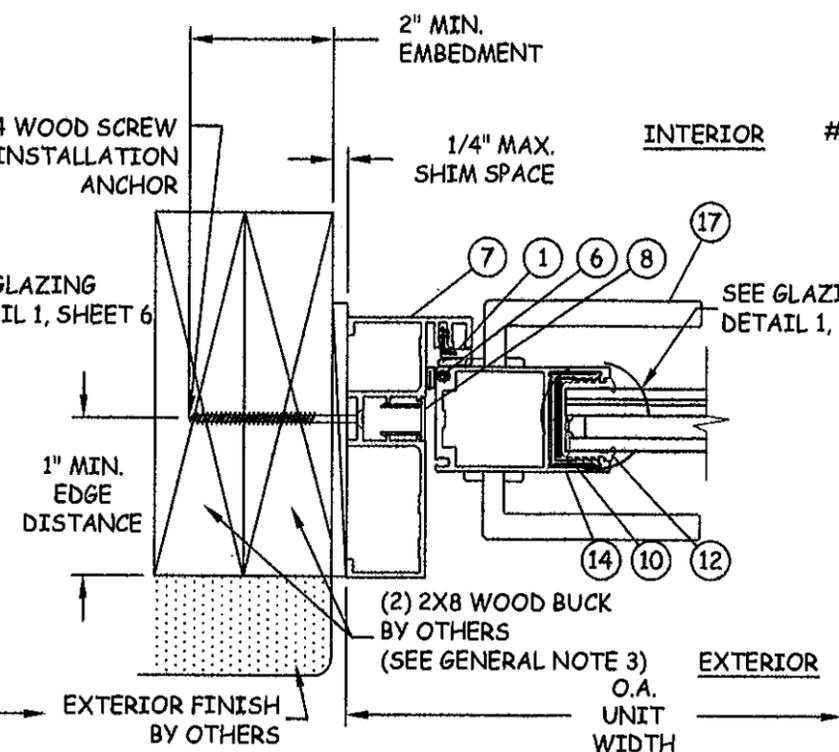


P6 HORIZONTAL SECTION
JAMB - 2X WOOD FRAME
MULTI POINT LOCK TO JAMB
(ONLY ON ODD NUMBER CONFIGURATIONS, SEE SCHEDULE SHEET 10)

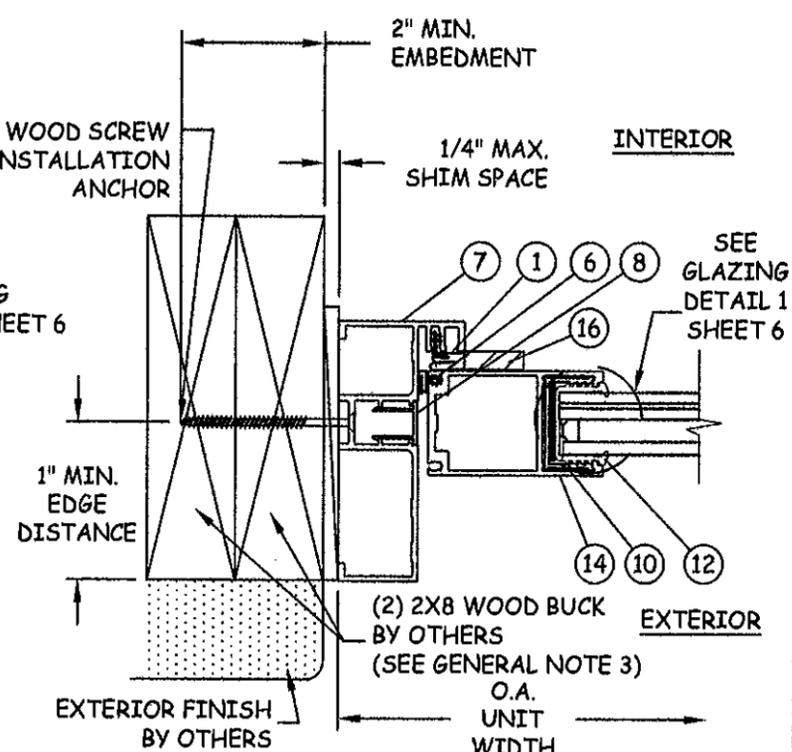

Q6 HORIZONTAL SECTION
JAMB W/ 2-PT. LOCK - 2X WOOD FRAME
TWIN BOLT LOCK TO JAMB
(ONLY ON ODD NUMBER CONFIGURATIONS, SEE SCHEDULE SHEET 10)

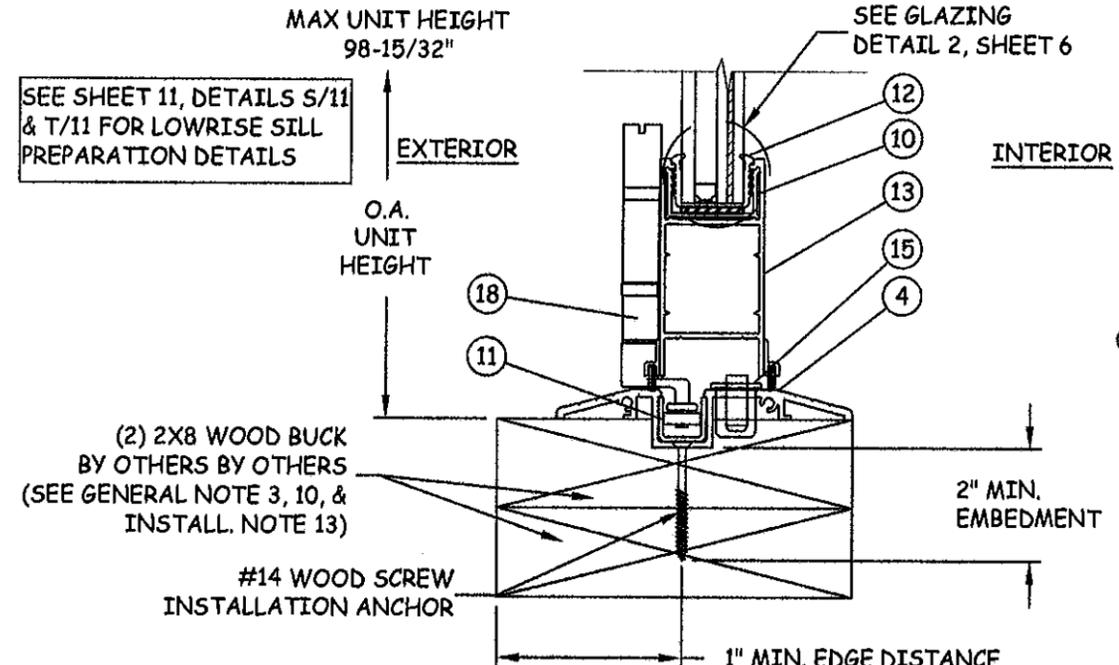


K6 VERTICAL SECTION
SILL-2X WOOD FRAME
LOWRISE THRESHOLD

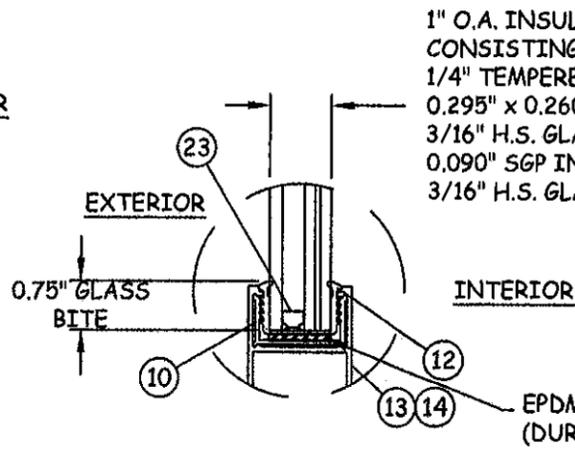

DRY GLAZING DETAIL 2

NOTE: GE II SILICONE
REQUIRED BETWEEN GLASS
AND FRAME WHERE WATER
INFILTRATION IS REQUIRED.

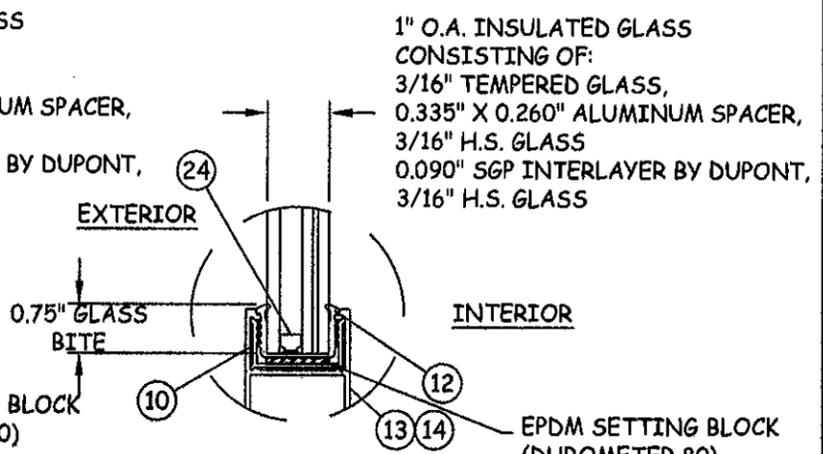

DRY GLAZING DETAIL 1

REVISIONS	DATE	BY
DESCRIPTION		
NO.		



Approved as complying with the
Florida Building Code
Date: 7/21/11
NGAS 10-1019-01
Miami Dade Product Control
By: [Signature]


DATE: 10.6.10
DWN BY: JLA
CHK BY: KSD
SCALE: NTS
DWG #: CIP001
SHEET: 6 OF 11




COASTAL INNOVATIVE PRODUCTS
 941 NORTH ELM STREET, STE. C
 ORANGE, CA 92867
 PH: (714) 744-6020 FX: (714) 744-6030

TITLE: E3 HURRICANE BIFOLD DOOR
 HORIZONTAL SECTIONS


PREPARED BY: CERTWORKS, LLC
 127 W. FAIRBANKS AVE., STE. 438
 WINTER PARK, FL 32789
 PH: (407) 644-6957 FX: (407) 644-2366

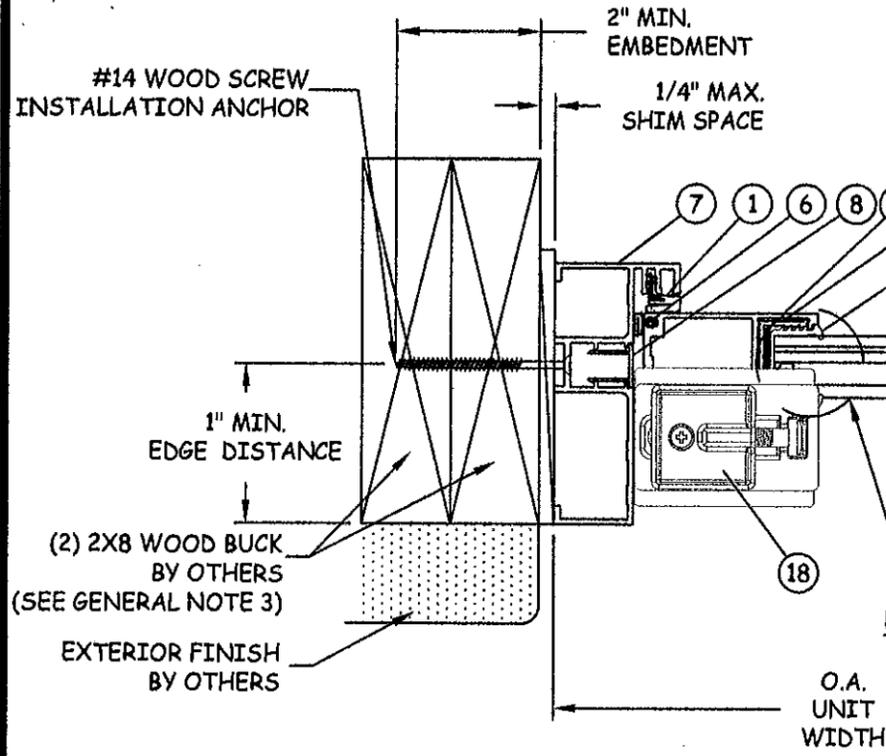


E
7
HORIZONTAL SECTION
JAMB - 2X WOOD BUCK

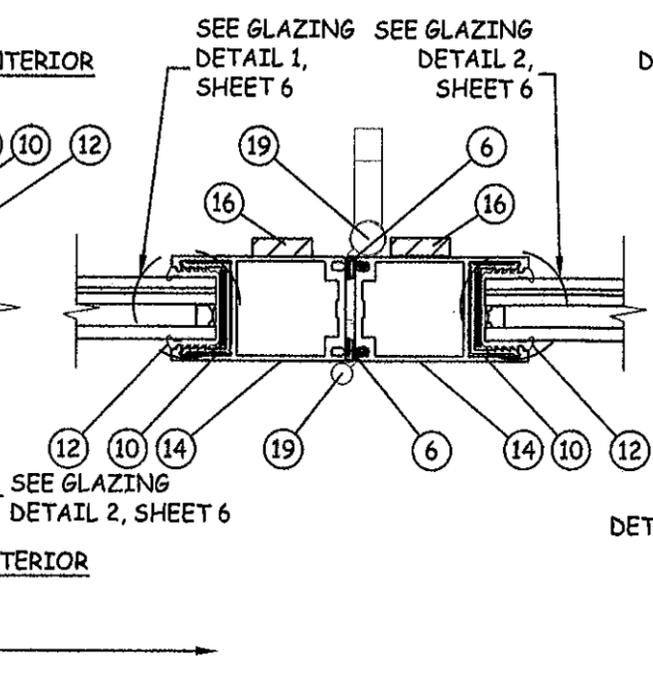


F
7
HORIZONTAL SECTION
HHS/HS & TWIN BOLTS

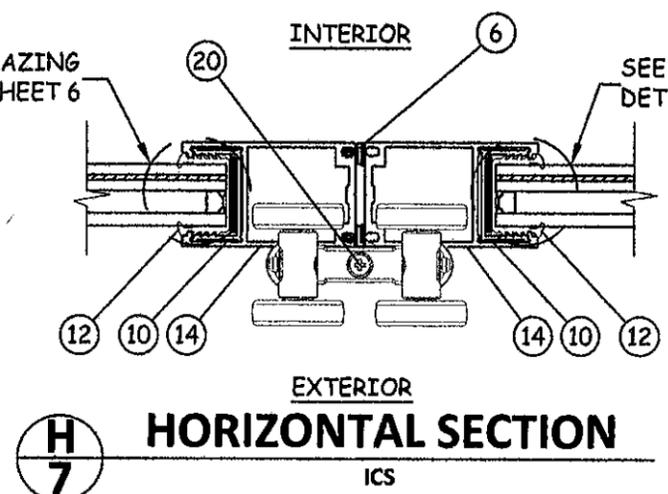


H
7
HORIZONTAL SECTION
ICS

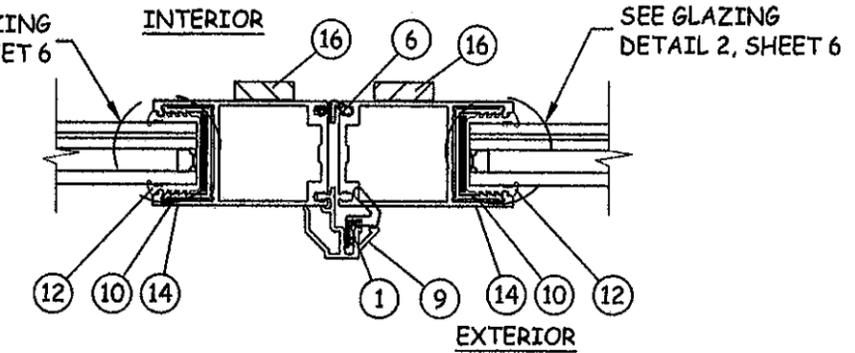


R
7
HORIZONTAL SECTION
DOUBLE TWIN BOLT

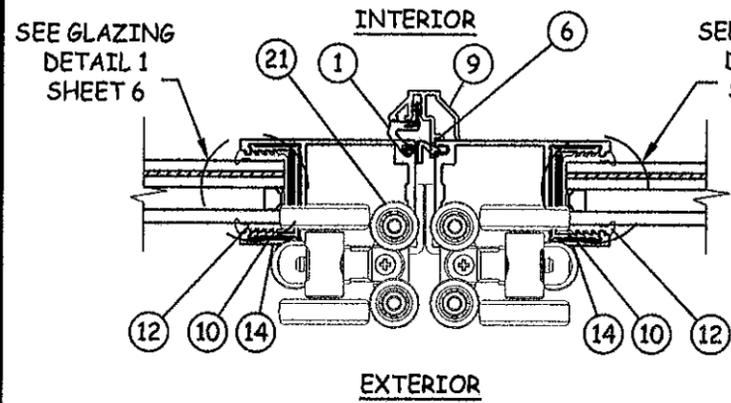

I
7
HORIZONTAL SECTION
RCS/LCS

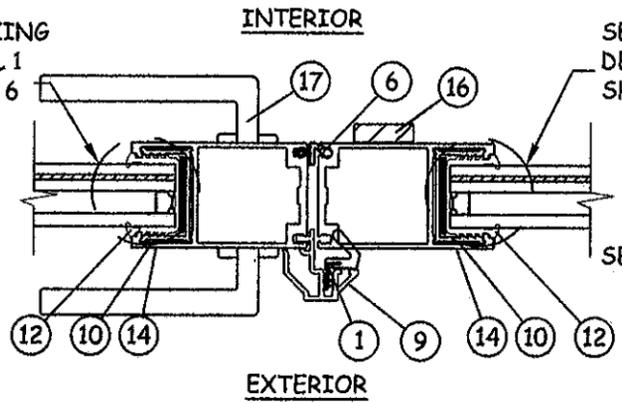

J
7
HORIZONTAL SECTION
4 POINT DOOR HANDLE & TWIN BOLT

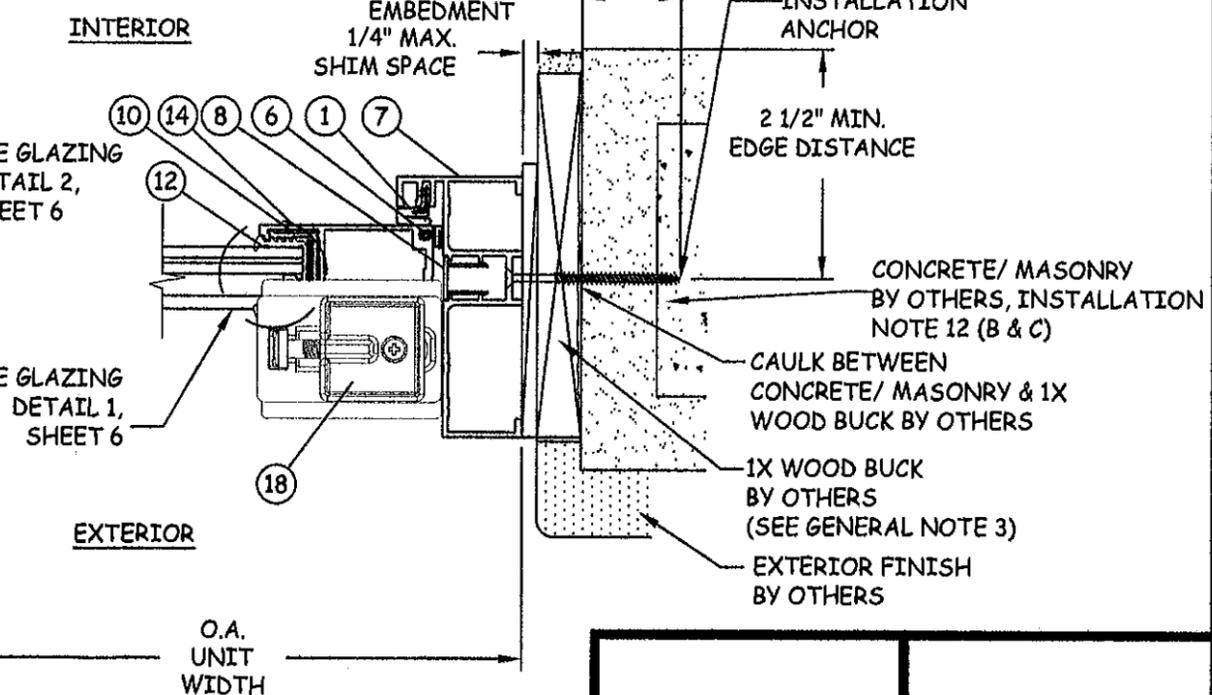

G
7
HORIZONTAL SECTION
JAMB - CONCRETE/MASONRY

Approved as complying with the Florida Building Code
 Date: 7/21/11
 NOA# 10-1014-01
 Miami Made Product Council
 By: [Signature]

REVISIONS	DESCRIPTION	DATE	BY













DATE: 10.6.10	DWN BY: JLA	CHK BY: KSD	SCALE: NTS
DWG #: CIP001			
SHEET: 7 OF 11			



COASTAL INNOVATIVE PRODUCTS
941 NORTH ELM STREET, STE. C
ORANGE, CA 92867
PH: (714) 744-6020 FX: (714) 744-6030

BILL OF MATERIALS				
ITEM NO.	DESCRIPTION	PART NUMBER	MATERIAL	MANUFACTURER
1	DOOR SEAL	QEBD 650	Q-LON	SCHLEGEL
2	HEADER		AL. 6063-T5	COASTAL INNOVATIVE PRODUCTS
3	STD. THRESHOLD		AL. 6063-T5	COASTAL INNOVATIVE PRODUCTS
4	LOWRISE THRESHOLD		AL. 6063-T5	COASTAL INNOVATIVE PRODUCTS
5	FLUSH GUIDE THRESHOLD		AL. 6063-T5	COASTAL INNOVATIVE PRODUCTS
6	WETAHERSEAL	QWS-DH1	Q-LON	SCHLEGEL
7	JAMB		AL. 6063-T5	COASTAL INNOVATIVE PRODUCTS
8	JAMB COVER		AL. 6063-T5	COASTAL INNOVATIVE PRODUCTS
9	ASTRAGAL		AL. 6063-T5	COASTAL INNOVATIVE PRODUCTS
10	GLAZING CLIP		AL. 6063-T5	COASTAL INNOVATIVE PRODUCTS
11	THRESHOLD INSERT		RIGID PVC	COASTAL INNOVATIVE PRODUCTS
12	DRY GLAZING GASKET		SANTOPRENE 101-64 TPV/TPE DUROMETER=64	COASTAL INNOVATIVE PRODUCTS (RAW MATERIAL BY EXXON MOBIL CHEMICAL CO.)
13	DOOR RAIL		AL. 6063-T5	COASTAL INNOVATIVE PRODUCTS
14	DOOR STILE		AL. 6063-T5	COASTAL INNOVATIVE PRODUCTS
15	DOUBLE SHOOT BOLT CUPS		ZYTEL 70633L NC010	
16	TWO PT. LOCK	TBL NL L/THROW	ZINC ALLOY	INTERLOCK
17	FOUR PT. LOCK	LCL 30R4PS	ZINC ALLOY	INTERLOCK
18	PIVOT	E3 CPS	STAINLESS STEEL	CENTOR
19	HINGES	E3 HS/ HHS/ HHNS/ HNHS/ HNH/ HNH	STAINLESS STEEL	CENTOR
20	ICS	E3 CRCS/CLCS	STAINLESS STEEL	CENTOR
21	END CARRIER RCS/LCS	E3 CICS	STAINLESS STEEL	CENTOR
22	MIDRAIL		AL. 6063-T5	COASTAL INNOVATIVE PRODUCTS
23	0.295" I.G. SPACER	756	AL. 6063-0	HELIMA
24	0.335" I.G. SPACER	856	AL. 6063-0	HELIMA

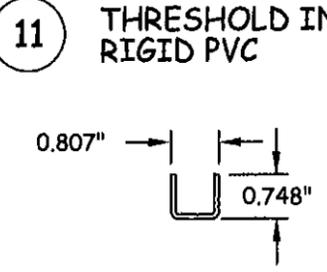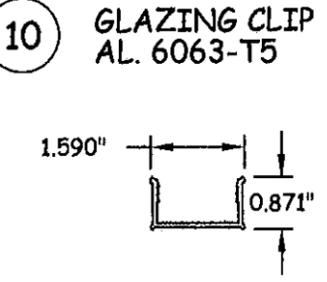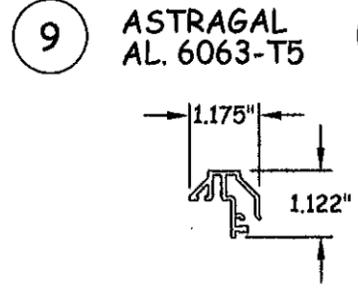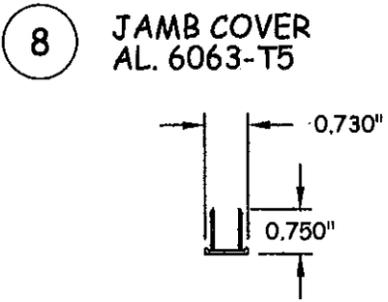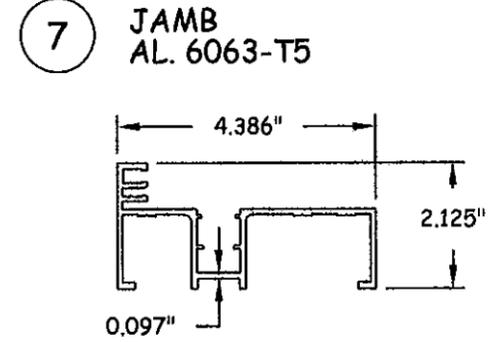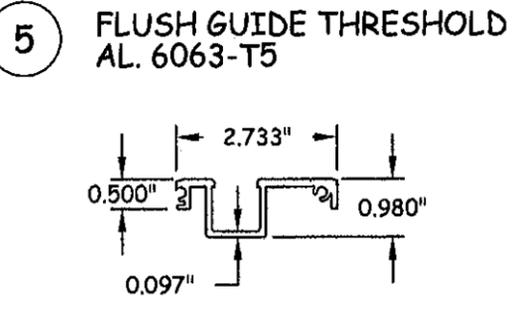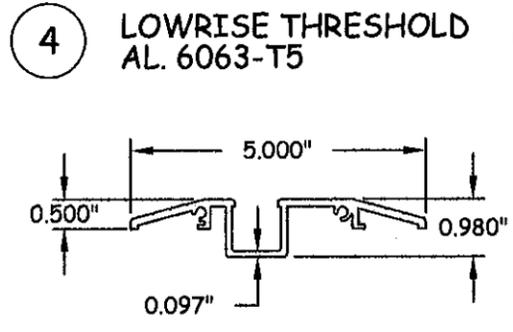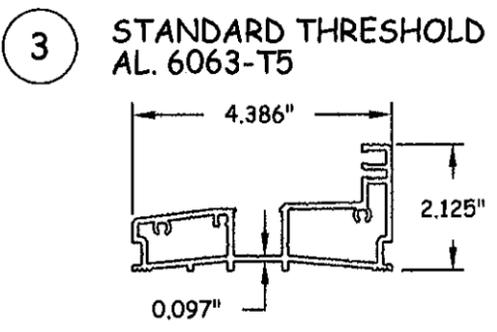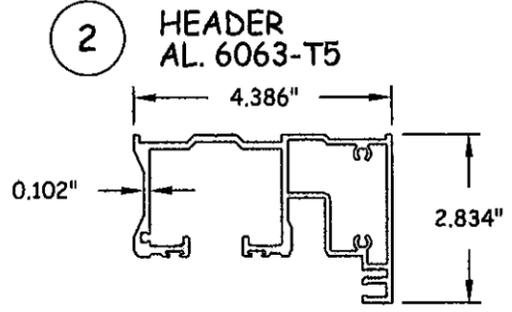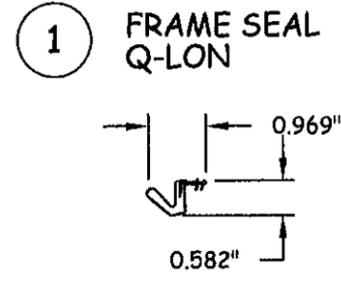

12 DRY GLAZING GASKET SANTOPRENE 101-64

- MIN. DUROMETER (SHORE A HARDNESS) = 64
- MIN. TENSILE STRENGTH @ BREAK = 1020 PSI
- COMPRESSION SET = 26%
- TEAR STRENGTH = 131 LBF/IN
- ELONGATION % = 340-463
- SPECIFIC GRAVITY = MIN. 0.96

TITLE: E3 HURRICANE BIFOLD DOOR COMPONENTS & BILL OF MATERIALS
PREPARED BY: CERTWORKS, LLC
127 W. FAIRBANKS AVE., STE. 438
WINTER PARK, FL 32789
PH: (407) 644-6957 FX: (407) 644-2366


REVISIONS	DESCRIPTION	BY	DATE




Approved as complying with the Florida Building Code
Date: 7/21/11
NDAS 10-1019.01
Miami Code Product Control
By: Isang J. Chaula

DATE: 10.6.10
DWN BY: JLA
CHK BY: KSD
SCALE: NTS
DWG #: CIP001
SHEET: 8 OF 11

13 DOOR RAIL
AL. 6063-T5

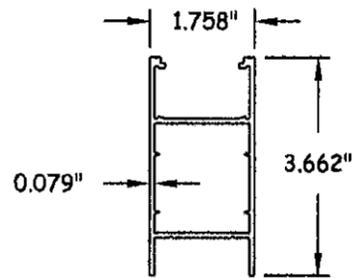

14 DOOR STILE
AL. 6063-T5

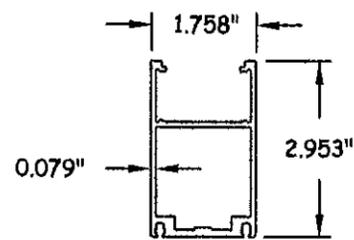


15 DOUBLE SHOOT BOLT CUPS
ZYTEL 70633L




16 TWO PT. LOCK
ZINC ALLOY




17 FOUR PT. LOCK
ZINC ALLOY

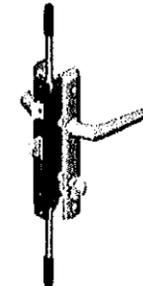


18 2-PIECE PIVOT SET
STAINLESS STEEL

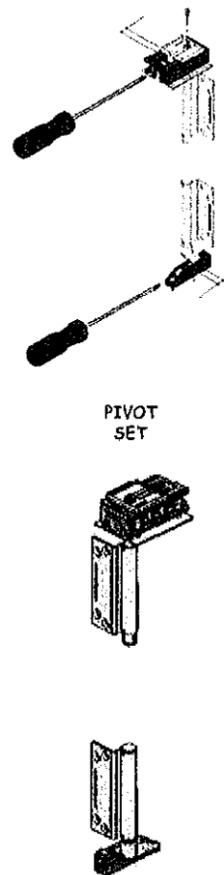


19 3-PIECE HINGE SET
STAINLESS STEEL

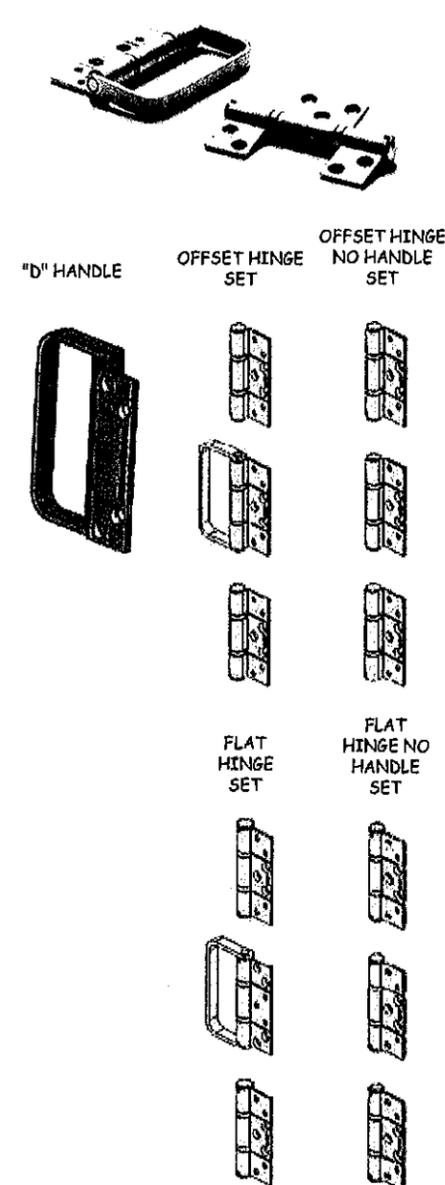


20 3-PIECE ICS SET
STAINLESS STEEL

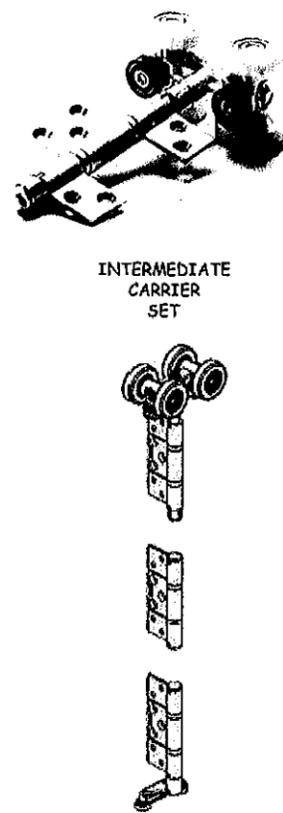


21 2-PIECE SET
END CARRIER (RCS/LCS)
STAINLESS STEEL

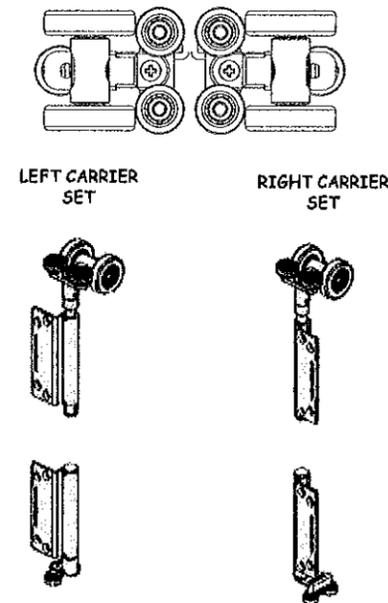


22 MIDRAIL
AL. 6063-T5

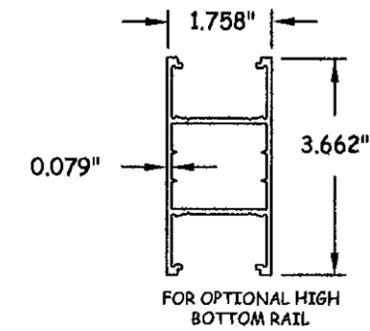

23 0.295" I.G. SPACER
AL. 6063-0

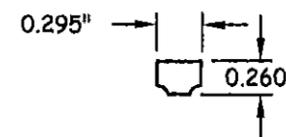


24 0.335" I.G. SPACER
AL. 6063-0

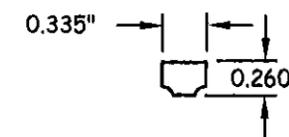

COASTAL INNOVATIVE PRODUCTS
941 NORTH ELM STREET, STE. C
ORANGE, CA 92667
PH: (714) 744-6020 FX: (714) 744-6030

TITLE: E3 HURRICANE BIFOLD DOOR COMPONENTS
PREPARED BY: CERTWORKS, LLC
127 W. FAIRBANKS AVE., STE. 438
WINTER PARK, FL 32789
PH: (407) 644-6957 FX: (407) 644-2366

NO.	DESCRIPTION	REVISIONS	
		BY	DATE

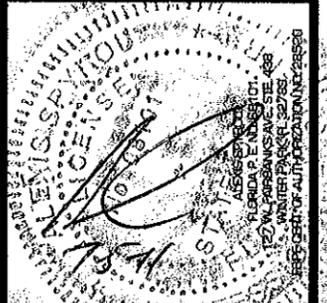


Approved as complying with the Florida Building Code
Date: 7/21/11
NDAS 10-1019.01
Miami State Product Control
By: Lyngal Chank

DATE: 10.6.10
DWN BY: JLA
CHK BY: KSD
SCALE: NTS
DWG #: CIP001
SHEET: 9 OF 11


PANEL CT.	QUALIFIED CONFIGURATIONS									
1	1L	1R	-	-	-	-	-	-	-	-
2	1L1R	2L	2R	-	-	-	-	-	-	-
3	1L2R	2L1R	3L	3R	-	-	-	-	-	-
4	1L3R	3L1R	2L2R	4L	4R	-	-	-	-	-
5	1L4R	4L1R	2L3R	3L2R	5L	5R	-	-	-	-
6	1L5R	5R1L	2L4R	4R2L	3L3R	6L	6R	-	-	-
7	1L6R	6L1R	2L5R	5L2R	3L4R	4R3L	7L	7R	-	-
8	1L7R	7L1R	2L6R	6L2R	3L5R	5L3R	4L4R	8L	8R	-
9	1L8R	8L1R	2L7R	7L2R	3L6R	6R3L	4L5R	5L4R	-	-
10	2L8R	8L2R	3L7R	7L3R	4L6R	6L4R	5L5R	-	-	-
11	3L8R	8L3R	4L7R	7L4R	5L6R	6L5R	-	-	-	-
12	4L8R	8L4R	5L7R	7L5R	6L6R	-	-	-	-	-
13	5L8R	8L5R	6L7R	7L6R	-	-	-	-	-	-
14	6L8R	8L6R	7L7R	-	-	-	-	-	-	-
15	7L8R	8L7R	-	-	-	-	-	-	-	-
16	8L8R	-	-	-	-	-	-	-	-	-

NOTES:


- MAXIMUM PANEL SIZE: 36" X 96".
- END PANEL HARDWARE:
 - ODD TO ODD PANELS (I.E. 3L3R CONFIG.)- REQUIRE 4-PT LOCK (ITEM 17) OR 2-PT LOCK (ITEM 16) ON ACTION PANEL (#3L OR #3R) AND 2-PT LOCK (ITEM 16) ON THE STRIKE-PLATE PANEL (#3R OR #3L)
 - ODD TO EVEN PANELS (I.E. 3L2R CONFIG.)- REQUIRE 4-PT LOCK (ITEM 17) OR 2-PT LOCK (ITEM 16) ON ACTION PANEL (#3L) AND ONE END CARRIER (ITEM 21) (#2R)
 - EVEN TO EVEN PANELS (I.E. 2L4R CONFIG.) - REQUIRE ONE END CARRIER (ITEM 21) ON BOTH PANELS (#2L AND #4R);
 - ODD PANEL INTO JAMB (I.E. 5L CONFIG.) - REQUIRE EITHER 4-PT LOCK (ITEM 17) OR 2-PT LOCK (ITEM 16) ON ACTION PANEL (#5L)
 - EVEN PANEL INTO JAMB (I.E. 6L) - REQUIRE ONE END CARRIER (ITEM 21) (#6L)
- HINGED JOINT PANELS - ALL HINGED PANELS REQUIRE THREE HINGES (ITEM 19) AND TWO 2-PT LOCKS (ITEM 16)
- CARRIER JOINT PANELS - ALL EVEN NUMBERED PANELS REQUIRE AN ICS (ITEM 20) AT THE TOP OF THE PANEL, A HINGE (ITEM 20) IN THE CENTER AND A CONCEALED INTERMEDIATE GUIDE (ITEM 20) AT THE BOTTOM

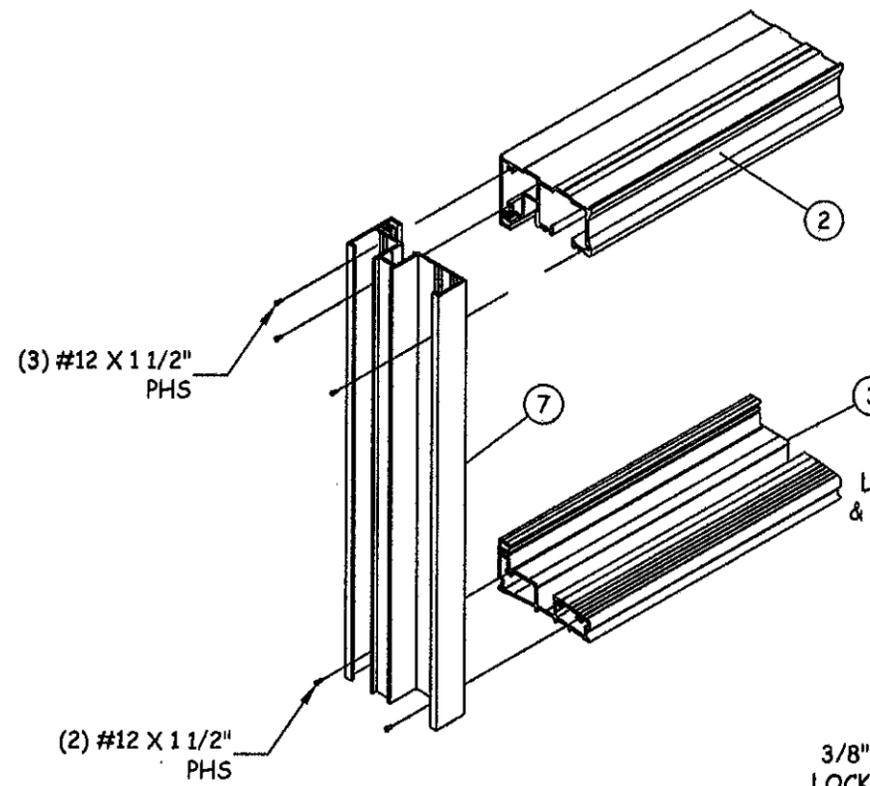

L
10 **FRAME CORNER DETAIL**
DOOR FRAME WITH STANDARD SILL SHOWN

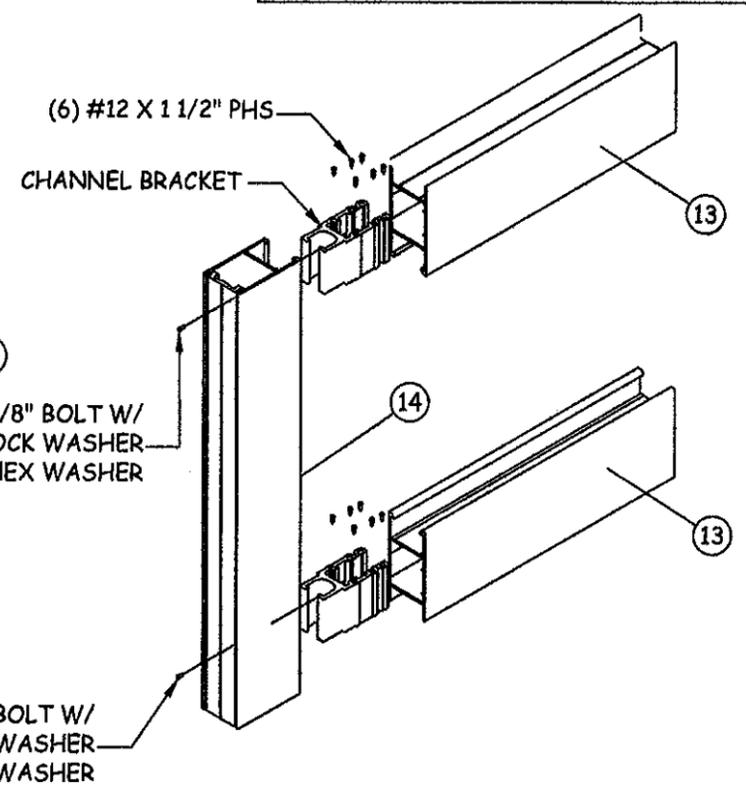

M
10 **PANEL CORNER DETAIL**
DOOR PANEL

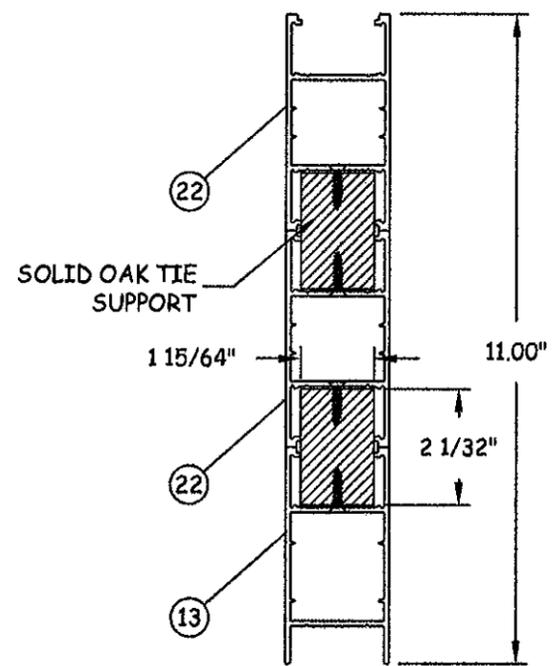

N
10 **VERTICAL SECTION**
OPTIONAL HIGH BOTTOM RAIL (WOOD REINFORCED)


Approved as complying with the Florida Building Code
Date 7/21/11
NOAS 10-1019-01
Holland Bode Product Control
By [Signature]



COASTAL INNOVATIVE PRODUCTS
941 NORTH ELM STREET, STE. C
ORANGE, CA 92867
PH: (714) 744-6020 FX: (714) 744-6030

TITLE: HURRICANE BIFOLD DOOR CORNER DETAILS & CONFIGURATIONS
PREPARED BY: CERTWORKS, LLC
127 W. FAIRBANKS AVE., STE. 438
WINTER PARK, FL 32789
PH: (407) 644-6957 FX: (407) 644-2366


REVISIONS	DESCRIPTION	BY	DATE
		NO.	

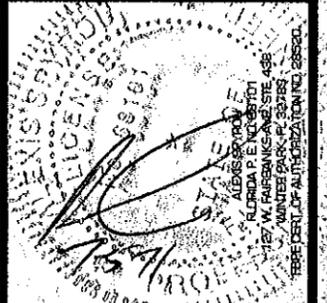


DATE: 10.6.10
DWN BY: JLA
CHK BY: KSD
SCALE: NTS
DWG #: CIP001
SHEET: 10 OF 11



COASTAL INNOVATIVE PRODUCTS
941 NORTH ELM STREET, STE. C
ORANGE, CA 92867
PH: (714) 744-6020 FX: (714) 744-6030

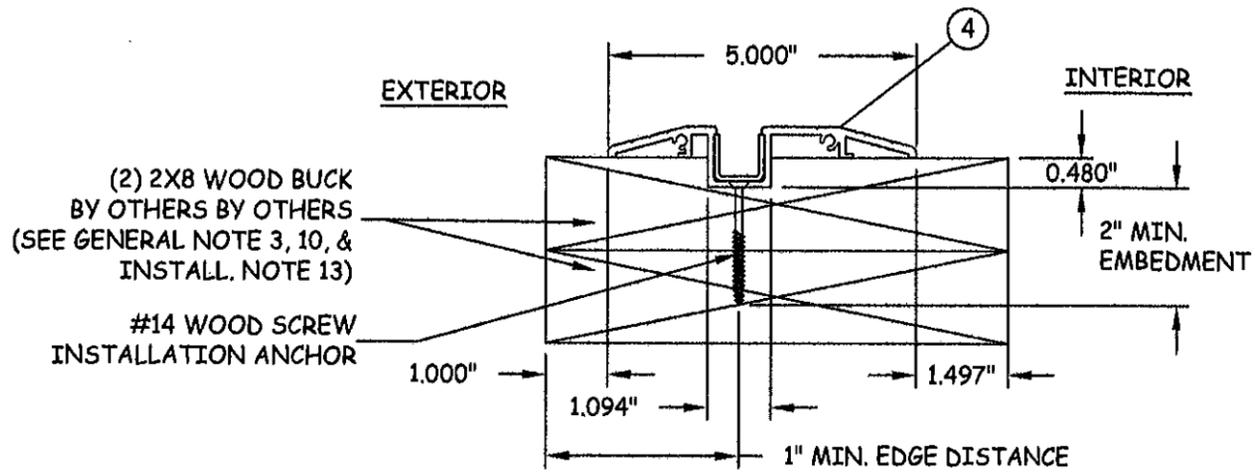


S11 LOW-RISE SILL DETAIL
2X8 WOOD BUCK INSTALLATION PREPARATION

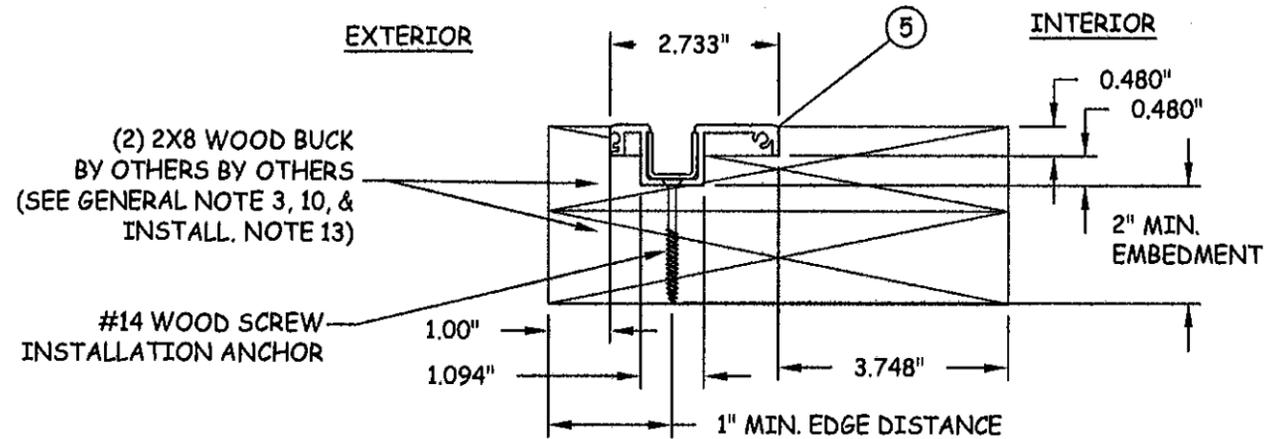


U11 FLUSH SILL DETAIL
2X8 WOOD BUCK INSTALLATION PREPARATION

ALL SUBSTRATES MUST BE RECESSED AND/OR ROUTED TO ACCOMMODATE THESE COMPONENTS PRIOR TO INSTALLATION. ALL EDGE DISTANCES AND EMBEDMENTS FOR ANCHORS MUST BE MAINTAINED AS NOTED IN THIS SHEET.

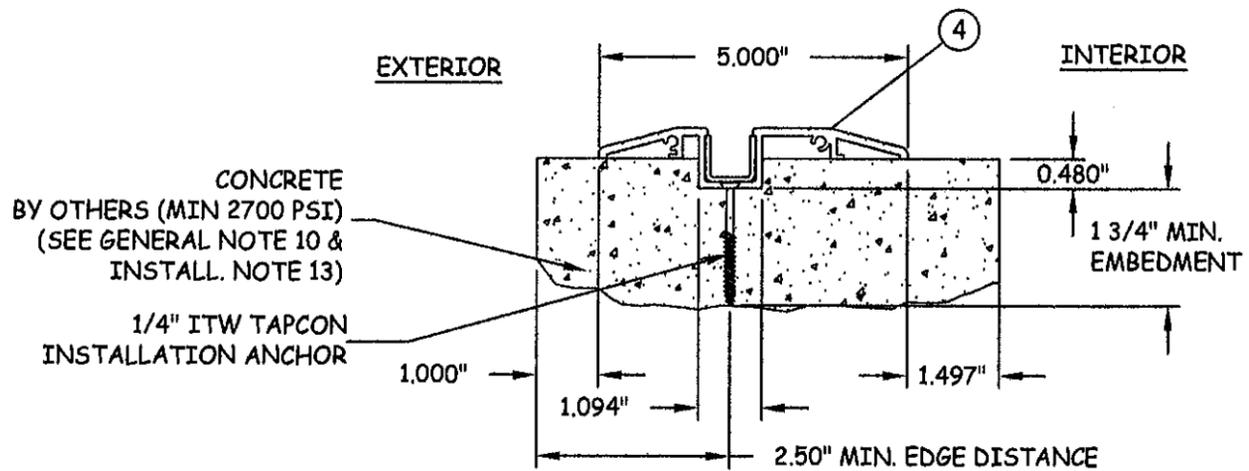


T11 LOW-RISE SILL DETAIL
CONCRETE INSTALLATION PREPARATION

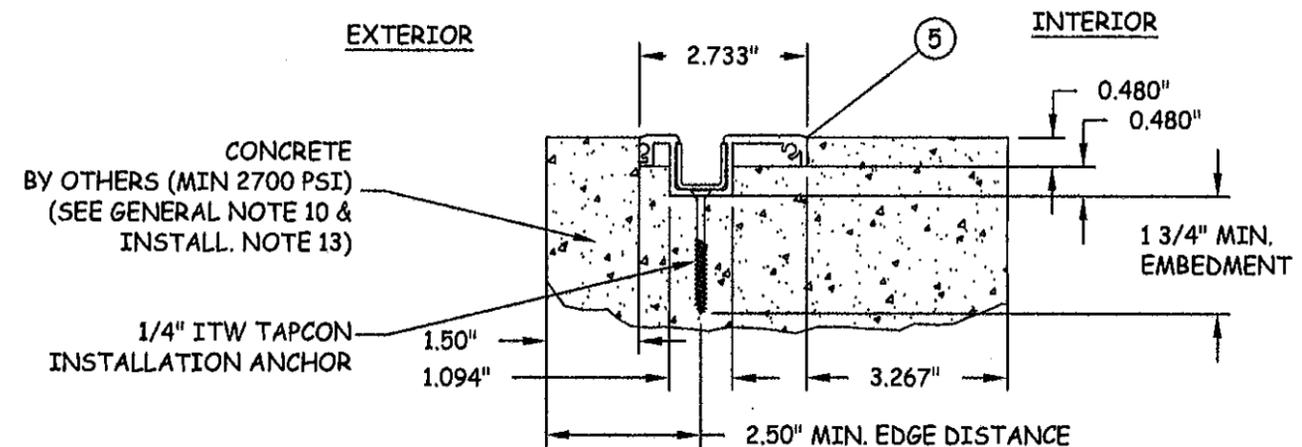

V11 FLUSH SILL DETAIL
CONCRETE INSTALLATION PREPARATION

TITLE: E3 HURRICANE BIFOLD DOOR INSTALLATION PREPARATION DETAILS
PREPARED BY: CERTWORKS, LLC
127 W. FAIRBANKS AVE., STE. 438
WINTER PARK, FL 32789
PH: (407) 644-6957 FX: (407) 644-2366

REVISIONS	DESCRIPTION	DATE	
		BY	
NO.			

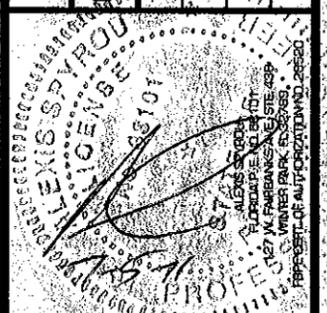

Approved as complying with the Florida Building Code
Date: July 21, 2011
NOA# 10-1019-01
Miami Dade Product Control
By: Ishag I. Chaud

DATE: 10.6.10
DWN BY: JLA
CHK BY: KSD
SCALE: NTS
DWG #: CIP001
SHEET: 11 OF 11