



DEPARTMENT OF REGULATORY AND ECONOMIC RESOURCES (RER)
 BOARD AND CODE ADMINISTRATION DIVISION
NOTICE OF ACCEPTANCE (NOA)

SMI Aluminum System, LLC
 11305 NW 128th Street
 Medley, FL 33178

SCOPE:

This NOA is being issued under the applicable rules and regulations governing the use of construction materials. The documentation submitted has been reviewed and accepted by Miami-Dade County RER -Product Control Section to be used in Miami Dade County and other areas where allowed by the Authority Having Jurisdiction (AHJ).

This NOA shall not be valid after the expiration date stated below. The Miami-Dade County Product Control Section (In Miami Dade County) and/or the AHJ (in areas other than Miami Dade County) reserve the right to have this product or material tested for quality assurance purposes. If this product or material fails to perform in the accepted manner, the manufacturer will incur the expense of such testing and the AHJ may immediately revoke, modify, or suspend the use of such product or material within their jurisdiction. RER reserves the right to revoke this acceptance, if it is determined by Miami-Dade County Product Control Section that this product or material fails to meet the requirements of the applicable building code.

This product is approved as described herein, and has been designed to comply with the Florida Building Code, including the High Velocity Hurricane Zone.

DESCRIPTION: Series "SM-2/K-2 breeze" Single Outswing Aluminum Entrance Door w/wo SHW

APPROVAL DOCUMENT: Drawing No. **W03-62 Rev D**, titled "Series SM-2/K-2 Breeze Alum Entrance Door (L.M.I.)", prepared by Al-Farooq Corporation, sheets 1 through 7 of 7, dated 08/07/03 and last revised on APR 26, 2012, signed and sealed by Javad Ahmad, P.E., bearing the Miami-Dade County Product Control renewal stamp with the Notice of Acceptance number and expiration date by the Miami-Dade County Product Control Section.

MISSILE IMPACT RATING: Large and Small Missile Impact Resistant

Limitations:

1. See Design Pressure (DP) ratings doors w/wo SHW (Single Hung Window). Lower DP of SHW or Single door shall control.
2. ADA threshold and Alt ADA threshold in sheet 2 are not rated for water, unless covered by canopy or overhang complying w/ FBC requirements.

LABELING: Each unit shall bear a permanent label with the manufacturer's name or logo, city, state and series and following statement: "Miami-Dade County Product Control Approved", noted herein.

RENEWAL of this NOA shall be considered after a renewal application has been filed and there has been no change in the applicable building code negatively affecting the performance of this product.

TERMINATION of this NOA will occur after the expiration date or if there has been a revision or change in the materials, use, and/or manufacture of the product or process. Misuse of this NOA as an endorsement of any product, for sales, advertising or any other purposes shall automatically terminate this NOA. Failure to comply with any section of this NOA shall be cause for termination and removal of NOA.

ADVERTISEMENT: The NOA number preceded by the words Miami-Dade County, Florida, and followed by the expiration date may be displayed in advertising literature. If any portion of the NOA is displayed, then it shall be done in its entirety.

INSPECTION: A copy of this entire NOA shall be provided to the user by the manufacturer or its distributors and shall be available for inspection at the job site at the request of the Building Official.
 This NOA renews NOA # 12-0501.09 and consists of this page 1 and evidence pages E-1 & E-2, as well as approval document mentioned above.

The submitted documentation was reviewed by Ishaq I. Chanda, P.E.



Handwritten signature and date: 7/10/13

NOA No. 13-0510.10
 Expiration Date: December 04, 2018
 Approval Date: July 18, 2013
 Page 1

NOTICE OF ACCEPTANCE: EVIDENCE SUBMITTED

A. DRAWINGS

1. Manufacturer's die drawings and sections (submitted under file # 12-0501.09)
2. Drawing No. **W03-62 Rev D**, titled "Series SM-2/K-2 Breeze Alum Entrance Door (L.M.I.)", prepared by Al-Farooq Corporation, sheets 1 through 7 of 7, dated 08/07/03 and last revised on APR 26, 2012, signed and sealed by Javad Ahmad, P.E.

B. TESTS (submitted under files # 12-0501.09/# 09-0223.09)

1. Test reports on:
 - 1) Air Infiltration Test, per FBC, TAS 202-94
 - 2) Uniform Static Air Pressure Test, Loading per FBC TAS 202-94
 - 3) Water Resistance Test, per FBC, TAS 202-94
 - 4) Large Missile Impact Test per FBC, TAS 201-94
 - 5) Cyclic Wind Pressure Loading per FBC, TAS 203-94
 - 6) Forced Entry Test, per FBC 2411 3.2.1, TAS 202-94

along with marked-up drawings and installation diagram of a terrace door, prepared by Fenestration Testing Laboratory, Inc., Test Report No. **FTL-5406**, dated 04/18/08, signed and sealed by Carlos Rionda P.E.

2. Test reports on:
 - 1) Air Infiltration Test, per FBC, TAS 202-94
 - 2) Uniform Static Air Pressure Test, Loading per FBC TAS 202-94
 - 3) Water Resistance Test, per FBC, TAS 202-94
 - 4) Large Missile Impact Test per FBC, TAS 201-94
 - 5) Cyclic Wind Pressure Loading per FBC, TAS 203-94
 - 6) Forced Entry Test, Per FBC 2411 3.2.1 and TAS 202-94

along with marked-up drawings and installation diagram of a terrace door, prepared by Fenestration Testing Laboratory, Inc., Test Report No. **FTL-3824**, dated 06/19/03, signed and sealed by Joseph Chan, P.E. (submitted under files # 09-0223.09/#03-0925.02).

C. CALCULATIONS (submitted under file # 12-0501.09)

1. Anchor Verification Calculations and structural analysis complying w/ FBC 2010, prepared by AL-Farooq Corporation, dated 04/15/11, signed and sealed by Javad Ahmad, P.E.
2. Glazing complies w/ ASTM E-1300-02 & -04

D. QUALITY ASSURANCE

1. Miami Dade Department of Regulatory and Economic Resources (RER).

E. MATERIAL CERTIFICATIONS

1. Notice of Acceptance No. **11-0325.05** issued to Solutia, for "Saflex clear & color interlayer", expiring on 05/21/2016.
2. Notice of Acceptance No. **12-0130.01** issued to Cytec industries Inc. for "Uvekol Laminated glass, expiring on 02/08/2014



Ishaq I. Chanda, P.E.
Product Control Examiner
NOA No. 13-0510.10


Expiration Date: December 04, 2018
Approval Date: July 18, 2013

NOTICE OF ACCEPTANCE: EVIDENCE SUBMITTED


- F. STATEMENTS** (All items below except #1, submitted under file #12-0501.09)
1. Statement letter dated 07/10/13 by SMI Alum Sys for Renewal with No change
 2. Statement letter of conformance to FBC 2010 and letter of no financial interest, prepared by Al Farooq Corporation, dated 10/21/11, signed and sealed by Javad Ahmad, P.E.
 3. Asset purchase agreement dated SEP 17, 2010 between Smith Mountain Acquisition Co.LLC (Buyer) and Pande Pande, LLC (Seller) signed by Leon Silverstein, Manager and Jim Pande, Manager respectively on behalf of the companies.
 4. Statement letter dated DEC 06, 2011, issued by Pande Pande, LLC dba SMI System or Smith Mountain Impact System of sales of asset and relinquishing of all rights of NOA # 09-0223.09, signed by Jim Pande, President.
 5. Statement letter dated NOV 11, 2011, issued by SMI Aluminum System of purchased of asset of SMI System dba Pande Pande, LLC, signed by Manny Valladares.
 6. Laboratory compliance letter, part of above referenced test reports.
- G. OTHER**
1. This NOA **renews NOA # 12-0501.09** expiring on DEC. 04, 2018.
 2. Previous NOA associated with this file is **NOA # 09-0223.09 (Former SMI-System by Pande Pane)**.
 3. Test proposal # 07-3217 dated July 27, 2007 approved by BCCO.



Ishaq I. Chanda, P.E.
Product Control Examiner
NOA No. 13-0510.10
Expiration Date: December 04, 2018
Approval Date: July 18, 2013

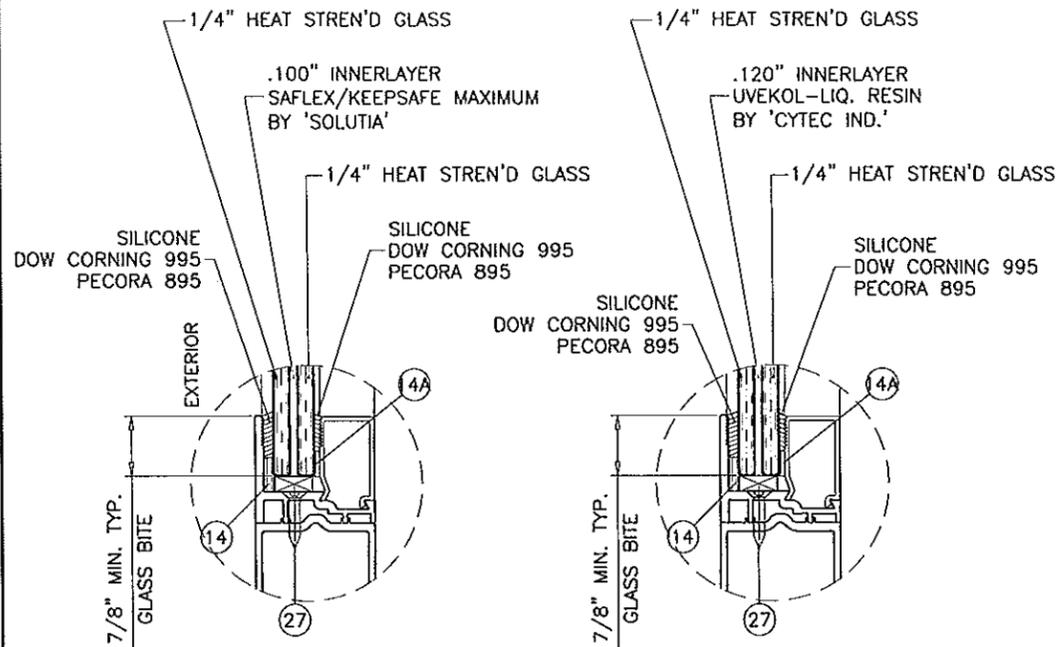

GLAZING OPTIONS

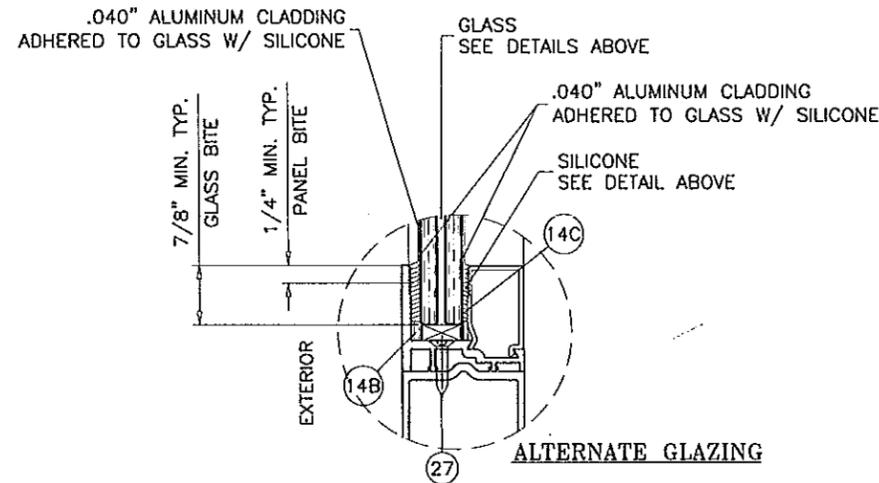

ALTERNATE GLAZING

SERIES SMK-2/K-2 BREEZE ALUMINUM ENTRANCE DOOR

APPROVAL APPLIES TO SINGLE LEAF (X) DOORS WITH OR WITHOUT WINDOW INSERT.
 SEE SEPARATE NOA FOR WINDOW CAPACITY.
 LOWER DESIGN PRESSURES FROM DOOR OR SINGLE HUNG WINDOW APPROVAL WILL APPLY TO ENTIRE SYSTEM.

THIS PRODUCT HAS BEEN DESIGNED AND TESTED TO COMPLY WITH THE REQUIREMENTS OF THE FLORIDA BUILDING CODE INCLUDING HIGH VELOCITY HURRICANE ZONE (HVHZ).


WOOD BUCKS BY OTHERS, MUST BE ANCHORED PROPERLY TO TRANSFER LOADS TO THE STRUCTURE.

ANCHORS SHALL BE AS LISTED, SPACED AS SHOWN ON DETAILS, ANCHORS EMBEDMENT TO BASE MATERIAL SHALL BE BEYOND WALL DRESSING OR STUCCO.

ANCHORING OR LOADING CONDITIONS NOT SHOWN IN THESE DETAILS ARE NOT PART OF THIS APPROVAL.


A LOAD DURATION INCREASE IS USED IN DESIGN OF ANCHORS INTO WOOD ONLY.

MATERIALS INCLUDING BUT NOT LIMITED TO STEEL/METAL SCREWS, THAT COME INTO CONTACT WITH OTHER DISSIMILAR MATERIALS SHALL MEET THE REQUIREMENTS OF THE FLORIDA BLDG. CODE SECTION 2003.8.4.

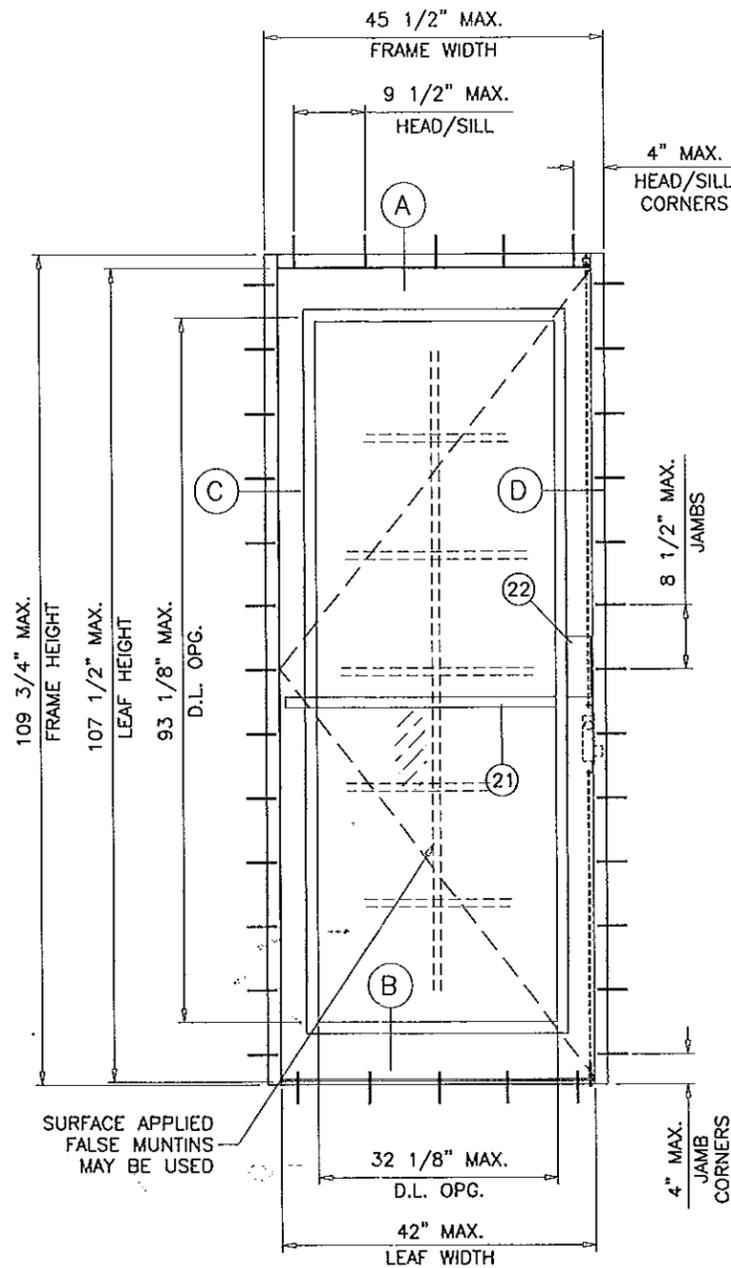

TYPICAL ELEVATION

MAXIMUM DESIGN LOAD RATING = + 100.0 PSF
 (FOR SIZES SHOWN ABOVE OR SMALLER) - 120.0 PSF
 DOORS WITHOUT WINDOWS

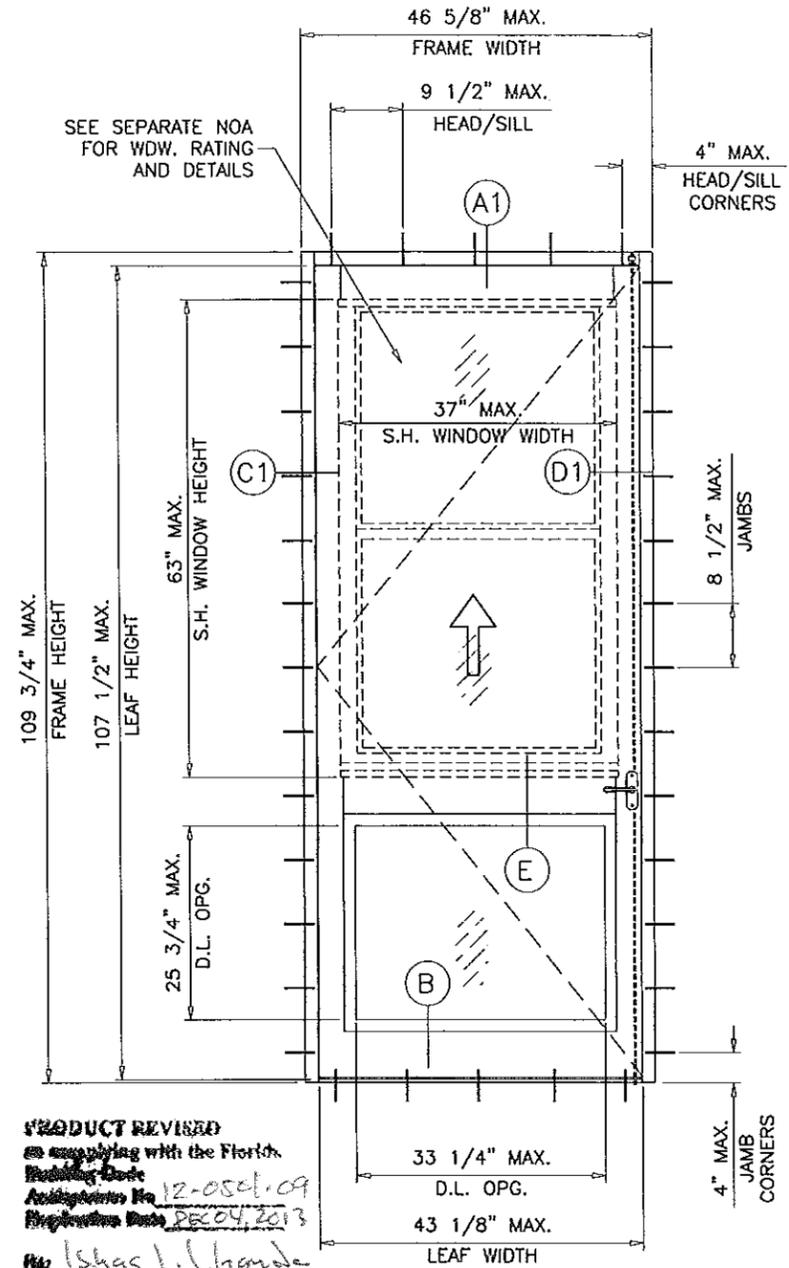

TYPICAL ELEVATION

MAXIMUM DESIGN LOAD RATING = + 90.0 PSF *
 (FOR SIZES SHOWN ABOVE OR SMALLER) - 120.0 PSF
 DOORS WITH WINDOWS

* LOWER RATING OF SINGLE HUNG WINDOW OR SINGLE DOOR SHALL CONTROL

THESE DOORS ARE RATED FOR LARGE MISSILE IMPACT.
 SHUTTERS ARE NOT REQUIRED.

NOTE:
 GLASS CAPACITIES ON THIS SHEET ARE
 BASED ON ASTM E1300-04 (3 SEC. GUSTS).

Engr: JAVAD AHMAD
 CIVIL
 FLA. PE # 70592
 C.A.N. 3538

APR 26 2012


PRODUCT RENEWED
 as complying with the Florida
 Building Code
 Acceptance No 13-0510-10
 Expiration Date 02/04/2018
 By: [Signature]
 Miral Bldg Product (0000)

afC
AL-FAROOQ CORPORATION
 ENGINEERS & PRODUCT DEVELOPMENT
 1235 S.W. 87 AVE
 MIAMI, FLORIDA 33174
 TEL. (305) 264-9100 FAX. (305) 262-6978
 COMP-ANL W03-62SM


SMK-2/K-2 BREEZE ALUM ENTRANCE DOOR (L.M.L.)
SMI Aluminum Systems, LLC.
 11500 MIRAMAR PARKWAY SUITE 300
 MIRAMAR, FL. 33025
 TEL. (305) 888-6288 FAX. (305) 888-6289

NO	DATE	BY	DESCRIPTION
A	03.05.08		UPDATED FOR 2004 FBC
B	06.10.08		REV. PER BCCC COMMENTS
C	02.10.09		ALT. GLAZING DETAIL ADDED
D	10.21.11		MANUF. NAME REV.


date: 08-07-03
 scale: 1/2" = 1'-0"
 dr. by: HAMID
 chk. by:
 drawing no.
W03-62
 sheet 1 of 7

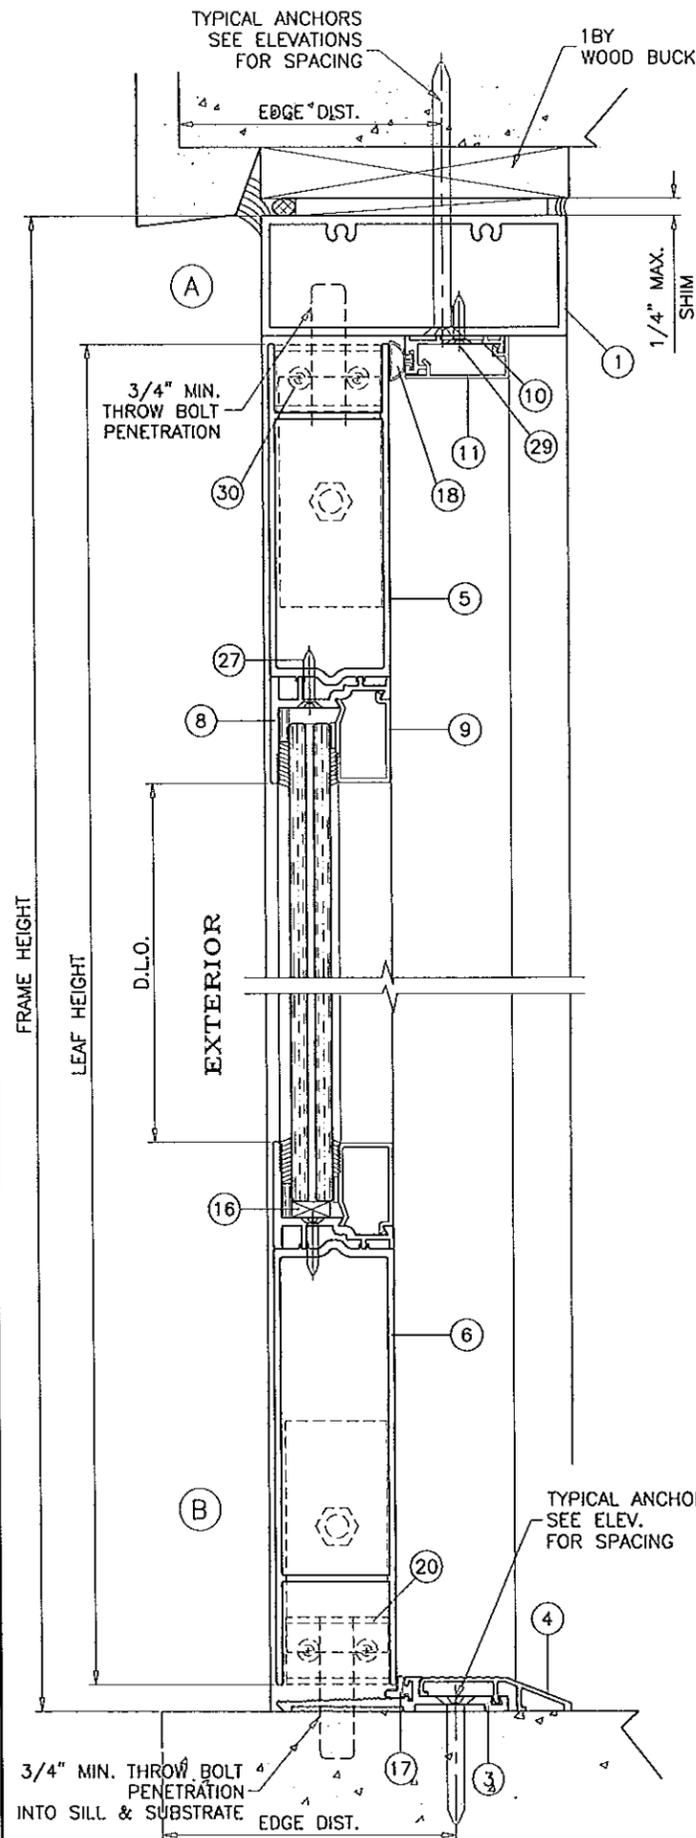


ADA BUMPER THRESHOLD

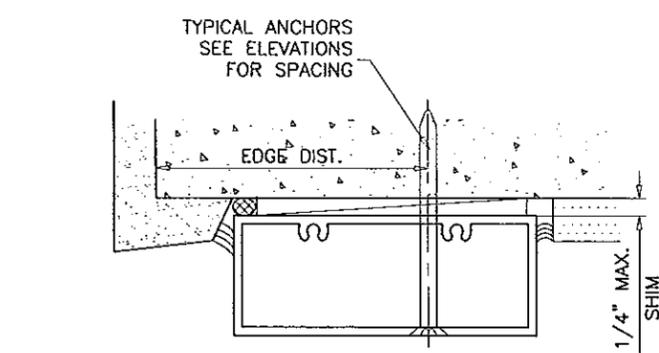

ALT. ADA BUMPER THRESHOLD

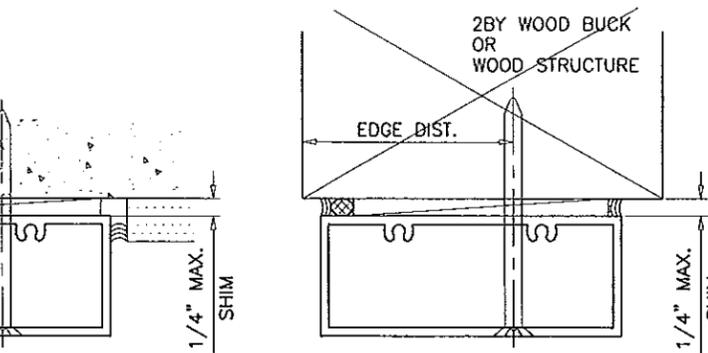

HI-RISE THRESHOLD

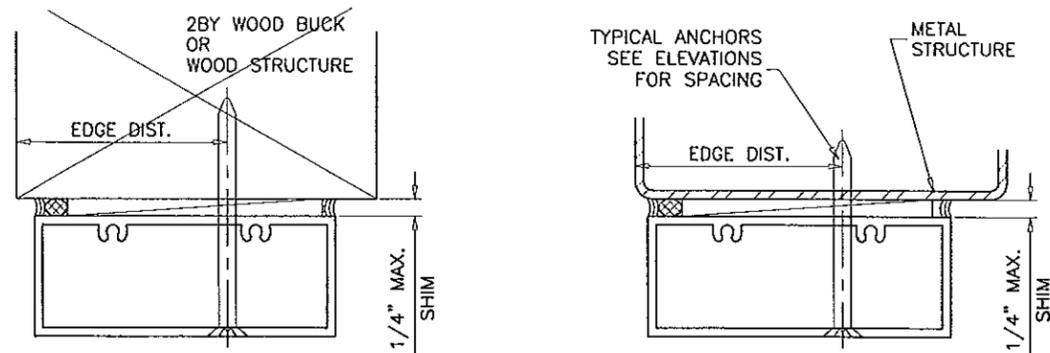

ALT. HI-RISE THRESHOLD

WOOD BUCKS AND METAL STRUCTURE NOT BY 'SMI SYSTEMS' MUST SUSTAIN LOADS IMPOSED BY GLAZING SYSTEM AND TRANSFER THEM TO THE BUILDING STRUCTURE.

TYPICAL ANCHORS: SEE ELEV. FOR SPACING
 1/4" DIA. ULTRACON BY 'ELCO' (Fu=177 KSI, Fy=155 KSI)
 INTO 2BY WOOD BUCKS OR WOOD STRUCTURES
 1-3/8" MIN. PENETRATION INTO WOOD
 THRU 1BY BUCKS INTO CONC. OR MASONRY
 1-1/4" MIN. EMBED INTO CONC. OR MASONRY
 DIRECTLY INTO CONC. OR MASONRY
 1-1/4" MIN. EMBED INTO CONC. OR MASONRY
 1/4" DIA. TEKS OR SELF DRILLING SCREWS (GRADE 5 CRS)
 INTO METAL STRUCTURES
 STEEL : 1/8" THK. MIN. (Fy = 36 KSI MIN.)
 ALUMINUM : 1/8" THK. MIN. (6063-T5 MIN.)
 (STEEL IN CONTACT WITH ALUMINUM TO BE PLATED OR PAINTED)

TYPICAL EDGE DISTANCE
 INTO CONCRETE AND MASONRY = 2" MIN.
 INTO WOOD STRUCTURE = 1" MIN.
 INTO METAL STRUCTURE = 3/4" MIN.

CONCRETE AT HEAD, SILL OR JAMBS f'c = 3000 PSI MIN.
 C-90 HOLLOW/FILLED BLOCK AT JAMBS f'm = 2000 PSI MIN.

PRODUCT REVIEWED
 as complying with the Florida
 Building Code
 Acceptance No 13-0510-10
 Expiration Date 12/14/12
 By *[Signature]*
 Miramir Product Control

PRODUCT REVIEWED
 as complying with the Florida
 Building Code
 Acceptance No 12-0501-09
 Expiration Date 12/04/12
 By *[Signature]*
 Miramir Product Control

#8 X 3/4" SMS
 AT 3" FROM ENDS
 AND AT MID SPAN

Engr: JAVAD AHMAD
 CIVIL
 FLA. PE # 70592
 C.A.N. 3538

[Signature]

APR 26 2012

afC
AL-FAROOQ CORPORATION
 ENGINEERS & PRODUCT DEVELOPMENT
 1235 S.W. 87 AVE
 MIAMI, FLORIDA 33174
 TEL. (305) 264-8100 FAX. (305) 262-6978
 COMP-ANL\W03-62SM



SMK-2/K-2 BREEZE ALUM ENTRANCE DOOR (L.M.I.)
SMI Aluminum Systems, LLC.
 11500 MIRAMAR PARKWAY SUITE 300
 MIRAMAR, FL. 33025
 TEL. (305) 888-6288 FAX. (305) 888-6289

no	date	description
A	03.05.08	UPDATED FOR 2004 FBC
B	06.10.08	NO CHANGE THIS SHEET
C	02.10.09	NO CHANGE THIS SHEET
D	10.21.11	MANUF. NAME REV.

date: 08-07-03
 scale: 3/8" = 1"
 dr. by: HAMID
 chk. by:

drawing no.
W03-62

sheet 2 of 7

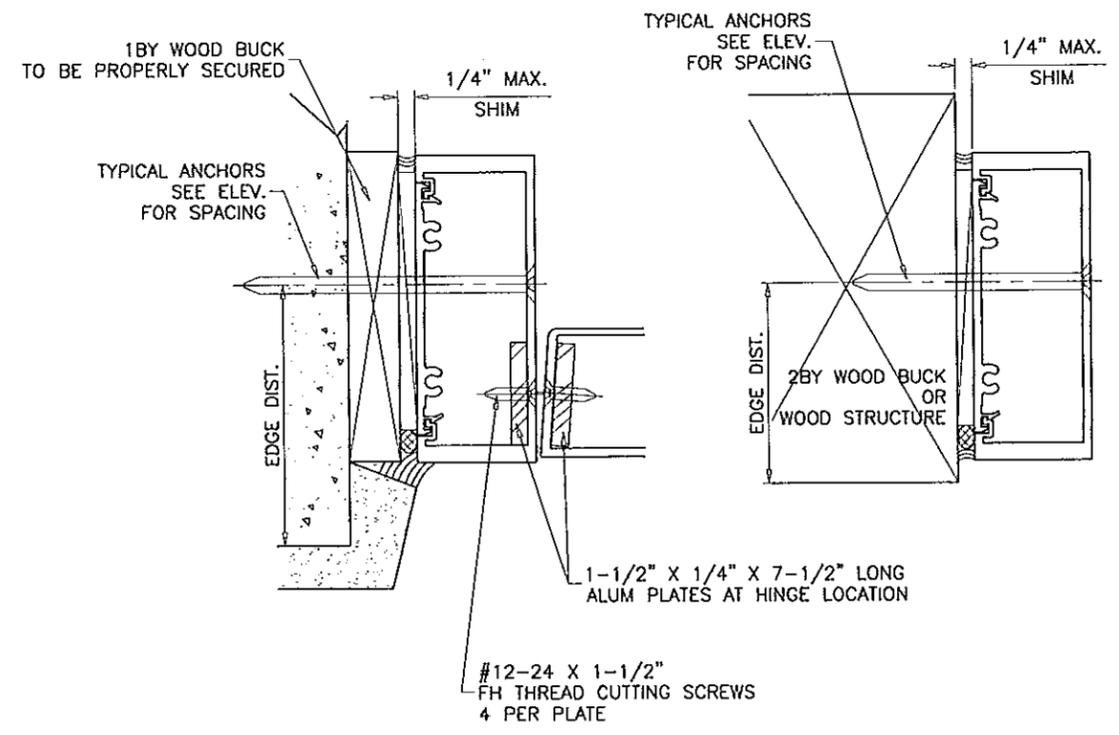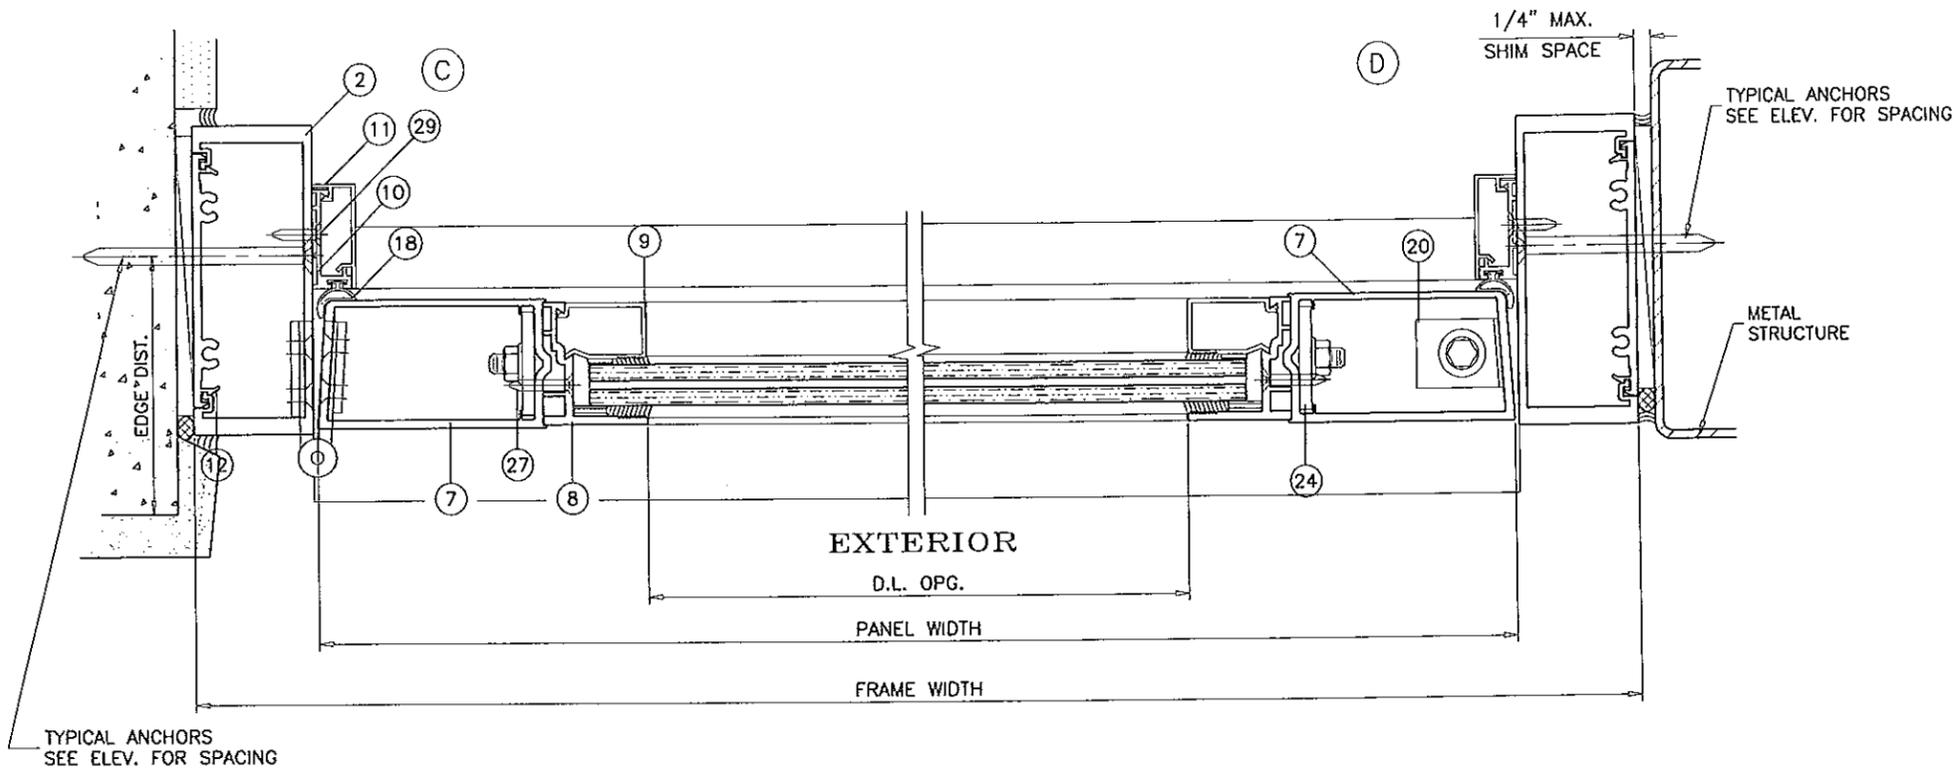

1-1/2" X 1/4" X 7-1/2" LONG
ALUM PLATES AT HINGE LOCATION

#12-24 X 1-1/2"
FH THREAD CUTTING SCREWS
4 PER PLATE

PRODUCT RENEWED
as complying with the Florida
Building Code
Acceptance No 13-0510-10
Expiration Date 12/4/18
By Shay I. Chaudhry
~~Product Control~~

PRODUCT REVISED
to comply with the Florida
Building Code
Acceptance No 12-0501-09
Expiration Date 12/04/12
By Shay I. Chaudhry
~~Product Control~~

Engr: JAVAD AHMAD
CIVIL
FLA. PE # 70592
C.A.N. 3538

APR 26 2012



af c
AL-FAROOQ CORPORATION
ENGINEERS & PRODUCT DEVELOPMENT
1235 S.W. 87 AVE
MIAMI, FLORIDA 33174
TEL. (305) 264-8100 FAX. (305) 262-6978
COMP-ANL\W03-62SM

SMK-2/K-2 BREEZE ALUM ENTRANCE DOOR (L.M.I.)
SMI Aluminum Systems, LLC.
11500 MIRAMAR PARKWAY SUITE 300
MIRAMAR, FL. 33025
TEL. (305) 888-6288 FAX. (305) 888-6289

no.	date	description	by
A	03.05.08	UPDATED FOR 2004 FBC	
B	06.10.08	REV. PER BCCO COMMENTS	
C	02.10.09	DETAIL ADDED	
D	10.21.11	MANUF. NAME REV.	

date: 08-07-03
scale: 3/8" = 1"
dr. by: HAMID
chk. by:

drawing no.
W03-62
sheet 3 of 7

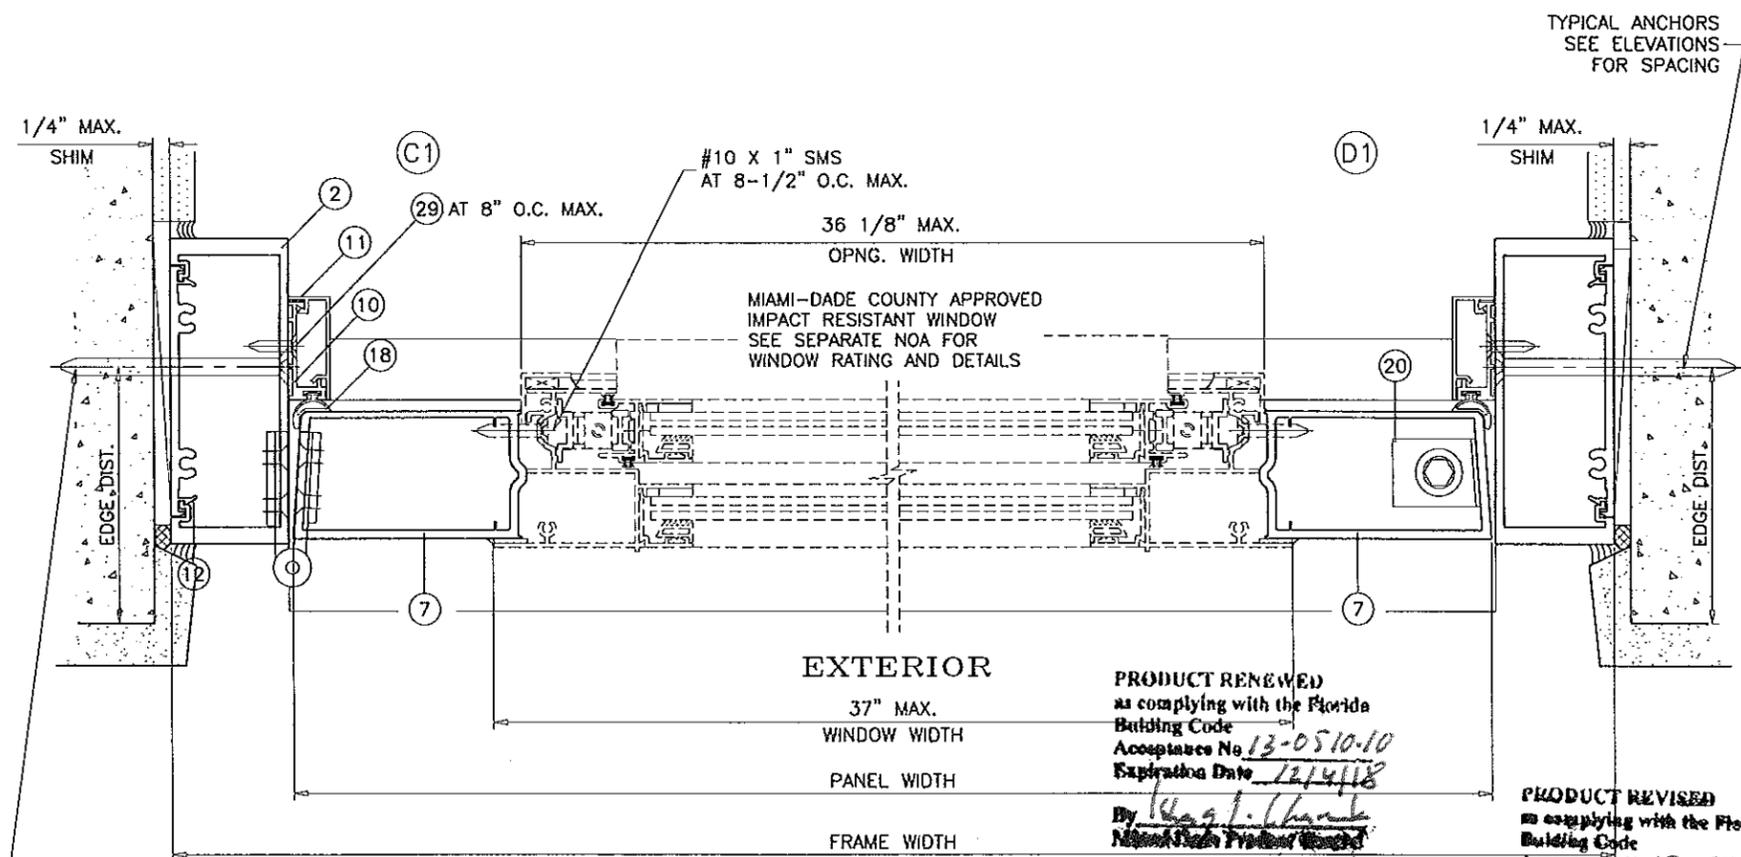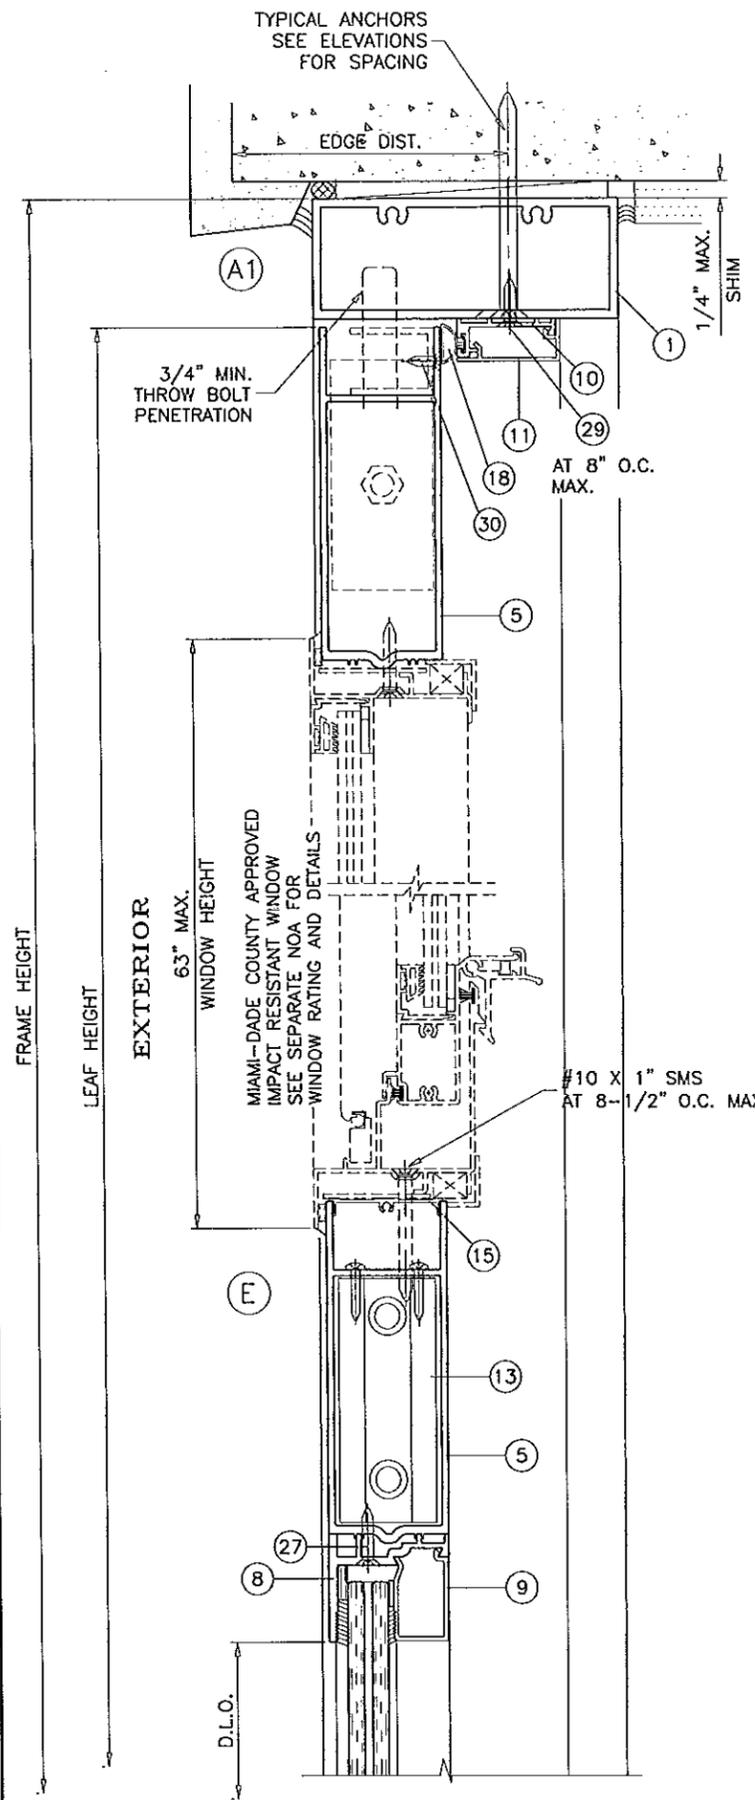

PRODUCT RENEWED
 as complying with the Florida
 Building Code
 Acceptance No. 13-0510-10
 Expiration Date 12/14/18
 By *[Signature]*
 Miami-Dade Product Council

PRODUCT REVISED
 as complying with the Florida
 Building Code
 Acceptance No. 12-0501-09
 Expiration Date 12/14/18
 By *[Signature]*
 Miami-Dade Product Council

Engr: JAVAD AHMAD
 CIVIL
 FLA. PE # 70592
 C.A.N. 3538

[Signature]
 APR 26 2012

afC
AL-FAROOQ CORPORATION
 ENGINEERS & PRODUCT DEVELOPMENT
 1235 S.W. 87 AVE
 MIAMI, FLORIDA 33174
 TEL (305) 264-8100 FAX (305) 262-6978
 COMP-ANL\W03-62SM

SMK-2/K-2 BREEZE ALUM ENTRANCE DOOR (L.M.I.)
SMI Aluminum Systems, LLC.
 11500 MIRAMAR PARKWAY SUITE 300
 MIRAMAR, FL. 33025
 TEL. (305) 888-6288 FAX. (305) 888-6289

no	date	description
A	03.05.08	UPDATED FOR 2004 FBC
B	06.10.08	REV. PER BCCO COMMENTS
C	02.10.09	NO CHANGE THIS SHEET
D	10.21.11	MANUF. NAME REV.

date: 08-07-03
 scale: 3/8" = 1"
 dr. by: HAMID
 chk. by:

drawing no.
W03-62
 sheet 4 of 7


SEALANTS:

ALL FRAME AND LEAF CORNERS AND INSTALLATION SCREWS SEALED WITH SILICONE. PERIMETER OF WINDOW FRAME TO DOOR LEAF AT EXTERIOR AND INTERIOR SEALED WITH SILICONE.

LOCKS:


OPTION 1:

THREE POINT LOCK SYSTEM WITH 5 PLY HOOK LOCK BOLT REGENT 2222, KEY OPERATED ON EXTERIOR AND THUMB-TURN ON INTERIOR, LOCATED AT 34" FROM BOTTOM OF PANEL

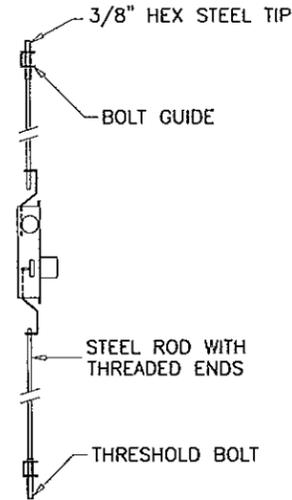


OPTION 2:

THREE POINT LOCK SYSTEM WITH 4 PLY HOOK LOCK REGENT NO. 206-3P, KEY OPERATED ON EXTERIOR AND THUMB-TURN ON INTERIOR, LOCATED AT 36" FROM BOTTOM OF PANEL

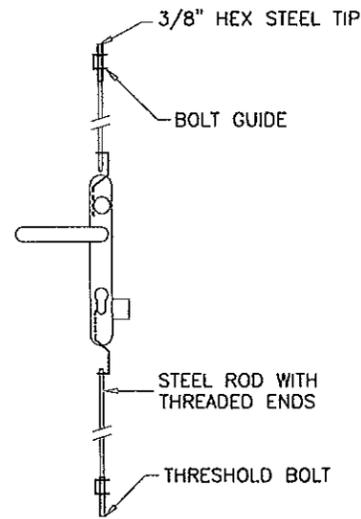

ITEM #	PART #	REQD.	DESCRIPTION	MATERIAL	MANF./SUPPLIER/REMARKS
1	SMI-006	1	FRAME HEAD	6063-T6	-
2	SMI-005	2	FRAME JAMB	6063-T6	-
3	SMI-023	1	BUMPER THRESHOLD	6063-T6	-
3A	SMI-036	1	ALT. BUMPER THRESHOLD	6063-T6	-
4	SMI-024	1	ADA THRESHOLD COVER	6063-T6	-
4A	SMI-038	1	ALT. ADA THRESHOLD COVER	6063-T6	-
4B	SMI-037	1	ALT. ADA THRESHOLD COVER	6063-T6	-
5	SMI-012	1/ LEAF	TOP RAIL/MID RAIL	6063-T6	-
6	SMI-013	1/ LEAF	BOTTOM RAIL	6063-T6	-
7	SMI-011	1/ LEAF	DOOR STILE	6063-T6	-
8	SMI-008	4/ LEAF	EXTERIOR GLASS STOP (DOOR)	6063-T6	-
9	SMI-007	4/ LEAF	INTERIOR GLASS STOP (DOOR)	6063-T6	-
10	SMI-014	3/ DOOR	DOOR STOP BASE	6063-T6	-
11	SMI-015	3/ DOOR	DOOR STOP COVER	6063-T6	-
12	SMI-004	1/ ANCHOR	FLAT FILLER, 3" LONG	6063-T6	-
13	SMI-105	2	SHEAR BLOCK	6063-T6	-
14	SMI-G04	AS REQD.	GLAZING TAPE	FOAM	FRANK LOWE
14A	SMI-G05	AS REQD.	GLAZING TAPE	FOAM	FRANK LOWE
14B	SMI-G11	AS REQD.	ALT. GLAZING TAPE (3/16" X 5/16")	FOAM	FRANK LOWE
14C	SMI-G12	AS REQD.	ALT. GLAZING TAPE (1/8" X 5/16")	FOAM	FRANK LOWE
15	SMI-033	3	FALSE MUNTIN BASE	6063-T6	-
16	SMI-G03	AS REQD.	SETTING BLOCK (3/8" X 1/4" X 1/2" LONG)	EPDM	FRANK LOWE, (DUROMETER 85±5)
17	E20510K	AS REQD.	BULB W'STRIPPING	VINYL	ULTRAFAB, (DUROMETER 65±5)
18	E23610K	AS REQD.	BULB W'STRIPPING WITH FLAP	VINYL	ULTRAFAB, (DUROMETER 65±5)
19	-	2/ LEAF	3/8" THREADED ROD WITH NUT	STEEL	-
20	-	2/ LEAF	FLUSH BOLT GUIDE	ST. STEEL	-
21	-	AS REQD.	PUSH BAR	-	-
22	-	AS REQD.	PULL HANDLE	-	-
23	-	2	THRESHOLD CLIP	ALUMINUM	2" X 2" X 1/8" X 1" LONG
24	-	4/ LEAF	SUPPORT PLATE (1-1/4" X 2" X 1/8")	ALUMINUM	-
26	#12 X 1-1/2"	2/ CORNER	FRAME ASSEMBLY SCREWS	-	HEX H SELF DRILLING
27	#10 X 1"	AS REQD.	GLASS STOP SCREWS AT 4-1/2" O.C. MAX.	-	FH SMS
28	#10 X 1/2"	AS REQD.	THRESHOLD CLIP SCREWS	-	FH SELF DRILLING
29	#8 X 3/4"	AS REQD.	DOOR STOP SCREWS AT 8" O.C. MAX.	-	FH SMS
30	#10 X 5/16"	2/ GUIDE	GUIDE INSTALLATION SCREWS	-	FH MS
31	SMI-025	1	HI-RISE RHRESHOLD COVER	6063-T6	-
31A	SMI-039	1	ALT. HI-RISE RHRESHOLD COVER	6063-T6	-

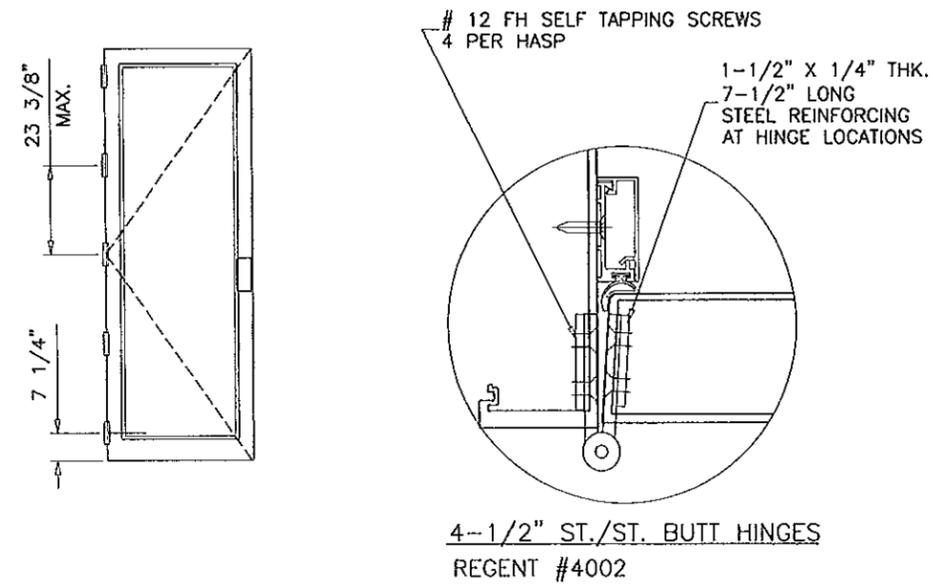

PRODUCT REVIEWED as complying with the Florida Building Code
 Acceptance No 13-0510-10
 Expiration Date 12/4/13
 By *Shrey L. Chandra*
 Project Manager

PRODUCT REVIEWED as complying with the Florida Building Code
 Acceptance No 12-0501-05
 Expiration Date 12/4/12
 By *Shrey L. Chandra*
 Project Manager

Engr: JAVAD AHMAD
 CIVIL
 FLA. PE # 70592
 C.A.N. 3538

 APR 26 2012

afC
AL-FAROOQ CORPORATION
 ENGINEERS & PRODUCT DEVELOPMENT
 1235 S.W. 87 AVE
 MIAMI, FLORIDA 33174
 TEL. (305) 264-8100 FAX. (305) 262-6975
 COMP - ANL \ W03 - 62SM

SMK-2/K-2 BREEZE ALUM ENTRANCE DOOR (L.M.I.)
SMI Aluminum Systems, LLC.
 11500 MIRAMAR PARKWAY SUITE 300
 MIRAMAR, FL. 33025
 TEL. (305) 888-6288 FAX. (305) 888-6289


no	date	description
A	03.05.08	UPDATED FOR 2004 FBC
B	06.10.08	REV. PER BCCO COMMENTS
C	02.10.09	ALT. GLAZING DETAIL ADDED
D	10.21.11	MANUF. NAME REV.

revisions:


date: 08-07-03
 scale: 3/8" = 1"
 dr. by: HAMID
 chk. by:

drawing no.
W03-62


sheet 5 of 7

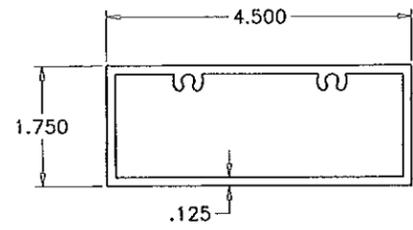


1 FRAME HEAD

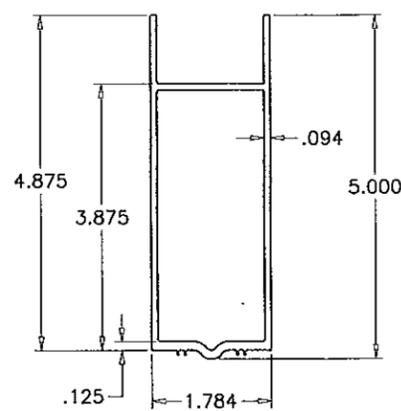


5 TOP RAIL/MID RAIL

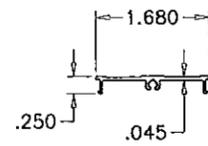


15 FALSE MUNTIN BASE

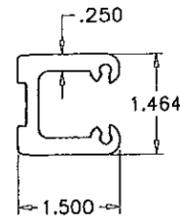


13 SHEAR BLOCK

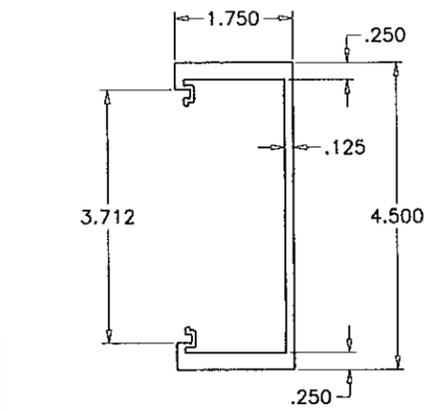


2 FRAME JAMB

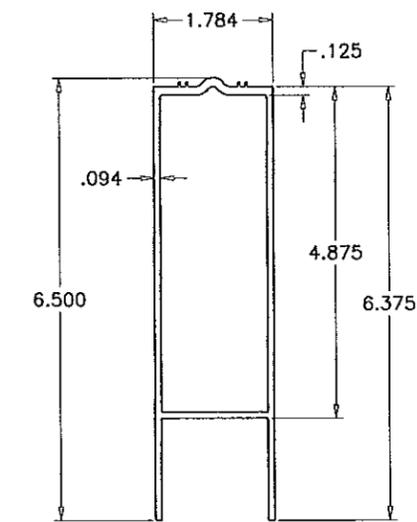


6 BOTTOM RAIL

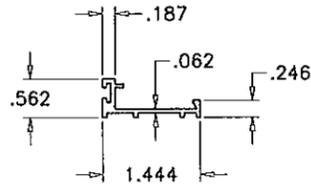


10 DOOR STOP BASE

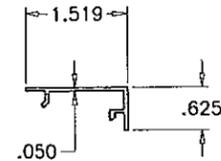


11 DOOR STOP COVER

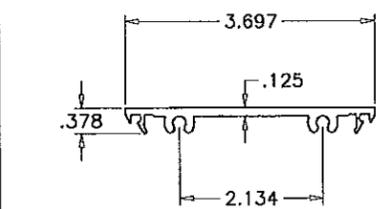


12 FLAT FILLER

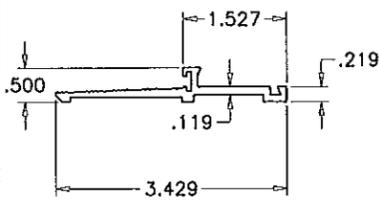


3 BUMPER THRESHOLD

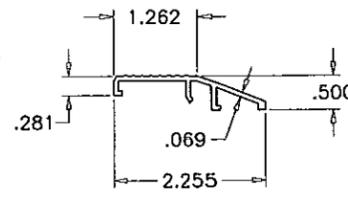


4 ADA THRESHOLD COVER

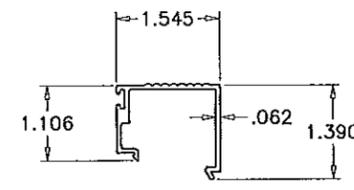


31 HI-RISE THRESHOLD COVER

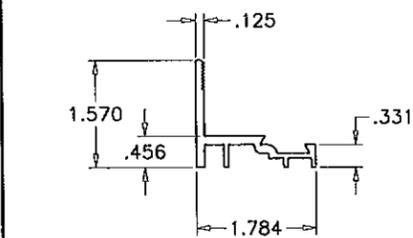


8 EXTERIOR GLASS STOP (DOOR)

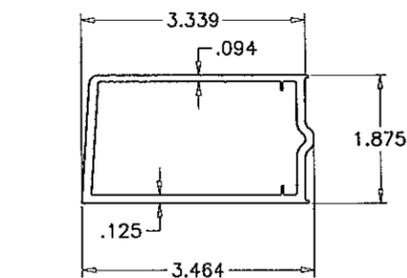


7 DOOR STILE

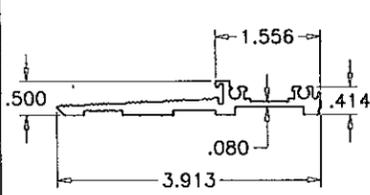


3A ALT. BUMPER THRESHOLD

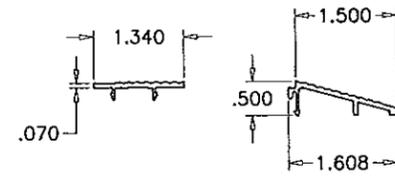

4A ALT. ADA THRESHOLD COVERS
4B ALT. ADA THRESHOLD COVERS

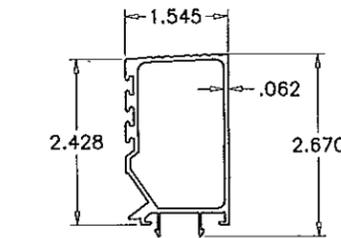

31A ALT. HI-RISE THRESHOLD COVER

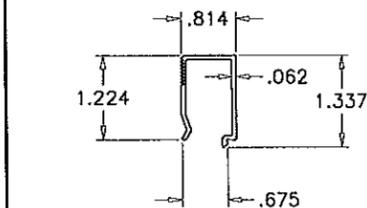

9 INTERIOR GLASS STOP (DOOR)

Engr: JAVAD AHMAD
CIVIL
FLA. PE # 70592
C.A.N. 3538

APR 26 2012

PRODUCT REVISED
as complying with the Florida
Building Code
Acceptance No 13-0510-10
Expiration Date 12/14/18
By Javad Ahmad
Manufacture Product Control

PRODUCT REVISED
as complying with the Florida
Building Code
Acceptance No 12-0501-09
Expiration Date 12/14/12
By Javad Ahmad
Manufacture Product Control


NO.	DATE	DESCRIPTION	BY
A	03.05.08	UPDATED FOR 2004 FBC	
B	06.10.08	NO CHANGE THIS SHEET	
C	02.10.09	NO CHANGE THIS SHEET	
D	10.21.11	MANUF. NAME REV.	

date: 08-07-03
scale: 3/8" = 1"
dr. by: HAMID
chk. by:


drawing no.
W03-62
sheet 6 of 7

AL-FAROQ CORPORATION
ENGINEERS & PRODUCT DEVELOPMENT
1235 S.W. 87 AVE
MIAMI, FLORIDA 33174
TEL. (305) 264-9100 FAX. (305) 262-6978
COMP-ANL\W03-62SM


SMK-2/K-2 BREEZE ALUM ENTRANCE DOOR (L.M.I.)
SMI Aluminum Systems, LLC.
11500 MIRAMAR PARKWAY SUITE 300
MIRAMAR, FL. 33025
TEL. (305) 888-6288 FAX. (305) 888-6289

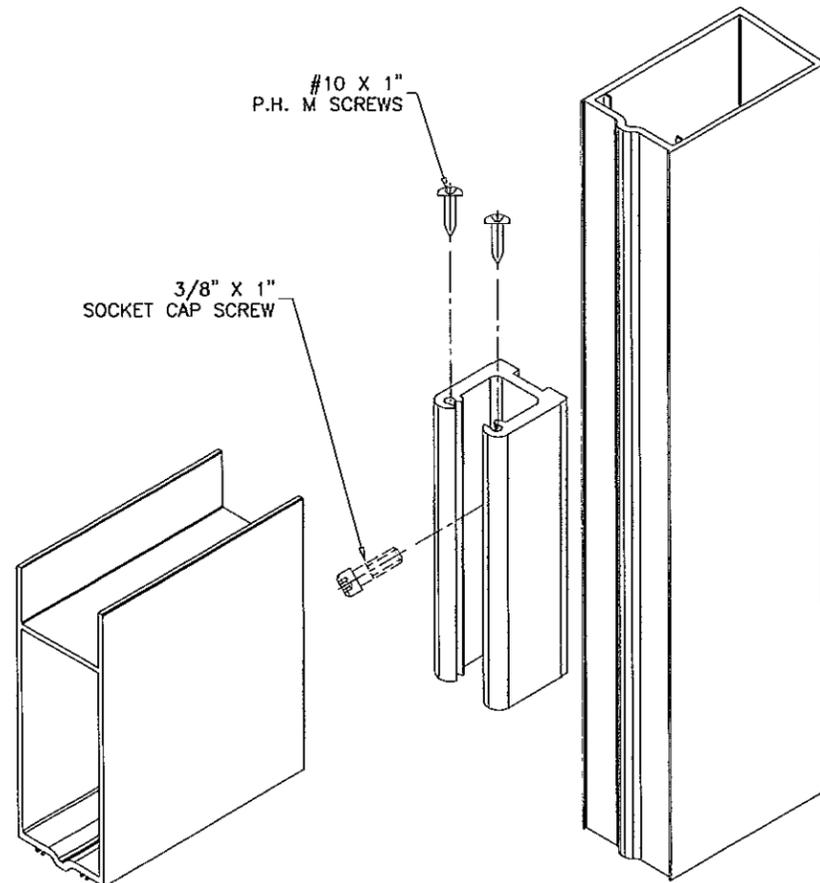


MID RAIL CORNER

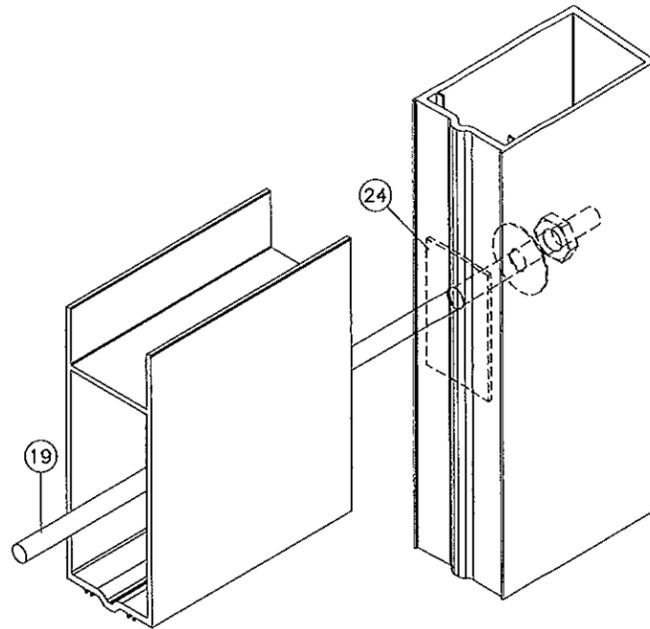


DOOR LEAF CORNER

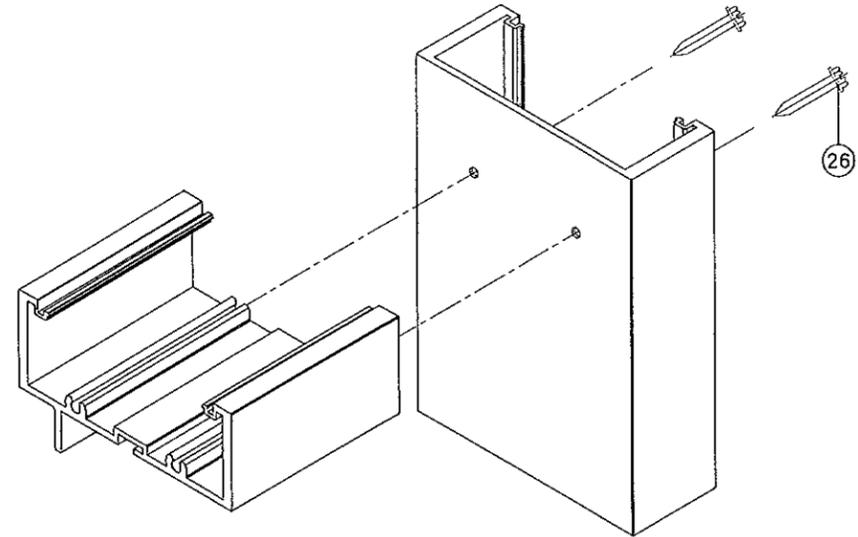

FRAME TOP CORNER

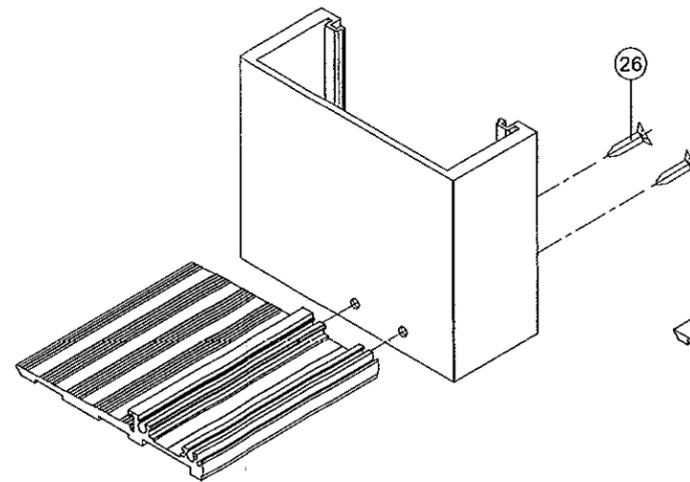

FRAME BOTTOM CORNER

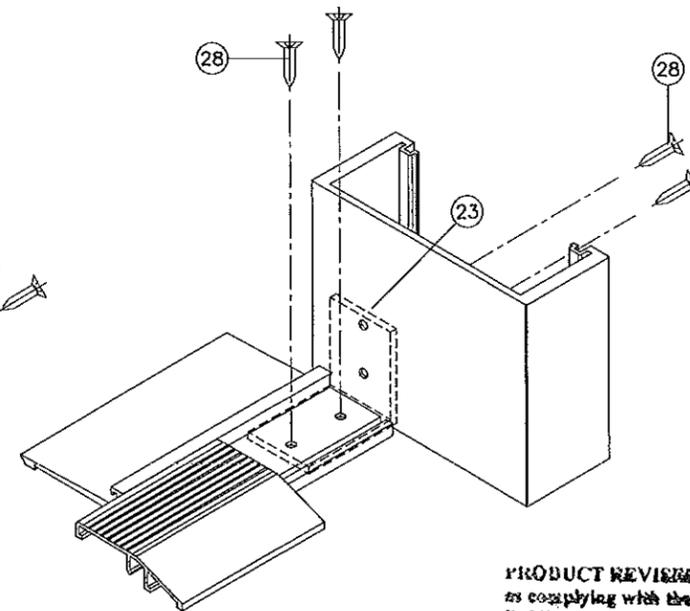

PRODUCT RENEWED
 as complying with the Florida
 Building Code
 Acceptance No. 13-0510-10
 Expiration Date: Dec 04, 2018
 By: *Khan J. Ahmad*
 Board Date: Project Control

PRODUCT REVIEWED
 as complying with the Florida
 Building Code
 Acceptance No. 12-0501-05
 Expiration Date: Dec 04, 2018
 By: *Khan J. Ahmad*
 Board Date: Project Control

Engr: JAVAD AHMAD
 CIVIL
 FLA. PE # 70592
 C.A.N. 3538

[Signature]
 APR 26 2012

afc
AL-FAROOQ CORPORATION
 ENGINEERS & PRODUCT DEVELOPMENT
 1235 S.W. 87 AVE
 MIAMI, FLORIDA 33174
 TEL. (305) 264-8100 FAX. (305) 262-6978
 COMP-ANL W03-62SM

SMK-2/K-2 BREEZE ALUM ENTRANCE DOOR (L.M.I.)
SMI Aluminum Systems, LLC.
 11500 MIRAMAR PARKWAY SUITE 300
 MIRAMAR, FL. 33025
 TEL. (305) 888-6288 FAX. (305) 888-6289

NO	DATE	BY	DESCRIPTION
A	03.05.08		UPDATED FOR 2004 FBC
B	06.10.08		REV. PER BCC COMMENTS
C	02.10.09		NO CHANGE THIS SHEET
D	10.21.11		MANUF. NAME REV.

date: 08-07-03
 scale: 3/8" = 1"
 dr. by: HAMID
 chk. by:

drawing no.
W03-62
 sheet 7 of 7