



MIAMI-DADE COUNTY
 PRODUCT CONTROL SECTION
 11805 SW 26 Street, Room 208
 Miami, Florida 33175-2474
 T (786) 315-2590 F (786) 315-2599
www.miamidade.gov/economy

DEPARTMENT OF REGULATORY AND ECONOMIC RESOURCES (RER)
 BOARD AND CODE ADMINISTRATION DIVISION
NOTICE OF ACCEPTANCE (NOA)

Nan Ya Plastics Corporation USA
 8989 North Loop East, Suite 800
 Houston, TX 77029

SCOPE:

This NOA is being issued under the applicable rules and regulations governing the use of construction materials. The documentation submitted has been reviewed and accepted by Miami-Dade County RER -Product Control Section to be used in Miami Dade County and other areas where allowed by the Authority Having Jurisdiction (AHJ).

This NOA shall not be valid after the expiration date stated below. The Miami-Dade County Product Control Section (In Miami Dade County) and/or the AHJ (in areas other than Miami Dade County) reserve the right to have this product or material tested for quality assurance purposes. If this product or material fails to perform in the accepted manner, the manufacturer will incur the expense of such testing and the AHJ may immediately revoke, modify, or suspend the use of such product or material within their jurisdiction. RER reserves the right to revoke this acceptance, if it is determined by Miami-Dade County Product Control Section that this product or material fails to meet the requirements of the applicable building code.

This product is approved as described herein, and has been designed to comply with the Florida Building Code, including the High Velocity Hurricane Zone.

DESCRIPTION: Nan Ya Series Fiberglass Outswing Opaque Doors – N.I.

APPROVAL DOCUMENT: Drawing No. NAN0012 Rev C, titled "Opaque Double Entry Non-Impact Outswing", sheets 1 through 5 of 5, dated 04/21/08 and last revised on 02-26-14, prepared by PTC, LLC, signed and sealed by Robert J. Amoruso, P.E., bearing the Miami-Dade County Product Control Revision stamp with the Notice of Acceptance number and expiration date by the Miami-Dade County Product Control Section.

MISSILE IMPACT RATING: None.

Limitations:

1. Approved Hurricane protection Devices, complying w/ FBC, as applicable are required.
2. 1x or 2x buck to be properly secured to sustain imposed load and to be reviewed by building Official.

LABELING: Each unit shall bear a permanent label with the manufacturer's name or logo, city, state and series and following statement: "Miami-Dade County Product Control Approved", unless otherwise noted herein.

RENEWAL of this NOA shall be considered after a renewal application has been filed and there has been no change in the applicable building code negatively affecting the performance of this product.

TERMINATION of this NOA will occur after the expiration date or if there has been a revision or change in the materials, use, and/or manufacture of the product or process. Misuse of this NOA as an endorsement of any product, for sales, advertising or any other purposes shall automatically terminate this NOA. Failure to comply with any section of this NOA shall be cause for termination and removal of NOA.

ADVERTISEMENT: The NOA number preceded by the words Miami-Dade County, Florida, and followed by the expiration date may be displayed in advertising literature. If any portion of the NOA is displayed, then it shall be done in its entirety.

INSPECTION: A copy of this entire NOA shall be provided to the user by the manufacturer or its distributors and shall be available for inspection at the job site at the request of the Building Official.

This NOA revises & renews NOA # 12-0612.03 consists of this page 1 and evidence page E-1 and E-2, as well as approval document mentioned above.

The submitted documentation was reviewed by Ishaq I. Chanda, P.E.



NOA No. 14-0305.05
 Expiration Date: March 04, 2019
 Approval Date: May 15, 2014
 Page 1

4.
 5/15/14

NOTICE OF ACCEPTANCE: EVIDENCE SUBMITTED

A. DRAWINGS

1. Manufacturer's die drawings and sections (submitted under file #12-0612.03/ # 08-0425.13).
2. Drawing No. **NAN0012 Rev C**, titled "Opaque Double Entry Non-Impact Outswing", sheets 1 through 5 of 5, dated 04/21/08 and last revised on 02-26-14, prepared by PTC, LLC, signed and sealed by Robert J. Amoruso, P.E.

B. TESTS (submitted under file #12-0612.03/ # 08-0425.13)

1. Test reports on 1) Air Infiltration Test, per FBC, TAS 202-94
 - 2) Uniform Static Air Pressure Test, Loading per FBC TAS 202-94
 - 3) Water Resistance Test, per FBC, TAS 202-94
 - 4) Forced Entry Test, per FBC 3603.2 (b) and TAS 202-94

along with marked-up drawings and installation diagram of Fiberglass Outswing Door w/ Sidelites, prepared by ETC Laboratories, Test Report No. **ETC-06-255-174121.3**, dated 12/18/08, signed and sealed by Joseph L. Doldan, P.E.

Note: This test report has been revised by an addendum issued by ETC Lab on 01/23/09, signed & sealed by Joseph L. Doldan, P.E.

C. CALCULATIONS


1. Statement letter compliance to FBC 2010 and "No product change", dated February 26, 2014, prepared by PTC, LLC, signed and sealed by Robert J. Amoruso, P.E.
2. Statement letter of compliance to FBC 2007 & 2010 dated April 25, 2012, prepared by PTC, LLC, signed and sealed by Robert J. Amoruso, P.E. (submitted under file #12-0612.03)
3. Statement letter, dated SEP 04, 2012 of test standard equivalency of plastic material conformance to FBC 2007 & 2010, prepared by PTC, LLC, signed and sealed by Robert J. Amoruso, P.E.
4. Anchor verification calculations and structural analysis complying per FBC 2007, prepared by PTC Engineering, Inc., dated 4/21/08, signed and sealed by Douglas J. McDougall, P.E. (submitted under file #08-0425.13)
5. Successor Engineer's letter dated 01/15/09, prepared, signed and sealed by Paul E. Winter, P.E.

D. QUALITY ASSURANCE

1. Miami Dade Department of Regulatory and Economic Resources (RER).

E. MATERIAL CERTIFICATIONS (submitted under file #12-0612.03/ # 08-0425.13)

1. Test report No.ETC-05-255-16776.1, prepared by ETC Laboratories, dated 07/06/06, issued to Nan Ya Plastics Corp., for their SMC Fiberglass material / ETC05033 per ASTM D638-03 "4500 exposed Xenon Arch" & tensile strength ASTM D638-03 "Tensile strength", Smoke density per ASTM D2843-99, Rate of burning per ASTM D635-98 and "Self ignition" per ASTM D1929-01, all signed and sealed by Joseph Labora Doldan, P.E.
2. Test report No.ETC-05-255-17144.0, prepared by ETC Laboratories, dated 07/03/08, issued to Nan Ya Plastics Corp., for their Rigid PVC plastic(part #ETC06024) per ASTM D1929-96 "Standard Test Method for Ignition Properties of Plastics", ASTM D2843-99 "Standard Test Method for Density of Smoke from the Burning or Decomposition of Plastics", ASTM D635-98 "Standard Test Method for Rate of Burning and/or Extent and Time of Burning of Self-Supporting Plastics in a Horizontal Position" and ASTM D638-03 "Standard Test Methods for Tensile Properties of Plastics" for exposed & unexposed sample per Xenon Arch after 4500 Hours, signed and sealed by Joseph Labora Doldan, P.E.

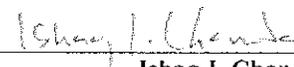

Ishaq I. Chanda, P.E.

Product Control Examiner

NOA No 14-0305.05

Expiration Date:

Approval Date: May 15, 2014

Nan Ya Plastics Corporation USA

NOTICE OF ACCEPTANCE: EVIDENCE SUBMITTED

E. MATERIAL CERTIFICATIONS (continue)


4. Test report No.ETC-06-255-17412.0, prepared by ETC Laboratories, dated 04/25/06, issued to Nan Ya Plastics Corp., for their Phenolic Foam Board / ETC06013 plastic per ASTM E84-05 "*Standard Test Method for Surface Burning Characteristics of Building Materials*", signed and sealed by Joseph Labora Doldan, P.E.
5. Test report No.ETC-05-255-17412.1, prepared by ETC Laboratories, dated 04/25/06, re-issued on 06/28/06 to Nan Ya Plastics Corp., for their Phenolic Foam Board / ETC06013 plastic per ASTM E84-05 "*Standard Test Method for Surface Burning Characteristics of Building Materials*", signed and sealed by Joseph L. Doldan, P.E.
6. Test report No.ETC-05-255-17900.0, prepared by ETC Laboratories, dated 06/28/06, issued to Nan Ya Plastics Corp., for their Phenolic Foam Board / ETC06013 plastic per ASTM D1929-96 "*Standard Test Method for Ignition Properties of Plastics*", signed and sealed by Joseph L. Doldan, P.E.
7. Test report No.ETC-05-255-16776.0, prepared by ETC Laboratories, dated 01/04/06, issued to Nan Ya Plastics Corp., for their SMC / ETC05033 plastic per ASTM D1929-96 "*Standard Test Method for Ignition Properties of Plastics*", ASTM D2843-99 "*Standard Test Method for Density of Smoke from the Burning or Decomposition of Plastics*", ASTM D635-98 "*Standard Test Method for Rate of Burning and/or Extent and Time of Burning of Self-Supporting Plastics in a Horizontal Position*" and ASTM D638-03 "*Standard Test Methods for Tensile Properties of Plastics*", signed and sealed by Joseph Labora Doldan, P.E.
8. Test report No.ETC-05-255-16777.1, prepared by ETC Laboratories, dated 07/26/06, issued to Nan Ya Plastics Corp., for their Cellular PVC / ETC05034 plastic per ASTM D1929-96 "*Standard Test Method for Ignition Properties of Plastics*", ASTM D2843-99 "*Standard Test Method for Density of Smoke from the Burning or Decomposition of Plastics*", ASTM D635-98 "*Standard Test Method for Rate of Burning and/or Extent and Time of Burning of Self-Supporting Plastics in a Horizontal Position*" and ASTM D638-03 "*Standard Test Methods for Tensile Properties of Plastics*", signed and sealed by Joseph Labora Doldan, P.E.

F. STATEMENTS

1. Statement letter of compliance to FBC 2010 dated 02/26/2014, prepared by PTC, LLC, signed and sealed by Robert J. Amoruso, P.E.
2. Statement letter of compliance to FBC 2007 & 2010 dated April 25, 2012, prepared by PTC, LLC, signed and sealed by Robert J. Amoruso, P.E. (submitted under file #12-0612.03)
3. Statement letter of conformance to FBC 2007 and no financial interest, issued by PTC, dated April 21, 2008, signed and sealed by Douglas J. McDougall, P.E.(submitted under file #08-0425.13).
4. Certificate of Authority dated May 23, 1983, to transact business, issued to Nan Ya Plastic Corporation, USA issued by the State of Texas, signed by Secretary of State.
5. Lab compliance letter as part of above test reports.

G. OTHER

1. This NOA revises & renews NOA # 12-0612.03, expired on March 04, 2014.
2. Test proposal # 06-1291 dated 11/06/2006 approved by BCCO.

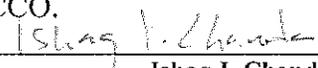
Ishaq I. Chanda, P.E.
Product Control Examiner
NOA No. 14-0305.05
Expiration Date: March 04, 2019
Approval Date: May 15, 2014

NAN YA PLASTICS CORP.

OPAQUE DOUBLE ENTRY NON-IMPACT OUTSWING DOOR

GENERAL NOTES:

1. THE PRODUCT ANCHORAGE SHOWN HEREIN IS DESIGNED TO COMPLY WITH THE 2010 FLORIDA BUILDING CODE (FBC), AT THE DESIGN PRESSURES STATED HEREIN.
2. THE PRODUCT DETAILS CONTAINED HEREIN ARE BASED UPON SIGNED AND SEALED TEST REPORT #ETC-07-255-18448.3 REISSUE DATED 10/01/07, AND ASSOCIATED LABORATORY STAMPED DRAWINGS.
3. THE PRODUCT HAS BEEN EVALUATED FOR CONFORMANCE TO THE STANDARDS LISTED IN THE 2010 FLORIDA BUILDING CODE (FBC) AND IS IN COMPLIANCE WITH SAID STANDARDS, INCLUDING HIGH VELOCITY HURRICANE ZONE (HVHZ) REQUIREMENTS.
4. ADEQUACY OF THE EXISTING STRUCTURAL CONCRETE / MASONRY AND WOOD FRAMING AS A MAIN WIND FORCE RESISTING SYSTEM CAPABLE OF WITHSTANDING AND TRANSFERRING APPLIED PRODUCT LOADS TO THE FOUNDATION IS THE RESPONSIBILITY OF THE PROJECT ENGINEER OR ARCHITECT OF RECORD.
5. 1X AND 2X BUCKS (WHEN USED) SHALL BE DESIGNED AND ANCHORED TO PROPERLY TRANSFER ALL LOADS TO THE STRUCTURE. BUCK DESIGN AND INSTALLATION IS THE RESPONSIBILITY OF THE PROJECT ENGINEER OR ARCHITECT OF RECORD.
6. THE INSTALLATION DETAILS DESCRIBED HEREIN ARE GENERIC AND MAY NOT REFLECT ACTUAL CONDITIONS FOR A SPECIFIC SITE. IF SITE CONDITIONS CAUSE INSTALLATION TO DEVIATE FROM THE REQUIREMENTS DETAILED HEREIN, THEN THE BUILDING OFFICIAL MAY ELECT ONE OF THE FOLLOWING OPTIONS:
 - A. OUTSIDE HVHZ: REQUIRE THAT A LICENSED ENGINEER OR ARCHITECT PREPARE AND SUBMIT SITE SPECIFIC DOCUMENTS FOR USE WITH THIS DOCUMENT, TO BE REVIEWED BY AUTHORITY HAVING JURISDICTION.
 - B. INSIDE HVHZ: REQUIRE THAT A ONE-TIME SITE SPECIFIC APPROVAL BE APPLIED FOR AND OBTAINED FROM THE MIAMI-DADE COUNTY PRODUCT CONTROL SECTION.

TABLE OF CONTENTS	
SHEET	SHEET DESCRIPTION
1	GENERAL AND INSTALLATION NOTES
2	ELEVATION AND ANCHOR LAYOUT
3	VERTICAL SECTIONS AND CORNER DETAIL
4	HORIZONTAL SECTIONS
5	BILL OF MATERIALS AND COMPONENTS

7. IN HVHZ AREAS, USE OF AN APPROVED IMPACT PROTECTIVE SYSTEM COMPLYING WITH THE HVHZ REQUIREMENTS OF THE FBC IS MANDATORY FOR THE PRODUCT HEREIN. OUTSIDE HVHZ AREAS, USE OF AN APPROVED IMPACT PROTECTIVE SYSTEM COMPLYING WITH THE 2010 FBC IS MANDATORY.
8. DOOR FRAME AND PANEL FRAME MATERIAL: FOAM PVC DOOR PANEL SKIN IS MOULDED FIBERGLASS SKIN
9. A 1/3 INCREASE IN ALLOWABLE STRESS FOR WIND LOADS WAS NOT USED IN THE DESIGN OF THE PRODUCT(S) SHOWN HEREIN.

INSTALLATION NOTES:

1. ONE (1) INSTALLATION ANCHOR IS REQUIRED AT EACH ANCHOR LOCATION SHOWN.
2. THE NUMBER OF INSTALLATION ANCHORS DEPICTED IS THE MINIMUM NUMBER OF ANCHORS TO BE USED FOR PRODUCT INSTALLATION.
3. SHIM AS REQUIRED AT EACH INSTALLATION ANCHOR WITH LOAD BEARING SHIM. MAXIMUM ALLOWABLE SHIM SIZE OF 1/4 INCH. SHIM WHERE SPACE OF 1/16 INCH OR GREATER OCCURS. SHIM SHALL BE CONSTRUCTED OF HIGH DENSITY PLASTIC OR BETTER (LOAD BEARING).
4. FOR INSTALLATION INTO WOOD FRAMING, USE #12 WOOD SCREWS OF SUFFICIENT LENGTH TO ACHIEVE 1 1/2 INCH MINIMUM EMBEDMENT.
5. FOR INSTALLATION THROUGH 1X BUCK TO CONCRETE / MASONRY, OR DIRECTLY INTO CONCRETE / MASONRY, USE 1/4 INCH ITW TAPCONS OF SUFFICIENT LENGTH TO ACHIEVE 1 1/4 INCH MINIMUM EMBEDMENT.
6. MINIMUM EMBEDMENT AND EDGE DISTANCE EXCLUDE WALL FINISHES (INCLUDING BUT NOT LIMITED TO STUCCO, FOAM, BRICK VENEER, AND SIDING).

7. INSTALLATION ANCHORS AND ASSOCIATED HARDWARE MUST BE MADE OF CORROSION RESISTANT MATERIAL OR HAVE A CORROSION RESISTANT COATING.
8. FOR CONCRETE BLOCK, DO NOT INSTALL INSTALLATION ANCHORS INTO MORTAR JOINTS. EDGE DISTANCE IS MEASURED FROM FREE EDGE OF BLOCK OR EDGE OF MORTAR JOINT INTO FACE SHELL OF BLOCK.
9. INSTALLATION ANCHORS SHALL BE INSTALLED IN ACCORDANCE WITH ANCHOR MANUFACTURER'S INSTALLATION INSTRUCTIONS, AND ANCHORS SHALL NOT BE USED IN SUBSTRATES WITH STRENGTHS LESS THAN THE MINIMUM STRENGTH SPECIFIED BY THE ANCHOR MANUFACTURER BELOW.
 - A. WOOD - PT SOUTHERN YELLOW PINE, MINIMUM SPECIFIC GRAVITY OF 0.55.
 - B. CONCRETE - MINIMUM COMPRESSIVE STRENGTH OF 3192 PSI AND COMPLIES WITH ACI 301.
 - C. MASONRY - STRENGTH CONFORMANCE TO ASTM C-90.
10. INSTALLATION ANCHOR CAPACITIES FOR PRODUCTS HEREIN ARE BASED ON SUBSTRATE MATERIALS WITH THE FOLLOWING PROPERTIES:
 - A. WOOD - PT SOUTHERN YELLOW PINE, MINIMUM SPECIFIC GRAVITY OF 0.55.
 - B. CONCRETE - MINIMUM COMPRESSIVE STRENGTH OF 3192 PSI AND COMPLIES WITH ACI 301.
 - C. MASONRY - STRENGTH CONFORMANCE TO ASTM C-90.

DESIGN PRESSURE RATING (PSF)
WHERE WATER INFILTRATION IS NOT REQUIRED
±55.0

PRODUCT REVISED
 to comply with the Florida
 Building Code
 Acceptance No. 14-0305-05
 Expiration Date 12/24/2017
 By Shawn J. Chen
 Miami Dade Product Control

PROJECT NO. 414-0109			
C	NOA RENEWAL	02/26/14	RJA
B	UPDATE TO 2010 FBC	04/25/12	TJH
A	PER MIAMI DADE COMMENTS DATED 1-5-09	01/08/09	SMC
REV	DESCRIPTION	DATE	BY

NANYA PLASTICS
 8989 NORTH LOOP EAST
 HOUSTON, TX 77029


TITLE: OPAQUE DOUBLE ENTRY NON-IMPACT OUTSWING DOOR
 GENERAL INSTALLATION NOTES AND ELEVATION

DRAWN BY: CB	DATE: 04/21/08
SCALE: N.T.S.	DRAWING NO: NAN0012
REV: C	SHEET: 1 OF 5


PFC PRODUCT DESIGN GROUP, LLC
 PO BOX 320775
 LONGWOOD, FLORIDA 32752
 PHONE: 321.600.1788
 FAX: 321.600.1786
 EMAIL: info@pfc-corp.com
 PFC, C.A. NO. 24515

Robert J. Amoroso, P.E.
 FL P.E. No. 49752

WJL
 1/19/14

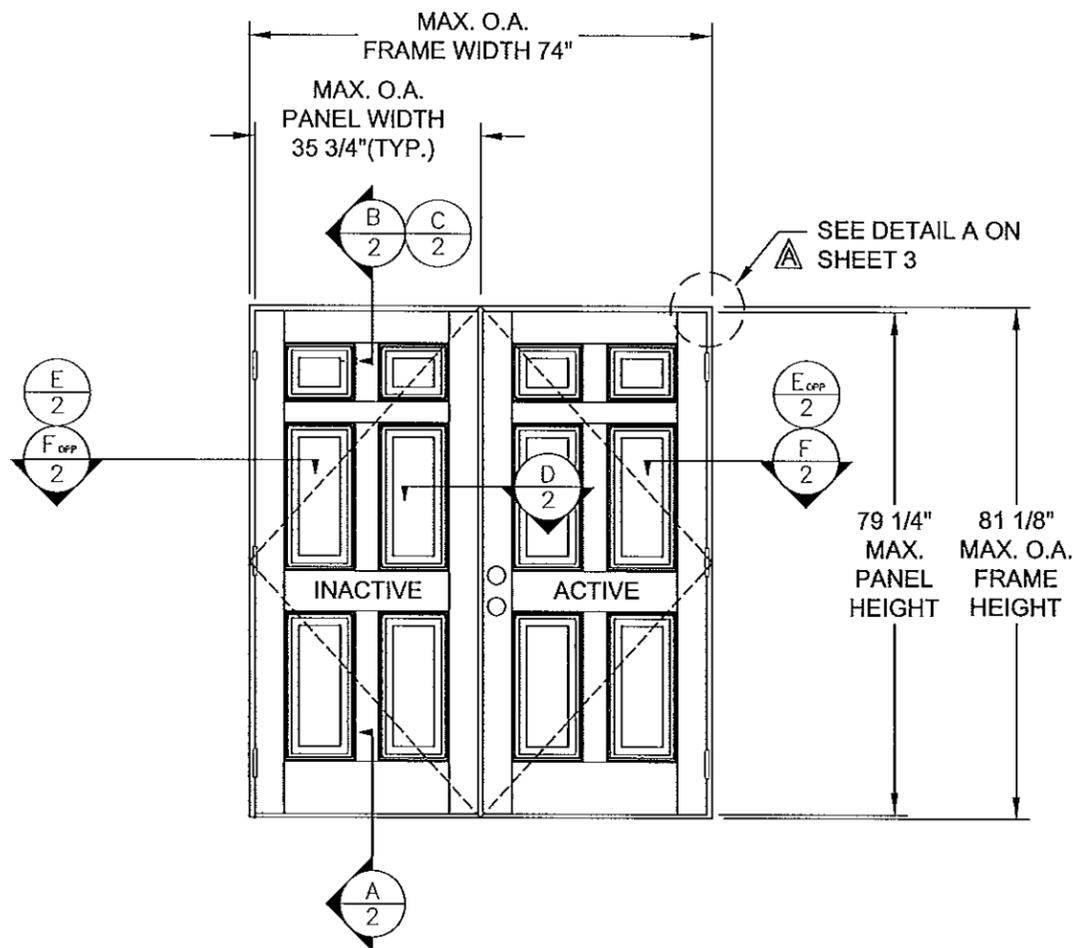

ELEVATION
EXTERIOR VIEW

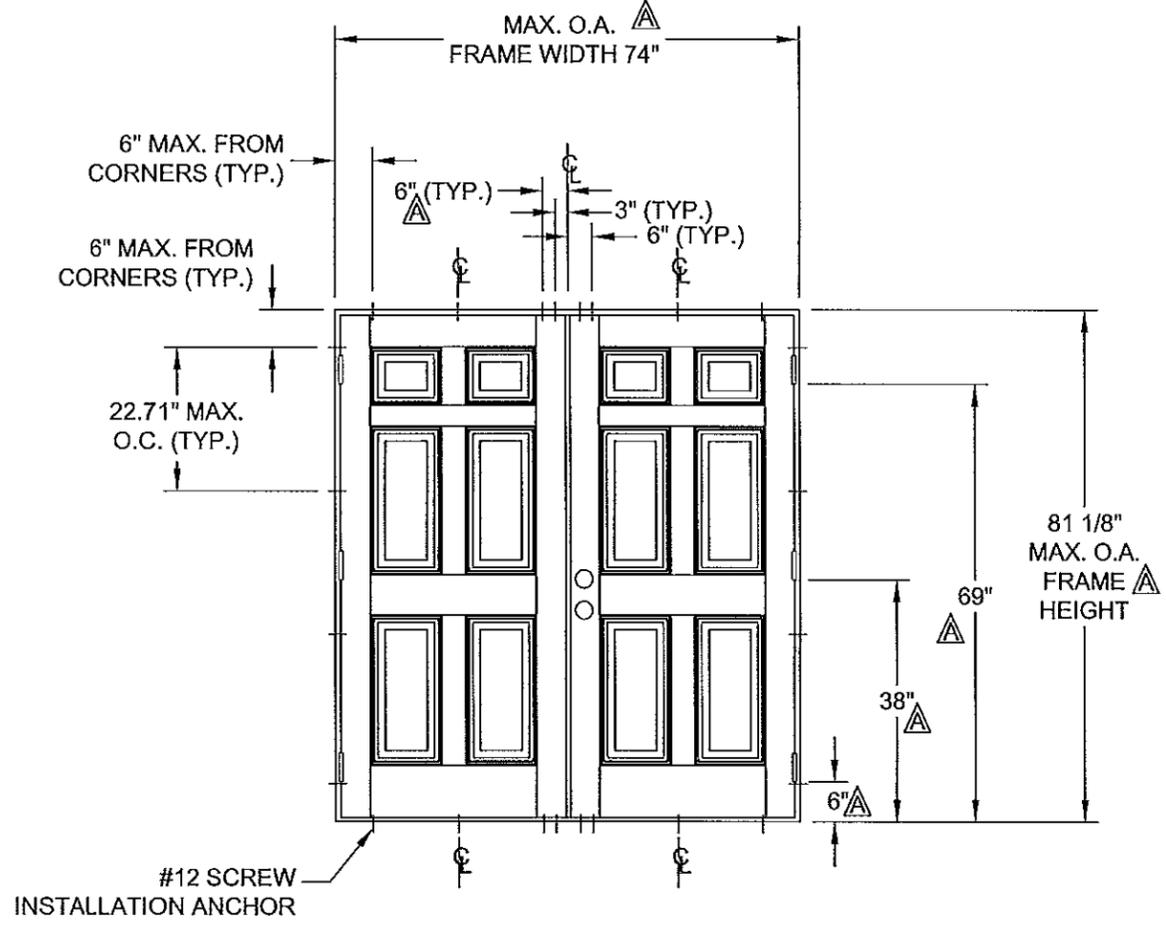

ANCHOR LAYOUT
EXTERIOR VIEW

PRODUCT REVISED
to comply with the Florida
Building Code
Acceptance No. 14-0305-01
Expiration Date 2/14/19
By *[Signature]*
Miami Dade Product Control

PROJECT NO. 414-0109	
C	NOA RENEWAL
B	UPDATE TO 2010 FBC
A	PER MIAMI DADE COMMENTS DATED 1-5-09
REV	DESCRIPTION
DATE	BY
02/26/14	RJA
04/25/12	TJH
01/08/09	SMC

NANYA PLASTICS
8989 NORTH LOOP EAST
HOUSTON, TX 77029

TITLE: OPAQUE DOUBLE ENTRY NON-IMPACT OUTSWING DOOR
ELEVATION AND ANCHOR LAYOUT


DATE: 04/21/08
DRAWING NO.: NAN0012
SCALE: N.T.S.
SHEET: 2 OF 5

PREPARED BY: CB
DRAWN BY: N.T.S.
REV: C


PFC
PFC PRODUCT DESIGN GROUP, LLC
70 BOX 520775
LONGWOOD, FLORIDA 32752
Phone: 321.680.1788
Fax: 321.680.1789
Email: info@pfc-usa.com
PFC C.A. NO. 25915

Robert J. Amoroso, P.E.
FL P.E. No. 49752


[Handwritten Signature]
2/26/14

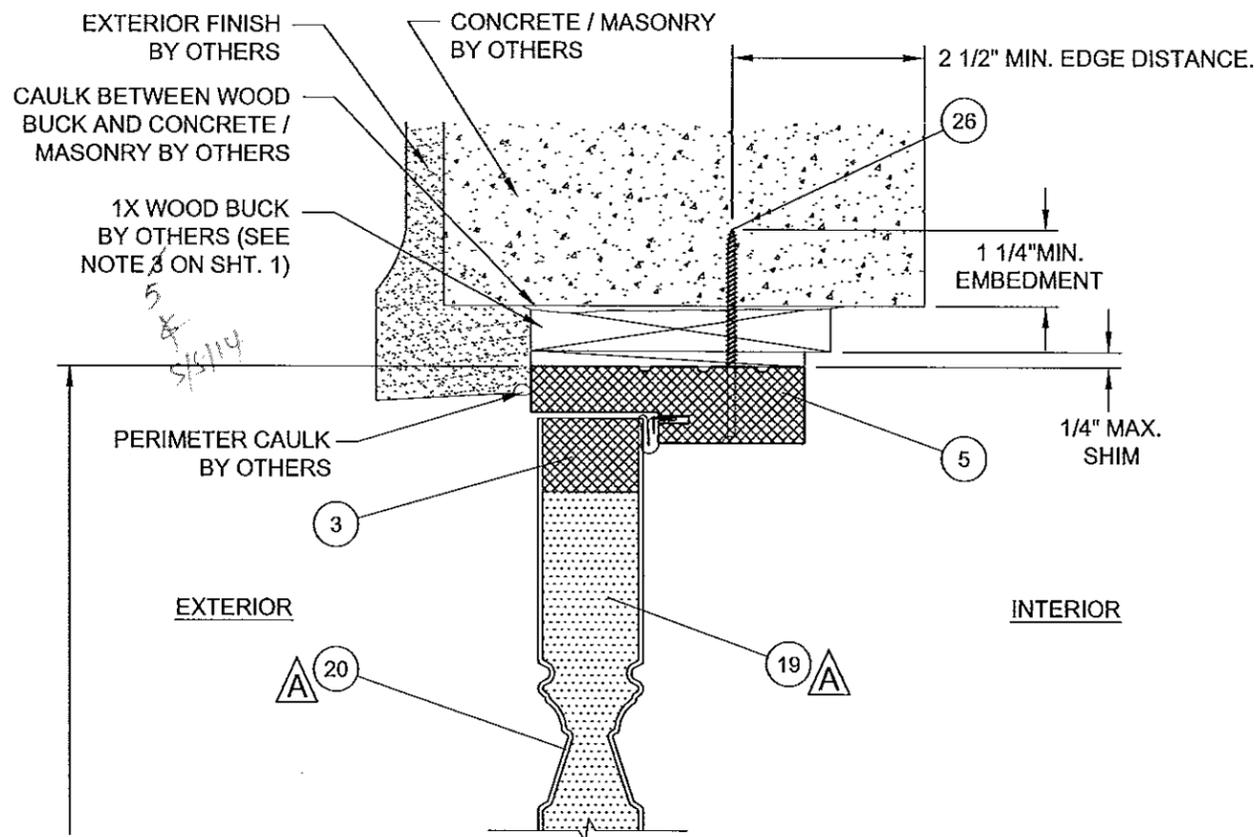


B VERTICAL SECTION
CONCRETE / MASONRY SUBSTRATE

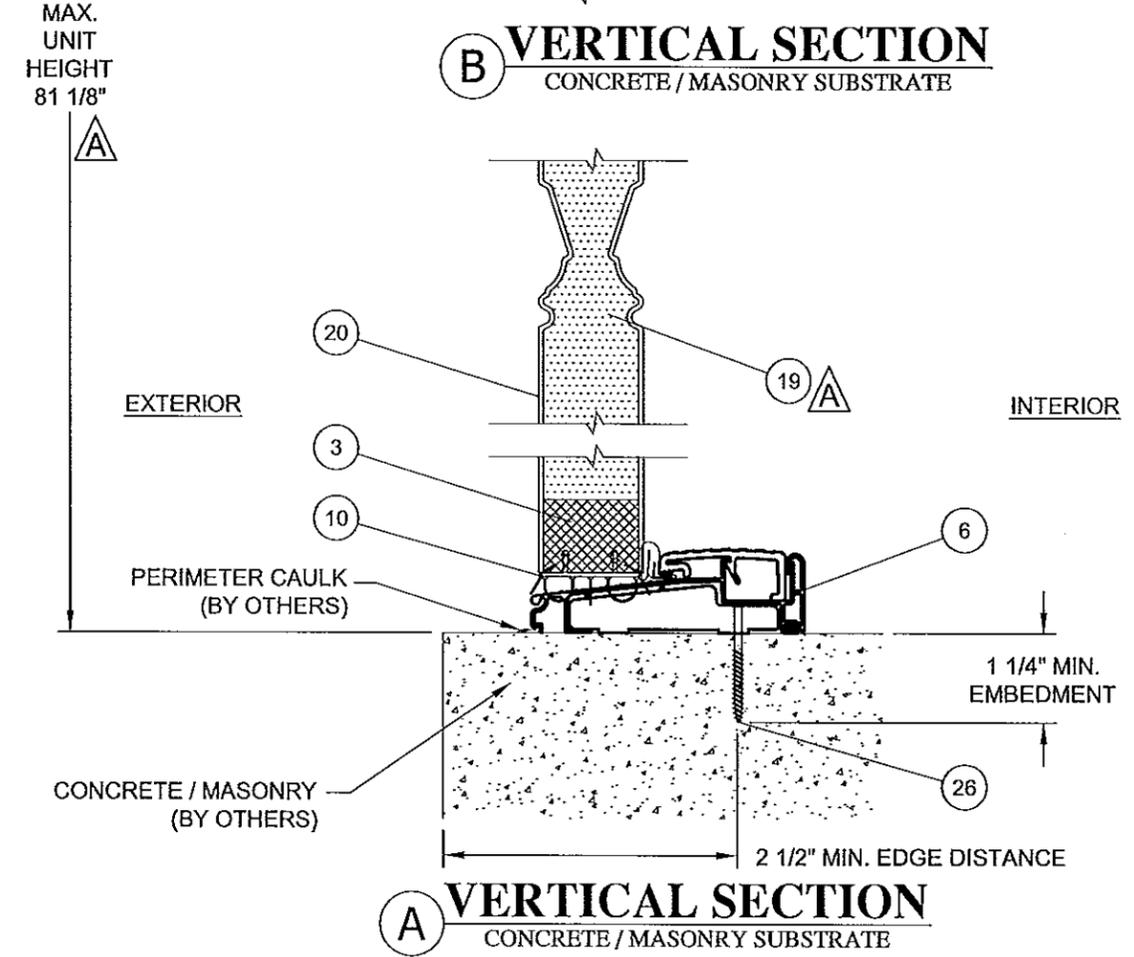


A VERTICAL SECTION
CONCRETE / MASONRY SUBSTRATE

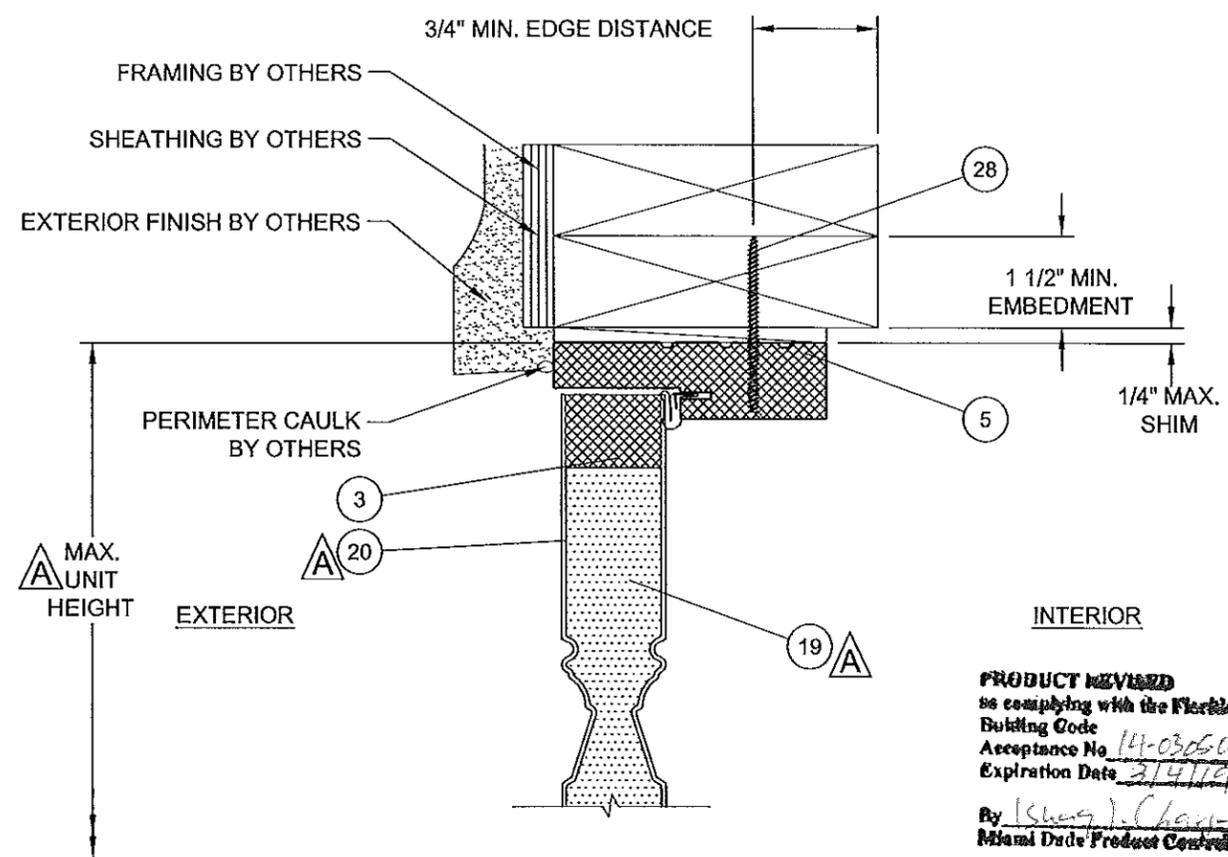


C VERTICAL SECTION
WOOD FRAME SUBSTRATE

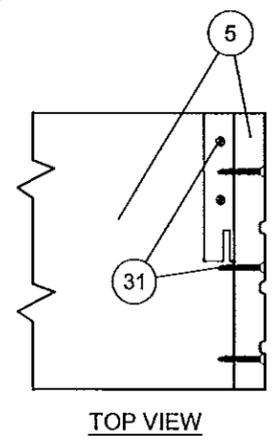

TOP VIEW

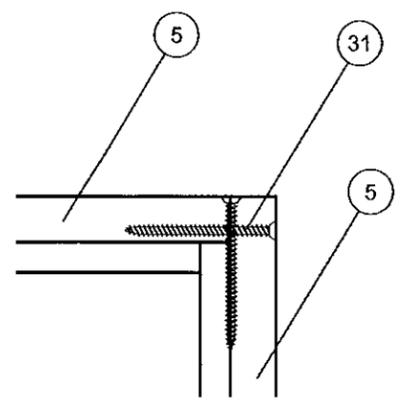

FRONT VIEW

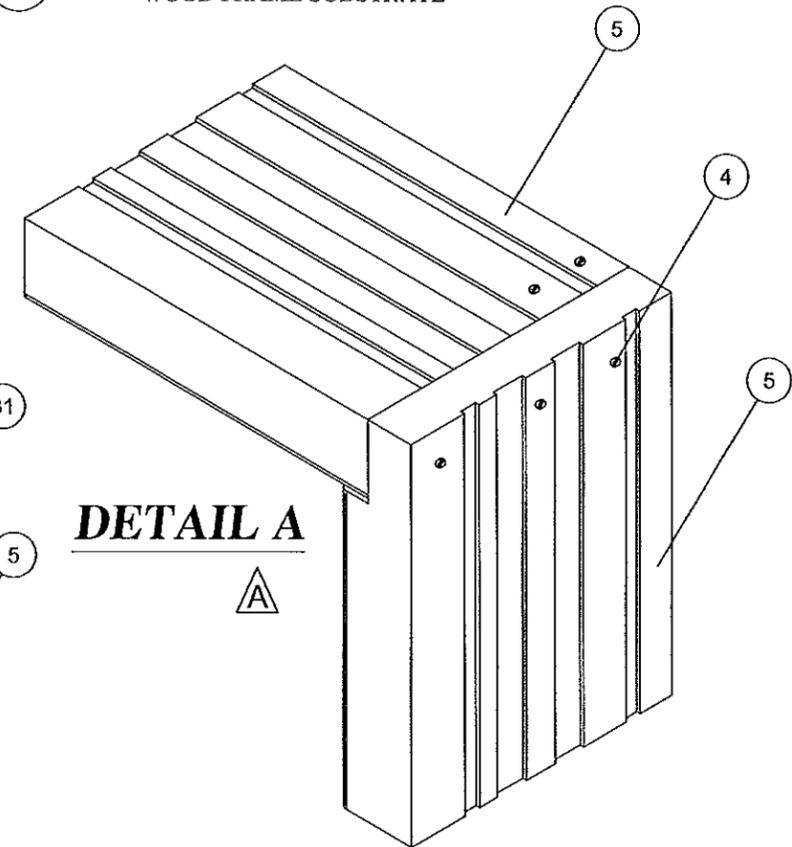

DETAIL A

PRODUCT REVIEWED
as complying with the Florida
Building Code
Acceptance No. 14-030505
Expiration Date 3/14/12
By *[Signature]*
Miami Dade Product Control


PROJECT NO. 414-0109	RJA	TJH	BY
NOA RENEWAL	02/26/14	04/25/12	DATE
UPDATE TO 2010 FBC			REV
PER MIAMI DADE COMMENTS DATED 1-5-09			DESCRIPTION

NANYA PLASTICS 8989 NORTH LOOP EAST HOUSTON, TX 77029	DATE:	04/21/08	DRAWING NO: NANC0012	SHEET: 3 OF 5
	DRAWN BY:	CB		
TITLE: OPAQUE DOUBLE ENTRY NON-IMPACT OUTSWING DOOR VERTICAL SECTIONS & CORNER DETAIL	REV:	C		

Robert J. Amoroso, P.E.
FL P.E. No. 49752

[Signature]
2/26/14



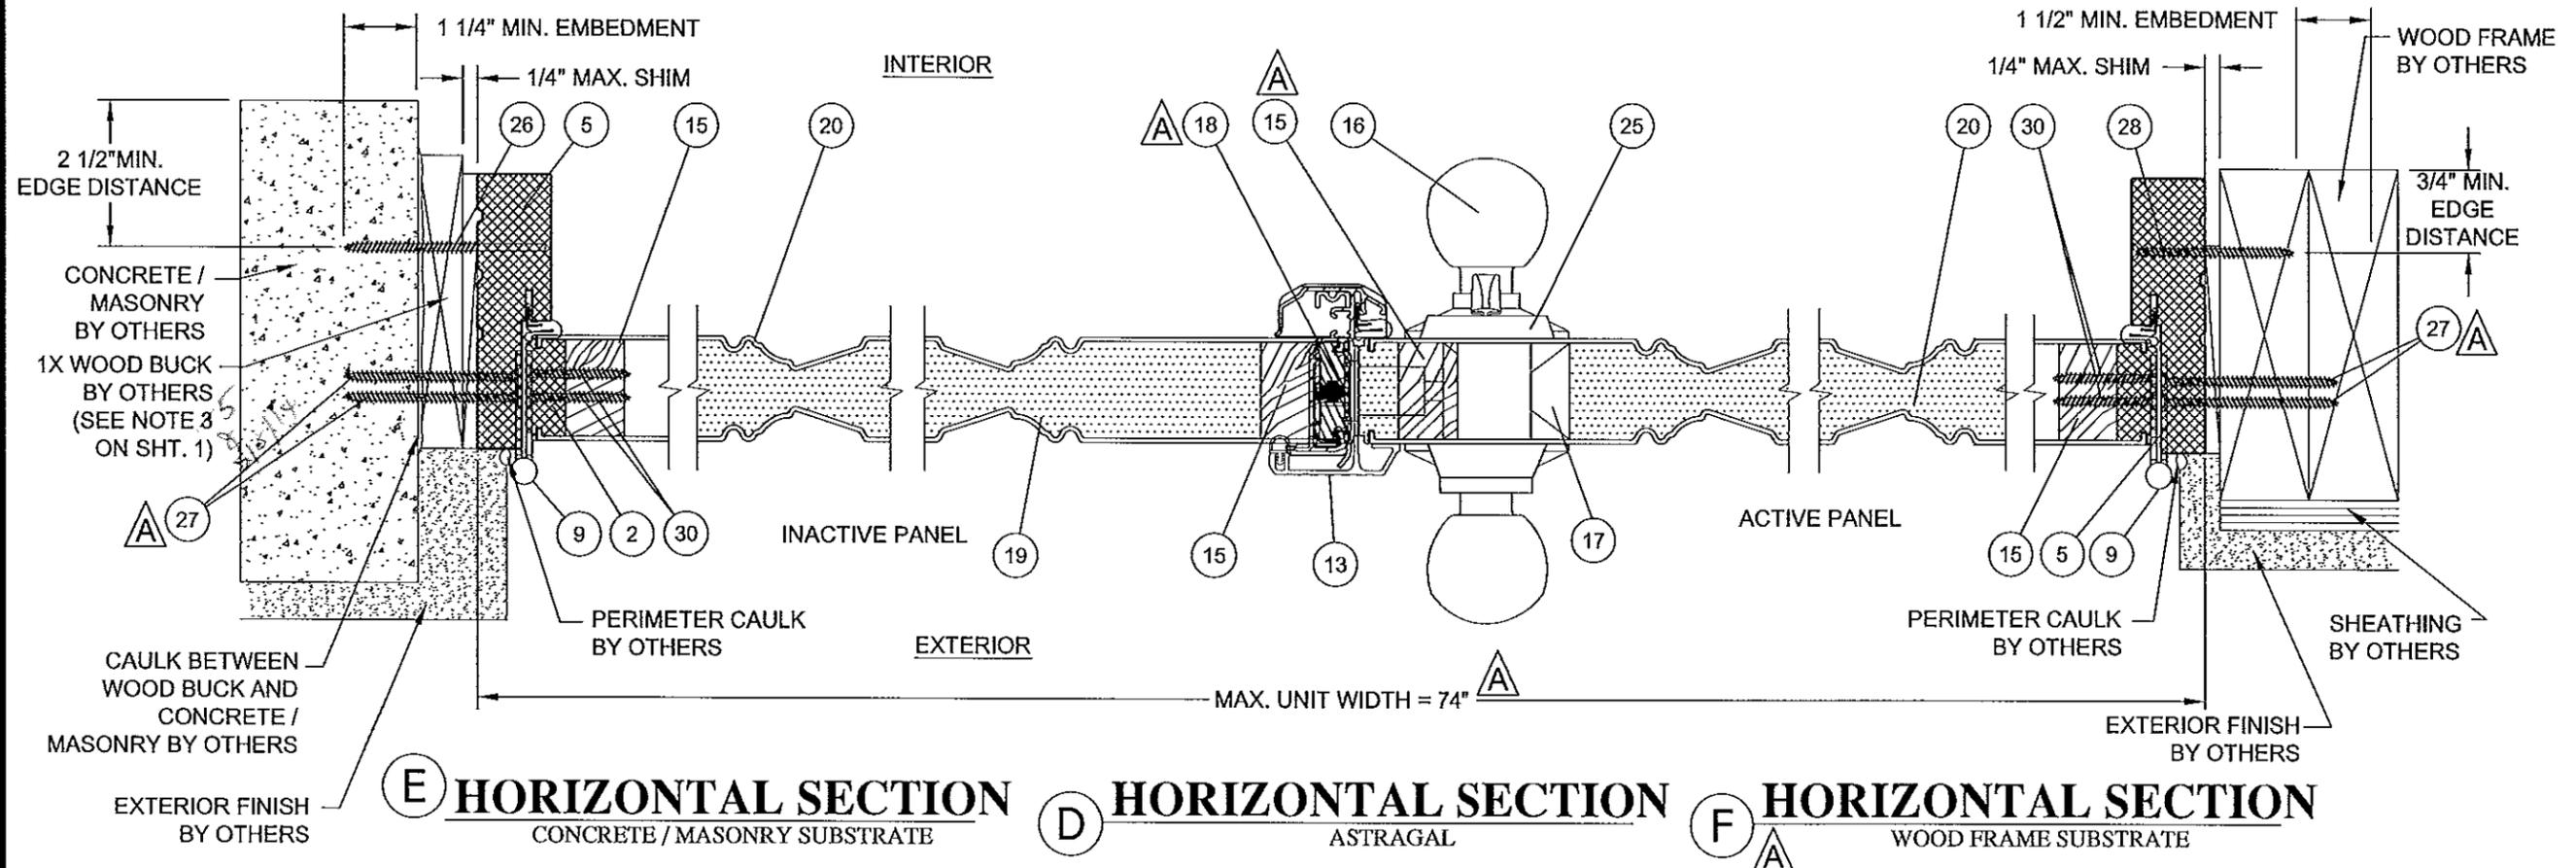

E HORIZONTAL SECTION CONCRETE / MASONRY SUBSTRATE
D HORIZONTAL SECTION ASTRAGAL
F HORIZONTAL SECTION WOOD FRAME SUBSTRATE

PRODUCT REVISED
 to comply with the Florida
 Building Code
 Acceptance No. 11-0305-05
 Expiration Date 3/1/12
 By Sheng T. Chang
 Initial Date Product Council

PROJECT NO. 414-0109			
C	NOA RENEWAL	02/26/14	RJA
B	UPDATE TO 2010 FBC	04/25/12	TJH
A	PER MIAMI DADE COMMENTS DATED 1-5-08	01/08/09	SMC
REV	DESCRIPTION	DATE	BY

NANYA PLASTICS
 8989 NORTH LOOP EAST
 HOUSTON, TX 77029

TITLE: OPAQUE DOUBLE ENTRY NON-IMPACT OUTSWING DOOR
 HORIZONTAL SECTIONS

DATE: 04/21/08
 DRAWING NO: NAN0012
 SCALE: N.T.S.
 SHEET: 4 OF 5

PREPARED BY: C
 DRAWN BY: CB
 CHECKED BY: N.T.S.
 REV: 1








PTC PRODUCT DESIGN GROUP, LLC
 PO BOX 320775
 LONGWOOD, FLORIDA 32752
 Phone: 321.660.1788
 Fax: 321.660.1789
 Email: info@ptc.com

Robert J. Amoroso, P.E.
 FL P.E. No. 49752










Handwritten signature and date: 11/26/14

BILL OF MATERIALS

ITEM NO.	PART NO.	QUANTITY	DESCRIPTION	MATERIAL	VENDOR
1	XXX	3	1 5/32" STILE	FOAM PVC	NANYA PLASTICS
2	XXX	8	5/8" STILE	FOAM PVC	NANYA PLASTICS
3	XXX	1	1 3/4" TOP/BOTTOM RAIL	FOAM PVC	NANYA PLASTICS
4	----	AS REQ'D.	#10 X 2 1/2" PH FL HD SCREW	----	----
5	XXX	3	FRAME HEAD & JAMB	FOAM PVC	NANYA PLASTICS
6	XXX	1	ENDURA 4 9/16" OUTSWING SILL	ALUMINUM	ENDURA
8	XXX	AS REQ'D.	Q-LON 650 WEATHERSTRIP	FOAM SILICONE (PE FILM)	Q-LON
9	----	4	4" X 4" HINGE	STEEL	MICOTA
10	XXX	2	ENDURA DOOR BOTTOM SWEEP	RIGID PVC CO-EX	ENDURA
11	XXX	2	CORNER PAD	FOAM SILICONE (PE FILM)	DOW-TECH PLASTICS
13	XXX	2	OUTSWING PANEL TRIM	ALUMINUM, PVC	MINI DIE CASTINGS
15	XXX	2	REINFORCEMENT (FULL LENGTH) Δ	WHITE PINE	----
16	----	1	ENTRY LATCH	----	KWIKSET
17	XXX	2	REINFORCEMENT (FULL LENGTH) Δ	WHITE PINE	----
18	XXX	1	ENDURA ASTRAGAL W/ BOLTS Δ	ALUMINUM, STEEL, PVC	ENDURA
19	XXX	AS REQ'D.	POLYURETHANE	----	NANYA PLASTICS Δ
20	XXX	4	SMC 67P DOOR SKIN - Fymin = 11000 PSI Δ	FIBERGLASS SKIN	NANYA PLASTICS
23	XXX	1	SHOOT BOLT STRIKE PLATE (HEAD)	STEEL (POWDER COATED)	----
24	XXX	1	SHOOT BOLT STRIKE PLATE (SILL)	STEEL (POWDER COATED)	----
25	XXX	1	DEAD BOLT	----	KWIKSET
26	----	----	1/4" ITW TAPCON W/ 1-1/4" MIN. EMBEDMENT	STEEL	ITW
27	----	12	#10 X 3" PFH SCREW	STEEL	----
28	----	14	#12 PFH SCREW	STEEL	----
29	----	12	#10 X 1 1/2" PFH SCREW	STEEL	----
30	----	14	#10 X 2" PFH SCREW	STEEL	----

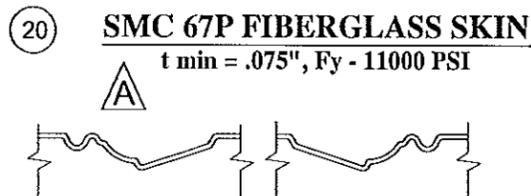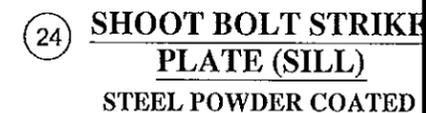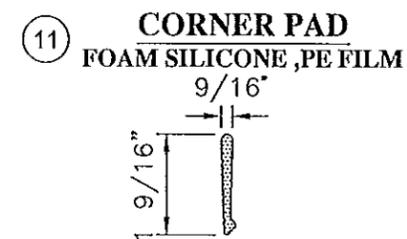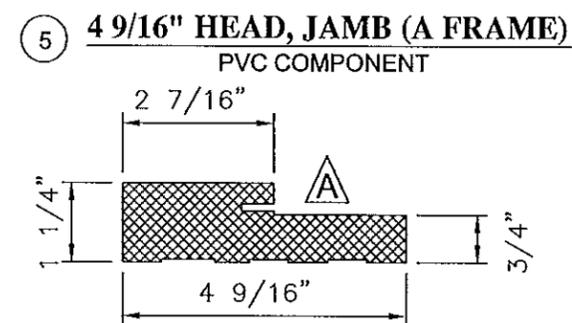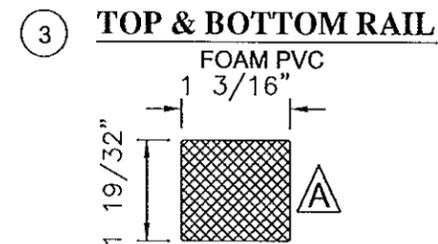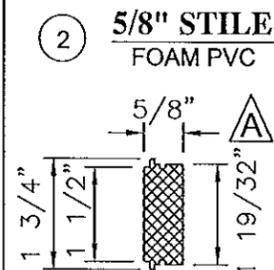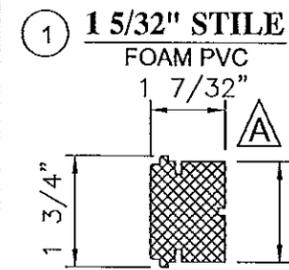

PRODUCT REVISION
to comply with the Florida
Building Code
Acceptance No. 14-0305-05
Expiration Date MAR 04 2019
By: [Signature]
[Signature]

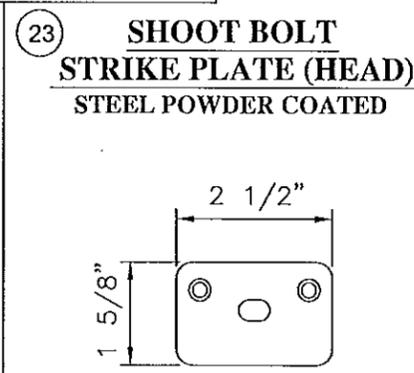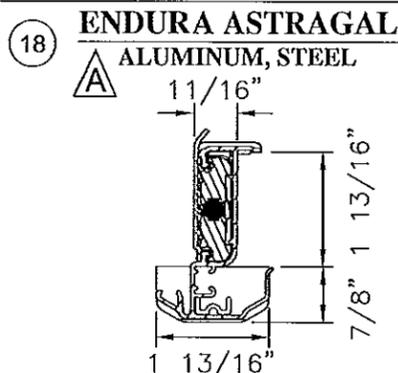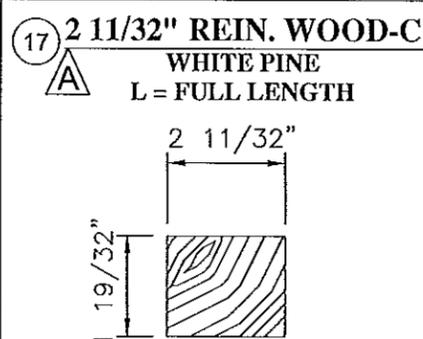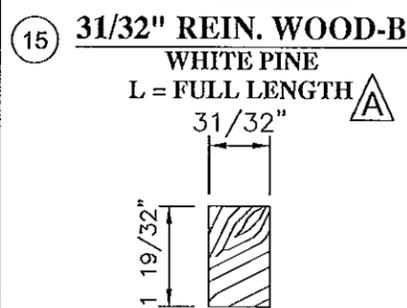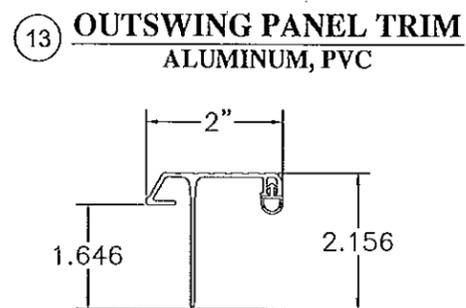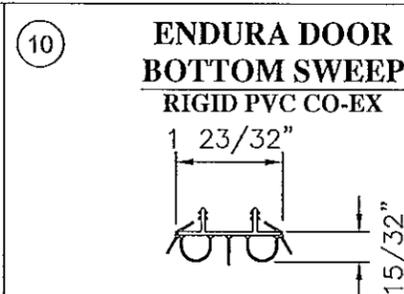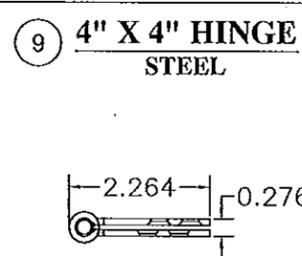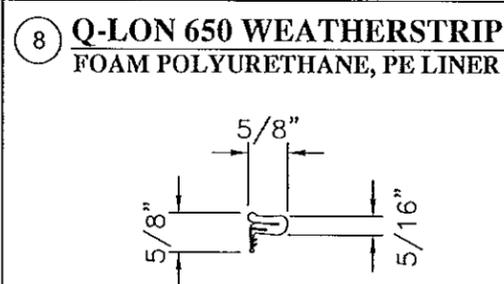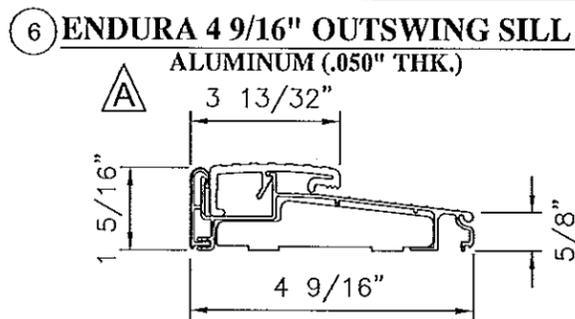

PROJECT NO. 414-0109	NOA RENEWAL	UPDATE TO 2010 FBC	PER MIAMI DADE COMMENTS DATED 1-5-09
02/26/14 RJA	04/25/12 TJH	01/08/09 SMC	
C	B	A	REV
			DATE
			BY

NANYA PLASTICS
8989 NORTH LOOP EAST
HOUSTON, TX 77029

TITLE: OPAQUE DOUBLE ENTRY NON-IMPACT OUTSWING DOOR
BILL OF MATERIALS AND COMPONENTS

DATE: 04/21/08
DRAWING NO: NAN0012
SHEET: 5 OF 5

PREPARED BY: [Signature]
SCALE: N.T.S.
REV: C

PTC PRODUCT DESIGN GROUP, LLC
PO BOX 920775
LONGWOOD, FLORIDA 32752
PHONE: 321.860.1788
FAX: 321.860.1789
EMAIL: info@nplpc.com

Robert J. Amoroso, P.E.
FL P.E. No. 49752

[Signature]