



DEPARTMENT OF REGULATORY AND ECONOMIC RESOURCES (RER)  
BOARD AND CODE ADMINISTRATION DIVISION

## NOTICE OF ACCEPTANCE (NOA)

MIAMI-DADE COUNTY  
PRODUCT CONTROL SECTION

11805 SW 26 Street, Room 208  
Miami, Florida 33175-2474  
T (786) 315-2590 F (786) 315-2599

[www.miamidade.gov/economy](http://www.miamidade.gov/economy)

**ECO Windows Systems, LLC**  
**8502 NW 80<sup>th</sup> Street,**  
**Medley, FL 33166**

### SCOPE:

This NOA is being issued under the applicable rules and regulations governing the use of construction materials. The documentation submitted has been reviewed and accepted by Miami-Dade County RER -Product Control Section to be used in Miami Dade County and other areas where allowed by the Authority Having Jurisdiction (AHJ).

This NOA shall not be valid after the expiration date stated below. The Miami-Dade County Product Control Section (In Miami Dade County) and/or the AHJ (in areas other than Miami Dade County) reserve the right to have this product or material tested for quality assurance purposes. If this product or material fails to perform in the accepted manner, the manufacturer will incur the expense of such testing and the AHJ may immediately revoke, modify, or suspend the use of such product or material within their jurisdiction. RER reserves the right to revoke this acceptance, if it is determined by Miami-Dade County Product Control Section that this product or material fails to meet the requirements of the applicable building code.

This product is approved as described herein and has been designed to comply with the Florida Building Code, including the High Velocity Hurricane Zone.

### DESCRIPTION: Series "750" Aluminum Sliding Glass Door w/ Reinforcements-S.M.I.

**APPROVAL DOCUMENT:** Drawing No. **18-21D Rev A**, titled "Series- 750 Alum Sliding. Glass Door (S.M.I.)", sheets 1 through 8 of 8, prepared by Al-Farooq Corporation, dated NOV 18, 2020, signed and sealed by Jalal Farooq, P.E., bearing the Miami-Dade County Product Control Revision stamp with the Notice of Acceptance number and expiration date by the Miami-Dade County Product Control Section.

### MISSILE IMPACT RATING: Small Missile Impact Resistant

#### Limitations:

1. See Design Pressures Vs Reinforcing, glass types and anchor capacity charts in sheet **2**. Exterior (positive) design pressures are limited to **+70 PSF w / 2-3/4"** sill riser and **+47.0 PSF w / 2"** sill riser. Lower design Pressure from charts applies to entire system.
2. See approved configurations in sheets 2.

**LABELING:** Each unit shall bear a permanent label with the manufacturer's name or logo, city, state and series and following statement: "Miami-Dade County Product Control Approved", noted herein.

**RENEWAL** of this NOA shall be considered after a renewal application has been filed and there has been no change in the applicable building code negatively affecting the performance of this product.

**TERMINATION** of this NOA will occur after the expiration date or if there has been a revision or change in the materials, use, and/or manufacture of the product or process. Misuse of this NOA as an endorsement of any product, for sales, advertising or any other purposes shall automatically terminate this NOA. Failure to comply with any section of this NOA shall be cause for termination and removal of NOA.

**ADVERTISEMENT:** The NOA number preceded by the words Miami-Dade County, Florida, and followed by the expiration date may be displayed in advertising literature. If any portion of the NOA is displayed, then it shall be done in its entirety.

**INSPECTION:** A copy of this entire NOA shall be provided to the user by the manufacturer or its distributors and shall be available for inspection at the job site at the request of the Building Official.

This NOA **revises** NOA# **19-1022.15** and consists of this page 1 and evidence page E-1 and E-2, as well as approval document mentioned above.

The submitted documentation was reviewed by **Ishaq I. Chanda, P.E.**



*Ishaq I. Chanda*

NOA No. 20-1119.19  
Expiration Date: April 04, 2024  
Approval Date: January 14, 2021  
Page 1

**NOTICE OF ACCEPTANCE: EVIDENCE SUBMITTED**

1. Evidence submitted under previous approval

**A. DRAWINGS**

1. Manufacturer's die drawings and sections.
2. Drawing No. **18-21D**, titled "Series-750 Alum Sliding Glass Door (S.M.I.)", sheets 1 through 8 of 8, prepared by Al-Farooq Corporation, dated 01/18/18, signed and sealed by Javad Ahmad, P.E.

**B. TESTS**

1. Test reports on
  - 1) Air Infiltration Test, per FBC, TAS 202-94
  - 2) Uniform Static Air Pressure Test, Loading per FBC TAS 202-94
  - 3) Water Resistance Test, per FBC, TAS 202-94
  - 4) Small Missile Impact Test per FBC, TAS 201-94
  - 5) Cyclic Wind Pressure Loading per FBC, TAS 203-94
  - 6) Forced Entry Test, per FBC 2411 3.2.1, TAS 202-94along with marked-up drawings and installation diagrams of Alum sliding Glass doors, prepared by Fenestration Testing Lab, Inc., Test Report No. **FTL-9831** dated 12/08/2017, signed and sealed by Idalmis Ortega, P. E.

**C. CALCULATIONS**

1. Anchor verification calculations and structural analysis, complying with FBC-2017 (6<sup>th</sup> Edition), prepared by Al Farooq Corporation, dated 01/09/18, signed and sealed by Javad Ahmad, P.E.
2. Glazing complies w/ ASTM E-1300.

**D. QUALITY ASSURANCE**

1. Miami Dade Department of Regulatory and Economic Resources (RER).

**E. MATERIAL CERTIFICATIONS**

1. Notice of Acceptance No. **19-0305.02** issued to Kuraray America, Inc for "**Trosifol**": Ultra clear, clear & color PVB glass interlayer, expiring on 07/08/24.

**F. STATEMENTS**

1. Statement letter of conformance to FBC 2017(6<sup>th</sup> edition) prepared by Al-Farooq Corporation, dated January 09, 2018, signed and sealed by Javad Ahmad, P.E.
2. Lab compliance as part of the above referenced test report.

**G. OTHER**

1. Test proposal #17-0580, dated 06/13/17 approved by Ishaq Chanda, P.E.
2. NOA#18-0129.10, issued to Eco Windows Systems, LLC for their Series "750" Aluminum Sliding Glass Door w/ Reinforcement – S.M.I., approved on 04/04/19 and expiring on 04/04/24.

*Ishaq I. Chanda*

---

**Ishaq I. Chanda, P.E.**  
**Product Control Unit Supervisor**  
**NOA No. 20-1119.19**  
**Expiration Date: April 04, 2024**  
**Approval Date: January 14, 2020**

**NOTICE OF ACCEPTANCE: EVIDENCE SUBMITTED**

1. New Evidence submitted

**DRAWINGS**

1. Drawing No. **18-21D Rev A**, titled “Series- 750 Alum Sliding. Glass Door (S.M.I.)”, sheets 1 through 8 of 8, prepared by Al-Farooq Corporation, dated NOV 18, 2020, signed and sealed by Jalal Farooq, P.E.

**TESTS**

1. None.

**CALCULATIONS**

1. Anchor verification calculations and structural analysis, complying with FBC-2020 (**7<sup>th</sup> Edition**), prepared by Al Farooq Corporation, dated Nov 18, 2020, signed and sealed by Jalal Farooq, P.E.
2. Glazing complies w/ ASTM E-1300-02, -04 -09 & -16.

**QUALITY ASSURANCE**

1. Miami Dade Department of Regulatory and Economic Resources (RER).

**MATERIAL CERTIFICATIONS**

1. Notice of Acceptance No. **19-0305.02** issued to **Kuraray America, Inc.** for their “**Trosifol® Ultraclear, Clear and Color PVB Glass Interlayers**”, expiring on 07/08/24.

**STATEMENTS**

1. Statement letter of conformance to FBC 2020 (**7<sup>th</sup> Edition**) and letter of no financial interest, prepared by Al Farooq Corporation, dated 11/18/20, signed and sealed by Jalal Farooq, P.E.
2. Lab compliance as part of the above referenced test report.

**OTHER**

1. This NOA revises NOA# 19-1022.15, expiring 04/04/24.

*Ishaq I. Chanda*

---

**Ishaq I. Chanda, P.E.**  
**Product Control Unit Supervisor**  
**NOA No. 20-1119.19**  
**Expiration Date: April 04, 2024**  
**Approval Date: January 14, 2020**

THESE DOORS ARE RATED FOR SMALL MISSILE IMPACT.  
F.B.C. APPROVED IMPACT RESISTANT SHUTTERS  
REQUIRED FOR INSTALLATIONS UP TO 30 FT. OF GRADE.  
SHUTTERS NOT REQD. FOR INSTALLATIONS ABOVE 30 FT. OF GRADE.

**SERIES-750**  
**ALUMINUM SLIDING GLASS DOOR**

THIS PRODUCT HAS BEEN DESIGNED AND TESTED TO COMPLY WITH THE REQUIREMENTS OF THE 2017 (6TH EDITION)/2020 (7TH EDITION) FLORIDA BUILDING CODE INCLUDING HIGH VELOCITY HURRICANE ZONE (HVHZ).

1BY OR 2BY WOOD BUCKS & BUCK FASTENERS BY OTHERS, MUST BE DESIGNED AND INSTALLED ADEQUATELY TO TRANSFER APPLIED PRODUCT LOADS TO THE BUILDING STRUCTURE.


ANCHORS SHALL BE CORROSION RESISTANT, SPACED AS SHOWN ON DETAILS AND INSTALLED PER MANUF'S INSTRUCTIONS. SPECIFIED EMBEDMENT TO BASE MATERIAL SHALL BE BEYOND WALL DRESSING OR STUCCO.

A LOAD DURATION INCREASE IS USED IN DESIGN OF ANCHORS INTO WOOD ONLY.  
ALL SHIMS TO BE HIGH IMPACT, NON-METALLIC AND NON-COMPRESSIBLE.


MATERIALS INCLUDING BUT NOT LIMITED TO STEEL/METAL SCREWS, THAT COME INTO CONTACT WITH OTHER DISSIMILAR MATERIALS SHALL MEET THE REQUIREMENTS OF THE 2017/2020 FLORIDA BLDG. CODE & ADOPTED STANDARDS.

THIS PRODUCT APPROVAL IS GENERIC AND DOES NOT PROVIDE INFORMATION FOR A SITE SPECIFIC PROJECT, i.e. LIFE SAFETY OF THIS PRODUCT, ADEQUACY OF STRUCTURE RECEIVING THIS PRODUCT AND SEALING AROUND OPENING FOR WATER INFILTRATION RESISTANCE ETC.  
CONDITIONS NOT SHOWN IN THIS DRAWING ARE TO BE ANALYZED SEPARATELY, AND TO BE REVIEWED BY BUILDING OFFICIAL.

DESIGN LOADS SHOWN ARE BASED ON 'ALLOWABLE STRESS DESIGN (ASD)'.

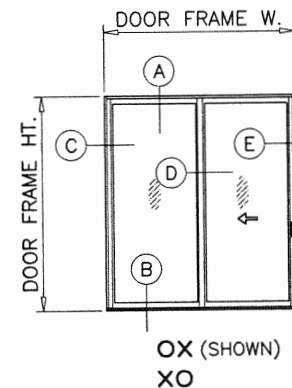

**APPROVED CONFIGURATIONS**

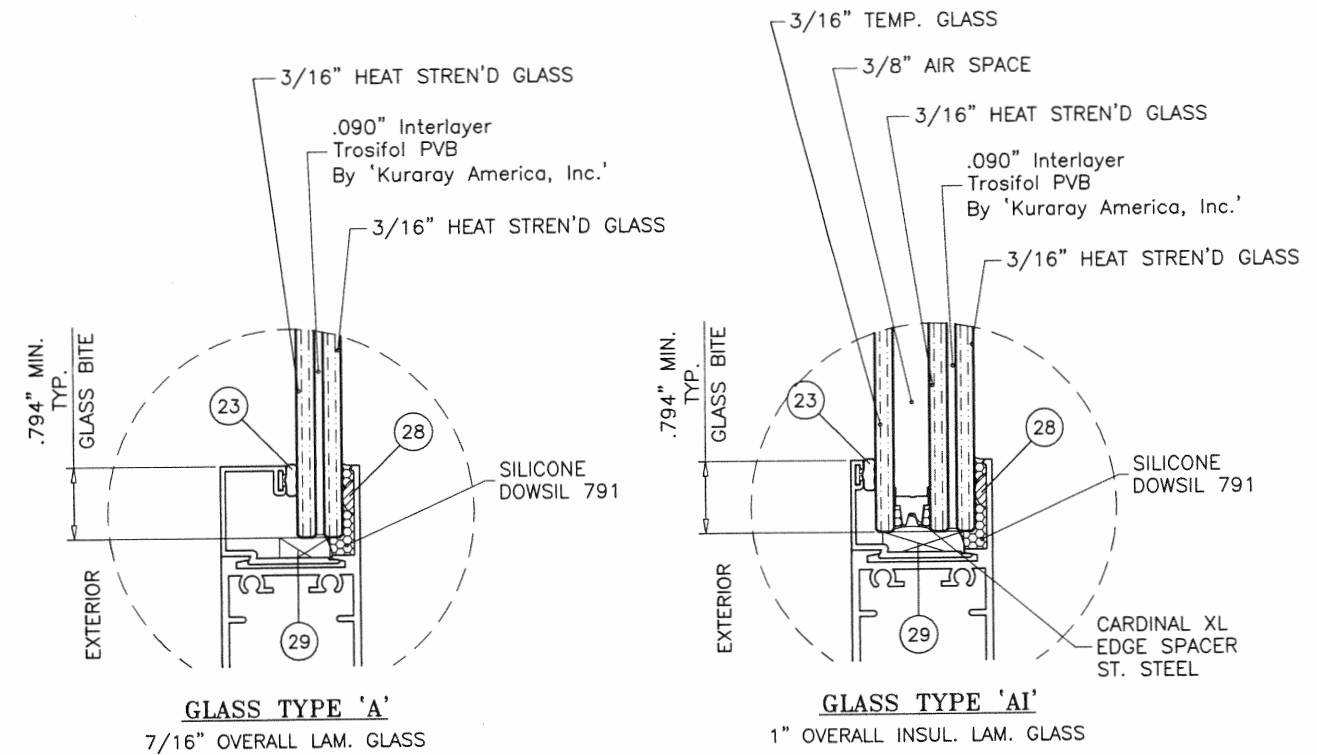

**GLAZING OPTIONS**

**PRODUCT REVISED**  
as complying with the Florida  
Building Code  
NOA-No. 20-1119.19

Expiration Date 04/04/2024

By *Ishag I. Chanda*  
Miami-Dade Product Control

**LAMINATED GLASS**  
**INSUL. LAM. GLASS**  
**SMALL MISSILE IMPACT**



NOV 18 2020

**af c**  
**AL-FAROOQ CORPORATION**  
ENGINEERS & PRODUCT DEVELOPMENT  
9360 SUNSET DRIVE, SUITE 220  
MIAMI, FLORIDA 33173  
TEL. (305) 264-8100 FAX. (305) 262-6978  
COMP-ANL\18-21D-ECO

SERIES-750 ALUM SLIDING GLASS DOOR (S.M.I.)



**ECO WINDOW SYSTEMS, LLC.**  
8502 N.W. 80th STREET  
MEDLEY, FL. 33166  
TEL. (305) 885-5299 FAX (305) 885-5902

revisions:	no	date	by	description
	A	11.05.20		UPDATED TO 2020 FBC

date:	01-18-18
scale:	1/2"=1'-0"
dr. by:	TARIQ
chk. by:	

drawing no.	18-21D
sheet	1 of 8



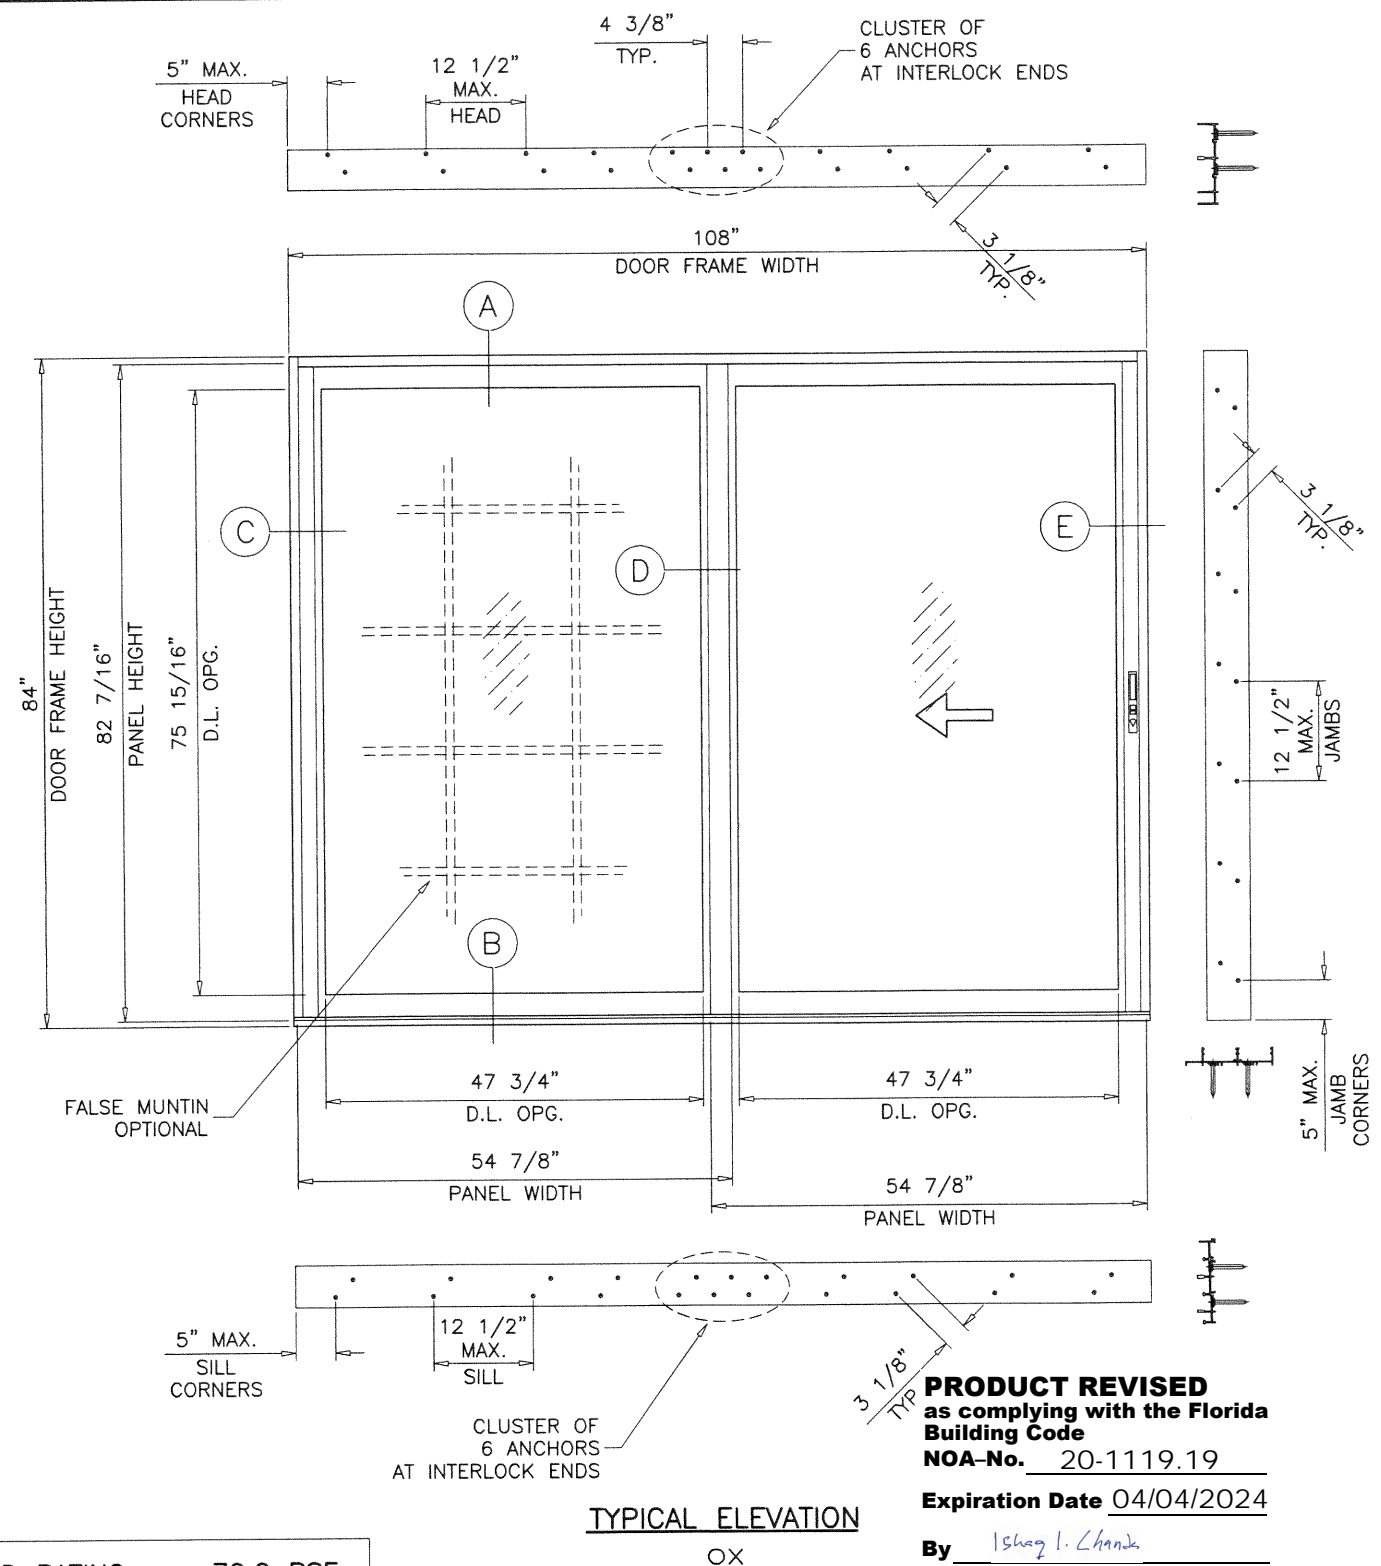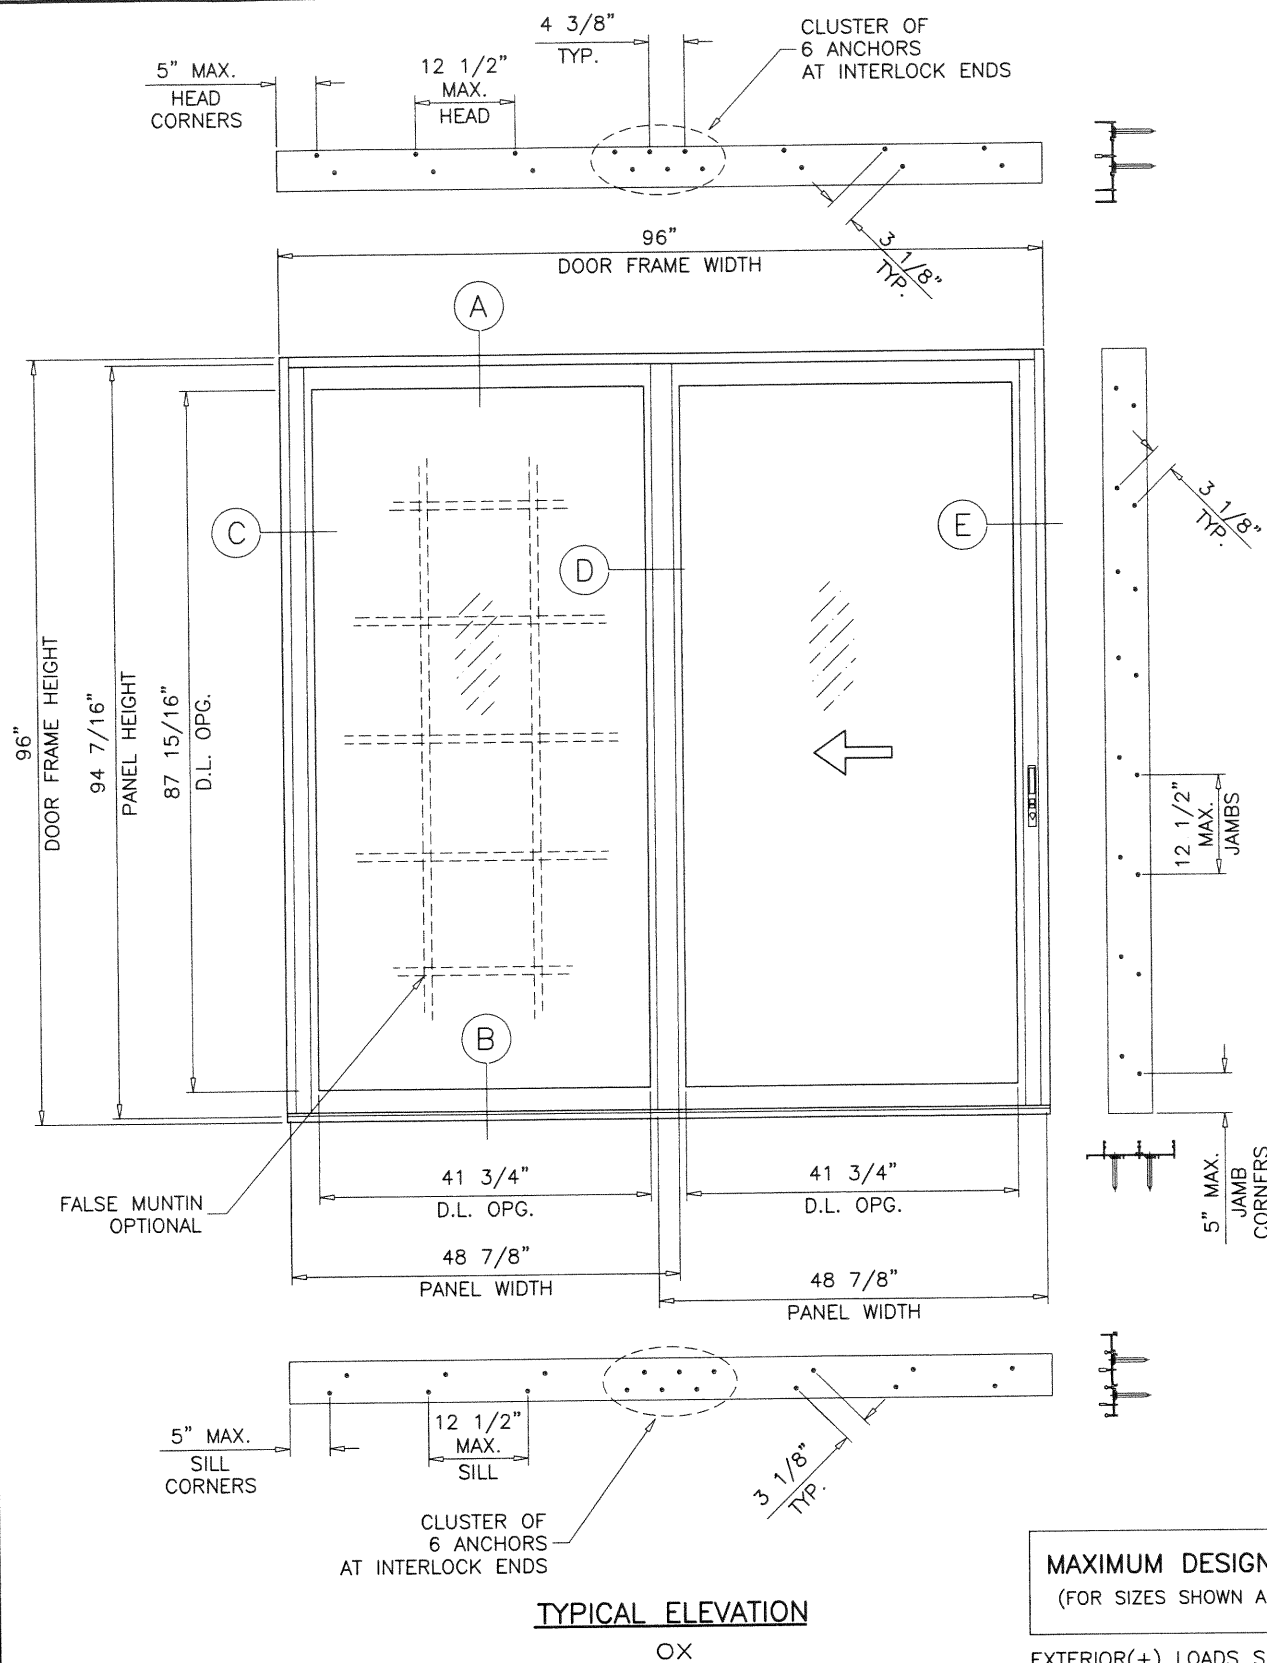


EXTERIOR(+) LOADS SHOWN ABOVE ARE FOR DOORS WITH 2-3/4" SILL HEIGHTS.  
FOR 2" SILL HEIGHT LIMIT EXT.(+) LOADS TO 47.0 PSF  
DOORS WITH 1" SILL HEIGHTS ARE NOT APPROVED FOR WATER INFILTRATION RESISTANCE  
SEE SHEET 3 FOR DETAILS

DAYLITE OPENINGS WIDTHS:  
PANEL WIDTH - 7.125"  
DAYLITE OPENING HEIGHT:  
PANEL HEIGHT - 6.50"  
PANEL HEIGHT = DOOR FRAME HEIGHT - 1.5625"

NOTE:  
GLASS CAPACITIES ON THIS SHEET ARE  
BASED ON ASTM E1300-09 (3 SEC. GUSTS)  
AND FLORIDA BUILDING COMMISSION  
DECLARATORY STATEMENT DCA05-DEC-219

ALTERNATE SIZE UNITS:  
MAX. FRAME AREA OF DOORS NOT TO EXCEED  
THE TESTED FRAME AREA OF 64 SQ. FT.

NOV 18 2020

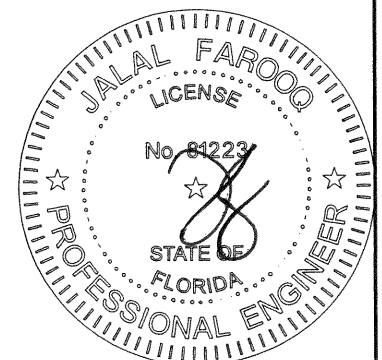

**AL-FAROOQ CORPORATION**  
ENGINEERS & PRODUCT DEVELOPMENT  
9360 SUNSET DRIVE, SUITE 220  
MIAMI, FLORIDA 33173  
TEL. (305) 264-8100 FAX. (305) 262-6978  
(C.A.N. 3538)

SERIES-750 ALUM SLIDING GLASS DOOR (S.M.I.)  
**ECO WINDOW SYSTEMS, LLC.**  
8502 N.W. 80th STREET  
MEDLEY, FL. 33166  
TEL. (305) 885-5299 FAX (305) 885-5902

revisions:	no.	date	by	description
	A	11.05.20		UPDATED TO 2020 FBC
date:	01-18-18			
scale:	1/2" = 1"			
dr. by:	TARIQ			
chk. by:				
drawing no.	18-21D			
sheet	2 of 8			

COMP-ANL\18-21D-ECO





1BY OR 2BY WOOD BUCKS AND METAL STRUCTURE NOT BY 'ECO WINDOWS'  
MUST SUSTAIN LOADS IMPOSED BY GLAZING SYSTEM  
AND TRANSFER THEM TO THE BUILDING STRUCTURE.

**TYPICAL ANCHORS:** SEE ELEV. FOR SPACING

- AT HEAD —
- TYPE 'A'— 1/4" DIA. ULTRACON+ BY 'DEWALT' (Fu=164 KSI, Fy=148 KSI)  
THRU 1BY OR 2BY BUCKS INTO CONCRETE  
1-1/4" MIN. EMBED INTO CONCRETE
- TYPE 'B'— 1/4" DIA. ULTRACON+ BY 'DEWALT' (Fu=164 KSI, Fy=148 KSI)  
DIRECTLY INTO CONCRETE  
1-3/4" MIN. EMBED
- TYPE 'C'— 1/4" DIA. SELF DRILLING SCREWS (GRADE 5 CRS)  
INTO MIAMI-DADE COUNTY APPROVED MULLIONS  
OR  
INTO METAL STRUCTURES  
(3) THREADS MIN. PENETRATION BEYOND SUBSTRATE  
ALUMINUM: 1/8" THK. MIN. (6063-T5 MIN.)  
STEEL: 1/8" THK. MIN. (Fy = 36 KSI MIN.)  
(STEEL IN CONTACT WITH ALUMINUM TO BE PLATED OR PAINTED)


- AT SILL —
- TYPE 'B'— 5/16" DIA. ULTRACON BY 'DEWALT' (Fu=177 KSI, Fy=155 KSI)  
DIRECTLY INTO CONCRETE  
2" MIN. EMBED

- AT JAMBS —
- TYPE 'A'— 1/4" DIA. ULTRACON+ BY 'DEWALT' (Fu=164 KSI, Fy=148 KSI)  
INTO 2BY WOOD BUCKS OR WOOD STRUCTURES  
1-1/2" MIN. PENETRATION INTO WOOD  
THRU 1BY BUCKS INTO CONC. OR BLOCKS  
1-1/4" MIN. EMBED INTO CONC. OR BLOCKS
- TYPE 'B'— 1/4" DIA. ULTRACON+ BY 'DEWALT' (Fu=164 KSI, Fy=148 KSI)  
DIRECTLY INTO CONC. OR BLOCKS  
1-1/4" MIN. EMBED INTO CONC. OR BLOCKS
- TYPE 'C'— 1/4" DIA. SELF DRILLING SCREWS (GRADE 5 CRS)  
INTO MIAMI-DADE COUNTY APPROVED MULLIONS  
OR  
INTO METAL STRUCTURES  
(3) THREADS MIN. PENETRATION BEYOND SUBSTRATE  
ALUMINUM: 1/8" THK. MIN. (6063-T5 MIN.)  
STEEL: 1/8" THK. MIN. (Fy = 36 KSI MIN.)  
(STEEL IN CONTACT WITH ALUMINUM TO BE PLATED OR PAINTED)

**TYPICAL EDGE DISTANCE**

INTO CONCRETE AND BLOCKS = 2-1/2" MIN.  
INTO WOOD STRUCTURE = 1" MIN.  
INTO METAL STRUCTURE = 3/4" MIN.


WOOD AT HEAD OR JAMBS SG = 0.55 MIN.  
CONCRETE AT HEAD, SILL OR JAMBS f'c = 3000 PSI MIN.  
C-90 HOLLOW/FILLED BLOCK AT JAMBS f'm = 2000 PSI MIN.

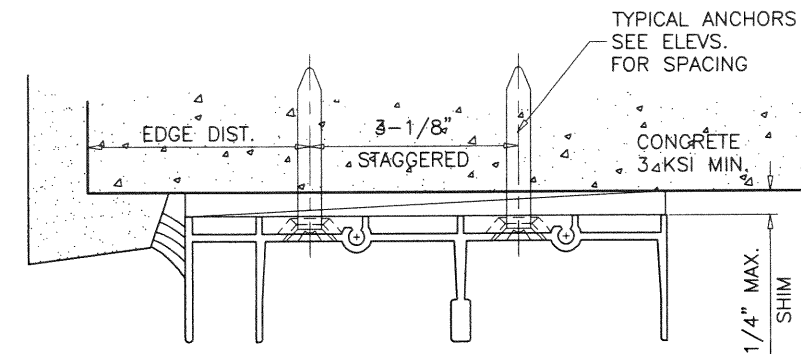

**PRODUCT REVISED**  
as complying with the Florida  
Building Code  
NOA-No. 20-1119.19



Expiration Date 04/04/2024

By Ishaq I. Chandra  
Miami-Dade Product Control

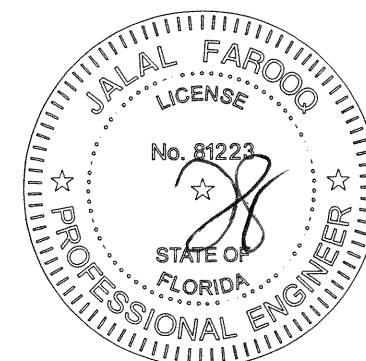

NOV 18 2023

<b>af c</b>	
<b>AL-FAROOQ CORPORATION</b> ENGINEERS & PRODUCT DEVELOPMENT 9360 SUNSET DRIVE, SUITE 220 MIAMI, FLORIDA 33173 (C.A.N. 3538) TEL. (305) 264-8100 FAX. (305) 262-6978 COMP-ANL 18-21D-ECO	
SERIES-750 ALUM SLIDING GLASS DOOR (S.M.I.)	
ECO WINDOW SYSTEMS, LLC. 8502 N.W. 80th STREET MEDLEY, FL. 33166 TEL. (305) 885-5299 FAX (305) 885-5902	
revisions:	
no	date
1	11.05.20
description	
A 11.05.20 UPDATED TO 2020 FBC	
date:	01-18-18
scale:	1/2" = 1"
dr. by:	TARIQ
chk. by:	
drawing no.	
18-21D	
sheet 4 of 8	

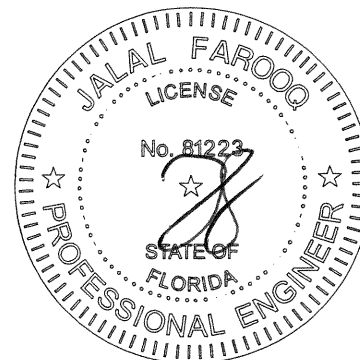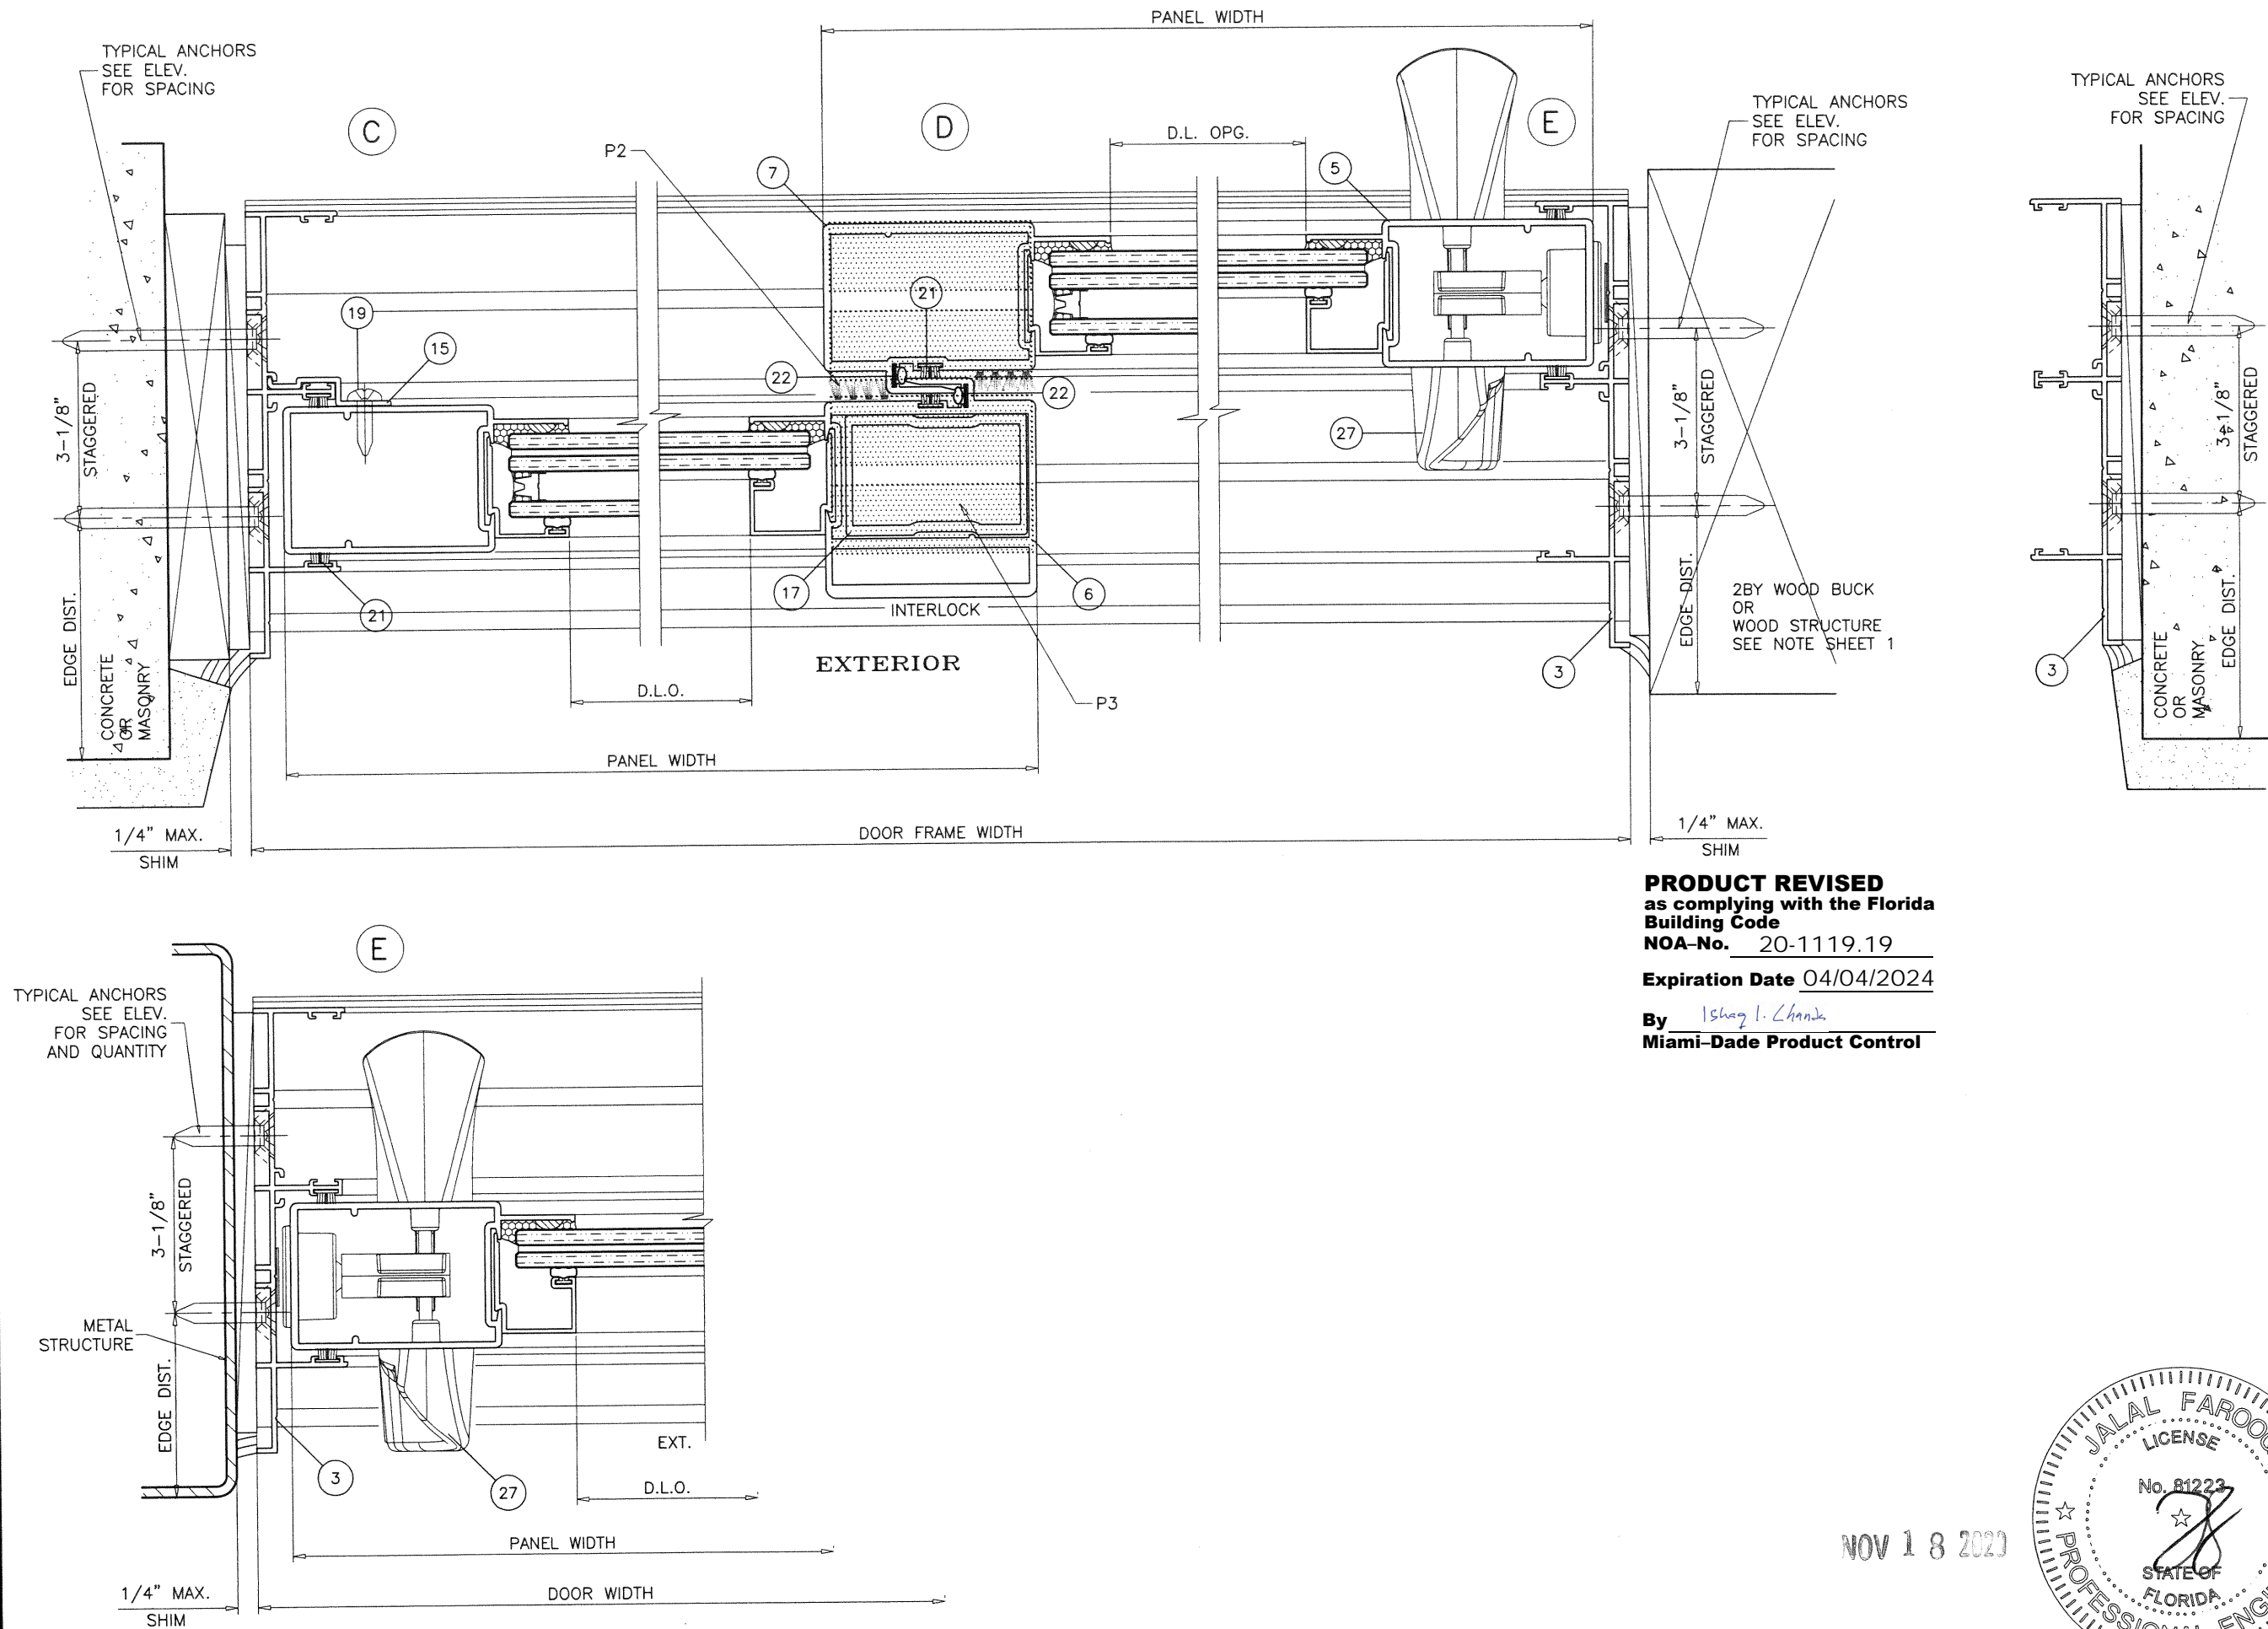

NOV 18 2020

<b>AL-FAROOQ CORPORATION</b> ENGINEERS & PRODUCT DEVELOPMENT 9360 SUNSET DRIVE, SUITE 220 MIAMI, FLORIDA 33173 TEL. (305) 264-8100 FAX. (305) 262-6978 (C.A.N. 3538)			
SERIES-750 ALUM SLIDING GLASS DOOR (S.M.I.) <b>ECO WINDOW SYSTEMS, LLC.</b> 8502 N.W. 80th STREET MEDLEY, FL. 33166 TEL. (305) 885-5299 FAX (305) 885-5902			
date: 01-18-18 scale: 1/2" = 1" dr. by: TARIQ chk. by:	no. 11.05.20 by description UPDATED TO 2020 FBC	revisions: no. date by description A 11.05.20 UPDATED TO 2020 FBC	drawing no. <b>18-21D</b> sheet 5 of 8

COMP-ANL\18-21D-ECO




ITEM #	PART #	QUANTITY	DESCRIPTION	MATERIAL	MANF./SUPPLIER/REMARKS
1	E701	1	FRAME HEAD (2 TRACK)	6005-T5	-
2	E702	1	FRAME SILL (2 TRACK)	6005-T5	-
3	E703	2	FRAME JAMB (2 TRACK)	6063-T6	-
4	E704	2/ PANEL	PANEL TOP AND BOTTOM RAIL	6063-T6	-
5	E705	AS RQD.	PANEL LOCK STILE	6063-T6	-
6	E730	AS REQD.	PANEL H.D. OUTER INTERLOCK	6063-T6	-
7	E707	AS REQD.	PANEL INNER INTERLOCK	6063-T6	-
10	E710	AS REQD.	GLAZING BEAD 7/16" LAMINATED GLASS	6063-T6	-
11	E711	AS REQD.	GLAZING BEAD 1" INSULATED GLASS	6063-T6	-
13	E713	AS REQD.	2" SILL RISER	6063-T6	-
14	E714	AS REQD.	2-3/4" SILL RISER	6063-T6	-
15	E715	AS REQD.	FIXED PANEL CLIP (CONTINUOUS)	6063-T6	-
17	E717	AS REQD.	INTERLOCK STIFFENER (FULL PANEL LENGTH)	6063-T6	-
18	#10 X 3/4" HWH SMS	AS REQD.	FRAME ASSY. SCREWS	ST. STEEL	-
18A	#10 X 1" FH SMS	AS REQD.	PANEL ASSY. SCREWS	ST. STEEL	-
19	#8 X 1/2" PH SMS	2/CLIP	FIXED PANEL CLIP SCREWS	ST. STEEL	AT 3" FROM ENDS & 16" O.C.
20	#10 X 1-1/4" PH SMS	1/ ROLLER	ROLLER INST. SCREWS	-	NOT SHOWN
21	WEATHERSTRIP	AS REQD.	FRAME AND PANEL WEATHERSTRIP	-	FIN SEAL .190 HIGH BY ULTRAFAB
22	E235	AS REQD.	INTERLOCK BUMPER BULB	SANTOPRENE	ULTRAFAB
23	E203	AS REQD.	GLAZING BEAD BULB	SANTOPRENE	ULTRAFAB, DUROMETER 65±5
24	PR03-6005	2/ MOV. PANEL	TANDEM NYLON WHEELS IN ST. STEEL HOUSING	-	INTERLOCK (1/2" MTG. SPACER REQD.)
25	E718	2/PANEL	FIXED PANEL SKATE	DELRIN	-
26	#8 X 1/2" PH SMS	2/CLIP	FIXED PANEL SKATE INST. SCREWS	ST. STEEL	
27	-	AS REQD.	3 PLY DUAL POINT LOCK ASSEMBLY	-	BY INTERLOCK
28		AS REQD.	BUMPON SPACER	SILICONE	BY FRANK LOWE
29		AS REQD.	SETTING BLOCKS AT 1/4 POINTS	EPDM	DUROMETER 80±5 SHORE A

SEALANT:

ALL JOINTS AND FRAME CONNECTIONS SEALED WITH WHITE/ALUMINUM COLORED SILICONE.

PRODUCT REVISED  
as complying with the Florida  
Building Code  
NOA-No. 20-1119.19  
Expiration Date 04/04/2024  
By Ismael I. Chanda  
Miami-Dade Product Control

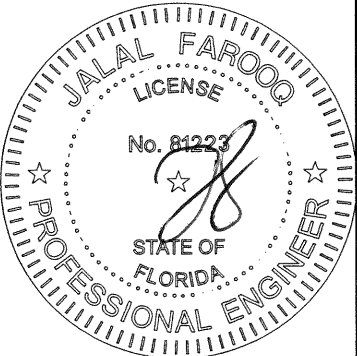

NOV 18 2020

AL-FAROOQ CORPORATION  
ENGINEERS & PRODUCT DEVELOPMENT  
9360 SUNSET DRIVE, SUITE 220  
MIAMI, FLORIDA 33173  
TEL. (305) 264-8100  
FAX. (305) 262-6978

COMP-ANL\18-21D-ECO














SERIES-750 ALUM SLIDING GLASS DOOR (S.M.I.)

ECO WINDOW SYSTEMS, LLC.  
8502 N.W. 80th STREET  
MEDLEY, FL. 33166  
TEL. (305) 885-5299  
FAX (305) 885-5902

revisions:  
no. date by description  
A 11.05.20 by UPDATED TO 2020 FBC

date: 01-18-18  
scale: 1/2" = 1"  
dr. by: TARIQ  
chk. by:

drawing no.  
18-21D  
sheet 6 of 8

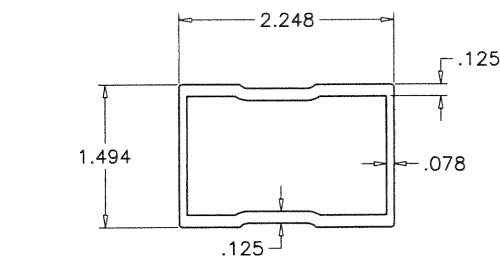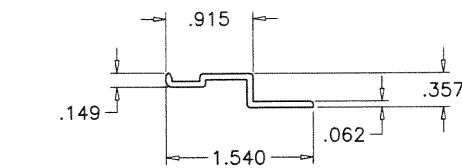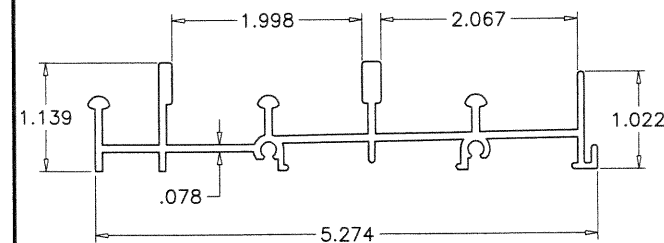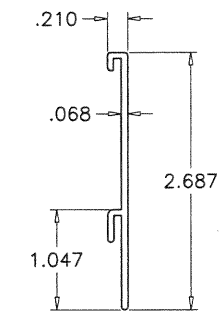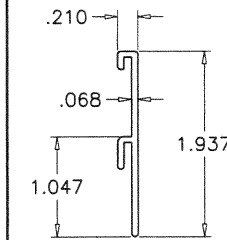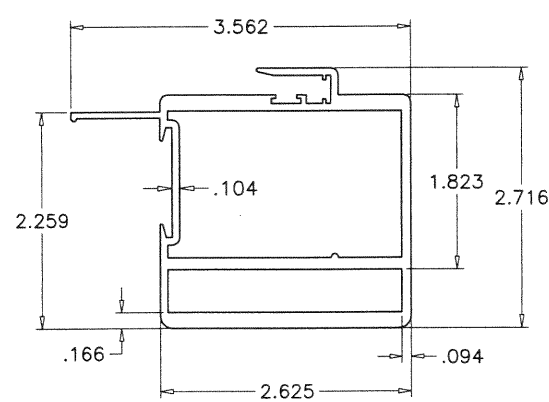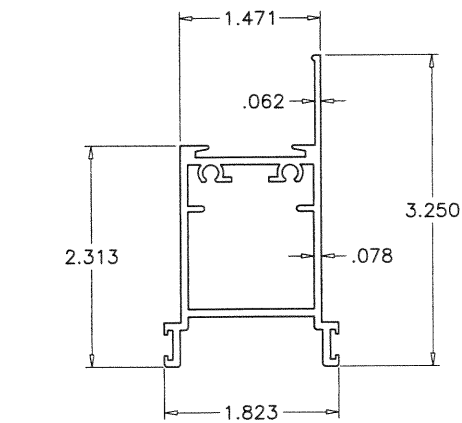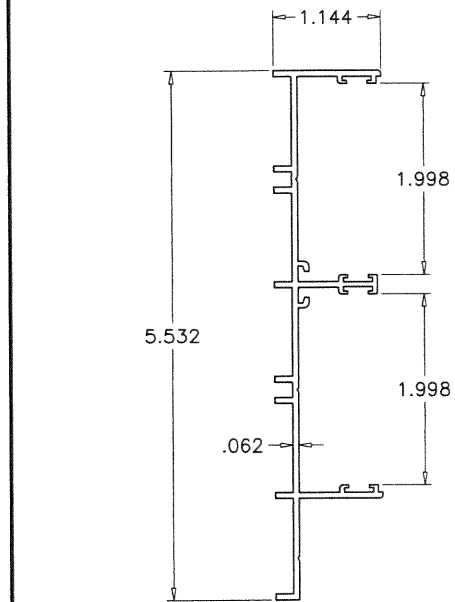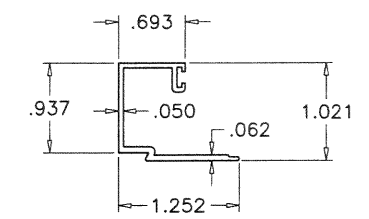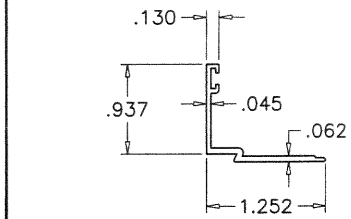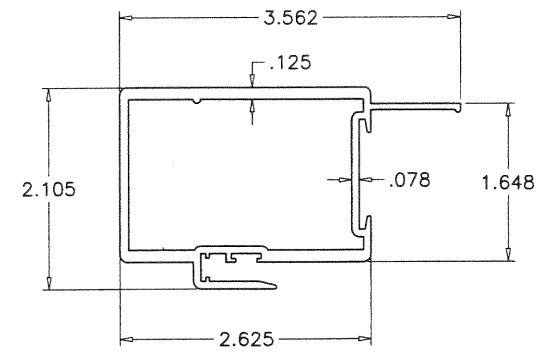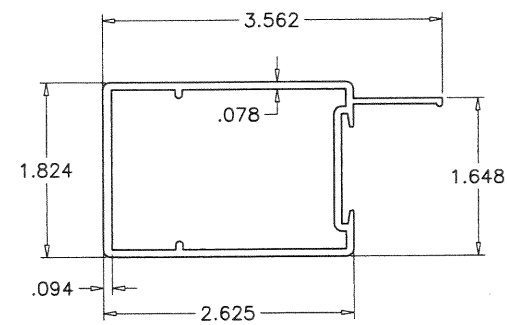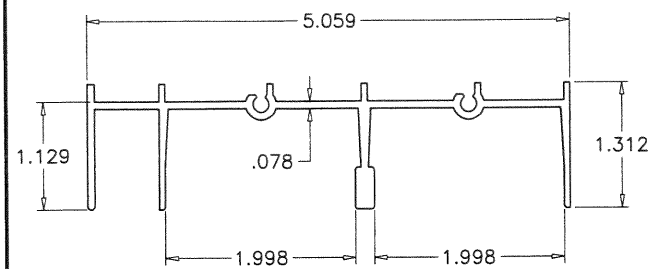

**PRODUCT REVISED**  
as complying with the Florida  
Building Code  
NOA-No. 20-1119.19

**Expiration Date** 04/04/2024

By Ishaq I. Chande  
Miami-Dade Product Control

a f c

**AL-FAROOQ CORPORATION**  
ENGINEERS & PRODUCT DEVELOPMENT  
9360 SUNSET DRIVE, SUITE 220  
MIAMI, FLORIDA 33173 (C.A.N. 3538)  
TEL. (305) 264-8100 FAX. (305) 262-6978

COMP-ANL\18-21D-ECO

SERIES-750 ALUM SLIDING GLASS DOOR (S.M.I.)

ECO WINDOW SYSTEMS, LLC.  
8502 N.W. 80th STREET

8502 N.W. 80TH STREET  
MEDLEY, FL. 33166  
TEL (305) 995 5200 FAX

[illegible]

revisions:		
no	date	by description
A	11.05.20	UPDATED TO 2020 FBC

date: 01-18-18

scale:  $1/2'' = 1''$


dr. by: TARIQ

... 57.

drawing no.

18-21D

sheet 7 of 8

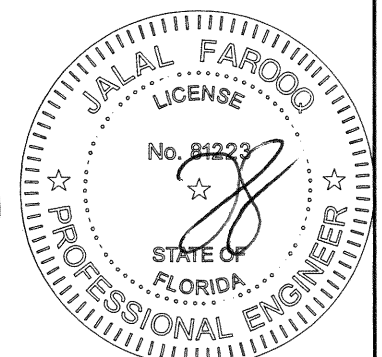

NOV 18 2021

