



DEPARTMENT OF REGULATORY AND ECONOMIC RESOURCES (RER)
BOARD AND CODE ADMINISTRATION DIVISION

NOTICE OF ACCEPTANCE (NOA)

MIAMI-DADE COUNTY
PRODUCT CONTROL SECTION
11805 SW 26 Street, Room 208
Miami, Florida 33175-2474
T (786) 315-2590 F (786) 315-2599
www.miamidade.gov/economy

Wall Panel Systems, Inc.
1720 Howard Place
Redlands, CA 92373

SCOPE:

This NOA is being issued under the applicable rules and regulations governing the use of construction materials. The documentation submitted has been reviewed and accepted by Miami-Dade County RER-Product Control Section to be used in Miami Dade County and other areas where allowed by the Authority Having Jurisdiction (AHJ).

This NOA shall not be valid after the expiration date stated below. The Miami-Dade County Product Control Section (In Miami Dade County) and/or the AHJ (in areas other than Miami Dade County) reserve the right to have this product or material tested for quality assurance purposes. If this product or material fails to perform in the accepted manner, the manufacturer will incur the expense of such testing and the AHJ may immediately revoke, modify, or suspend the use of such product or material within their jurisdiction. RER reserves the right to revoke this acceptance if it is determined by Miami-Dade County Product Control Section that this product or material fails to meet the requirements of the applicable building code.

This product is approved as described herein and has been designed to comply with the Florida Building Code, including the High Velocity Hurricane Zone.

DESCRIPTION: WPS ES-400, ES-500 and Horizontal Flush Composite Siding Panel Systems

APPROVAL DOCUMENT: Drawing No. **01-0400, 01-0500** and **01-HFS**, titled "WPS Exterior System with Exposed Fasteners, Concealed Fasteners, and Horizontal Flush Siding System", sheets 1 through 10 of 10, with revision E dated 06/28/2023, prepared by Wall Panel Systems, Inc., signed and sealed by William E. Fitch, P.E., bearing the Miami-Dade County Product Control Revision stamp with the Notice of Acceptance number and approval date by the Miami-Dade County Product Control Section.

MISSILE IMPACT RATING: Large and Small Missile Impact Resistant

LABELING: A permanent label with the manufacturer's name or logo, city, state, model/series, and following statement: "Miami-Dade County Product Control Approved", is to be located on each panel.

RENEWAL of this NOA shall be considered after a renewal application has been filed and there has been no change in the applicable building code negatively affecting the performance of this product.

TERMINATION of this NOA will occur after the expiration date or if there has been a revision or change in the materials, use, and/or manufacture of the product or process. Misuse of this NOA as an endorsement of any product, for sales, advertising or any other purposes shall automatically terminate this NOA. Failure to comply with any section of this NOA shall be cause for termination and removal of NOA.

ADVERTISEMENT: The NOA number preceded by the words Miami-Dade County, Florida, and followed by the expiration date may be displayed in advertising literature. If any portion of the NOA is displayed, then it shall be done in its entirety.

INSPECTION: A copy of this entire NOA shall be provided to the user by the manufacturer or its distributors and shall be available for inspection at the job site at the request of the Building Official.

This NOA **revises NOA # 19-0305.03** and consists of this page 1 and evidence page E-1, as well as approval document mentioned above.

The submitted documentation was reviewed by **Carlos M. Utrera, P.E.**

MIAMI-DADE COUNTY
APPROVED

NOA No. 23-0525.03
Expiration Date: February 16, 2028
Approval Date: September 14, 2023
Page 1

NOTICE OF ACCEPTANCE: EVIDENCE SUBMITTED

1. Evidence submitted under NOA # 19-0305.03 and new

A. DRAWINGS

1. Drawing No. **01-0400, 01-0500** and **01-HFS**, titled “WPS Exterior System with Exposed Fasteners, Concealed Fasteners, and Horizontal Flush Siding System”, sheets 1 through 10 of 10, with revision E dated 06/28/2023, prepared by Wall Panel Systems, Inc., signed and sealed by William E. Fitch, P.E.

B. TESTS

1. Test reports on 1) Uniform Static Air Pressure Test, Loading per FBC TAS 202-94
2) Cyclic Wind Pressure Loading per FBC, TAS 203-94
along with marked-up drawings and installation diagram of WPS ES-400 Exposed Fastener System, prepared by Intertek, Test Report No. **M8122.03-303-44 R6**, dated 07/13/2022, with revision dated 01/12/2023 signed and sealed by Tyler Westerling, P.E.
2. Test reports on 1) Uniform Static Air Pressure Test, Loading per FBC TAS 202-94
2) Cyclic Wind Pressure Loading per FBC, TAS 203-94
along with marked-up drawings and installation diagram of WPS ES-500 Concealed Fastener System, prepared by Intertek, Test Report No. **M8124.03-303-44 R6**, dated 07/07/2022, with revision dated 01/17/2023 signed and sealed by Tyler Westerling, P.E.
3. Test reports on 1) Uniform Static Air Pressure Test, Loading per FBC TAS 202-94
2) Cyclic Wind Pressure Loading per FBC, TAS 203-94
along with marked-up drawings and installation diagram of WPS Horizontal Flush Siding System, prepared by Intertek, Test Report No. **M8125.03-303-44 R6**, dated 07/07/2022, with revision dated 01/17/2023 signed and sealed by Tyler Westerling, P.E.

C. CALCULATIONS

1. Anchor verification calculations, prepared by Christopher Roberts, dated 07/05/2022, signed and sealed by William E. Fitch, P.E.

D. QUALITY ASSURANCE

1. Miami-Dade Department of Regulatory and Economic Resources (RER).

E. MATERIAL CERTIFICATIONS

1. Notice of Acceptance No. **22-0202.07**, issued to Trespa North America, Ltd., for their **TS 110 Trespa Meteon FR Composite Siding System**, approved on 03/10/2022 and expiring on 01/08/2024.

F. STATEMENTS

1. Statement letter of code conformance to the 7th edition (2020) of the FBC, and of no financial interest, issued by William E. Fitch, P.E., dated 11/11/2022, signed and sealed by William E. Fitch, P.E.



Carlos M. Utrera, P.E.
Product Control Examiner
NOA No. 23-0525.03

Expiration Date: February 16, 2028
Approval Date: September 14, 2023

GENERAL NOTES:

1. THE PRODUCT SHOWN HEREIN IS DESIGNED AND MANUFACTURED TO COMPLY WITH REQUIREMENTS OF THE FLORIDA BUILDING CODE.
2. WOOD FRAMING AND MASONRY FENESTRATION TO BE DESIGNED AND ANCHORED TO PROPERLY TRANSFER ALL LOADS TO STRUCTURE. FRAMING AND MASONRY FENESTRATION IS THE RESPONSIBILITY OF THE ARCHITECT OF RECORD.
3. CONTRACTOR IS RESPONSIBLE FOR MAINTAINING STRUCTURAL INTEGRITY OF FENESTRATION AND ALL FRAMING AROUND FENESTRATION
4. FOR INSTALLATION INTO WOOD STUDS USE #10 X 2-1/2" WOOD SCREWS. LOCATE ANCHORS AS SHOWN IN ELEVATION AND INSTALLATION DETAILS.
5. WOOD STUDS SHALL BE SPACED @ 16" O.C. WITH 5/8" PLYWOOD SHEATHING PER FBC 2322.3 FOR USE IN HVHZ ZONES.
6. STEEL STUDS SHALL BE ENGINEERED SEPARATELY WITH 5/8" PLYWOOD FOR USE IN HVHZ ZONES.
7. FOR INSTALLATION INTO MASONRY OR CONCRETE WALL, USE 1/4" ITW TAPCON WITH SUFFICIENT LENGTH TO ACHIEVE 1-1/4" EMBEDMENT INTO SUBSTRATE. LOCATE ANCHORS AS SHOWN IN ELEVATION AND INSTALLATION DETAIL
8. ALL FASTENERS TO BE CORROSION RESISTANT.
9. INSTALLATION ANCHORS SHALL BE INSTALLED IN ACCORDANCE WITH ANCHOR MANUFACTURER'S INSTALLATION INSTRUCTIONS, AND ANCHORS SHALL NOT BE USED IN SUBSTRATES WITH STRENGTHS LESS THAN THE MINIMUM STRENGTH SPECIFIED BELOW

9.1 WOOD: MINIMUM SPECIFIC GRAVITY OF G=0.42


9.2 CONCRETE: MINIMUM COMPRESSIVE STRENGTH OF 3,200 PSI

9.3 MASONRY: STRENGTH CONFORMANCE TO ASTM C-90, GRADE N, TYPE 1 (OR GREATER)

9.4 STEEL STUD: 18GA. (0.060") FY=33KSI/FU=52KSI
10. ALLOWABLE STRESS INCREASE OF 1/3 WAS NOT USED IN THE DESIGN OF THE PRODUCT SHOWN HEREIN. WIND LOAD DURATION FACTOR Cd=1.6 WAS USED FOR WOOD ANCHOR CALCULATIONS.
11. COMPACT LAMINATED PHENOLIC PANELS IN THICKNESS 5/16" (8MM), 3/8" (10MM) & 1/2" (13MM). MATERIAL IS BASED ON THERMOSETTING RESINS HOMOGENEOUSLY REINFORCED WITH WOOD FIBERS AND MANUFACTURED UNDER PRESSURE AND TEMPERATURE.


11.1 METEON® PANELS MANUFACTURED BY TRESPA NORTH AMERICA, LTD.
MIAMI-DADE NOA 22-0202.07
12. EXTRUSION MATERIAL: ALUMINUM 6063-T6
13. THIS PRODUCT SHALL BE INSTALLED ONTO EXISTING APPROVED WALLS CONSISTING OF-CONCRETE, C-90, CONCRETE BLOCK, OR 5/8 IN. MIN. PLYWOOD SHEATHING.
14. WATER-RESISTIVE BARRIER PER FBC 1404.2 OR STUCCO.


| REVISIONS | | |
|-----------|-----------------------------------|------------|
| REV. | DESCRIPTION | DATE |
| A | REVISED PER M-D COMMENTS | 2/26/2021 |
| B | REVISED PER M-D COMMENTS | 7/14/2021 |
| C | Revised Per M-D Review | 12/13/2022 |
| D | Revised Panel Thicknesses Line 11 | 4/22/2023 |
| E | Added revision designations | 6/28/2023 |

PRODUCT REVISED
as complying with the Florida
Building Code
NOA-No. 23-0525.03
Expiration Date 02/16/2028
By 
Miami-Dade Product Control

| TABLE OF CONTENTS | |
|-------------------|------------------------------|
| SHEET | DESCRIPTION |
| 1. | GENERAL NOTES |
| 2. | ES-400 ELEVATIONS & SECTIONS |
| 3. | ES-400 INSTALLATION DETAILS |
| 4. | ES-400EXTRUSION SPECIFICS |
| 5. | ES-500 ELEVATIONS & SECTIONS |
| 6. | ES-500 INSTALLATION DETAILS |
| 7. | ES-500 EXTRUSION SPECIFICS |
| 8. | HFS-ELEVATIONS & SECTIONS |
| 9. | HFS-INSTALLATION DETAILD |
| 10. | HFS-EXTRUSION SPECIFICS |




| | | |
|---|--------------------|------------------|
| WALL PANEL SYSTEMS, INC. 1815 RUSTIN AVE. SUITE A RIVERSIDE, CA 92507 | | SYSTEM ALL |
| DESCRIPTION WPS Exterior Systems GENERAL NOTES | | |
| DRAWN BY: WPS, INC. | DWG NO 01-0100 | REV. E |
| SCALE N.T.S. | DATE 06/28/2023 | SHEET 1 OF 10 |

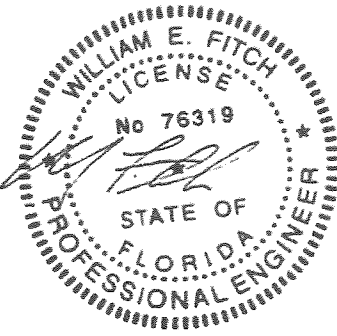

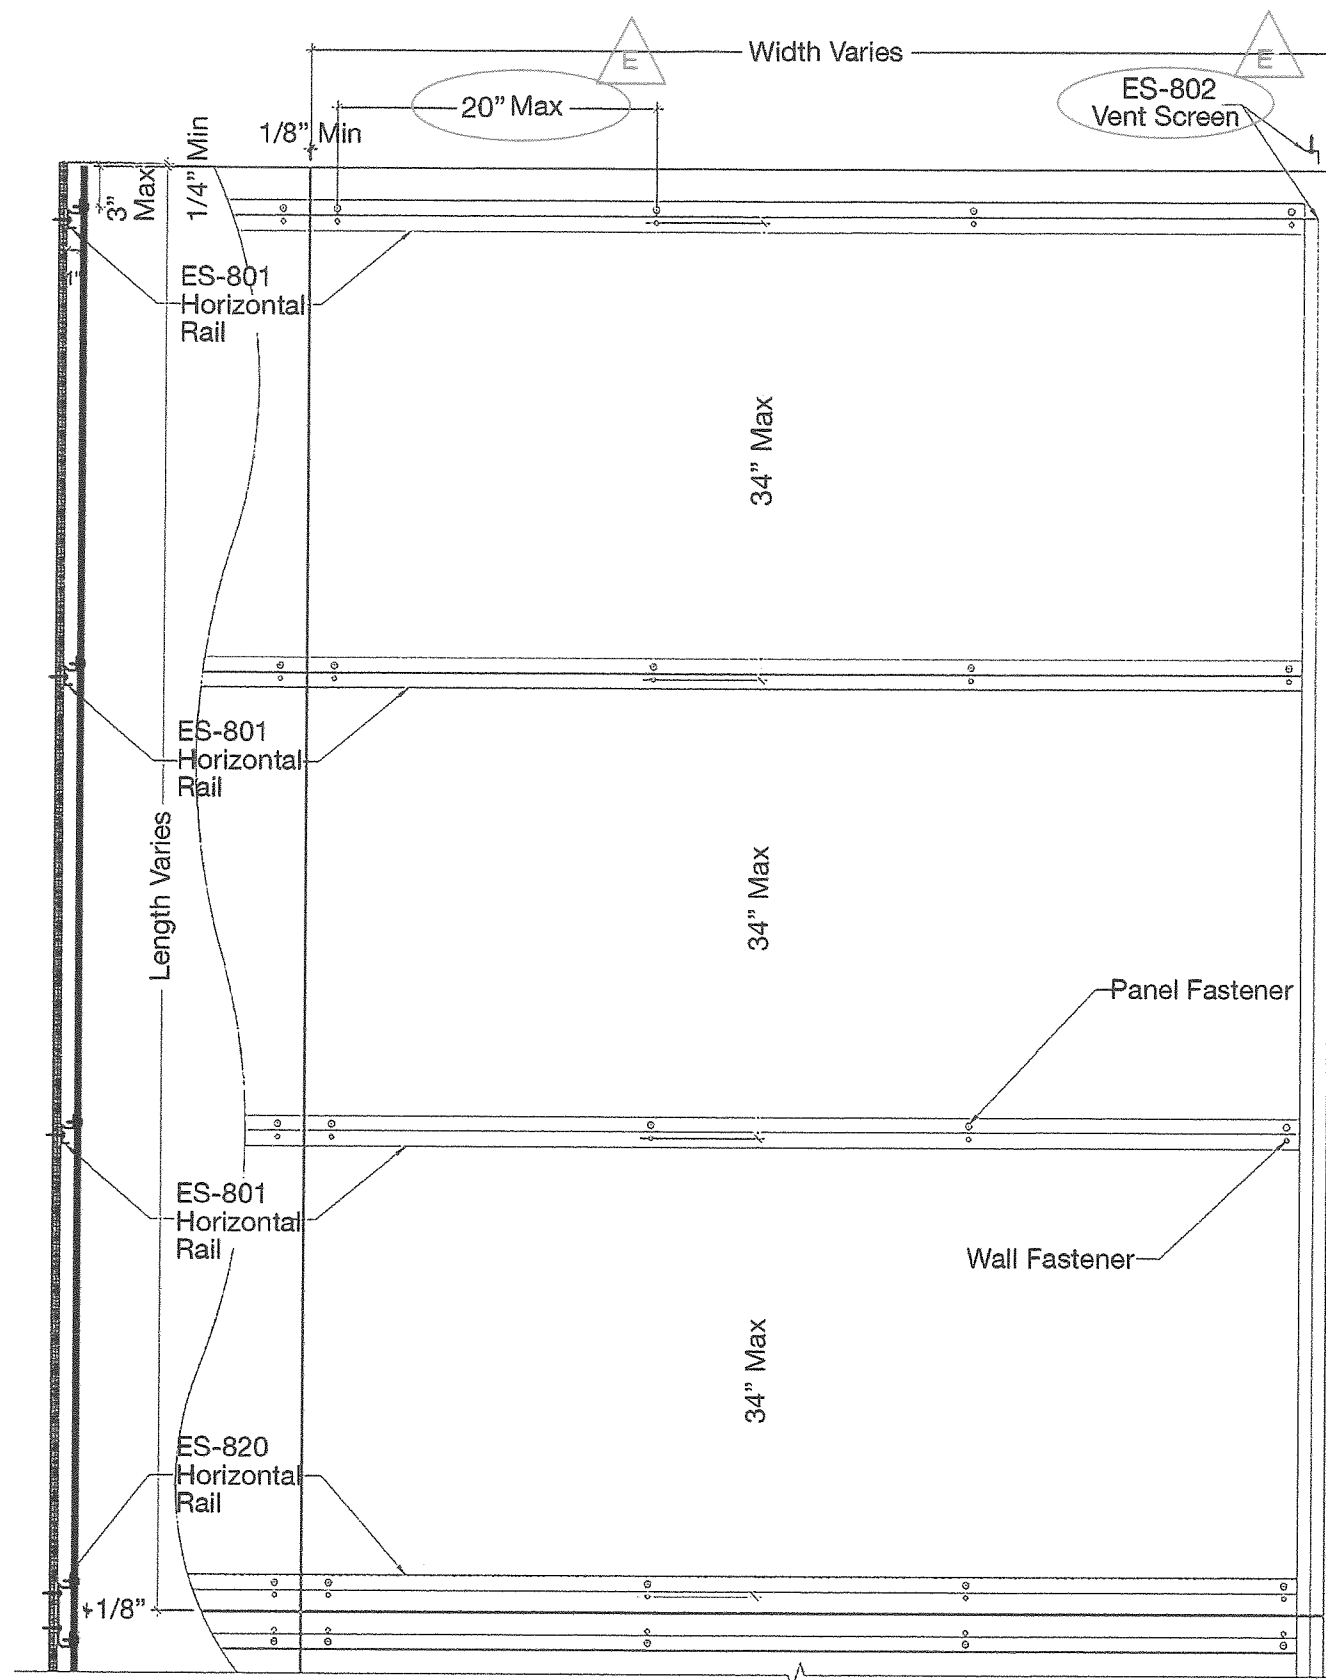

| DESIGN PRESSURE RATING | IMPACT RATING |
|---------------------------------|---|
| 8 mm, 10 mm & 13 mm ± 75 psf | Large and small missile impact when installed over 5/8" plywood sheathing on wood studs @ 16" o.c. per FBC 2322.3 |

| REVISIONS | | |
|-----------|---|------------|
| REV. | DESCRIPTION | DATE |
| A | REVISED PER M-D COMMENTS | 2/26/2021 |
| B | REVISED PER M-D COMMENTS | 7/14/2021 |
| C | REVISED PER M-D REVIEW | 12/13/2022 |
| D | Revised Vent Screen Number & Max Panel Fastener Spacing | 4/22/2023 |
| E | Added Revision Designations | 6/28/2023 |

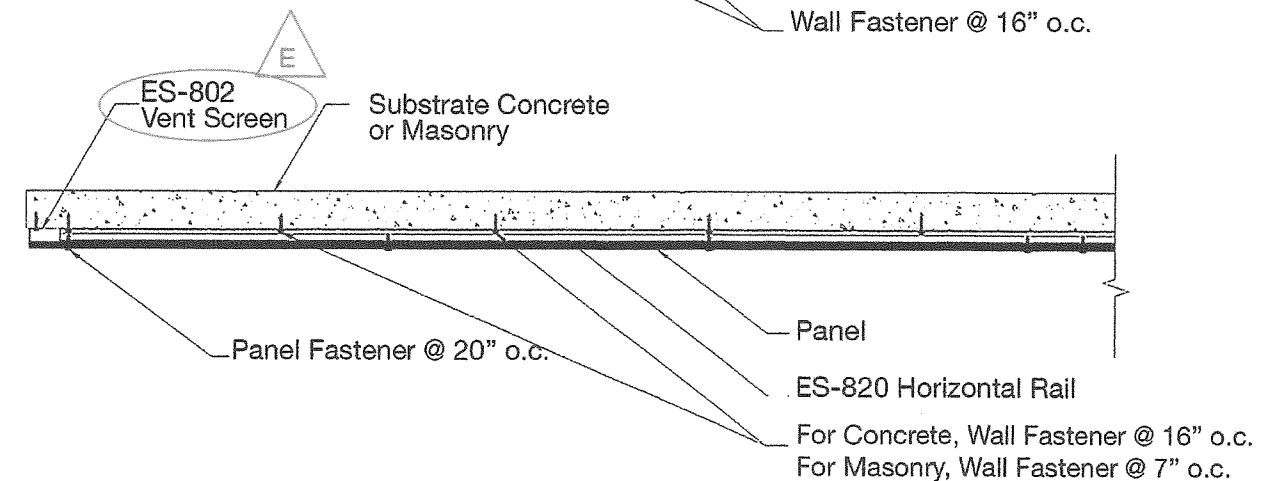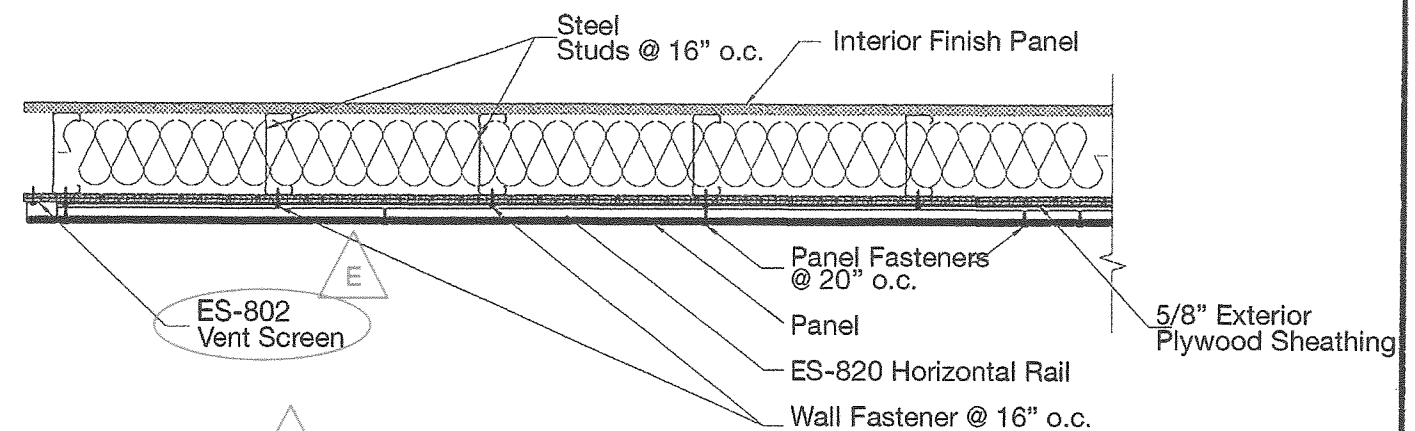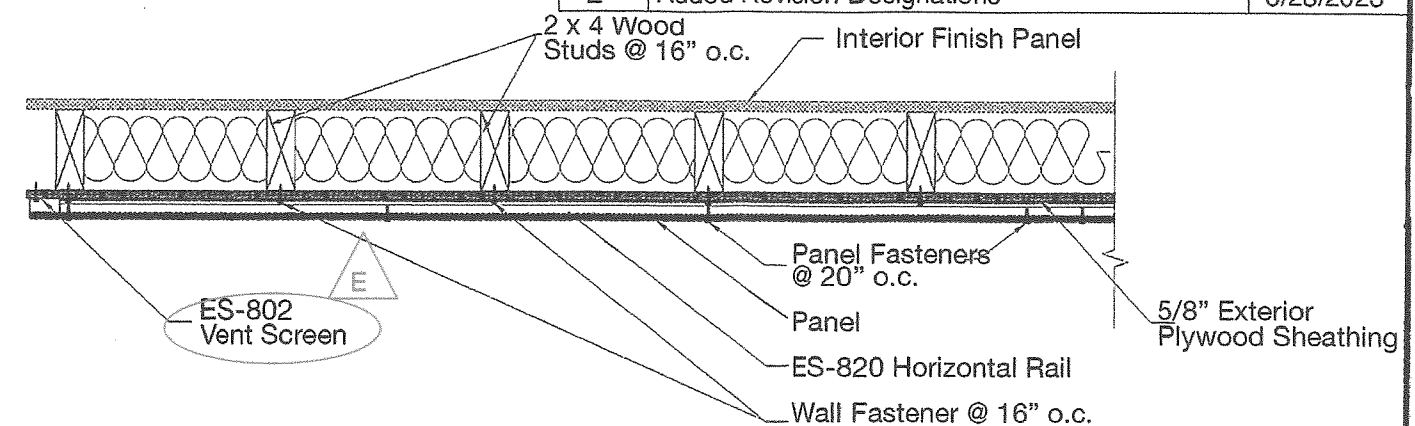


PRODUCT REVISED
as complying with the Florida
Building Code
NOA-No. 23-0525.03
Expiration Date 02/16/2028
By *[Signature]*
Miami-Dade Product Control

WALL PANEL SYSTEMS, INC.
1815 Rustin Ave, Suite A
Riverside, CA 92507





SYSTEM
ES-400

DESCRIPTION
WPS Exterior System with Exposed Fasteners
ELEVATIONS & SECTIONS

DRAWN BY: **WPS, INC.** DWG NO: **01-0400** REV: **E**
SCALE: **N.T.S.** DATE: **06/28/2023** SHEET: **2 OF 10**

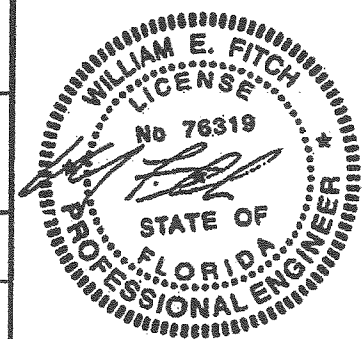


| REV. | REVISIONS | | DATE |
|------|--------------------------|--|------------|
| | DESCRIPTION | | |
| A | REVISED PER M-D COMMENTS | | 2/26/2021 |
| B | REVISED PER M-D COMMENTS | | 7/14/2021 |
| C | REVISED PER M-D REVIEW | | 12/13/2022 |

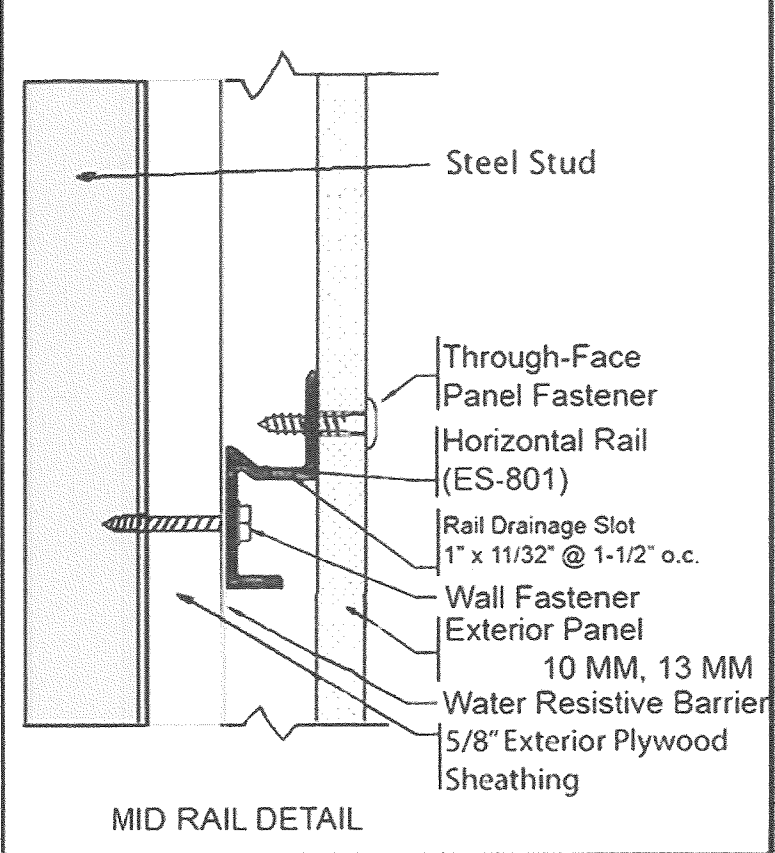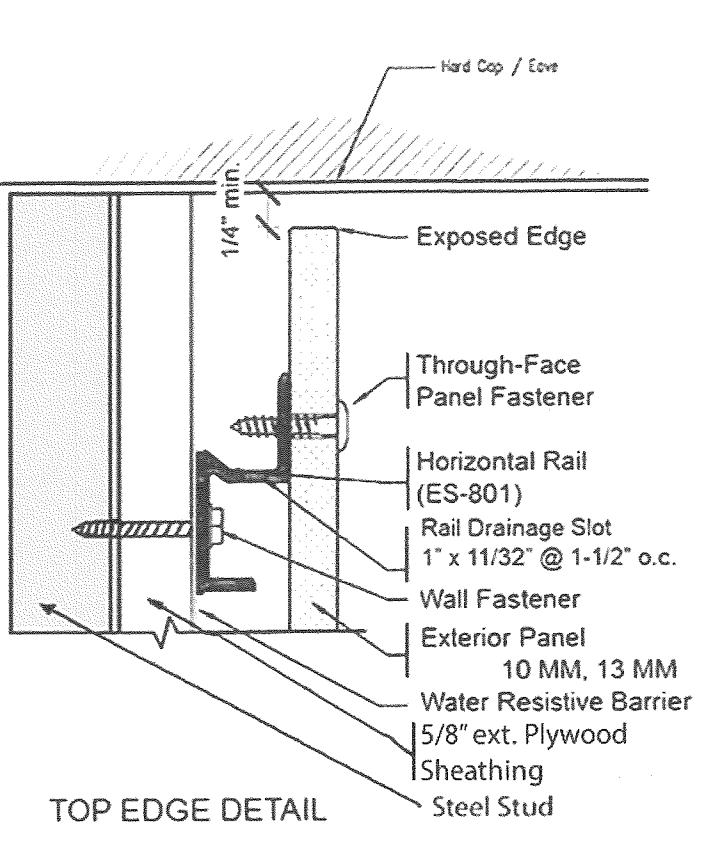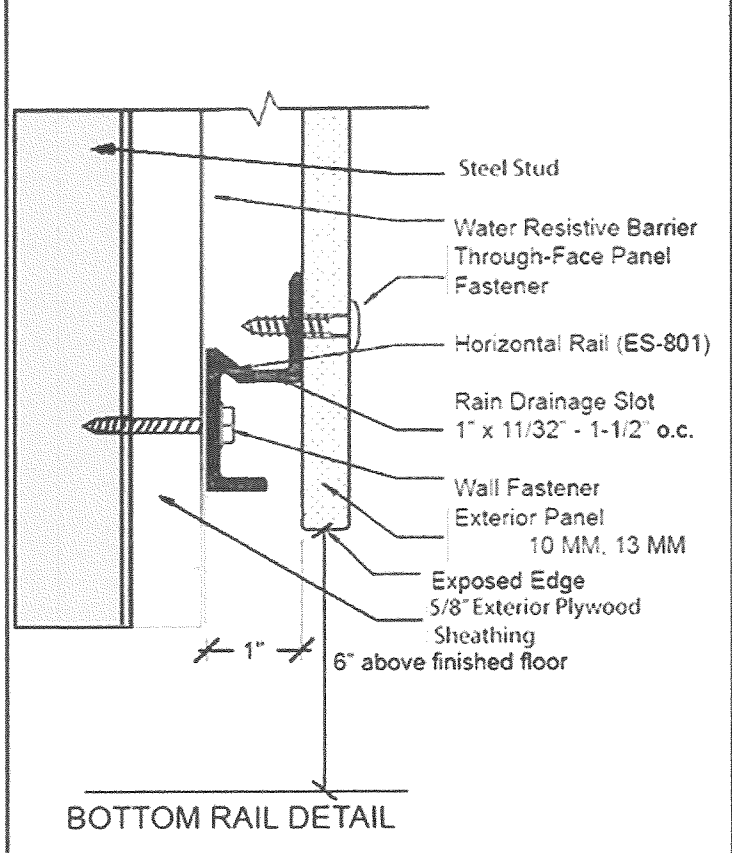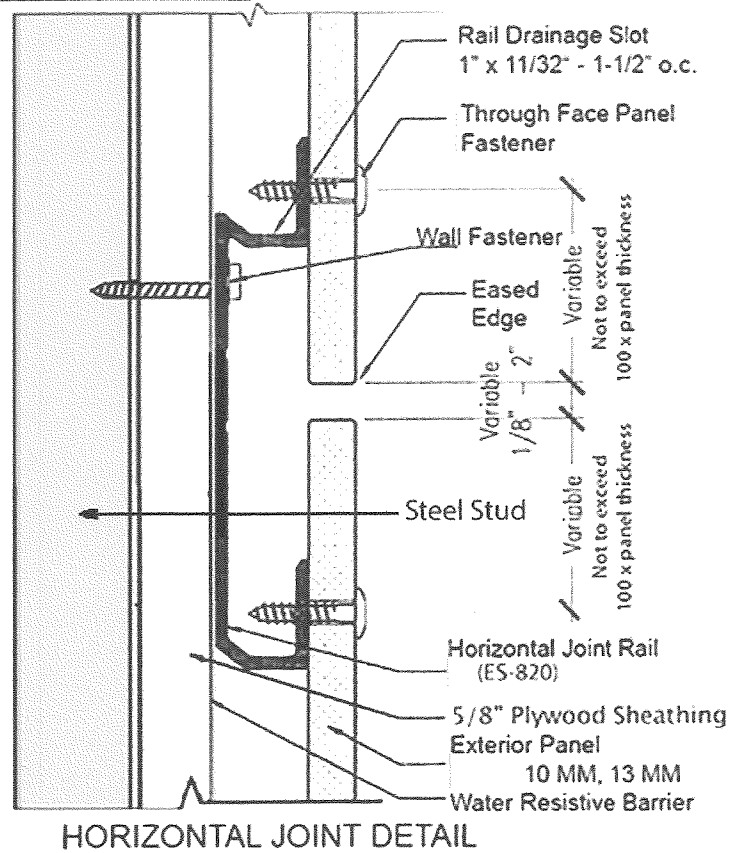







| WALL FASTENER SCHEDULE | | | PANEL FASTENER SCHEDULE | | | |
|------------------------|-----------------------------------|---------|-------------------------|-------------------|-----------|-----------------|
| SUBSTRATE | DESCRIPTION | MANUF. | PANEL THICK. | DESCRIPTION | MANUFACT. | MATERIAL |
| CONCRETE | 1/4" X 1-1/4" TITEN TTN SS | TAPCON | 1/2" (13mm) | SX3/15-D12-5,5x30 | SFS Intec | Stainless Steel |
| MASONRY C 90 | 1/4" X 1-1/4" TITEN TTN SS | TAPCON | 3/8" (10mm) | SX3/15-D12-5,5x30 | SFS Intec | Stainless Steel |
| STEEL STUD | #12 X 1-1/2" SELF DRILLING SCREWS | SIMPSON | 5/16" (8mm) | SX3/15-D12-5,5x30 | SFS Intec | Stainless Steel |
| WOOD STUD | SD-10 X 2-1/2" WOOD SCREWS | SIMPSON | | | | |

PRODUCT REVISED
as complying with the Florida
Building Code
NOA-No. 23-0525.03
Expiration Date 02/16/2028
By *[Signature]*
Miami-Dade Product Control

| | | |
|---|---------------------|------------------|
| WALL PANEL SYSTEMS, INC. 1815 Rustin Ave, Suite A Riverside, CA 92507 | | SYSTEM ES-400 |
| WPS EXTERIOR SYSTEM WITH EXPOSED FASTENERS. INSTALLATION DETAILS | | |
| DRAWN BY: WPS, INC. | DWG NO. 01-0400 | REV: C |
| SCALE: N.T.S. | DATE: 06/28/2023 | SHEET 3 OF 10 |

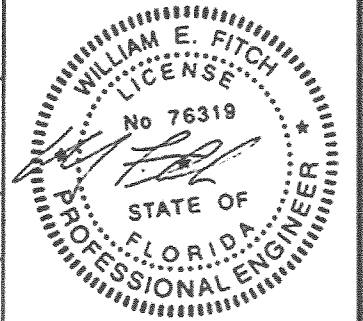



| REVISIONS | | |
|-----------|--------------------------|------------|
| REV. | DESCRIPTION | DATE |
| A | REVISED PER M-D COMMENTS | 2/26/2021 |
| B | REVISED PER M-D COMMENTS | 7/14/2021 |
| C | REVISED PER M-D REVIEW | 12/13/2022 |

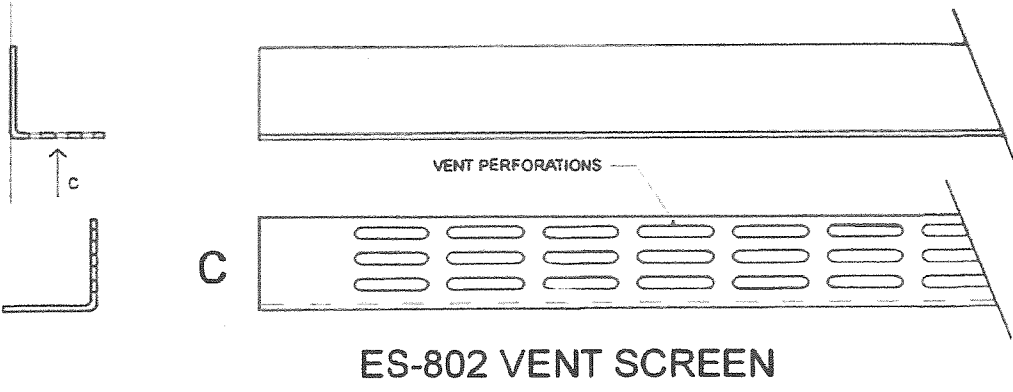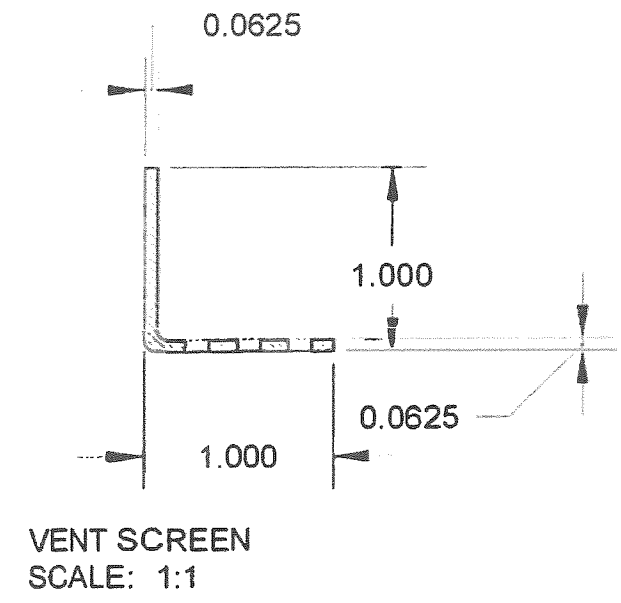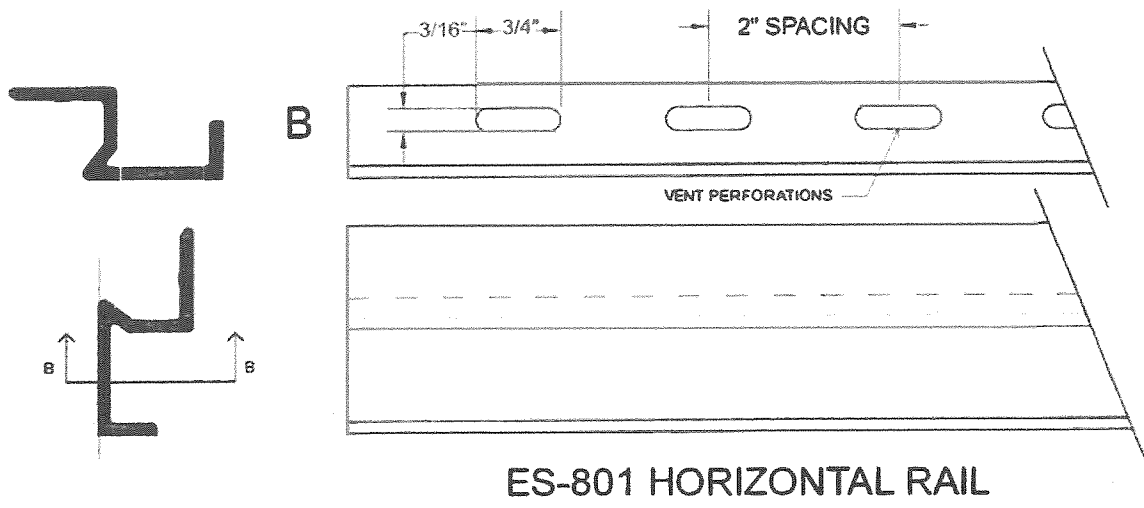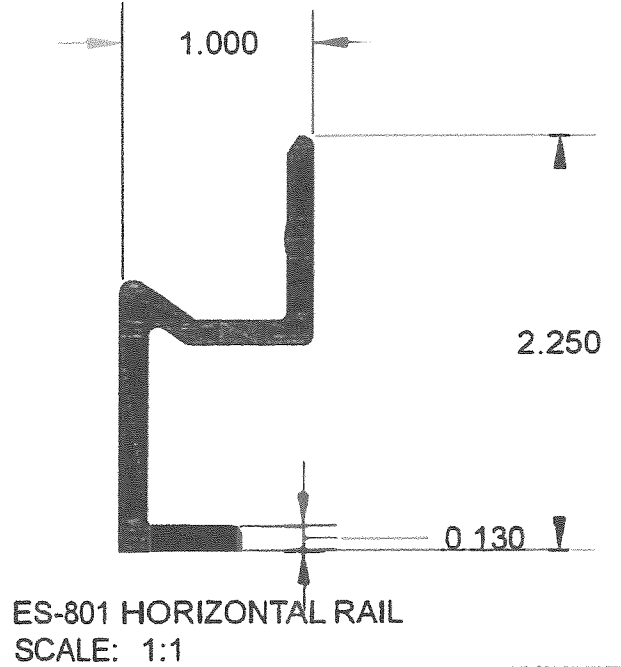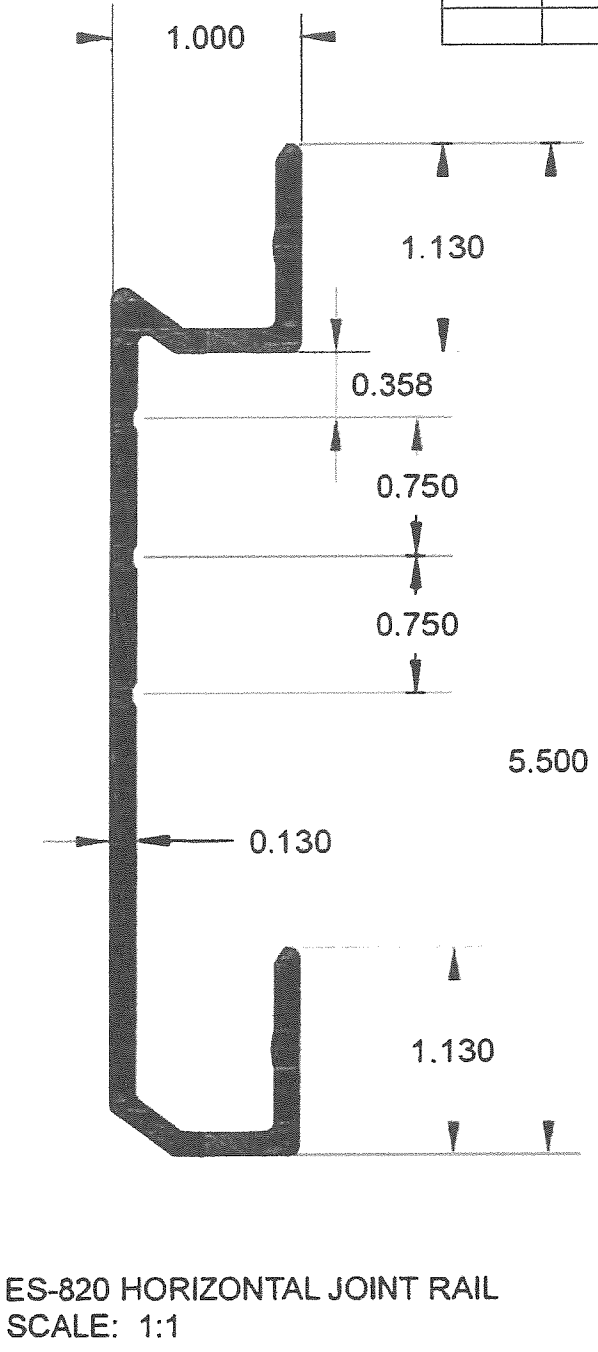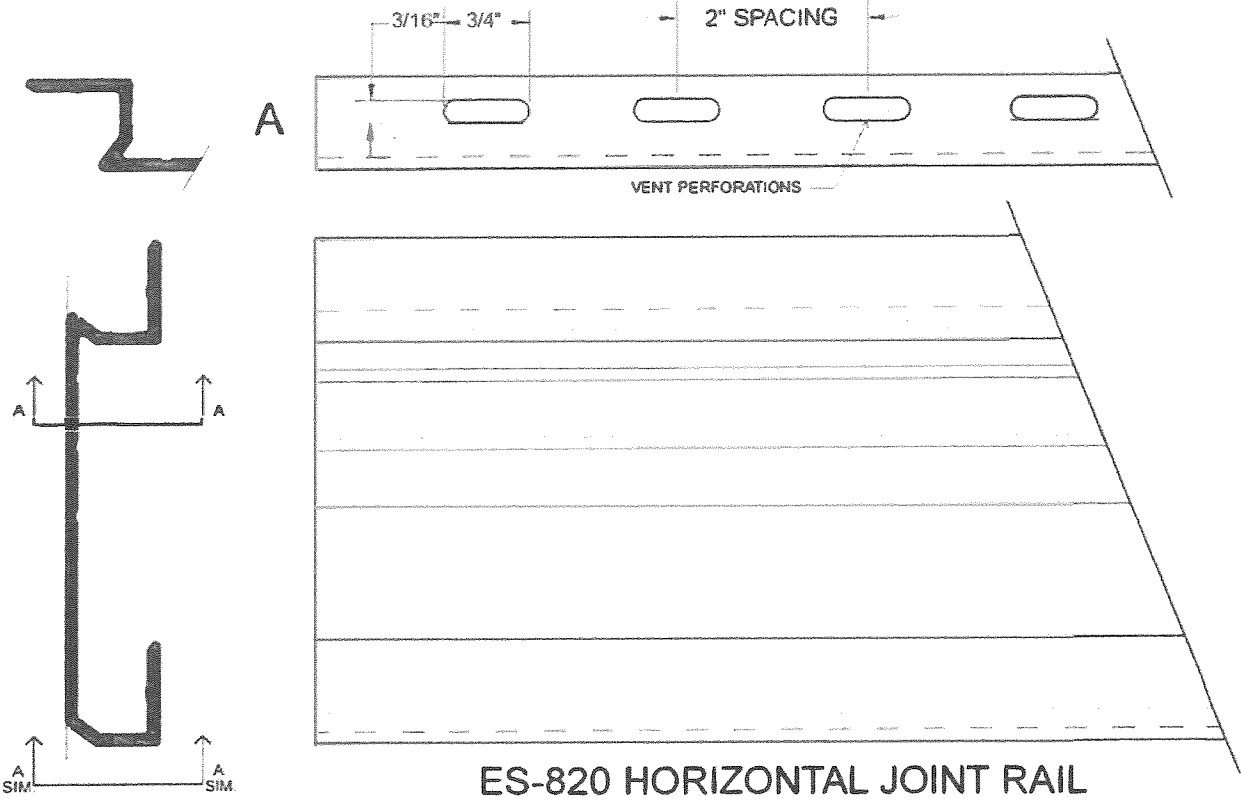

PRODUCT REVISED
as complying with the Florida
Building Code
NOA-No. 23-0525.03
Expiration Date 02/16/2028
By *[Signature]*
Miami-Dade Product Control


| | | |
|--|---------------------|------------------|
| WALL PANEL SYSTEMS, INC. 1815 Rustin Ave, Suite A Riverside, CA 92507 | | SYSTEM ES-400 |
| DESCRIPTION WPS Exterior System with Exposed Fasteners EXTRUSION SPECIFICS Manufactured by: Paramount Extrusions Company | | |
| DRAWN BY: WPS, INC. | DWG NO. 01-0400 | REV: C |
| SCALE: N.T.S. | DATE: 06/28/2023 | SHEET 4 OF 10 |

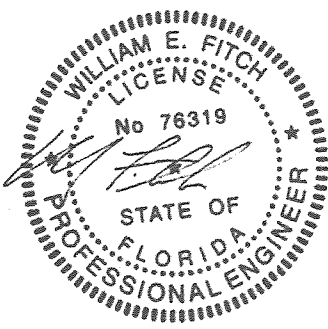

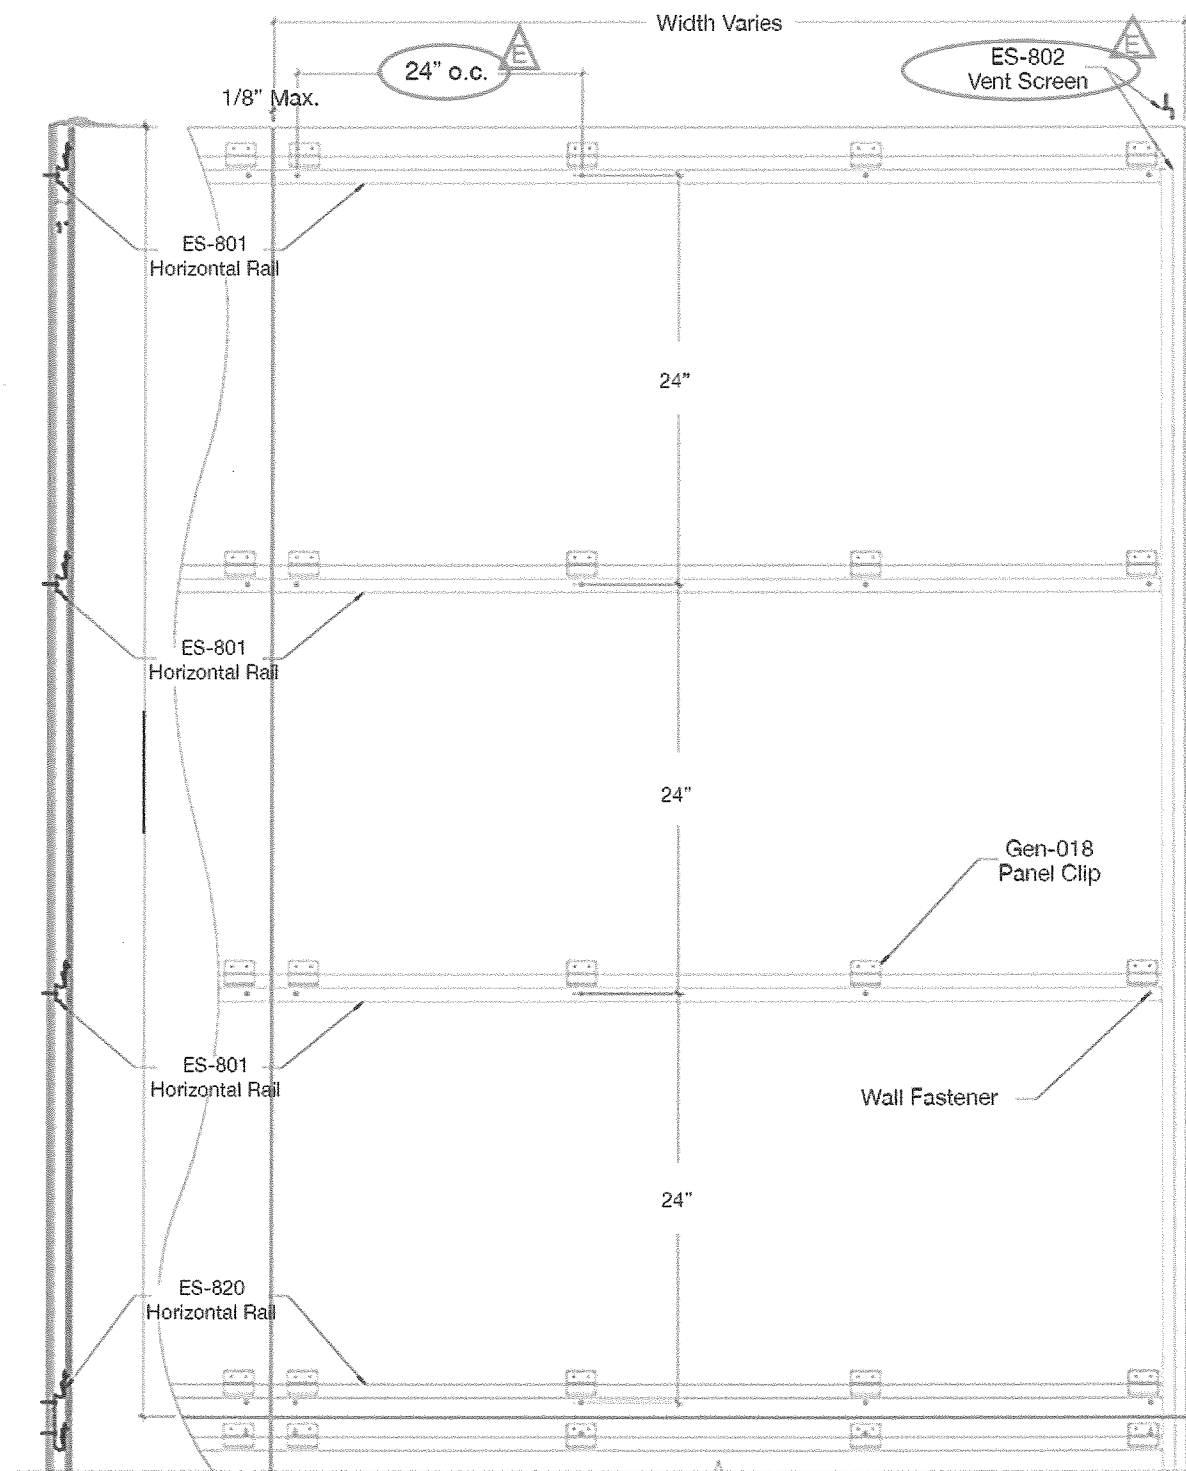


| DESIGN PRESSURE RATING | IMPACT RATING |
|---------------------------|---|
| 10 mm & 13 mm ± 60 psf | Large and small missile impact when installed over 5/8" plywood sheathing on wood studs @16" o.c. per FBC 2322.3 |

| REVISIONS | | |
|-----------|-----------------------------|------------|
| REV. | DESCRIPTION | DATE |
| A | REVISED PER M-D COMMENTS | 2/26/2021 |
| B | REVISED PER M-D COMMENTS | 2/15/2022 |
| C | REVISED PER M-D COMMENTS | 12/13/2022 |
| D | Corrected Vent Screen ID | 4/22/2023 |
| E | Added revision designations | 6/28/2023 |





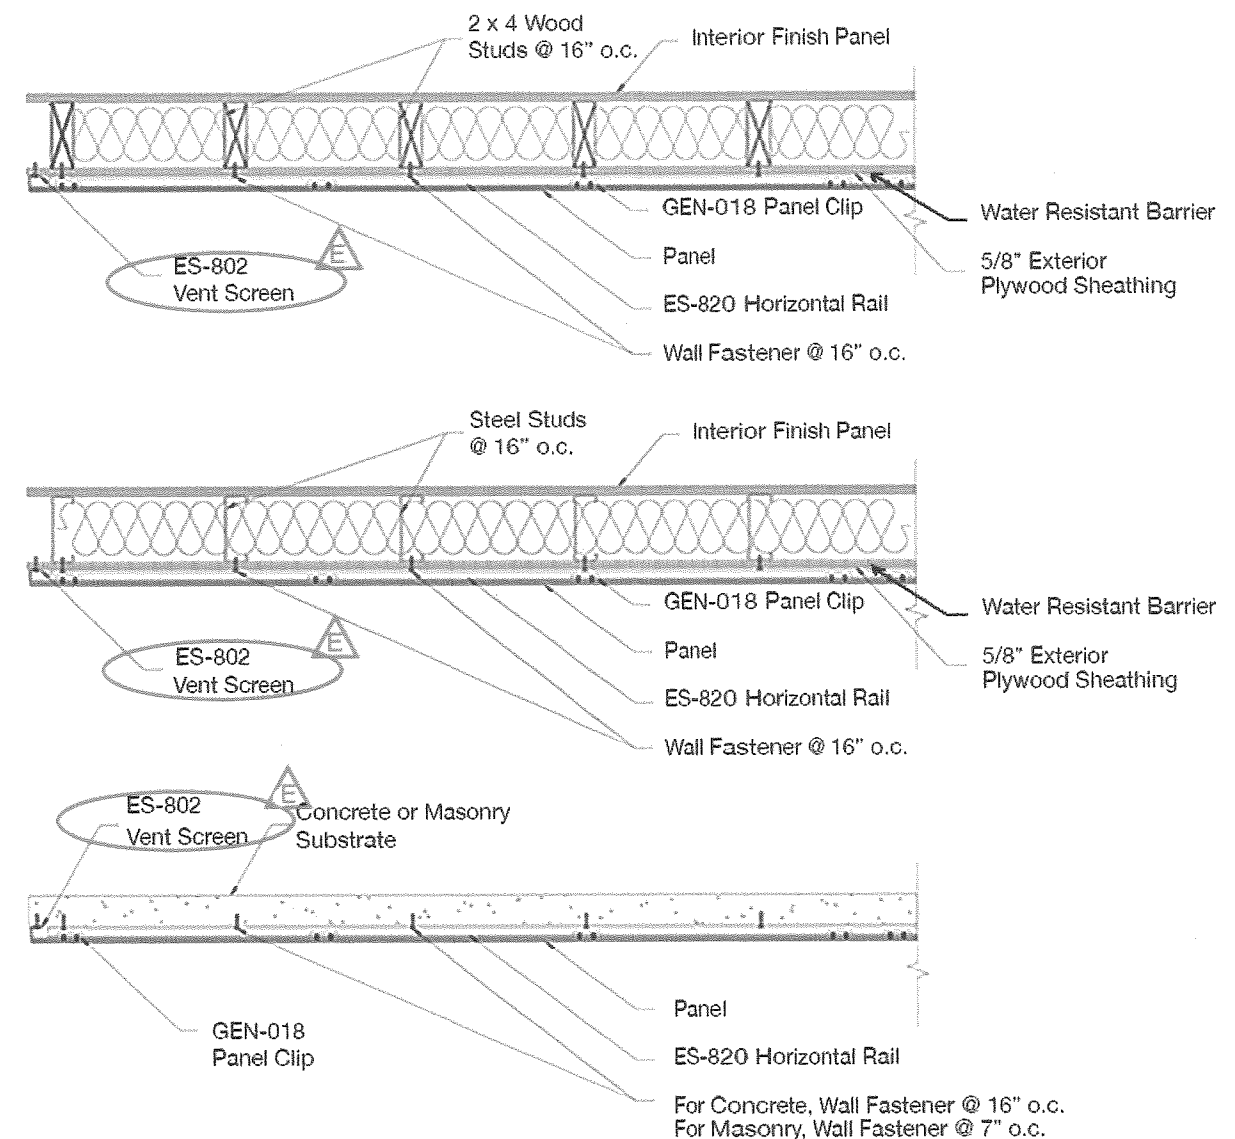


PRODUCT REVISED
as complying with the Florida
Building Code
NOA-No. 23-0525.03
Expiration Date 02/16/2028
By *[Signature]*
Miami-Dade Product Control


| | | |
|--|---------------------|------------------|
| WALL PANEL SYSTEMS, INC. 1815 Rustin Ave, Suite A Riverside, CA 92507 | | SYSTEM ES-500 |
| DESCRIPTION WPS Exterior Systems with Concealed Fasteners ELEVATION & SECTIONS | | |
| DRAWN BY: WPS, INC. | DWG NO. 01-0500 | REV: E |
| SCALE: N.T.S. | DATE: 06/28/2023 | SHEET 5 OF 10 |

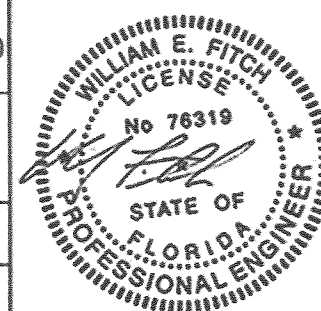


| REVISIONS | | |
|-----------|--------------------------|------------|
| REV. | DESCRIPTION | DATE |
| A | REVISED PER M-D COMMENTS | 2/26/2021 |
| B | REVISED PER M-D COMMENTS | 2/15/2022 |
| C | REVISED PER M-D COMMENTS | 12/13/2022 |

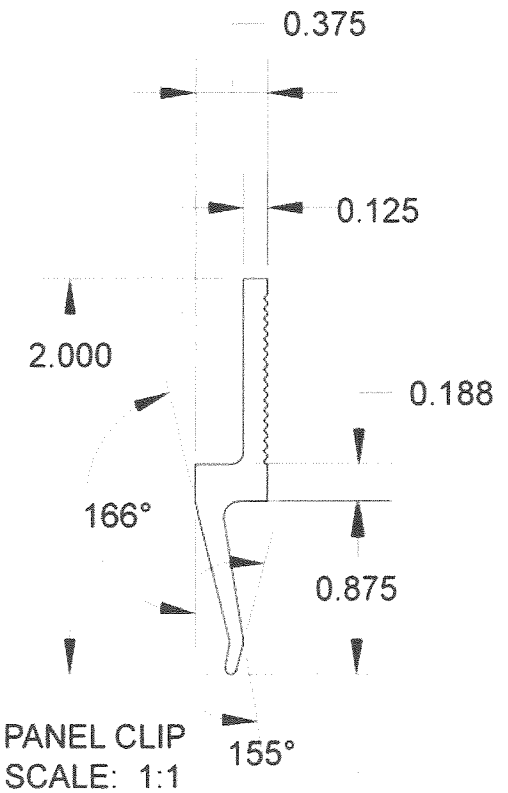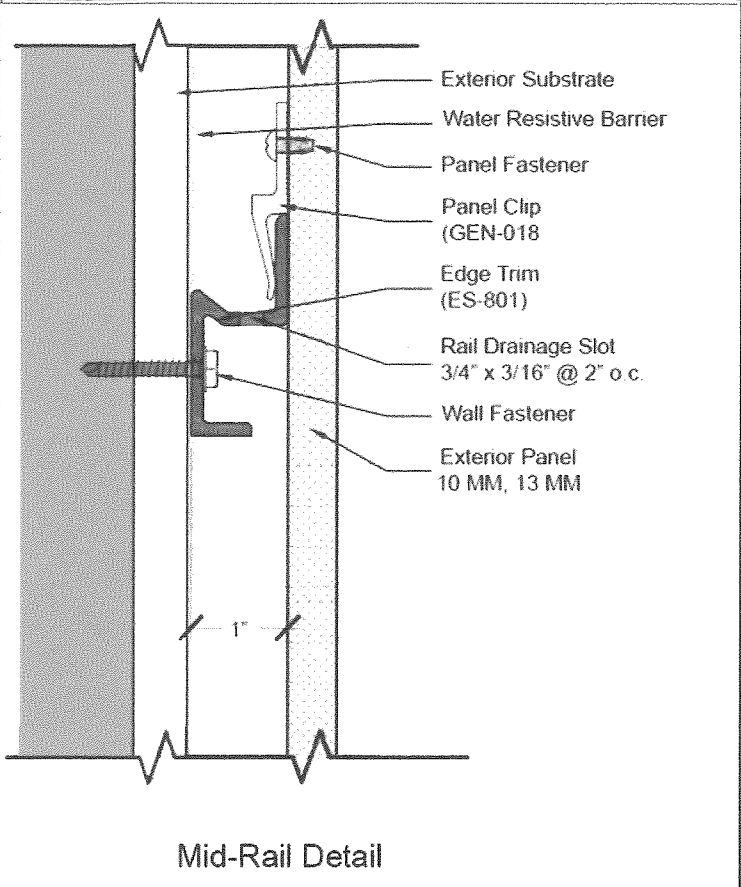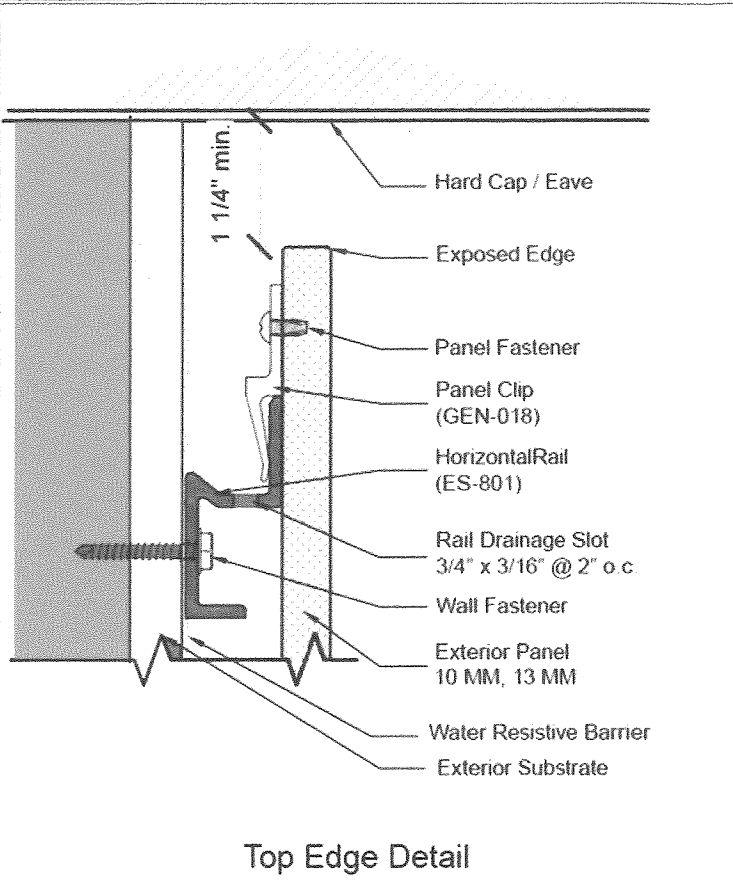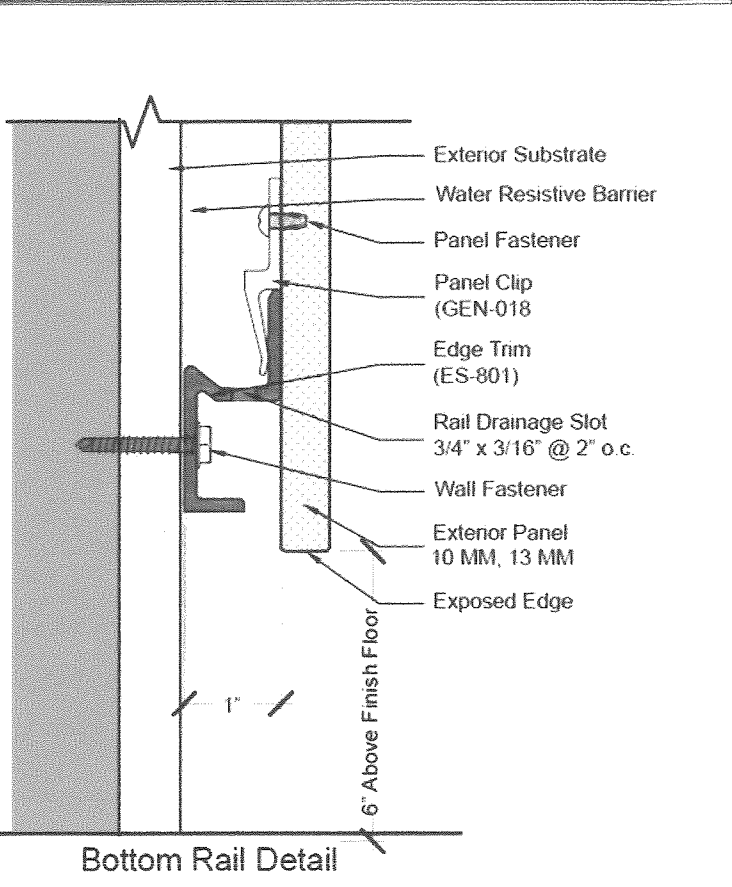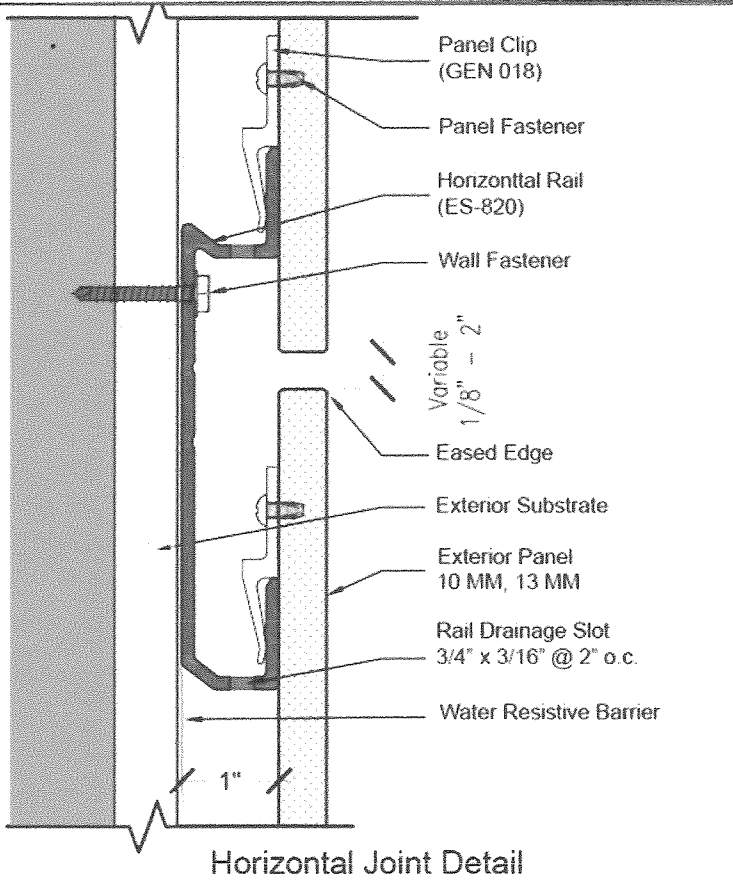


| WALL FASTENER SCHEDULE | | | PANEL FASTENER SCHEDULE | | | |
|------------------------|----------------------------|---------|-------------------------|---------------------|--------|-----------------|
| SUBSTRATE | DESCRIPTION | MANUF. | PANEL THICKNESS | DESCRIPTION | MANUF. | MATERIAL |
| CONCRETE | 1/4" X 1-1/4" TITEN TTN SS | TAPCON | 10 MM | SX3 /15-D12-5, 5x30 | | Stainless Steel |
| MASONRY C 90 | 1/4" X 1-1/4" TITEN TTN SS | TAPCON | | | | |
| STEEL STUD | #12 SELF-DRILLING SCREWS | SIMPSON | 13 MM | SX3 /15-D12-5, 5x30 | | Stainless Steel |
| WOOD STUD | SD-10 X 2-1/2" WOOD SCREWS | SIMPSON | | | | |

PRODUCT REVISED
as complying with the Florida
Building Code
NOA-No. 23-0525.03
Expiration Date 02/16/2028
By 
Miami-Dade Product Control


| | | |
|---|---------------------|------------------|
| WALL PANEL SYSTEMS, INC. 1815 Rustin Ave, Suite A Riverside, CA 92507 | | SYSTEM ES-500 |
| DESCRIPTION WPS EXTERIOR SYSTEM WITH CONCEALED FASTENERS INSTALLATION DETAILS | | |
| DRAWN BY: WPS, INC. | DWG NO. 01-0500 | REV: C |
| SCALE: N.T.S. | DATE: 06/28/2023 | SHEET 6 OF 10 |

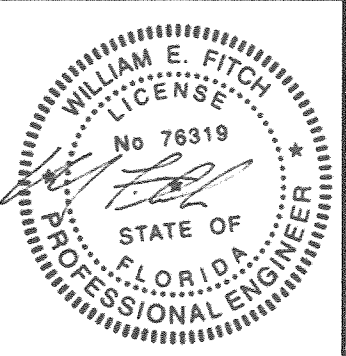


| REVISIONS | | |
|-----------|--------------------------|------------|
| REV. | DESCRIPTION | DATE |
| A | REVISED PER M-D COMMENTS | 2/26/2021 |
| B | REVISED PER M-D COMMENTS | 2/15/2022 |
| C | REVISED PER M-D COMMENTS | 12/13/2022 |

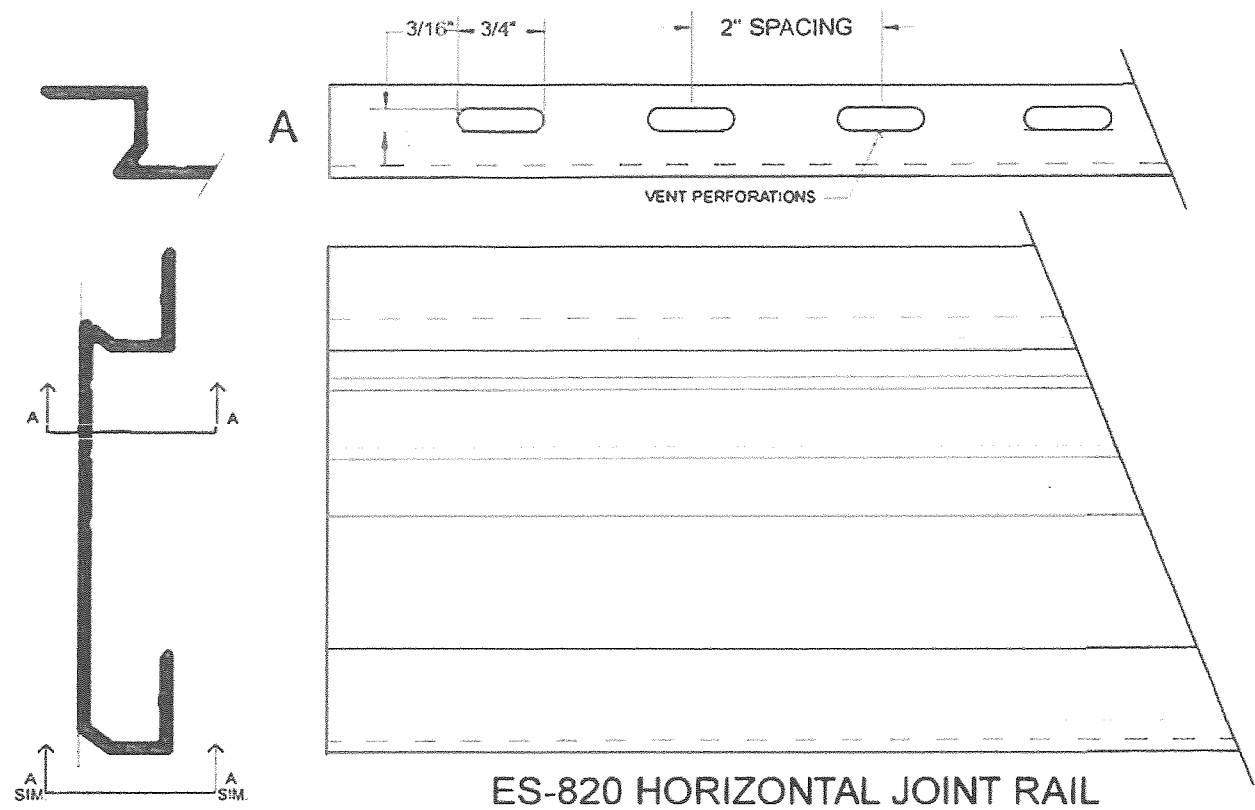


ES-820 HORIZONTAL JOINT RAIL

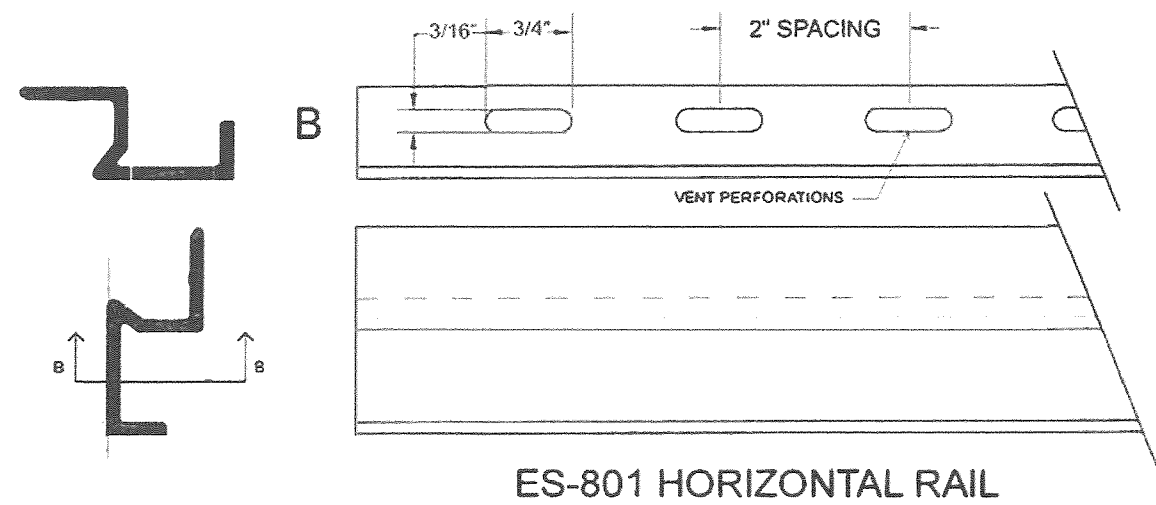


ES-801 HORIZONTAL RAIL

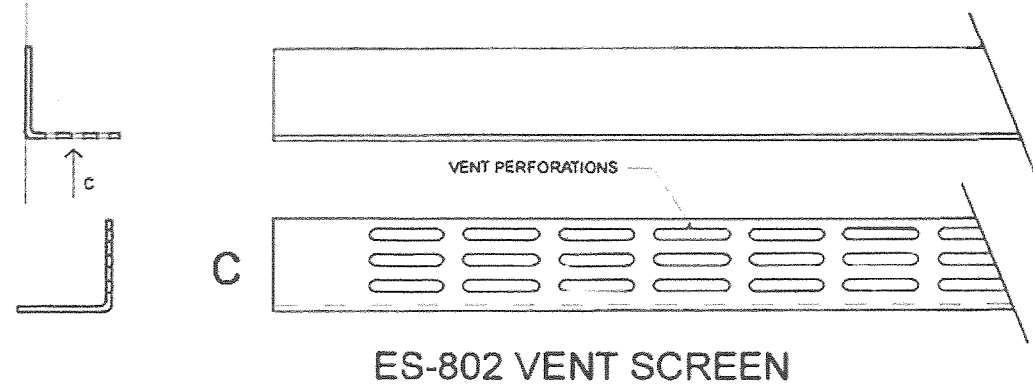


ES-802 VENT SCREEN

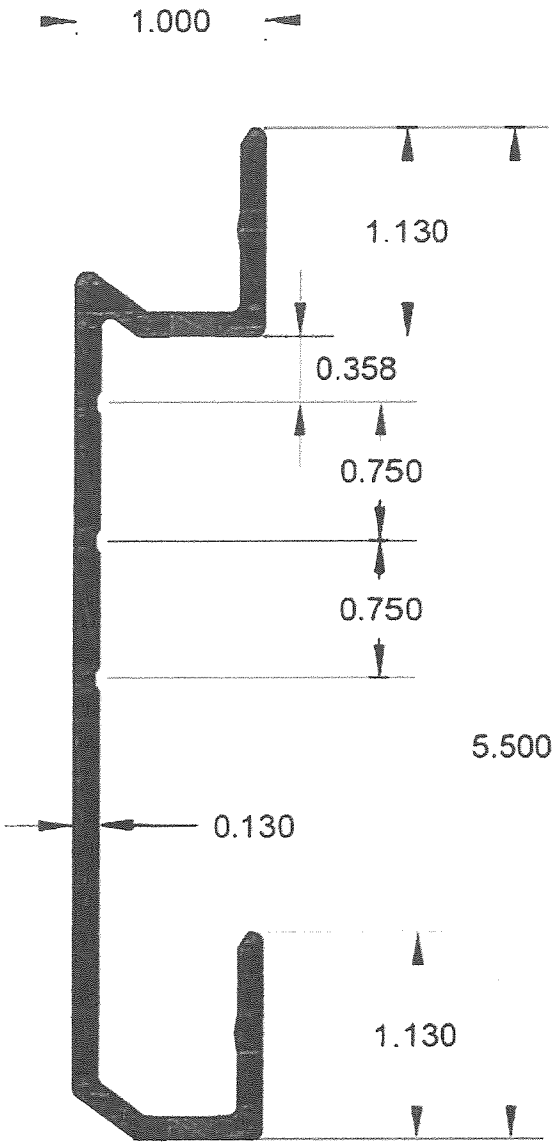

ES-820 HORIZONTAL JOINT RAIL
SCALE: 1:1

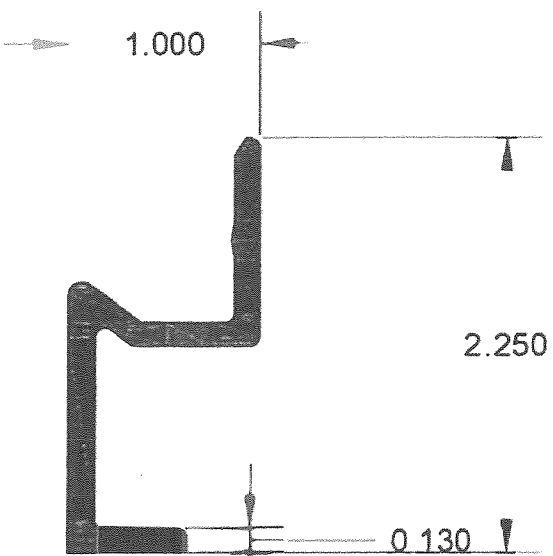


ES-801 HORIZONTAL RAIL
SCALE: 1:1

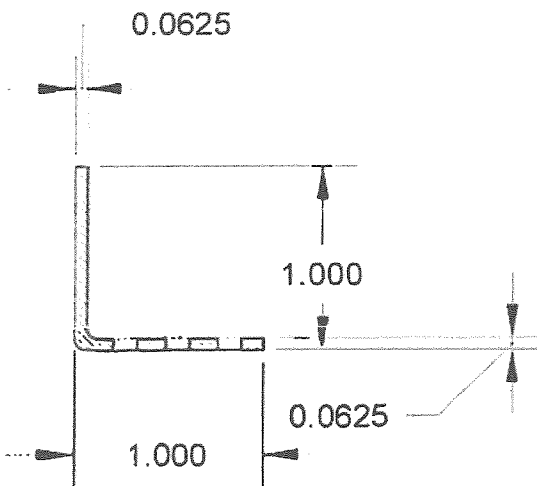


VENT SCREEN
SCALE: 1:1

PRODUCT REVISED
as complying with the Florida
Building Code
NOA-No. 23-0525.03
Expiration Date 02/16/2028
By *[Signature]*
Miami-Dade Product Control


| | | |
|---|---------------------|------------------|
| WALL PANEL SYSTEMS, INC. 1815 Rustin Ave, Suite A Riverside, CA 92507 | | SYSTEM ES-500 |
| DESCRIPTION WPS Exterior Systems with Concealed Fasteners EXTRUSION SPECIFICS Manufactured by: Paramount Extrusions Company | | |
| DRAWN BY: WPS, INC. | DWG NO. 01-0500 | REV: C |
| SCALE: N.T.S. | DATE: 06/28/2023 | SHEET 7 OF 10 |

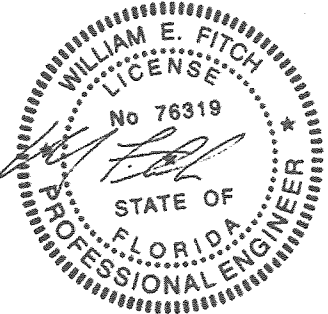

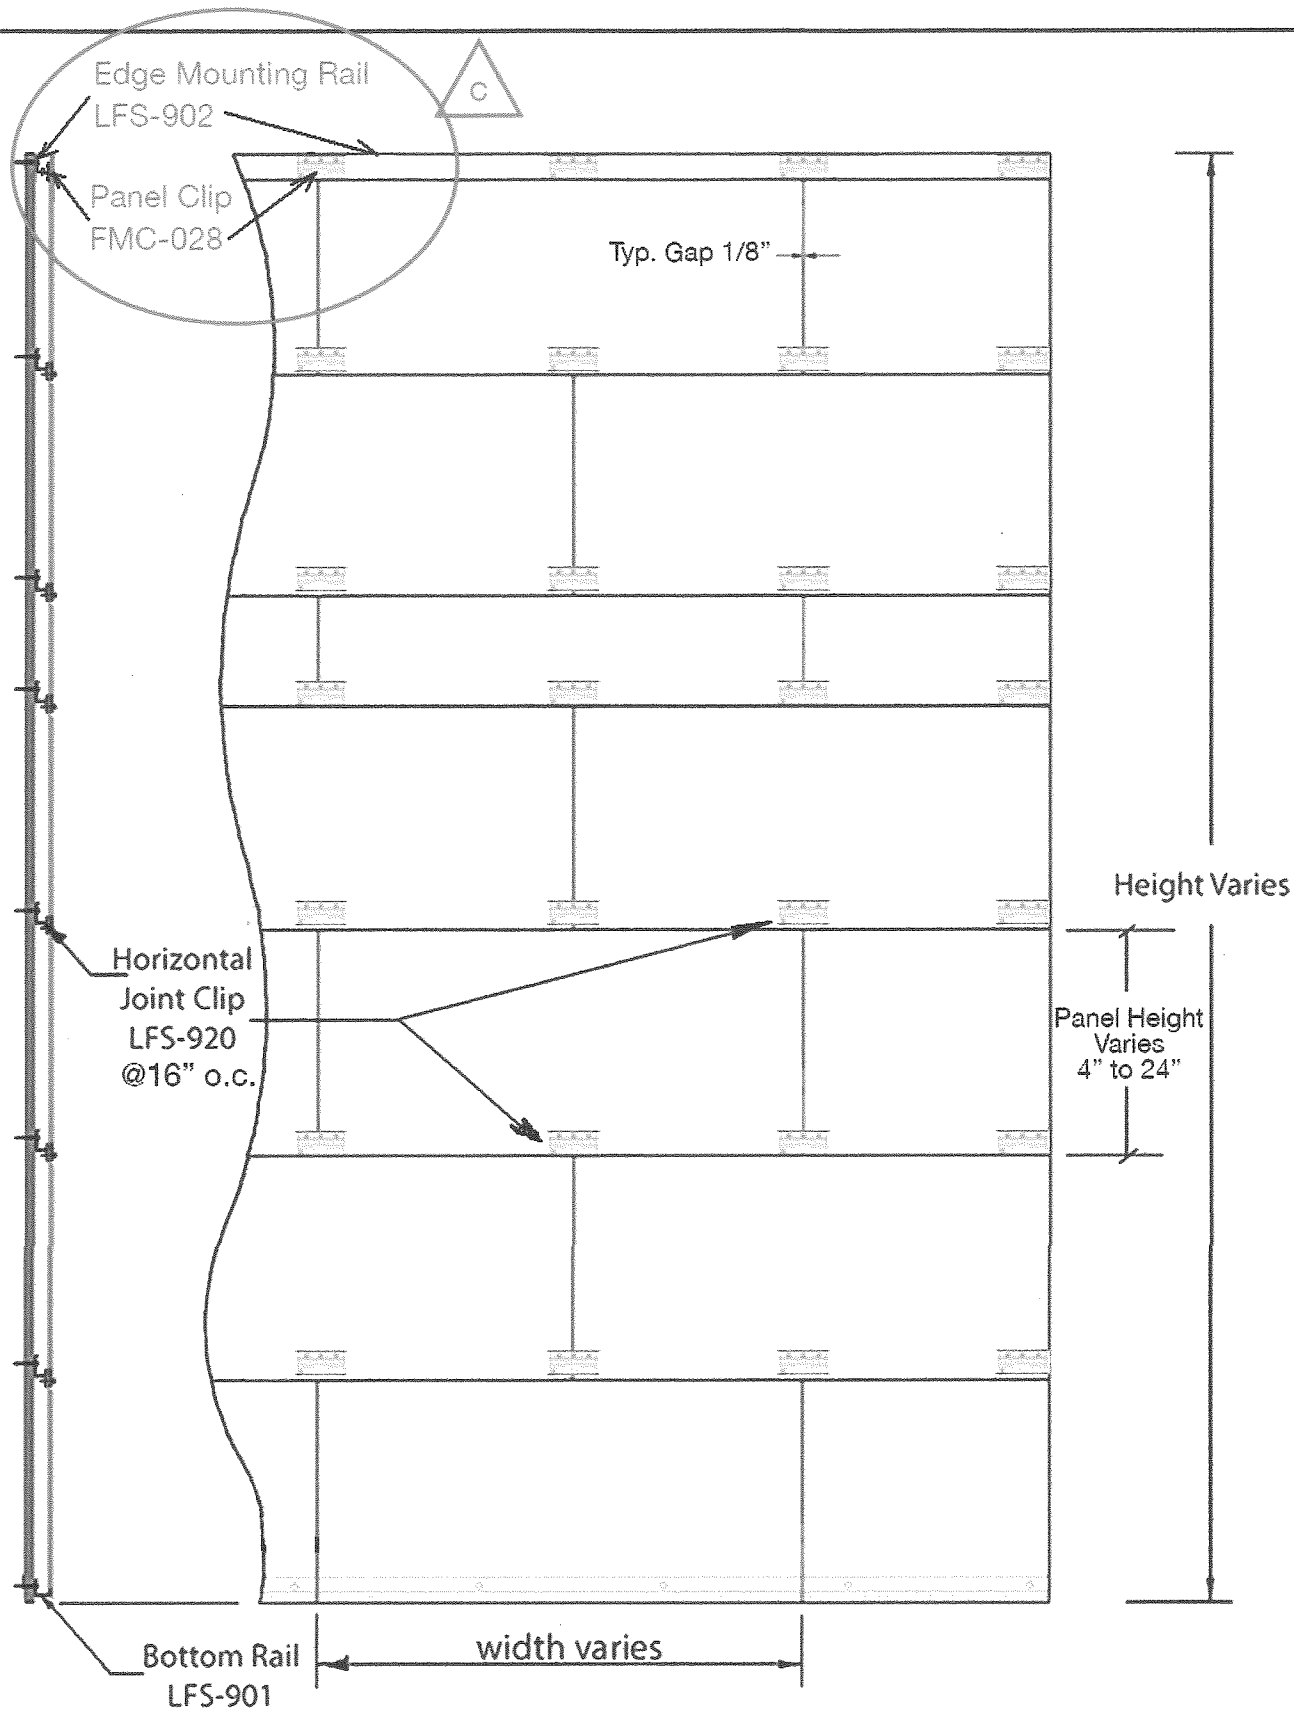


| DESIGN PRESSURE RATING | IMPACT RATING |
|---------------------------------|---|
| 8 mm, 10 mm & 13 mm ± 75 psf | Large and small mille impact when installed over 5/8" plywood sheathing on wood studs @ 16" o.c. per FBC 2322.3 |

| REVISIONS | | |
|-----------|--|------------|
| REV. | DESCRIPTION | DATE |
| A | Revised per M-D Review | 12/13/2022 |
| B | Corrected Top Edge Detail & Removed Vent Screen (not used on siding) | 4/22/2023 |
| C | Added revision designations | 6/28/2023 |




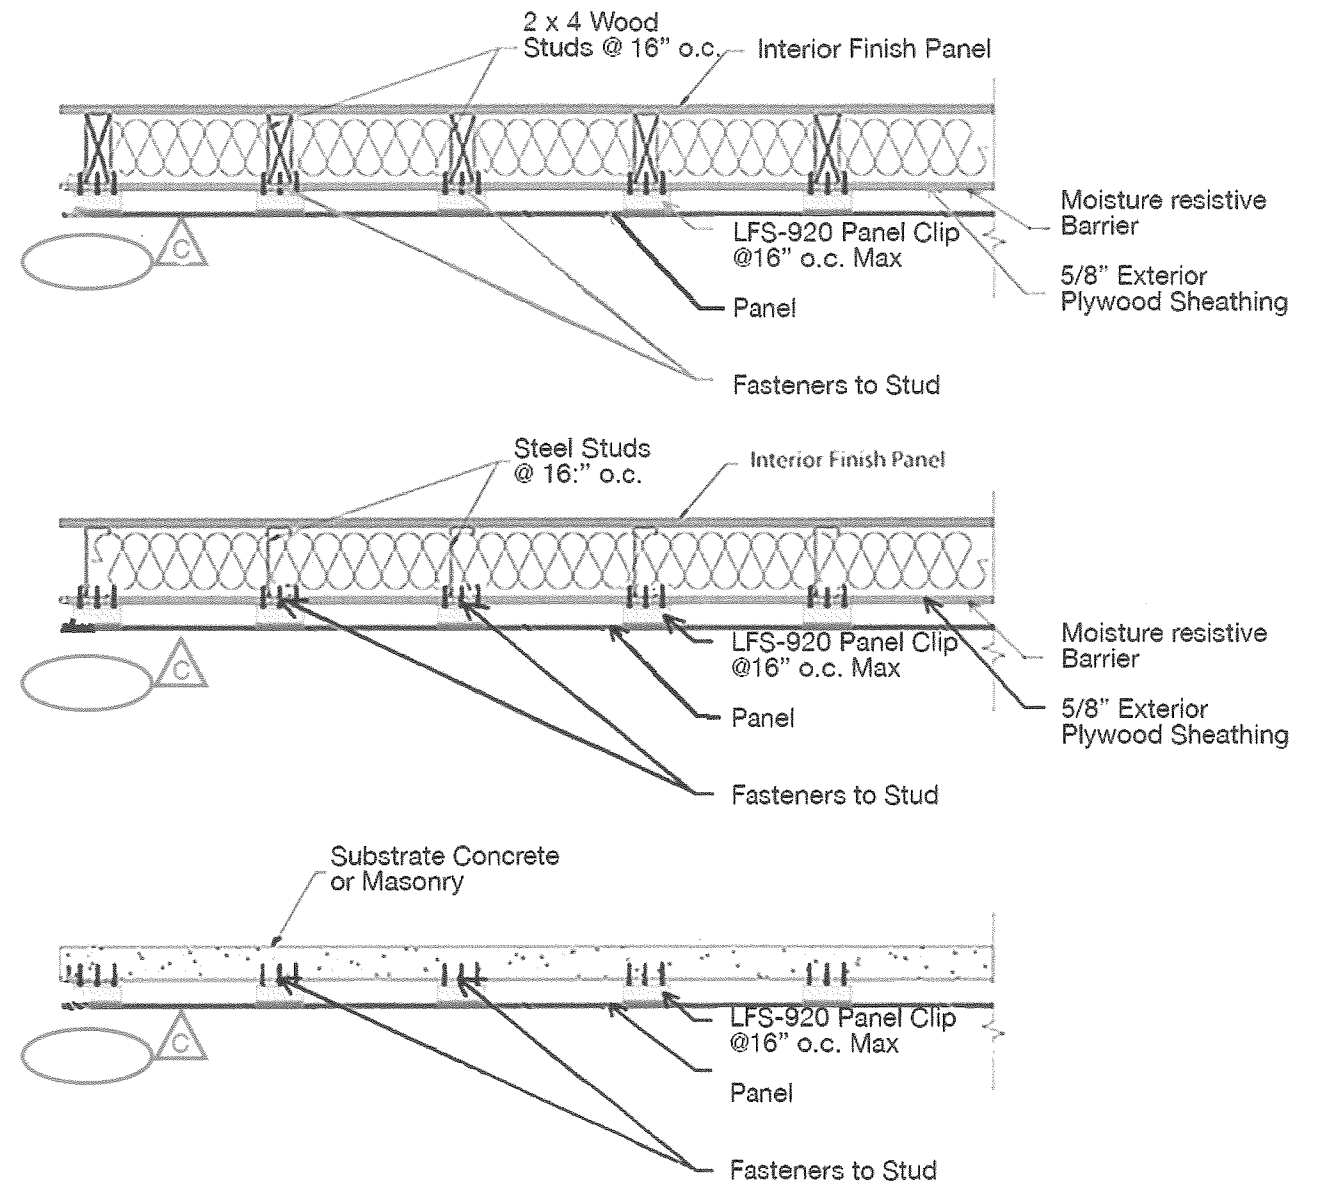


PRODUCT REVISED
as complying with the Florida
Building Code
NOA-No. 23-0525.03
Expiration Date 02/16/2028
By *[Signature]*
Miami-Dade Product Control

| | | |
|---|---------------------|------------------|
| WALL PANEL SYSTEMS, INC. 1815 Rustin Ave, Suite A Riverside, CA 92507 | | SYSTEM HFS |
| DESCRIPTION WPS Horizontal Flush Siding System ELEVATION & SECTIONS | | |
| DRAWN BY: WPS, INC. | DWG NO. 01-HFS | REV: C |
| SCALE: N.T.S. | DATE: 06/28/2023 | SHEET 8 OF 10 |

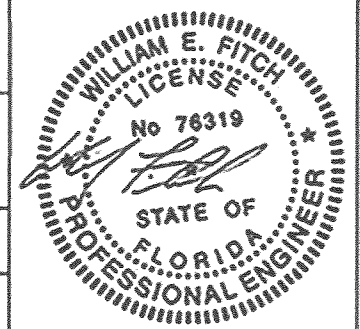

| REVISIONS | | |
|-----------|-----------------------------|------------|
| REV. | DESCRIPTION | DATE |
| A | Revised per M-D Review | 12/13/2022 |
| B | Corrected Top Edge Detail | 4/22/2023 |
| C | Added revision designations | 6/28/2023 |

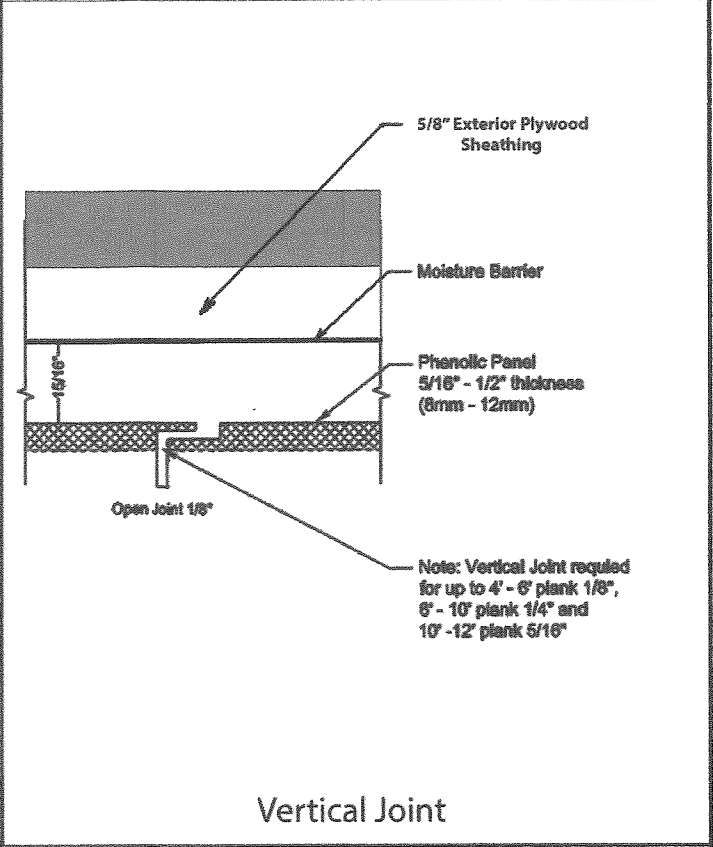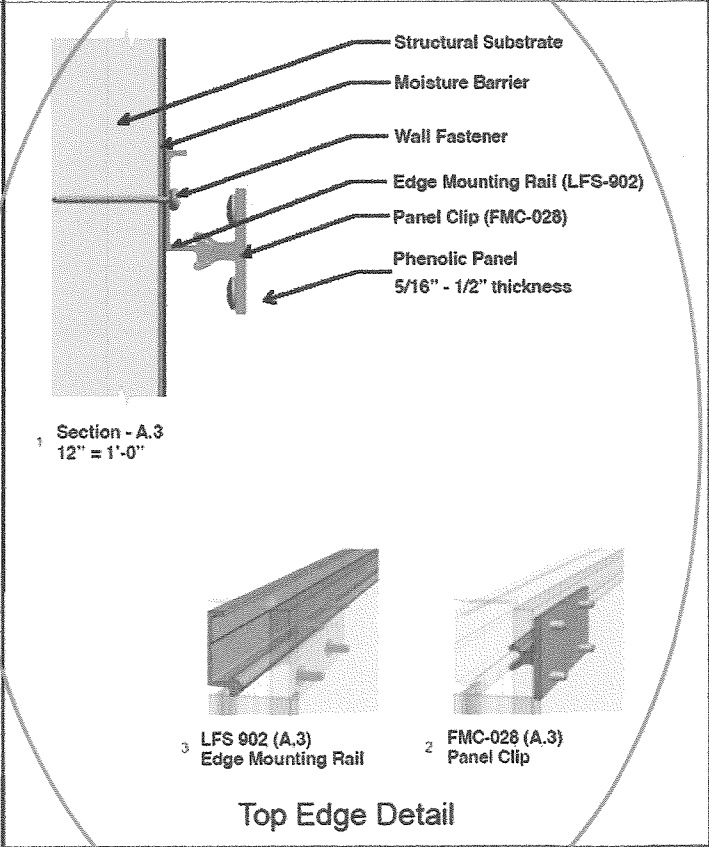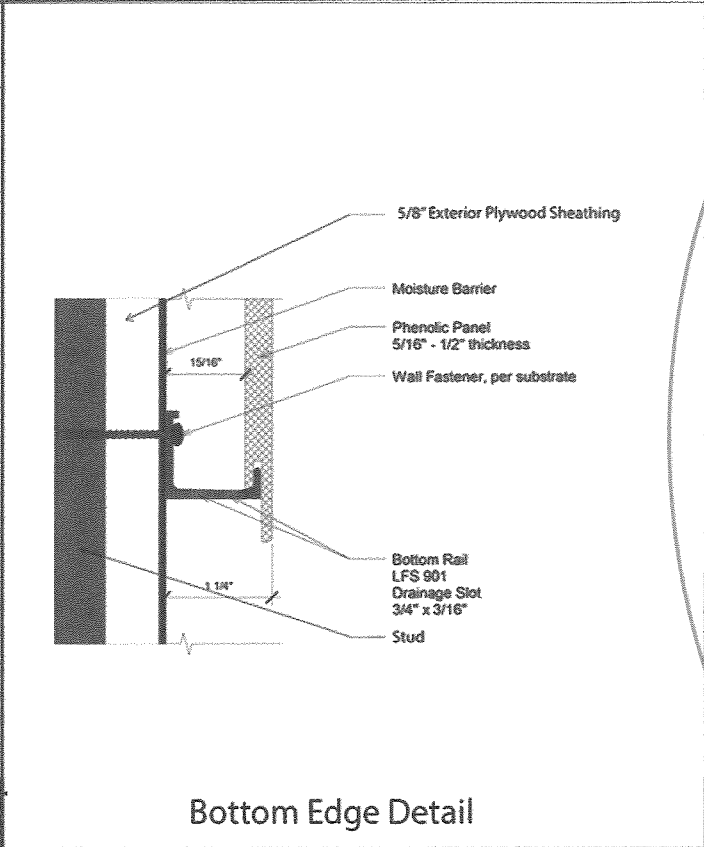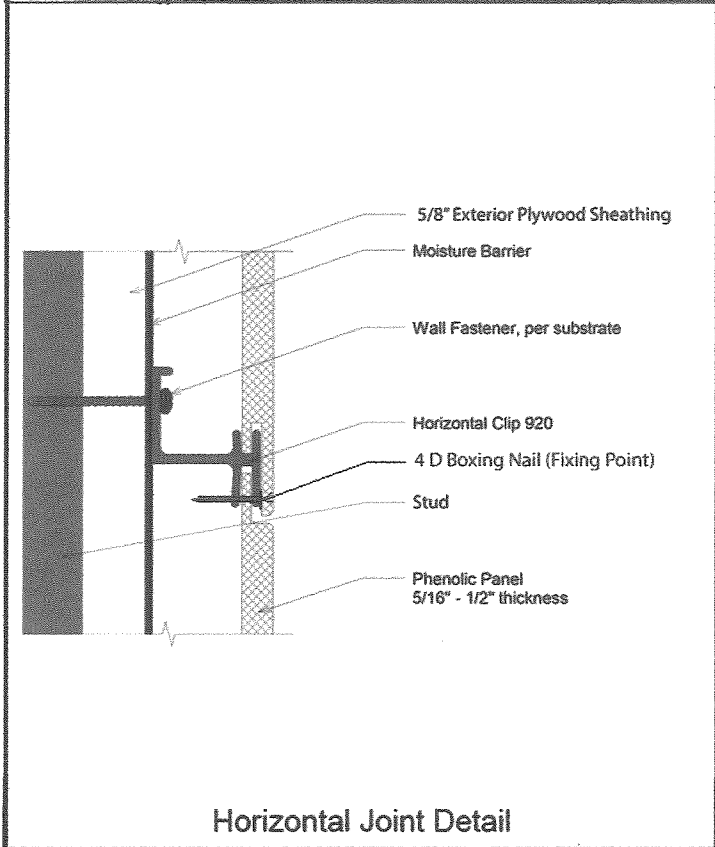


C


| WALL FASTENER SCHEDULE | | |
|------------------------|----------------------------|---------|
| SUBSTRATE | DESCRIPTION | MANUF. |
| CONCRETE | 1/4" X 1-1/4" TITEN TTN SS | TAPCON |
| MASONRY C 90 | 1/4" X 1-1/4" TITEN TTN SS | TAPCON |
| STEEL STUD | #12 SELF-DRILLING SCREWS | SIMPSON |
| WOOD STUD | SD-10 X 2-1/2" WOOD SCREWS | SIMPSON |

PRODUCT REVISED
as complying with the Florida
Building Code
NOA-No. 23-0525.03
Expiration Date 02/16/2028
By *[Signature]*
Miami-Dade Product Control

| | | |
|---|--------------------|------------------|
| WALL PANEL SYSTEMS, INC. 1815 Rustin Ave, Suite A Riverside, CA 92507 | | SYSTEM HFS |
| DESCRIPTION WPS Horizontal Flush Siding System INSTALLATION DETAILS | | |
| DRAWN BY: WPS, INC. | DWG NO. 01-HFS | REV: C |
| SCALE N.T.S. | DATE 06/28/2023 | SHEET 9 OF 10 |

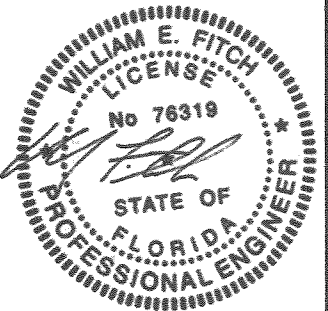


| REVISIONS | | |
|-----------|---|------------|
| REV. | DESCRIPTION | DATE |
| A | Revised per M-D Review | 12/13/2022 |
| B | Added LFS 902 & FMC 028 Removed LFS 905 | 04/22/2023 |
| C | Added revision designations | 06/28/2023 |

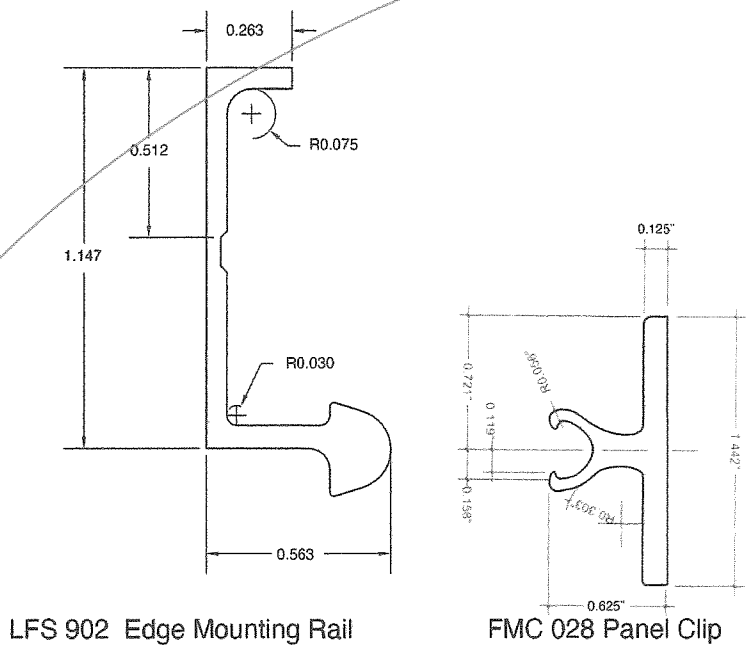


LFS 902 Edge Mounting Rail


FMC 028 Panel Clip

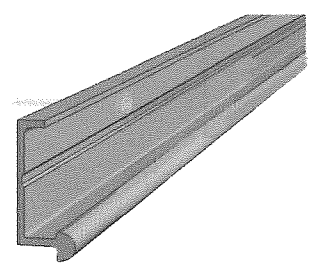


LFS 902
Edge Mounting Rail

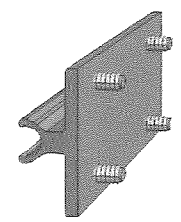


FMC 028
Panel Clip

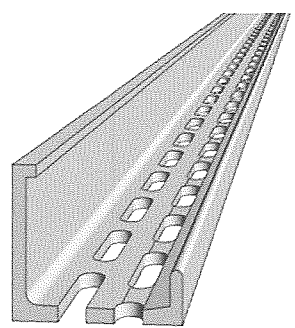


LFS 901 (U)
Bottom Rail with Drainage Slot

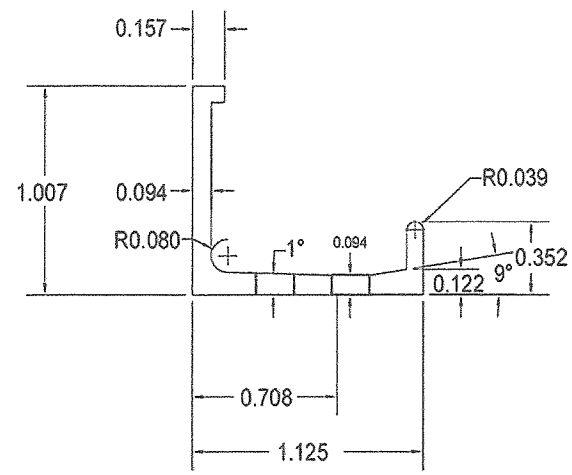


LFS 901 BOTTOM RAIL WITH DRAINAGE SLOT

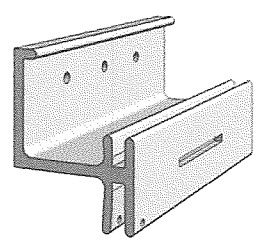


LFS 920 (U)
Horizontal Joint Clip

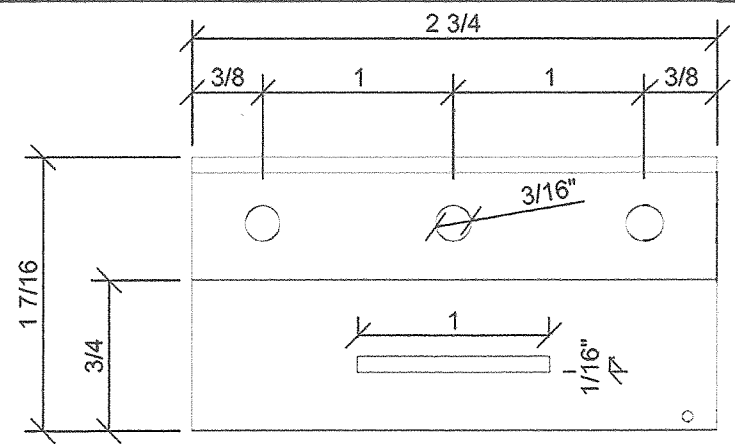

LFS 920 – HORIZONTAL JOINT CLIP

PRODUCT REVISED
as complying with the Florida
Building Code
NOA-No. 23-0525.03
Expiration Date 02/16/2028
By 
Miami-Dade Product Control

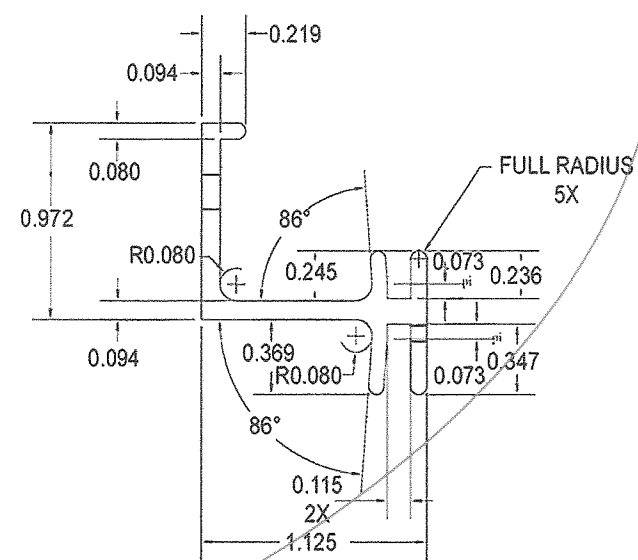

| | | |
|---|----------------------------|--------------------------|
| WALL PANEL SYSTEMS, INC. 1815 Rustin Ave, Suite A Riverside, CA 92507 | | SYSTEM HFS |
| DESCRIPTION WPS Horizontal Flush Siding System EXTRUSION SPECIFICS Manufactured by: Paramount Extrusions Company | | |
| DRAWN BY: WPS, INC. | DWG NO. 01-HFS | REV: C |
| SCALE: N.T.S. | DATE: 06/28/2023 | SHEET 10 OF 10 |

