



DEPARTMENT OF REGULATORY AND ECONOMIC RESOURCES (RER)
BOARD AND CODE ADMINISTRATION DIVISION

NOTICE OF ACCEPTANCE (NOA)

MIAMI-DADE COUNTY
PRODUCT CONTROL SECTION

11805 SW 26 Street, Room 208
Miami, Florida 33175-2474
T (786) 315-2590 F (786) 315-2599

www.miamidade.gov/economy

Wayne Dalton a Div. of Overhead Door Corporation
3395 Addison Drive
Pensacola, FL 32514

SCOPE:

This NOA is being issued under the applicable rules and regulations governing the use of construction materials. The documentation submitted has been reviewed and accepted by Miami-Dade County RER-Product Control Section to be used in Miami-Dade County and other areas, where allowed by the Authority Having Jurisdiction (AHJ).

This NOA shall not be valid after the expiration date stated below. The Miami-Dade County Product Control Section (In Miami-Dade County) and/ or the AHJ (in areas other than Miami-Dade County) reserve the right to have this product or material tested for quality assurance purposes. If this product or material fails to perform in the accepted manner, the manufacturer will incur the expense of such testing and the AHJ may immediately revoke, modify, or suspend the use of such product or material within their jurisdiction. RER reserves the right to revoke this acceptance if it is determined by Miami-Dade County Product Control Section that this product or material fails to meet the requirements of the applicable building code.

This product is approved as described herein and has been designed to comply with the Florida Building Code, including the High Velocity Hurricane Zone.

DESCRIPTION: Models C20 and C24 Code 2501 Steel Sectional Garage Door up to 14ft.-2in. Wide with Optional EPS Insulation and Impact Resistant Glazing

APPROVAL DOCUMENT: Drawing No. **361778**, titled "Windload Commercial Sectional Steel Door, C20 and C24, +50/-56PSF Dade County, 14'2" Max. Width", sheets 1 through 4 of 4, dated 04/23/2018, with revision **P01** dated 07/19/2018, prepared by Wayne Dalton a Div. of Overhead Door Corporation, signed and sealed by Dwayne J. Kornish, P.E., bearing the Miami-Dade County Product Control revision stamp with the NOA number and expiration date by the Miami-Dade County Product Control Section.

MISSILE IMPACT RATING: Large & Small Missile Impact Resistant

LABELING: A permanent label with the manufacturer's name or logo, manufacturing address, model/ series number, the positive and negative design pressure rating, indicate impact rated if applicable, installation instruction drawing reference number, approval number (NOA), the applicable test standards, and the statement reading 'Miami-Dade County Product Control Approved' is to be located on the door's sidetrack, bottom angle, or inner surface of a panel.

RENEWAL of this NOA shall be considered after a renewal application has been filed and there has been no change in the applicable building code negatively affecting the performance of this product.

TERMINATION of this NOA will occur after the expiration date or if there has been a revision or change in the materials, use, and/ or manufacture of the product or process. Misuse of this NOA as an endorsement of any product, for sales, advertising or any other purposes shall automatically terminate this NOA. Failure to comply with any section of this NOA shall be cause for termination and removal of NOA.

ADVERTISEMENT: The NOA number preceded by the words Miami-Dade County, Florida, and followed by the expiration date may be displayed in advertising literature. If any portion of the NOA is displayed, then it shall be done in its entirety.

INSPECTION: A copy of this entire NOA shall be provided to the user by the manufacturer or its distributors and shall be available for inspection at the job site at the request of the Building Official.

This NOA **renews** and **revises** **NOA # 20-1106.09** and consists of this page 1, evidence pages E-1 and E-2, as well as approval document mentioned above.

The submitted documentation was reviewed by **Carlos M. Utrera, P.E.**



NOA-No: 23-1013.06
Expiration Date: November 01, 2028
Approval Date: November 22, 2023
Page 1

Wayne Dalton a Div. of Overhead Door Corporation

NOTICE OF ACCEPTANCE: EVIDENCE SUBMITTED

1. EVIDENCE SUBMITTED UNDER NOA #'s 18-0122.03

A. DRAWINGS

1. Drawing No. **361778**, titled "Windload Commercial Sectional Steel Door, C20 and C24, +50/-56PSF Dade County, 14'2" Max. Width", sheets 1 through 4 of 4, dated 04/23/2018, with revision **P01** dated 07/19/2018, prepared by Wayne Dalton a Div. of Overhead Door Corporation, signed and sealed by Dwayne J. Kornish, P.E.

B. TESTS

1. Test reports on 1) Uniform Static Air Pressure Test, Loading per FBC TAS 202-94
2) Large Missile Impact Test per FBC, TAS 201-94
3) Cyclic Wind Pressure Loading per FBC, TAS 203-94
4) Forced Entry Test, per FBC, TAS 202-94
5) Tensile Test per ASTM E8
along with marked-up drawings of a 14'-2" Wide Models C20 and C24 Steel Sectional Doors, prepared by Intertek, Test Report No. **G6343.01-801-18-R2**, dated 10/24/2017, with revision dated 07/28/2018, signed and sealed by Tyler Westerling, P.E.
2. Test report on salt spray exposure, per ASTM B117-16 on G40 and G90 coupons, prepared by Intertek, Report No. **I1314.01-106-18R0**, dated 05/11/2018, signed by Gary T. Hartman.

C. CALCULATIONS

1. Anchorage verification calculations prepared by Wayne Dalton a Div. of Overhead Door Engineering, dated 07/18/2018, signed and sealed by Dwayne J. Kornish, P.E.

D. MATERIAL CERTIFICATIONS

1. Test report on the EPS Insulation, D.F. Self-Ignition Temperature per ASTM D1929-2016, Test Report # **103445527MID-002**, prepared by Intertek, dated 03/23/2017, signed by Bryan Bowman.
2. UL evaluation report on Styropek EPS insulations' Surface Burning Characteristics (Flame Spread and Smoke Density Index) per ANSI/UL723 (ASTM E84), prepared by UL Inc., Test Report # **UL ER38219-01** and dated 04/08/2015.
3. Notice of Acceptance No. **17-0410.01**, issued to Covestro, LLC, for their Makrolon Polycarbonate Sheets, approved on 06/08/2017 and expiring on 08/27/2022.

E. QUALITY ASSURANCE

1. Miami-Dade Department of Regulatory and Economic Resources (RER).

F. STATEMENTS

1. Statement letter of code conformance to the 6th edition (2017) FBC issued by Overhead Door Corporation, dated 09/12/2018, signed and sealed by Dwayne J. Kornish, P.E.
2. No financial interest letter issued by Overhead Door Corporation, dated 09/12/2018, signed and sealed by Dwayne J. Kornish, P.E.



Carlos M. Utrera, P.E.
Product Control Examiner

NOA-No: 23-1013.06

Expiration Date: November 01, 2028

Approval Date: November 22, 2023

Wayne Dalton a Div. of Overhead Door Corporation

NOTICE OF ACCEPTANCE: EVIDENCE SUBMITTED

2. EVIDENCE SUBMITTED UNDER NOA # 20-1106.09 AND NEW

A. DRAWINGS

1. None.

B. TESTS

1. None.

C. CALCULATIONS

1. None.

D. QUALITY ASSURANCE

1. Miami-Dade Department of Regulatory and Economic Resources (RER).

E. MATERIAL CERTIFICATIONS

1. Test report on flame spread and smoke developed of BASF polyurethane foam per ASTM E84, Test Report # RJ7233F-1, dated 10/14/2019, prepared by QAI Laboratories, Inc. and signed by Brian Ortega.
2. Test report on ignition temperature of BASF polyurethane foam per ASTM D1929, Test Report # 10399361SAT-4, dated 10/14/2019, prepared by Intertek Building & Construction (B&C), signed by Servando Romo.
3. Notice of Acceptance No. **22-0317.02**, issued to Plaskolite, LLC, for their TUFFAK Polycarbonate Sheets, approved on 04/21/2022 and expiring on 08/27/2027.

F. STATEMENTS

1. Statement letter of code conformance to the 8th edition (2023) of the FBC, issued by Wayne Dalton a Div. of Overhead Door Corporation, dated 09/29/2023, signed and sealed by Dwayne J. Kornish P.E.
2. Statement letter of code conformance to the 7th edition (2020) of the FBC, issued by Wayne Dalton a Div. of Overhead Door Corporation, dated 01/21/2021, signed and sealed by Dwayne J. Kornish P.E.



Carlos M. Utrera, P.E.
Product Control Examiner

NOA-No: 23-1013.06

Expiration Date: November 01, 2028

Approval Date: November 22, 2023

NOTES: (UNLESS OTHERWISE SPECIFIED)


1. RATED DESIGN LOAD +50/-56 PSF.
2. SECTION HEIGHTS MAY VARY TO CREATE VARIOUS DOOR HEIGHTS, 24" MAXIMUM SECTION HEIGHT.
3. MINIMUM 1" OVERLAP ON BOTH JAMBS REQUIRED TO MEET NEGATIVE DESIGN PRESSURES.
4. TESTED IN ACCORDANCE WITH DADE COUNTY PROTOCOLS TAS 201-94, TAS 202-94, & TAS 203-94.
5. DOOR SKIN MUST BE 50,000 PSI MIN. YIELD STRENGTH.
6. JAMB LOAD CALCULATIONS:
 $F = (1/2 \text{ DOOR WIDTH})(1 \text{ FT OF HEIGHT})(\text{DESIGN PRESSURE})$
 $F = (7.067)(1 \text{ FOOT})(50.00 \text{ AND } -56.00)(353.4/-395.8) \text{ LB.}$
7. JAMB FASTENER REQUIREMENTS:
 $F = (1/2 \text{ DOOR WIDTH})(1 \text{ FT OF HEIGHT})(\text{DESIGN PRESSURE})$
 $F = 354 \text{ LBS.}$
8. DOOR SKIN MATERIAL SHALL BE GALVANIZED ACCORDING TO ASTM A-525 TO G40 MIN, WITH BAKED-ON PRIMER, AND BAKED-ON POLYESTER PAINT TOP COAT.
9. FOR ANCHORING INTO WOOD, USE ONE 5/16" LAG SCREW PER TRACK CLIP WITH 1-1/2" EMBEDMENT INTO SOUTHERN PINE (G=0.55) OR BETTER.
10. APPROVED INSULATED AND NON-INSULATED: C-24 (24 GA), C-20 (20 GA).
11. WELD SLOT ON ANGLE AND 3/32" X 1" LONG ON 12" CENTERS. "IF WELDING MOUNTING OPTION IS CHOSEN."
12. LIFT UP MECHANISM-MANUAL, CHAIN LIFT, OR OPERATOR IS NOT PART OF THIS APPROVAL.
13. STANDARD LIFT, HIGH LIFT, VERTICAL LIFT, AND LOW HEADROOM TRACK IS AVAILABLE. FOR LOW HEADROOM LIFT CONDITIONS TOP BRACKET SHALL BE 13 GA LHR 7/4 TOP BRACKET WITH A MIN OF (3) 1/4 - 14 X 7/8" SELF DRILLING CRIMPTITE SCREWS IN LIEU OF THE BRACKET SHOWN ON DRAWING. U-BAR ON TOP SECTION SHALL BE INSTALLED ON TOP OF LHR TOP BRACKETS.
14. ATTACH STRUTS WITH (4) 1/4-14x7/8" SELF DRILLING CRIMPTITE SCREWS AT ALL STILE LOCATIONS, TYP. LOCATED WITHIN 6", +/- 3" FROM TOP OF SECTION.
15. KEY LOCK, SIDE LOCK, OR OPERATOR REQUIRED.
16. EXHAUST PORTS- OPTIONAL UP TO 6 PER BOTTOM SECTION.
17. IMPACT RESISTANT GLAZING OPTION- IMPACT RESISTANT GLAZING SYSTEM MAY BE INSTALLED INTERMEDIATE SECTION ONLY. GLAZING SHALL BE 1/4" POLYCARBONATE, 13-3/4" X 20-1/8" MAXIMUM SIZE, FASTENED WITH # 8 X 1" SMS: 3X MAX ALONG THE HORIZONTAL AND 2X MAX ALONG THE VERTICAL. SEE DETAIL F-F ON SHEET 2 FOR ASSEMBLY DETAILS.
18. THE DESIGN OF THE SUPPORTING STRUCTURAL ELEMENTS SHALL BE THE RESPONSIBILITY OF THE PROFESSIONAL OF RECORD FOR THE BUILDING OR STRUCTURE AND IN ACCORDANCE WITH CURRENT BUILDING CODES FOR THE LOADS LISTED ON THIS DRAWING.

PRODUCT REVISED
as complying with the Florida
Building Code
NOA-No. 23-1013.06

Expiration Date 11/01/2028

By *[Signature]*
Miami-Dade Product Control

REVISIONS				
ER	REV	DESCRIPTION	DATE	APVL
ER 31715	P01	NEW DRAWING	7/19/18	ESC

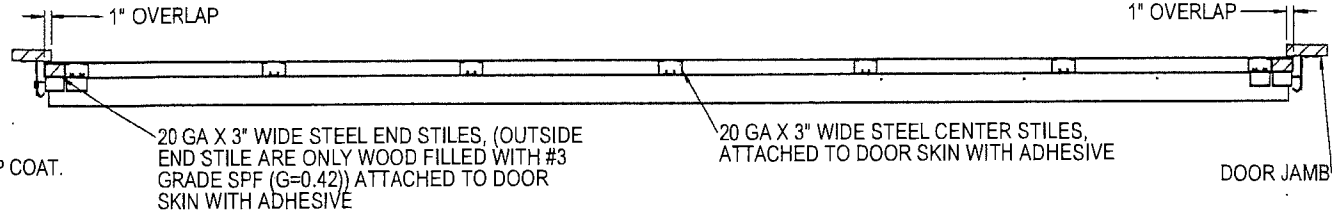

PRODUCT REVISED
as complying with the Florida
Building Code
NOA-No. 20-1106.09

Expiration Date 11/01/2023


By *[Signature]*
Miami-Dade Product Control

SECTION B-B
SCALE 1 : 12


PRODUCT APPROVED
as complying with the Florida
Building Code
NOA-No. 18-0122.03

Approval Date 11/01/2018

By *[Signature]*
Miami-Dade Product Control

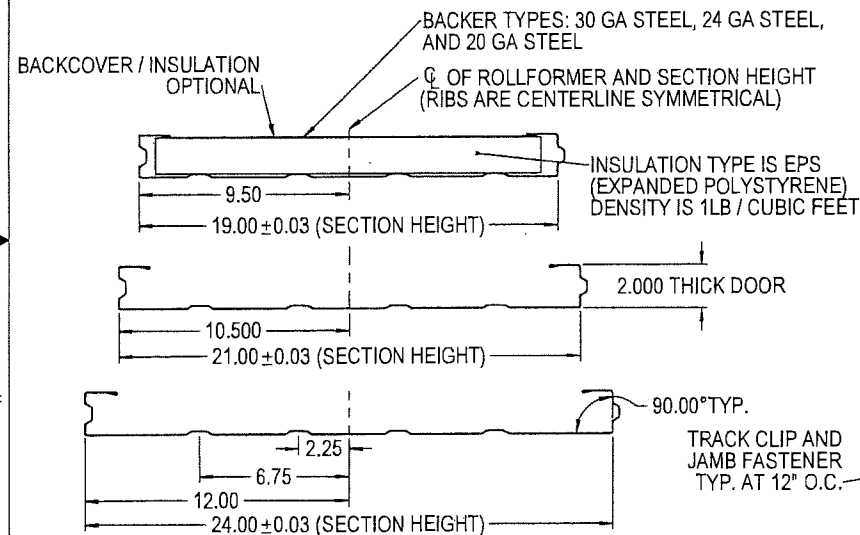


SECTION A-A
SCALE 1 : 4

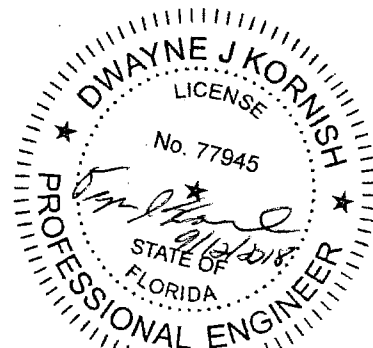


DWAYNE J. KORNISH, PE
4576 COUNTY ROAD 160
MOUNT HOPE, OHIO
FL PE 77945 TX PE 117868

PROFESSIONAL ENGINEER'S SEAL PROVIDED ONLY FOR
VERIFICATION OF WINDLOAD CONSTRUCTION DETAILS.

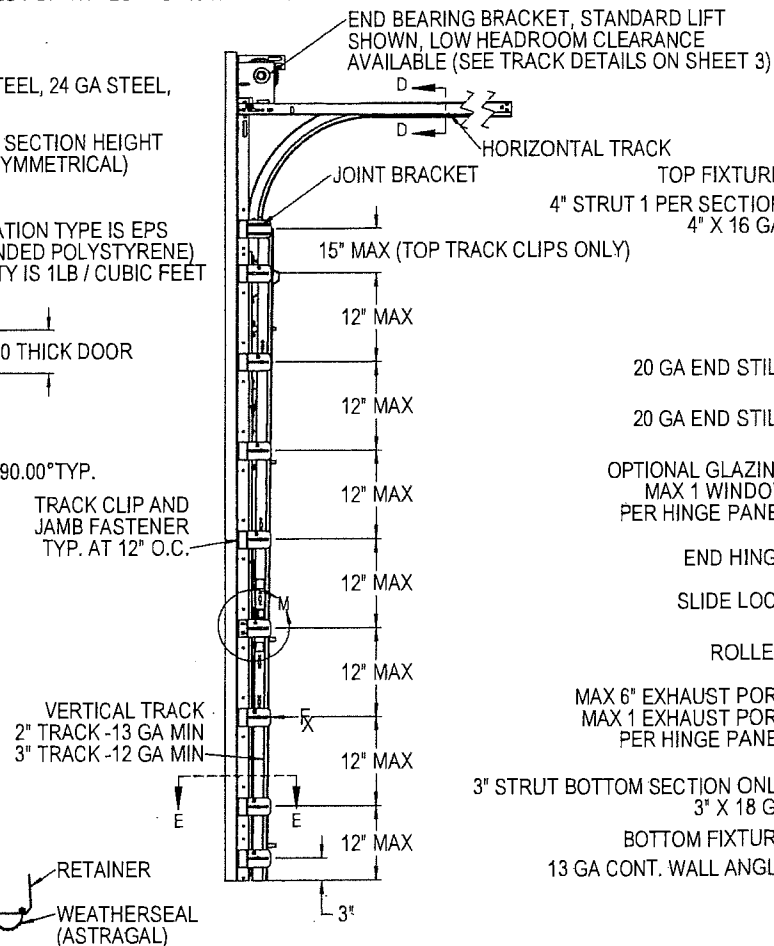



SECTION C-C
SCALE 1:4

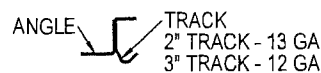


SECTION D-D
SCALE 1:4

DOOR WIDTH	NUMBER OF CENTER STILES
10'-3\" - 12'-2\"	4
12'-3\" - 14'-2\"	5

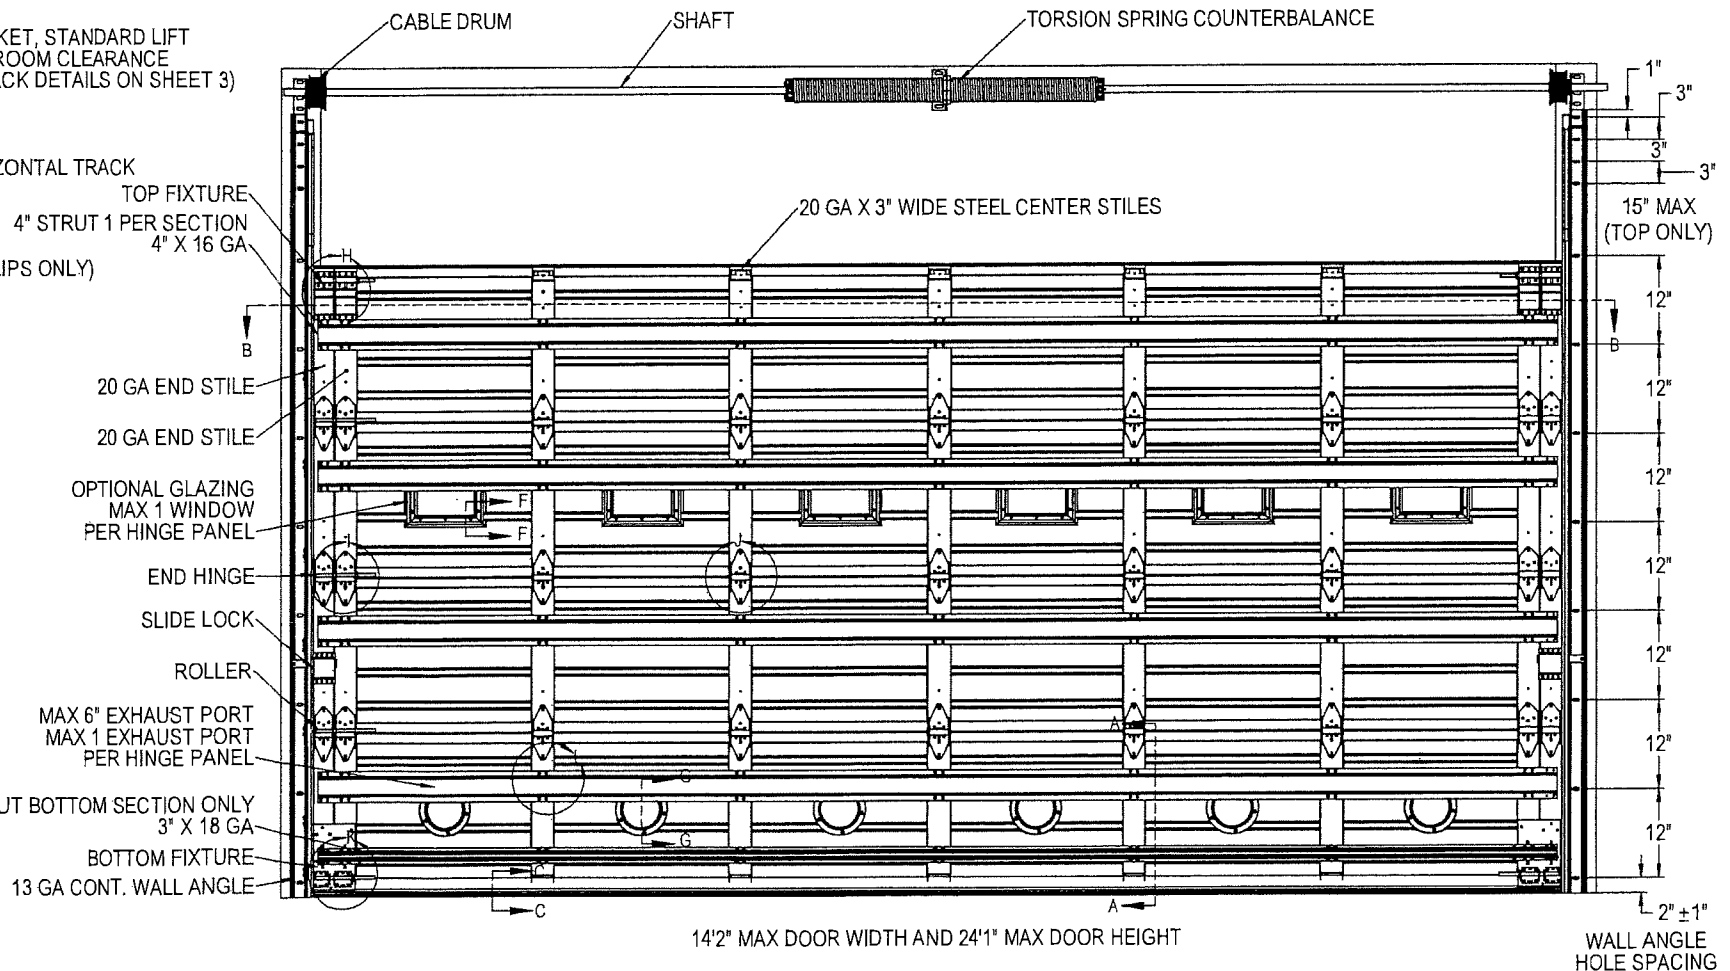
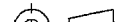
<div>THIRD ANGLE PROJECTION</div> 		UNLESS OTHERWISE SPECIFIED		APPROVALS		DATE	<div><div>Wayne Dalton</div><div>GARAGE DOORS</div></div> PENSACOLA, FLORIDA				
				DRAWN	E. CONRAD	4/23/18					
<div>A DIVISION OF OVERHEAD DOOR CORP</div> <div>3395 ADDISON DRIVE</div> <div>PENSACOLA, FLORIDA 32514</div> <div>(850)-474-9890</div>		<div>INTERPRET DIMS & TOLS</div> <div>PER ASME Y14.5M</div> <div>ALL DIMS ARE IN INCHES</div> <div>DO NOT SCALE</div> <div>DIMS CIRCLED WITH SYMBOL 'C' ARE CRITICAL TO QUALITY DESIGN</div> <div>FEATURES & MUST MEET APPLICABLE IN-PROCESS INSPECTION STANDARDS.</div>		TOLERANCES:		CHECKED	D. KORNISH	-	<div>DESCRIPTION</div> <div>WINDLOAD COMMERCIAL SECTIONAL STEEL DOOR, C20 AND C24, +50/-56PSF</div> <div>DADE COUNTY, 14'2" MAX WIDTH</div>		
				X = ± .1		APPROVED	-	-			
				XX = ± .03		MATERIAL	-	-			
				XXX = ± .010		FINISH	-	-			
		ANGULAR = ± .5 °		HOLES:		WINDLOAD SPECIFICATION		SIZE	DWG NO.	REV	
				< Ø.251 = +.004/- .003		OPTION CODE 2501		D	D-361778	P-00	
		Ø.251-Ø.500 = +.006/- .003		> Ø.500 = +.008/- .003		ALL GEOMETRY GOVERNED BY 3D CAD DATABASE:		SCALE 1:12		UOM = EA	SHEET 1 OF 4
								361778			

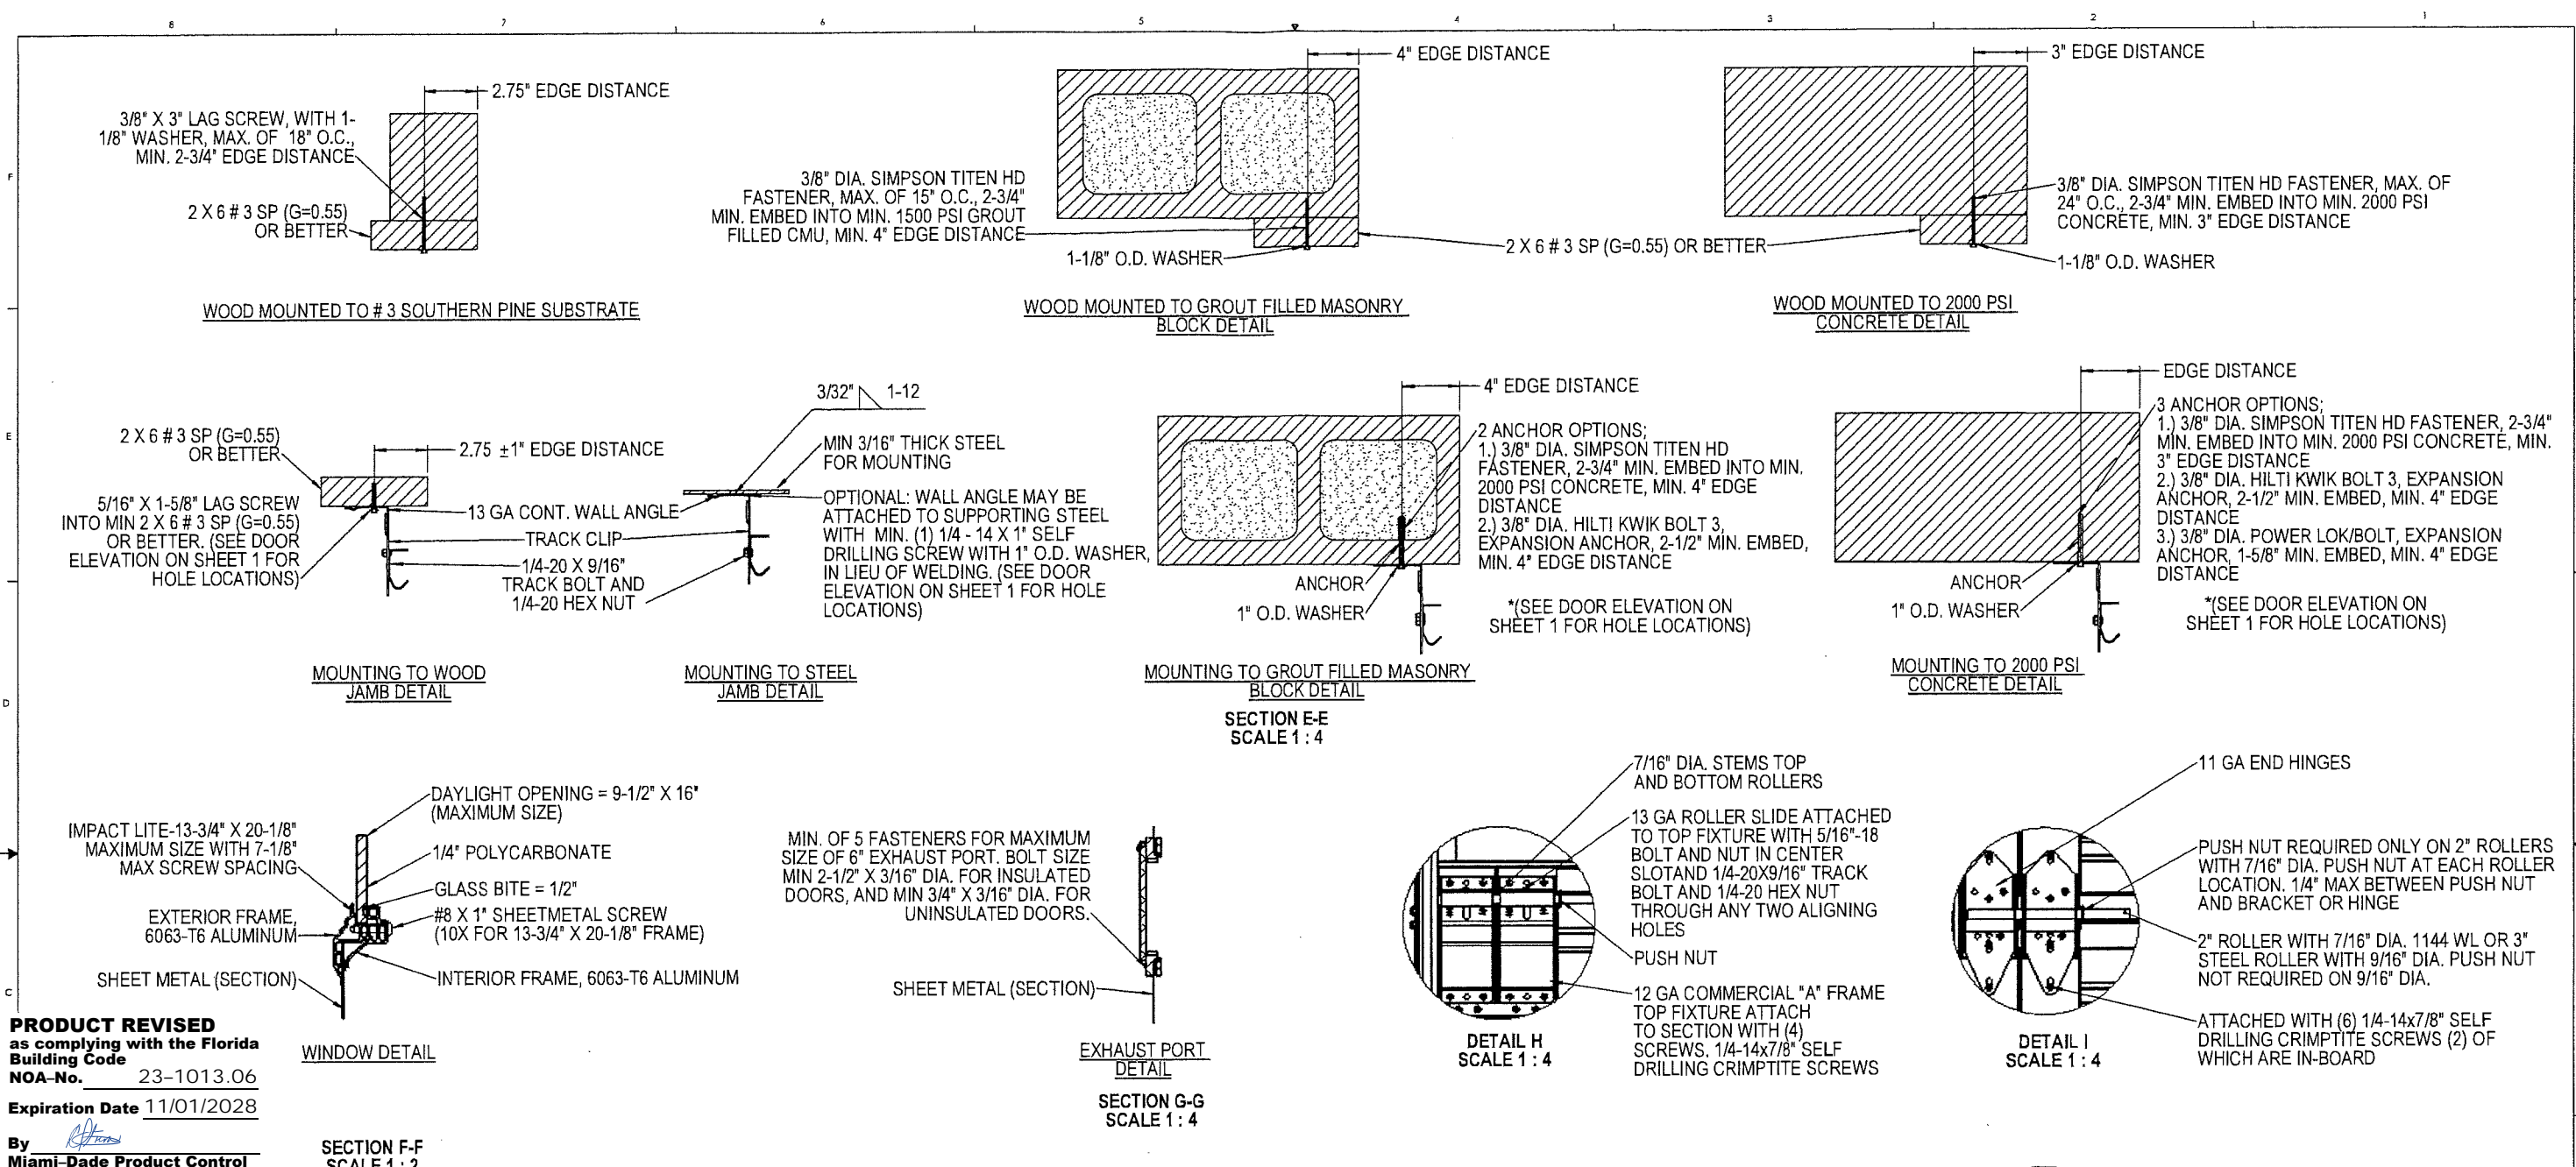

PRODUCT REVISED
as complying with the Florida Building Code
NOA-No. 23-1013.06
Expiration Date 11/01/2028

By *[Signature]*
Miami-Dade Product Control

SECTION F-F
SCALE 1:2

DWAYNE J. KORNISH, PE
4576 COUNTY ROAD 160
MOUNT HOPE, OHIO
FL PE 77945 TX PE 117868

PROFESSIONAL ENGINEER'S SEAL PROVIDED ONLY FOR VERIFICATION OF WINDLOAD CONSTRUCTION DETAILS.

PRODUCT APPROVED
as complying with the Florida Building Code
NOA-No. 18-0122.03
Approval Date 11/01/2018

By *[Signature]*
Miami-Dade Product Control

PRODUCT REVISED
as complying with the Florida Building Code
NOA-No. 20-1106.09
Expiration Date 11/01/2023


By *[Signature]*
Miami-Dade Product Control

THIRD ANGLE PROJECTION


A DIVISION OF OVERHEAD DOOR CORP
3395 ADDISON DRIVE
PENSACOLA, FLORIDA 32514
(850)-474-9890

UNLESS OTHERWISE SPECIFIED		APPROVALS DATE		Wayne Dalton PENSACOLA, FLORIDA	
INTERPRET DIMS & TOLS PER ASME Y14.5M ALL DIMS ARE IN INCHES DO NOT SCALE	TOLERANCES: X = ± .1 XX = ± .03 XXX = ± .010 ANGULAR = ± .5°	DRAWN	E. CONRAD	4/23/18	DESCRIPTION WINDLOAD COMMERCIAL SECTIONAL STEEL DOOR, C20 AND C24, +50/-56PSF DADE COUNTY, 14'2" MAX WIDTH
		CHECKED	D. KORNISH	-	
		APPROVED	-	-	
		MATERIAL	-	-	
DO NOT SCALE		FINISH		-	SIZE DWG NO. D D-361778
DIMS CIRCLED WITH SYMBOL 'D' ARE CRITICAL TO QUALITY DESIGN FEATURES & MUST MEET APPLICABLE IN-PROCESS INSPECTION STANDARDS.		WINDLOAD SPECIFICATION OPTION CODE 2501		REV P-00	
ALL GEOMETRY GOVERNED BY 3D CAD DATABASE: 361778		SCALE 1:12		UOM = EA	SHEET 2 OF 4

NOTES: (UNLESS OTHERWISE SPECIFIED)
1. ONE 4" STRUT PER SECTION, AND ONE 3" STRUT PER BOTTOM SECTION, ATTACHED WITH 1/4-14X7/8" SELF DRILLING CRIMPTITE SCREWS.

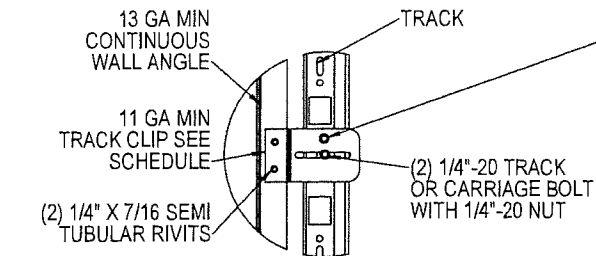


TYPICAL TRACK CLIP
RIVETING DETAIL

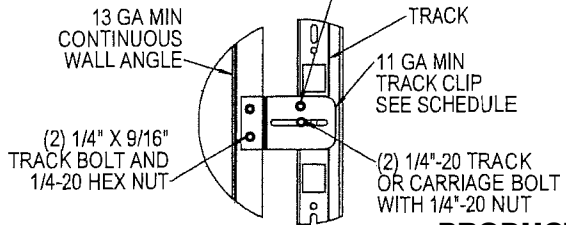

TYPICAL TRACK CLIP
BOLTING DETAIL

DETAIL M
SCALE 1:4

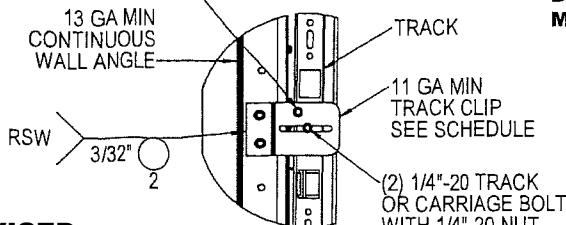

TYPICAL TRACK CLIP
WELDING DETAIL



PRODUCT REVISED
as complying with the Florida
Building Code
NOA-No. 20-1106.09
Expiration Date 11/01/2023

By
Miami-Dade Product Control


PRODUCT APPROVED
as complying with the Florida
Building Code
NOA-No. 18-0122.03

Approval Date 11/01/2018

By
Miami-Dade Product Control

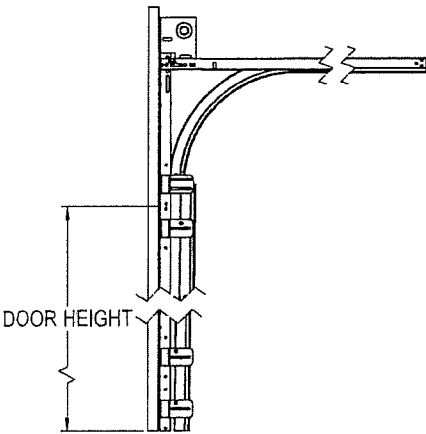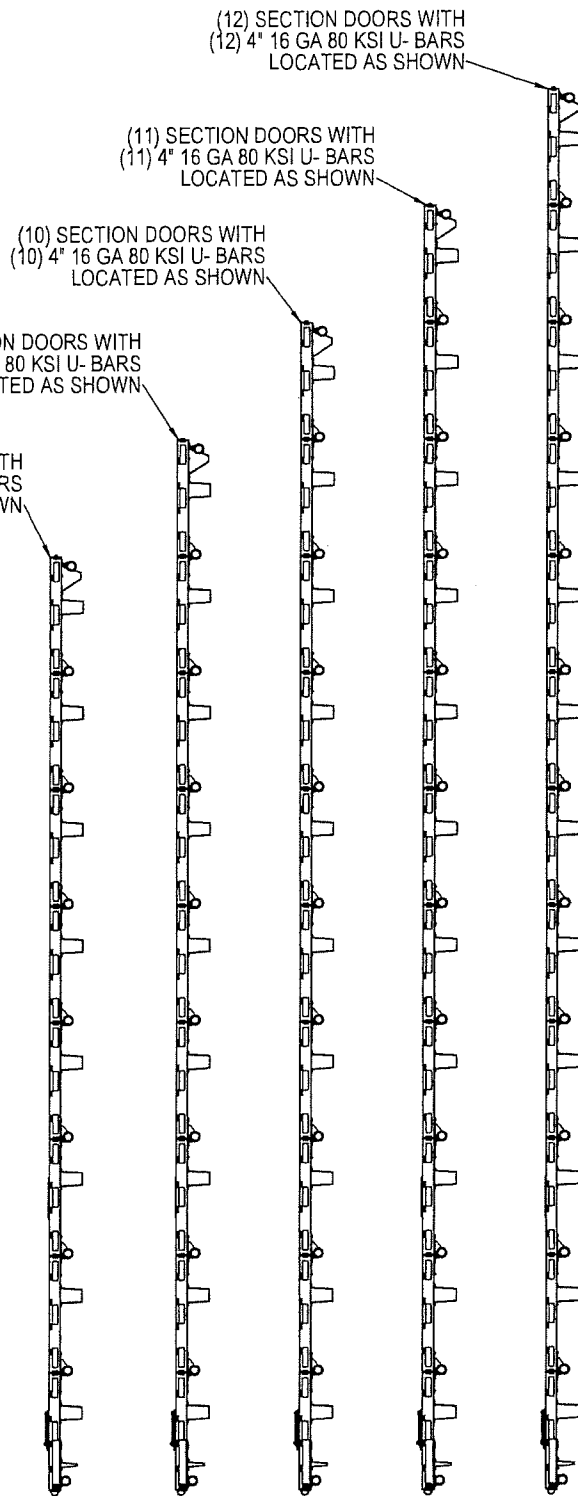


STANDARD LIFT
TRACK DETAIL

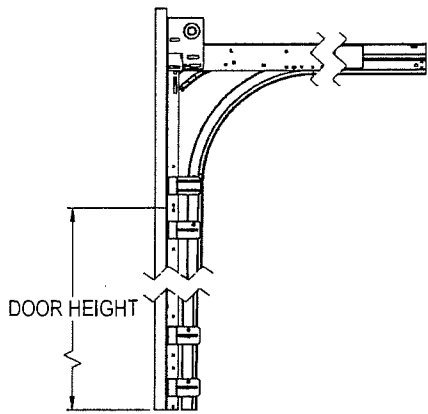


LOW HEADROOM
TRACK DETAIL


TRACK DETAIL
SCALE 1:12

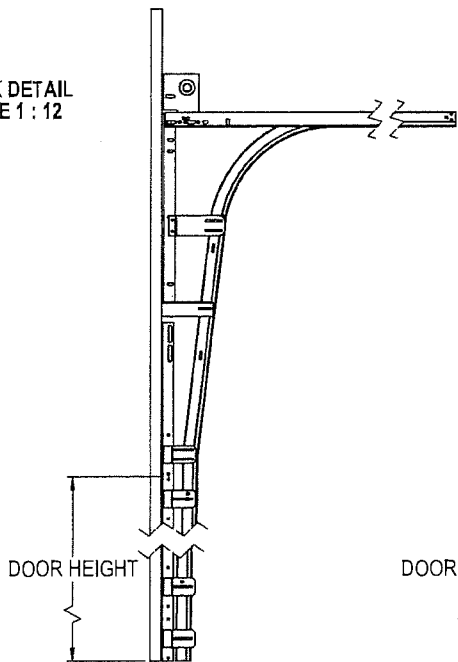


HIGH LIFT
TRACK DETAIL

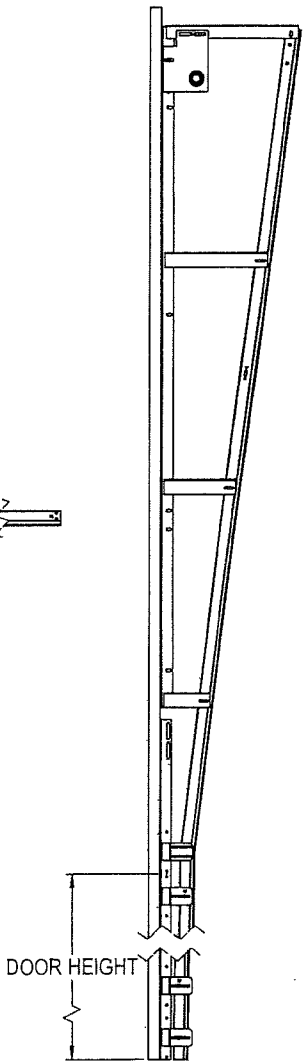

VERTICAL LIFT
TRACK DETAIL

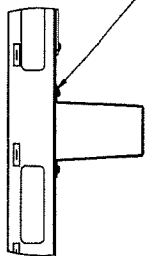

DETAIL N
SCALE 1:4

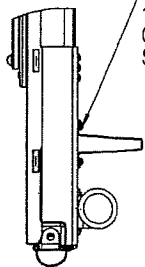

DETAIL O
SCALE 1:4

ATTACH 4" STRUTS WITH (4) 1/4-14X7/8" SELF DRILLING CRIMPTITE SCREWS AT ALL STILE LOCATION. LOCATED WITHIN 6", +/- 3" FROM TOP OF SECTIONS

(7) SECTION DOORS WITH (7) 4" 16 GA 80 KSI U- BARS LOCATED AS SHOWN



(6) SECTION DOORS WITH (6) 4" 16 GA 80 KSI U- BARS LOCATED AS SHOWN

(5) SECTION DOORS WITH (5) 4" 16 GA 80 KSI U- BARS LOCATED AS SHOWN


(4) SECTION DOORS WITH (4) 4" 16 GA 80 KSI U- BARS LOCATED AS SHOWN

ATTACH 3" STRUTS WITH (4) 1/4-14X7/8" SELF DRILLING CRIMPTITE SCREWS AT ALL STILE LOCATION

STRUT LOCATIONS
SCALE 1:16

THIRD ANGLE PROJECTION 	UNLESS OTHERWISE SPECIFIED		APPROVALS DATE		 PENSACOLA, FLORIDA		
	INTERPRET DIMS & TOLS PER ASME Y14.5M ALL DIMS ARE IN INCHES DO NOT SCALE	TOLERANCES:	DRAWN E. CONRAD 4/23/18	DESCRIPTION WINDLOAD COMMERCIAL SECTIONAL STEEL DOOR, C20 AND C24, +50/-56PSF DADE COUNTY, 14'2" MAX WIDTH			
		<div><div>.X = ± .1</div><div>.XX = ± .03</div><div>.XXX = ± .010</div><div>ANGULAR = ± .5 °</div></div>	CHECKED D. KORNISH -				
A DIVISION OF OVERHEAD DOOR CORP 3395 ADDISON DRIVE PENSACOLA, FLORIDA 32514 (850)-474-9890	DIMS CIRCLED WITH SYMBOL 'C' ARE CRITICAL TO QUALITY DESIGN FEATURES & MUST MEET APPLICABLE IN-PROCESS INSPECTION STANDARDS.	HOLES: <div><div>< Ø.251 = +.004/- .003</div><div>Ø.251-.500 = +.006/- .003</div><div>> Ø.500 = +.008/- .003</div></div>	APPROVED - MATERIAL - FINISH -	WINDLOAD SPECIFICATION OPTION CODE 2501	SIZE DWG NO. D D-361778	REV P-00	
ALL GEOMETRY GOVERNED BY 3D CAD DATABASE: 361778					SCALE 1:12	UOM = EA	SHEET 3 OF 4

PRODUCT REVISED
as complying with the Florida
Building Code
NOA-No. 23-1013.06
Expiration Date 11/01/2028
By
Miami-Dade Product Control

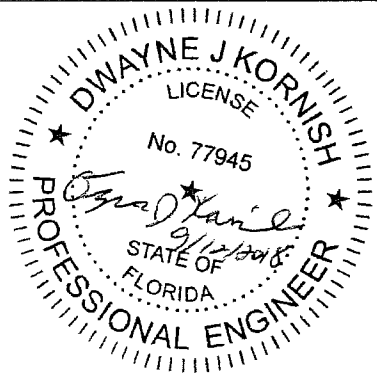


DWAYNE J. KORNISH, PE
4576 COUNTY ROAD 160
MOUNT HOPE, OHIO
FL PE 77945 TX PE 117868



PROFESSIONAL ENGINEER'S SEAL PROVIDED ONLY FOR
VERIFICATION OF WINDLOAD CONSTRUCTION DETAILS.

NOTES: (UNLESS OTHERWISE SPECIFIED)
1. FOR DIMENSIONS AND NOTE REFERENCES, REFER TO INDIVIDUAL DRAWINGS.


PRODUCT REVISED
as complying with the Florida
Building Code
NOA-No. 23-1013.06
Expiration Date 11/01/2028
By *[Signature]*
Miami-Dade Product Control

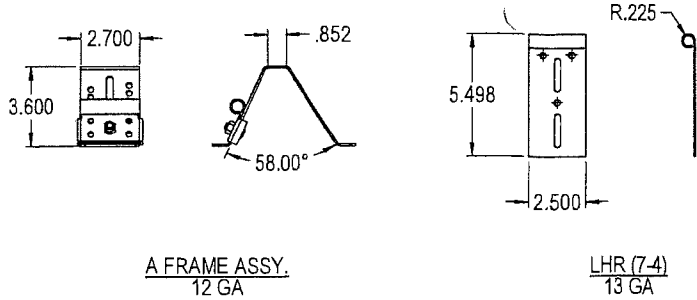


TOP FIXTURE DETAILS

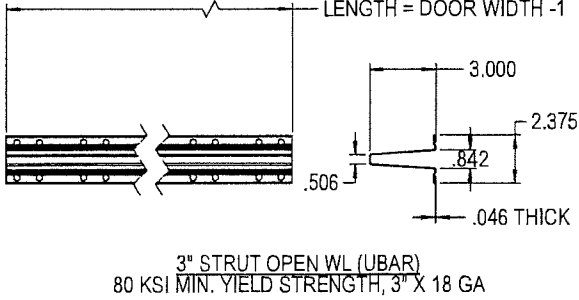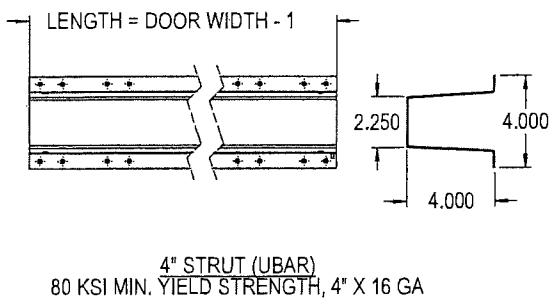


STRUT DETAILS

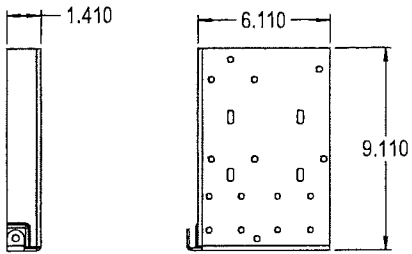


DOUBLE ENDSTILE
11 GA

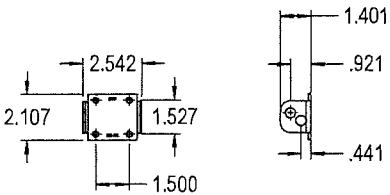

2" AND 3" ROLLER CARRIER
12 GA

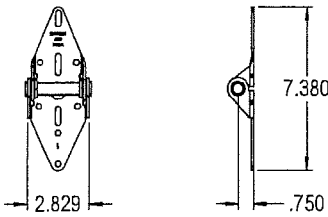


CENTER HINGE
14 GA

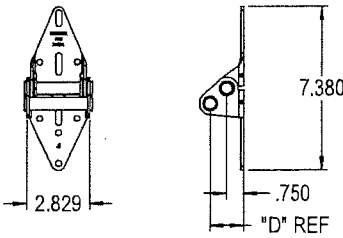


END HINGE
11 GA

HINGE DETAILS

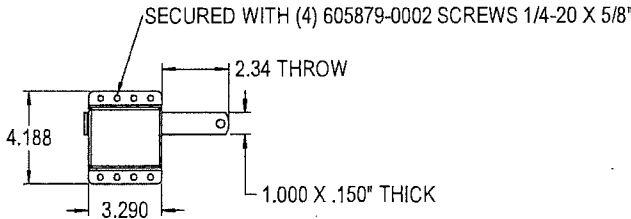


SIDE LOCK ASSY


LOCK DETAILS

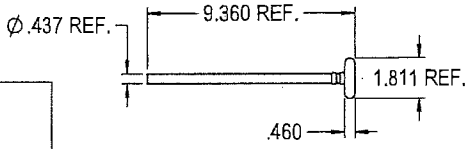

ROLLER ASSY. 2" WL 1144

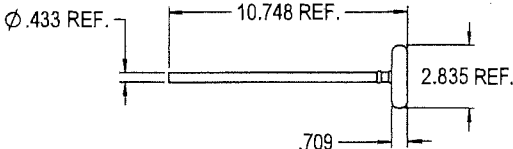


ROLLER ASSY. 3" 7/16" STEM

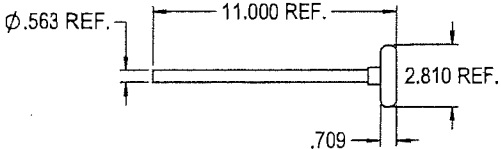


ROLLER ASSY. 3" 9/16" STEM

ROLLER STEM ASSY DETAILS

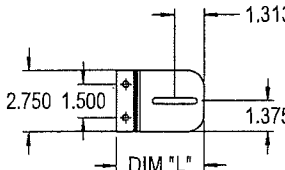


TRACK CLIP
11 GA

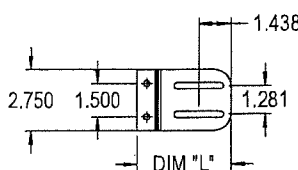

JOINT BRACKET
11 GA

BRACKET DETAILS

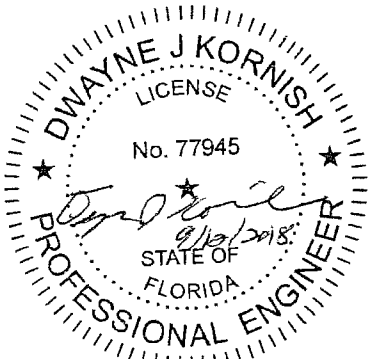


DWAYNE J. KORNISH, PE
4576 COUNTY ROAD 160
MOUNT HOPE, OHIO
FL PE 77945 TX PE 117868

PROFESSIONAL ENGINEER'S SEAL PROVIDED ONLY FOR
VERIFICATION OF WINDLOAD CONSTRUCTION DETAILS.

PRODUCT APPROVED
as complying with the Florida
Building Code
NOA-No. 18-0122.03
Approval Date 11/01/2018
By *[Signature]*
Miami-Dade Product Control

PRODUCT REVISED
as complying with the Florida
Building Code
NOA-No. 20-1106.09
Expiration Date 11/01/2023
By *[Signature]*
Miami-Dade Product Control

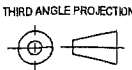

A DIVISION OF OVERHEAD
DOOR CORP
3395 ADDISON DRIVE
PENSACOLA, FLORIDA 32514
(850)-474-9890

UNLESS OTHERWISE SPECIFIED
INTERPRET DIMS & TOLS
PER ASME Y14.5M
ALL DIMS ARE IN
INCHES
DO NOT SCALE
DIMS CIRCLED WITH SYMBOL 'C'
ARE CRITICAL TO QUALITY DESIGN
FEATURES & MUST MEET APPLICABLE
IN-PROCESS INSPECTION STANDARDS.

TOLERANCES:
X = ±
XX = ±
XXX = ±
ANGULAR = ± °
HOLES:
< $\phi .251$ = ±
 $\phi .251$ - $\phi .500$ = ±
> $\phi .500$ = ±

ALL GEOMETRY GOVERNED BY 3D CAD DATABASE:
361778

APPROVALS DATE
DRAWN E. CONRAD 4/23/18
CHECKED D. KORNISH
APPROVED
MATERIAL
FINISH
WINDLOAD SPECIFICATION
OPTION CODE 2501

Wayne Dalton
PENSACOLA, FLORIDA
DESCRIPTION
WINDLOAD COMMERCIAL SECTIONAL
STEEL DOOR, C20 AND C24, +50/-56PSF
DADE COUNTY, 14'2" MAX WIDTH
SIZE DWG NO.
D D-361778
REV
P-00
SCALE 1:12 UOM = EA SHEET 4 OF 4