



DEPARTMENT OF REGULATORY AND ECONOMIC RESOURCES (RER)
BOARD AND CODE ADMINISTRATION DIVISION

NOTICE OF ACCEPTANCE (NOA)

MIAMI-DADE COUNTY, FLORIDA
PRODUCT CONTROL SECTION

11805 SW 26 Street, Room 208
T (786) 315-2590 F (786) 315-2599

www.miamidade.gov/economy

PGT Industries, Inc.
1070 Technology Drive,
North Venice, Fl. 34275

SCOPE:

This NOA is being issued under the applicable rules and regulations governing the use of construction materials. The documentation submitted has been reviewed and accepted by Miami-Dade County RER-Product Control Section to be used in Miami-Dade County and other areas where allowed by the Authority Having Jurisdiction (AHJ).

This NOA shall not be valid after the expiration date stated below. The Miami-Dade County Product Control Section (In Miami-Dade County) and/ or the AHJ (in areas other than Miami-Dade County) reserve the right to have this product or material tested for quality assurance purposes. If this product or material fails to perform in the accepted manner, the manufacturer will incur the expense of such testing and the AHJ may immediately revoke, modify, or suspend the use of such product or material within their jurisdiction. RER reserves the right to revoke this acceptance, if it is determined by Miami-Dade County Product Control Section that this product or material fails to meet the requirements of the applicable building code.

This product is approved as described herein and has been designed to comply with the Florida Building Code, including the High Velocity Hurricane Zone.

DESCRIPTION: Series "FD-650" Outswing Aluminum French Door w/wo Sidelites - N.I.

APPROVAL DOCUMENT: Drawing No. **8000-12 Rev G**, titled "Alum. French Door & Side Lites, Non-Impact", sheets 1 through 11 of 11, dated 12/23/04 and last revised on 04/20/20, prepared by manufacturer, signed and sealed by Anthony Lynn Miller, P. E., bearing the Miami-Dade County Product Control Section Revises stamp with the Notice of Acceptance number and Expiration date by the Miami-Dade County Product Control Section.

MISSILE IMPACT RATING: None: Approved Hurricane Protection devices, complying w/ FBC, as applicable are required.

Limitations:

1. See sheet **2** for Design Pressures (DP) VS sizes and glass types for doors and sidelites (Narrow or full jambs) and overhang /sill options. When doors are assembled with sidelites, lower design pressures from door or sidelite shall control.
2. See glass options in sheet **1** and spacer options for insulated glass in sheet **8**.
3. See installation anchoring details in sheets **9, 10** and **11**.

LABELING: Each unit shall bear a permanent label with the manufacturer's name or logo, city, state, series, and following statement: "Miami-Dade County Product Control Approved", unless otherwise noted herein.

RENEWAL of this NOA shall be considered after a renewal application has been filed and there has been no change in the applicable building code negatively affecting the performance of this product.

TERMINATION of this NOA will occur after the expiration date or if there has been a revision or change in the materials, use, and/ or manufacture of the product or process. Misuse of this NOA as an endorsement of any product, for sales, advertising or any other purposes shall automatically terminate this NOA. Failure to comply with any section of this NOA shall be cause for termination and removal of NOA.

ADVERTISEMENT: The NOA number preceded by the words Miami-Dade County, Florida, and followed by the expiration date may be displayed in advertising literature. If any portion of the NOA is displayed, then it shall be done in its entirety.

INSPECTION: A copy of this entire NOA shall be provided to the user by the manufacturer or its distributors and shall be available for inspection at the job site at the request of the Building Official.

This NOA **revises NOA No. 19-1126.07** and consists of this page 1 and evidence pages E-1, E-2, E-3, E-4 and E-5, as well as approval document mentioned above.

The submitted documentation was reviewed by **Ishaq I. Chanda, P. E.**



9/10/20

NOA No. 20-0427.04
Expiration Date: March 24, 2025
Approval Date: September 17, 2020
Page 1

NOTICE OF ACCEPTANCE: EVIDENCE SUBMITTED

1. Evidence submitted under previous approvals

A. DRAWINGS

1. Manufacturer's die drawings and sections.
2. Drawing No. **8000-12**, titled "Alum. French Door & Side Lites, Non-Impact", sheets 01 through 11 of 11, dated 12/23/04, with revision" D "dated 10/10/11, prepared by manufacturer, signed and sealed by Anthony Lynn Miller, P. E.

B. TESTS

1. Test reports on:
 - 1) Air Infiltration Test, per FBC, TAS 202-94
 - 2) Uniform Static Air Pressure Test, Loading per FBC, TAS 202-94
 - 3) Water Resistance Test, per FBC, TAS 202-94
 - 4) Forced Entry Test, per FBC 2411.3.2.1, and TAS 202-94

along with marked-up drawings and installation diagram of an aluminum doors of OXXO configuration, prepared by Fenestration Testing Laboratory, Inc., Test Report No. **FTL-5967**, dated 05/07/09, signed and sealed by Julio E. Gonzalez, P. E.

(Submitted under previous NOA No. 09-1028.09)

2. Test reports on:
 - 1) Air Infiltration Test, per FBC, TAS 202-94
 - 2) Uniform Static Air Pressure Test, Loading per FBC, TAS 202-94
 - 3) Water Resistance Test, per FBC, TAS 202-94
 - 4) Large Missile Impact Test per FBC, TAS 201-94
 - 5) Cyclic Wind Pressure Loading per FBC, TAS 203-94
 - 6) Forced Entry Test, per FBC 2411.3.2.1, and TAS 202-94

along with marked-up drawings and installation diagram of an aluminum doors of OXXO configuration, prepared by Fenestration Testing Laboratory, Inc., Test Report No. **FTL-4921**, dated 07/17/06, signed and sealed by Edmundo J. Largaespada, P. E.

(Submitted under previous NOA No. 05-0107.01)

3. Test reports on:
 - 1) Air Infiltration Test, per FBC, TAS 202-94
 - 5) Uniform Static Air Pressure Test, Loading per FBC, TAS 202-94
 - 6) Water Resistance Test, per FBC, TAS 202-94
 - 7) Forced Entry Test, per FBC 2411.3.2.1, and TAS 202-94


along with marked-up drawings and installation diagram of an aluminum doors of OXXO configuration, prepared by Fenestration Testing Laboratory, Inc., Test Reports No.'s **FTL-4450**, dated 12/14/04, **FTL-4451**, dated 12/14/04 and **FTL-4452**, dated 12/14/04, all signed and sealed by Edmundo J. Largaespada, P. E. *(Submitted under previous NOA No. 05-0107.01)*.

C. CALCULATIONS

1. Anchor verification calculations and structural analysis, complying with **FBC 2010 and FBC 2014, 5th Edition**, prepared by manufacturer, dated 02/11/15, signed and sealed by A. Lynn Miller, P. E.
2. Glazing complies with ASTM E1300-04/ 09.

D. QUALITY ASSURANCE

1. Miami-Dade Department of Regulatory and Economic Resources (RER).

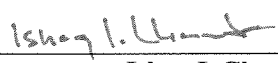
Ishaq I. Chanda, P. E.
Product Control Unit Supervisor
NOA No. 20-0427.04
Expiration Date: March 24, 2025
Approval Date: September 17, 2020

NOTICE OF ACCEPTANCE: EVIDENCE SUBMITTED

E. MATERIAL CERTIFICATIONS

1. None.

F. STATEMENTS

1. Statement letter of conformance to **FBC-2010** and complying with **FBC 5th Edition (2014)**, issued by manufacturer, dated 11/06/14, signed and sealed by A. Lynn Miller, P. E.
2. Statement letter of no financial interest, issued by manufacturer, dated 11/06/14, signed and sealed by A. Lynn Miller, P. E.
3. Department of State Certification of **PGT INDUSTRIES, INC.** as a for profit corporation, active and organized under the laws of the State of Florida, dated 01/27/15 and filed by Ken Detzner, Secretary of State.
4. Notification of Successor Engineer for manufacturer's NOA document per **Section 61G15-27.001** of the **Florida Administrative Code**, notifying original engineer that the successor engineer is assuming full professional and legal responsibility for all engineering documents pertaining to this NOA, dated 10/07/11, signed and sealed by A. Lynn Miller, P. E.
5. Proposal No. **08-1891** issued by Product Control, dtd 01/26/09, signed by Ishaq Chanda, P. E. *(Submitted under previous NOA No. 09-1028.09).*

2. Evidence submitted under previous approvals

A. DRAWINGS

1. Drawing No. **8000-12**, titled "Alum. French Door & Side Lites, Non-Impact", sheets 1 through 11 of 11, dated 12/23/04, with revision" E dated 05/05/16, prepared by manufacturer, signed and sealed by Anthony Lynn Miller, P. E.

B. TESTS

1. Reference Test report on 1) Uniform Static Air Pressure Test, per FBC, TAS 202-94
2) Large Missile Impact Test per FBC, TAS 201-94
3) Cyclic Wind Pressure Loading per FBC, TAS 203-94
Along with marked-up drawings and installation diagram of Aluminum Sliding Glass Doors (w/ PS, Super, Cardinal & Duraseal Spacers), prepared by Fenestration Testing Laboratory, Inc., Test Reports No(s) **FTL-8717, FTL-8970** and **FTL-8968**, dated 02/15/16, 06/07/16 and 06/20/16, all signed & sealed by Idalmis Ortega, P.E.

C. CALCULATIONS

1. Anchor verification calculations and structural analysis, complying with **FBC 2010 and FBC 2014, 5th Edition**, prepared by manufacturer, dated 02/11/15, signed and sealed by A. Lynn Miller, P. E. *(Submitted under previous NOA 14-1117.04).*

D. QUALITY ASSURANCE


1. Miami-Dade Department of Regulatory and Economic Resources (RER).

E. MATERIAL CERTIFICATIONS

1. None.

F. STATEMENTS *(Submitted under previous NOA No. 14-1117.04)*

1. Statement letter of conformance to **FBC-2010** and complying with **FBC 5th Edition (2014)**, issued by manufacturer, dated 11/06/14, signed and sealed by A. Lynn Miller, P. E.



Ishaq I. Chanda, P. E.
Product Control Unit Supervisor
NOA No. 20-0427.04
Expiration Date: March 24, 2025
Approval Date: September 17, 2020

NOTICE OF ACCEPTANCE: EVIDENCE SUBMITTED

G. OTHERS

1. Notice of Acceptance No. **14-1117.04**, issued to PGT Industries for their Series "FD-650" Outswing Aluminum French Door w/ Sidelites – N.I., approved on 02/19/15 and expiring on 03/24/20.

3. Evidence submitted under previous approvals

A. DRAWINGS

1. Drawing No. **8000-12**, titled "Alum. French Door & Side Lites, Non-Impact", sheets 1 through 11 of 11, dated 12/23/04, with revision F dated 04/10/17, prepared by manufacturer, signed and sealed by Anthony Lynn Miller, P. E.

B. TESTS (Submitted under previous NOA No. 16-0629.15)

1. Test report on 1) Uniform Static Air Pressure Test, per FBC, TAS 202-94
2) Large Missile Impact Test per FBC, TAS 201-94
3) Cyclic Wind Pressure Loading per FBC, TAS 203-94

Along with marked-up drawings and installation diagram of Aluminum Sliding Glass Doors (w/ PS, Super, Cardinal & Duraseal Spacers), prepared by Fenestration Testing Laboratory, Inc., Test Reports No(s) **FTL-8717**, **FTL-8970** and **FTL-8968**, dated 02/15/16, 06/07/16 and 06/20/16, all signed & sealed by Idalmis Ortega, P.E.

C. CALCULATIONS

1. Anchor verification calculations and structural analysis, complying with **FBC 5th Edition (2014)** and **FBC 6th Edition (2017)**, prepared by manufacturer, dated 11/22/17, signed and sealed by A. Lynn Miller, P. E.
2. Glazing complies with ASTM E1300-04/ 09.

D. QUALITY ASSURANCE

1. Miami-Dade Department of Regulatory and Economic Resources (RER).

E. MATERIAL CERTIFICATIONS

- 1 None.

F. STATEMENTS

1. Statement letter of conformance with **FBC 6th Edition (2017)**, issued by manufacturer, dated 08/16/17, signed and sealed by A. Lynn Miller, P. E.

G. OTHERS

1. Notice of Acceptance No. **16-0629.15**, issued to PGT Industries for their Series "FD-650" Outswing Aluminum French Door w/ Sidelites – N.I., expiring on 03/24/20.
2. Test proposal No. **16-0152** dated 03/09/16 approved by RER.


4. Evidence submitted under previous approval.

A. DRAWINGS

1. Drawing No. **8000-12 Rev F**, titled "Alum. French Door & Side Lites, Non-Impact", sheets 1 through 11 of 11, dated 12/23/04 and last revised on 11/22/19, prepared by manufacturer, signed and sealed by Anthony Lynn Miller, P. E.

B. TESTS

1. None.

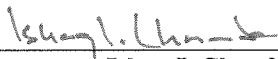

Ishaq I. Chanda, P. E.
Product Control Unit Supervisor
NOA No. 20-0427.04
Expiration Date: March 24, 2025
Approval Date: September 17, 2020

NOTICE OF ACCEPTANCE: EVIDENCE SUBMITTED

C. CALCULATIONS

1. None.
2. Glazing complies with ASTM E1300-04, -09.

D. QUALITY ASSURANCE

1. Miami Dade Department of Regulatory and Economic Resources (RER).

E. MATERIAL CERTIFICATIONS

1. None.

F. STATEMENTS

1. Statement letter of conformance to FBC 2020 (7th Edition), issued by manufacturer, dated 04/20/20, signed and sealed by Lynn Miller, P. E.

G. OTHER

1. This NOA **renews # 17-0504.03.**

5. New Evidence submitted

A. DRAWINGS

1. Drawing No. **8000-12 Rev G**, titled "Alum. French Door & Side Lites, Non-Impact", sheets 1 through 11 of 11, dated 12/23/04 and last revised on 04/20/20, prepared by manufacturer, signed and sealed by Anthony Lynn Miller, P. E.

B. TESTS

1. Test reports on:
 - 1) Air Infiltration Test, per FBC, TAS 202-94
 - 2) Uniform Static Air Pressure Test, Loading per FBC, TAS 202-94
 - 3) Water Resistance Test, per FBC, TAS 202-94
 - 4) Large Missile Impact Test per FBC, TAS 201-94
 - 5) Cyclic Wind Pressure Loading per FBC, TAS 203-94
 - 6) Forced Entry Test, per ASTM F588 and TAS 202-94

along with marked-up drawings and installation diagram of all PGT Industries, Inc., representative units listed below and tested to qualify **Dowsil 791** and **Dowsil 983** silicones, per Proposal #19-1155TP, prepared by Fenestration Testing Laboratory, Inc., Test Reports No.:

PGT Industries, Inc. test specimens:

FTL-7897, PGT PW5520 PVC Fixed Window (unit 6 in proposal), dated 09/03/14

FTL-20-2107.1, PGT SGD780 Aluminum Sliding Glass Door (unit 7 in proposal) **FTL-20-2107.2**, PGT CA740 Alum. Outswing Casement Window (unit 8 in proposal) **FTL-20-2107.3**, PGT PW7620A Aluminum Fixed Window (unit 9 in proposal) and **FTL-20-2107.4**, PGT PW7620A Aluminum Fixed Window (unit 10 in proposal) all dated 07/13/20 and signed and sealed by Idalmis Ortega, P.E.

C. CALCULATIONS

1. Anchor verification calculations and structural analysis, complying with **FBC 2020, 7th Edition**, prepared by manufacturer, dated 04/20/20, signed and sealed by A. Lynn Miller, P. E.
2. Glazing complies with ASTM E1300-04, -09, -12 and-16.



Ishaq I. Chanda, P. E.
Product Control Unit Supervisor
NOA No. 20-0427.04
Expiration Date: March 24, 2025
Approval Date: September 17, 2020

PGT Industries, Inc.

NOTICE OF ACCEPTANCE: EVIDENCE SUBMITTED

D. QUALITY ASSURANCE

1. Miami Dade Department of Regulatory and Economic Resources (RER).

E. MATERIAL CERTIFICATIONS


1. None.

G. STATEMENTS

1. Statement letter of conformance to FBC 2020 (7th Edition), issued by manufacturer, dated 04/20/20, signed and sealed by Lynn Miller, P. E.

G. OTHER

1. This NOA revises # 19-1126.07, expiring 03/24/2025.
2. RER Test proposal # 19-1155, dated 01/10/20 approved by Ishaq I. Chanda, P.E.

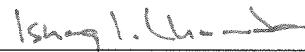

Ishaq I. Chanda, P. E.
Product Control Unit Supervisor
NOA No. 20-0427.04
Expiration Date: March 24, 2025
Approval Date: September 17, 2020

SERIES 650 OUTSWING NON-IMPACT RESISTANT FRENCH DOOR AND SIDE LITE

DESIGN PRESSURE RATING	IMPACT RATING
SEE TABLES 1, 2 & 3 ON SHEET 2	NOT RATED FOR MISSILE IMPACT RESISTANCE


- GLAZING OPTIONS:
 - 3/16" TEMPERED GLASS
 - 7/8" I.G. GLASS CONSISTING OF (2) LITES OF 3/16" TEMPERED GLASS WITH A 1/2" AIR SPACE.
- DESIGN PRESSURES: (SEE TABLES 1, 2 AND 3, SHEET 2)
 - NEGATIVE DESIGN LOADS BASED ON TESTED PRESSURE AND GLASS TABLES ASTM E 1300.
 - POSITIVE DESIGN LOADS BASED ON WATER TEST PRESSURE AND GLASS TABLES ASTM E 1300.
 - DESIGN LOADS ARE BASED ON ALLOWABLE STRESS DESIGN, ASD.
- CONFIGURATIONS: X, O, XX, XO, OX, XXX, XXO, OXX, OXO, XXXX, XXXO, OXXX, OR OXXO WHERE O REPRESENTS EITHER THE NARROW JAMB OR FULL JAMB SIDE LITE. ANY TWO ADJACENT X UNITS CAN BE EITHER TWO SINGLE X DOORS OR A DOUBLE XX DOOR, BOTH USING EITHER THE STANDARD OR THE LOW-RISE SILL. THE FRENCH DOOR ASSEMBLY BEAM IS USED TO ASSEMBLE X, XX, AND XO UNITS TO MAKE THE ABOVE CONFIGURATIONS.
- ANCHORAGE: THE 33 1/3% STRESS INCREASE HAS NOT BEEN USED IN THE DESIGN OF THIS PRODUCT. FOR ANCHORAGE REQUIREMENTS SEE SHEETS 9 THROUGH 11.
- SHUTTERS ARE REQUIRED WHERE IMPACT RESISTANCE REQUIRED. SHUTTERS MUST BE MIAMI-DADE COUNTY APPROVED FOR INSTALLATION IN MIAMI-DADE COUNTY.
- SEALANTS: INSTALLATION SCREWS, FRAME AND PANEL CORNERS SEALED WITH CLEAR COLORED SEALANT. VERTICAL ASSEMBLY BEAM SEAM-SEALED ON THE INTERIOR AND EXTERIOR WITH CONTRACTOR'S SEALANT.
- REFERENCES: TEST REPORTS FTL-4450, FTL-4451, FTL-4452, FTL-4921 AND FTL-5967.
ANSI/AF&PA NDS FOR WOOD CONSTRUCTION
ADM ALUMINUM DESIGN MANUAL
- THIS PRODUCT HAS BEEN DESIGNED & TESTED TO COMPLY WITH THE REQUIREMENTS OF THE FLORIDA BUILDING CODE, INCLUDING THE HIGH VELOCITY HURRICANE ZONE (HVHZ).

TABLE A:


Anchor Group	Anchor Type	Frame Member	Substrate	Min. Edge Distance	Min. Embedment or Metal Thickness
A	#12 SMS (steel, 18-8 S.S. or 410 S.S.)	All	Southern Pine (SG = 0.55)	9/16"	1-3/8"
		All	6063-T5 Aluminum	3/8"	1/8"
		All	Steel, A36	3/8"	0.060"
		All	Steel Stud, A1003 Gr. 33	3/8"	0.0451" (18 Ga.)
B	1/4" Elco UltraCon®	All	Concrete (min. 2.85 ksi)	2"	1-3/4"
		Jamb	Hollow Block (ASTM C90)	2"	1-1/4"
	1/4" DeWalt UltraCon+®	All	Concrete (min. 3 ksi)	2"	1-3/4"
		Jamb	Hollow Block (ASTM C90)	2"	1-1/4"
C	1/4" 410 SS Elco/DeWalt CreteFlex®	All	Concrete (min. 3.35 ksi)	1-3/4"	1-3/4"
		Jamb	Hollow Block (ASTM C90)	1-3/4"	1-1/4"
		All	Southern Pine (SG = 0.55)	1"	1-3/8"

- WHERE SUBSTRATE CONDITIONS REQUIRE ANCHORAGE FROM MORE THAN ONE OF THE ANCHOR GROUPS ABOVE, CHOOSE THE ANCHOR GROUP OF THE LOWEST LETTER FOR ALL TABLES IN THIS APPROVAL.
- ALL ANCHOR HEAD TYPES ARE APPLICABLE.
- MIN. OF 3 THREADS BEYOND METAL SUBSTRATE.
- SEE ANCHOR/SUBSTRATE MATERIAL PROPERTIES ON SHEET 6 FOR Fy & Fu.

GENERAL NOTES.....	1
CONFIGURATIONS.....	1
GLAZING DETAILS.....	1
DESIGN PRESSURES.....	2
ELEVATIONS.....	3
VERT. SECTIONS.....	4
HORIZ. SECTIONS.....	5
PARTS LIST.....	6
EXTRUSIONS.....	7-8
ANCHORAGE.....	9-11

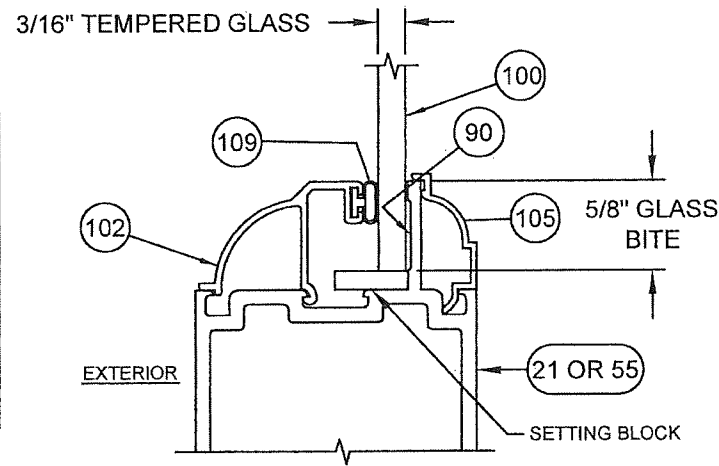

GLAZING DETAIL
MONOLITHIC GLASS

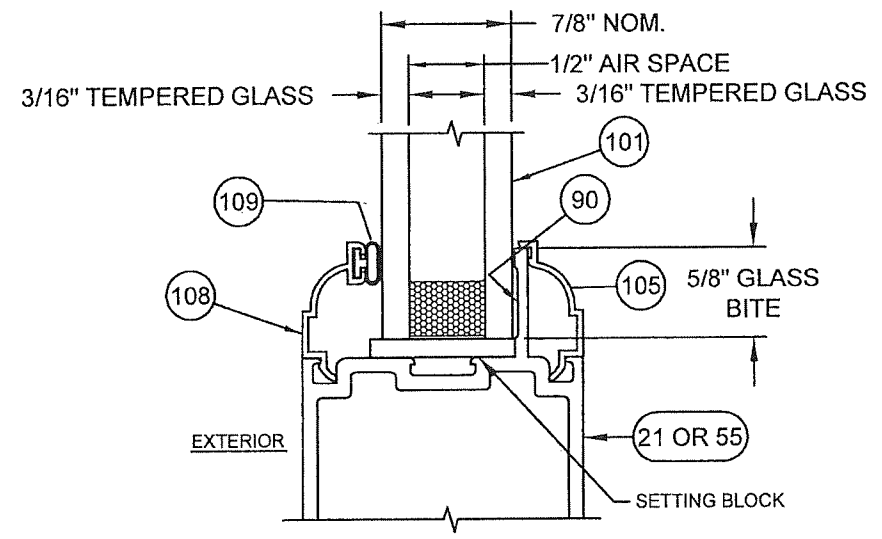


GLAZING DETAIL
I.G. GLASS

- CODES / STANDARDS USED:
- 2020 FLORIDA BUILDING CODE (FBC), 7TH EDITION
 - 2017 FLORIDA BUILDING CODE (FBC), 6TH EDITION
 - ASTM E1300-09
 - ANSI/AF&PA NDS-2018 FOR WOOD CONSTRUCTION
 - ALUMINUM DESIGN MANUAL, ADM-2015
 - AISI S100-16
 - AISC 360-16

Revised By:	Date:	Revisions:	
AGK	04/17/20	G	UPDATED TO FBC 2020, REV'D ANCHOR TABLE.
Drawn By:	Date:	Checked By:	Date:
F.K.	12/30/04		

1070 TECHNOLOGY DRIVE
N. VENICE, FL 34275
(941) 480-1600
REGISTRATION #29296

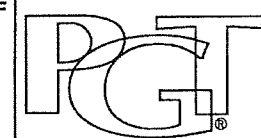

Description: GENERAL NOTES, GLAZING DETAILS AND MAP			
Title: ALUM. FRENCH DOOR & SIDE LITES, NON-IMPACT			
Series/Model: FD650	Scale: FULL	Sheet: 1 of 11	Drawing No.: 8000-12
			Rev: G

PRODUCT REVIEWED
as complying with the Florida
Building Code
Acceptance No. 20-0427-04
Expiration Date/MAR 24, 2025

Anthony L. Miller
Professional Engineer

A. LYNN MILLER, P.E.
FL P.E.# 58705

TABLE 1. COMPARATIVE ANALYSIS: OUTSWING DOORS

CONFIG.	GLASS		DOOR HEIGHT				
	A. 3/16" TEMPERED GLASS						
	OPTIONS: B. 7/8" I.G. (3/16"T, AIR SPACE, 3/16"T)		6 ⁸ - 79 3/4"	7 ⁰ - 83 3/4"	87 3/4"	91 3/4"	8 ⁰ - 95 3/4"
	DOOR WIDTH						
X	2 ⁰ 25"	+100.0 -145.0	+100.0 -145.0	+100.0 -145.0	+100.0 -145.0	+100.0 -139.5	
X	27"	+100.0 -145.0	+100.0 -145.0	+100.0 -144.2	+100.0 -136.9	+100.0 -130.3	
X	29"	+100.0 -145.0	+100.0 -143.4	+100.0 -135.7	+100.0 -128.7	+100.0 -122.4	
X	2 ⁶ 31"	+100.0 -144.2	+100.0 -135.8	+100.0 -128.3	+100.0 -121.6	+100.0 -115.6	
X	2 ⁸ 33"	+100.0 -126.7	+100.0 -126.7	+100.0 -122.0	+100.0 -115.5	+100.0 -109.7	
X	35"	+100.0 -112.2	+100.0 -112.2	+100.0 -112.2	+100.0 -110.2	+100.0 -104.6	
X	3 ⁰ 37"	+100.0 -100.0	+100.0 -100.0	+100.0 -100.0	+100.0 -100.0	+100.0 -100.0	
XX	4 ⁰ 47 3/4"	+100.0 -145.0	+100.0 -145.0	+100.0 -145.0	+100.0 -145.0	+100.0 -139.5	
XX	51 3/4"	+100.0 -145.0	+100.0 -145.0	+100.0 -144.2	+100.0 -136.9	+100.0 -130.3	
XX	55 3/4"	+100.0 -145.0	+100.0 -143.4	+100.0 -135.7	+100.0 -128.7	+100.0 -122.4	
XX	5 ⁰ 59 3/4"	+100.0 -144.2	+100.0 -135.8	+100.0 -128.3	+100.0 -121.6	+100.0 -115.6	
XX	5 ⁴ 63 3/4"	+100.0 -126.7	+100.0 -126.7	+100.0 -122.0	+100.0 -115.5	+100.0 -109.7	
XX	67 3/4"	+100.0 -112.2	+100.0 -112.2	+100.0 -112.2	+100.0 -110.2	+100.0 -104.6	
XX	6 ⁰ 71 3/4"	+100.0 -100.0	+100.0 -100.0	+100.0 -100.0	+100.0 -100.0	+100.0 -100.0	


TABLE 2. COMPARATIVE ANALYSIS: FULL JAMB SIDE LITE

SIDE LITE	GLASS		SIDE LITE HEIGHT			
	A. 3/16" TEMPERED GLASS					
	OPTIONS: B. 7/8" I.G. (3/16"T, AIR SPACE, 3/16"T)		6 ⁸ - 79 3/4"	7 ⁰ - 83 3/4"	87 3/4"	91 3/4"
	WIDTH					
	21 11/16"	+100.0 -145.0	+100.0 -145.0	+100.0 -145.0	+100.0 -145.0	+100.0 -145.0
	24 11/16"	+100.0 -145.0	+100.0 -145.0	+100.0 -145.0	+100.0 -144.9	+100.0 -137.9
	30 11/16"	+100.0 -142.9	+100.0 -135.3	+100.0 -127.8	+100.0 -121.1	+100.0 -115.1
	33 11/16"	+100.0 -118.6	+100.0 -118.6	+100.0 -118.6	+100.0 -112.5	+100.0 -106.8
	36 11/16"	+100.0 -100.0	+100.0 -100.0	+100.0 -100.0	+100.0 -100.0	+100.0 -100.0

NOTE: REFERENCE TEST REPORTS FTL4450, FTL-4451, FTL-4452, FTL-4921 AND FTL 5967.


TABLE 3. COMPARATIVE ANALYSIS: NARROW JAMB SIDE LITE

SIDE LITE	GLASS		SIDE LITE HEIGHT				
	A. TEMPERED GLASS						
	OPTIONS: B. 7/8" I.G. (3/16"T, AIR SPACE, 3/16"T)		6 ⁸ - 79 3/4"	7 ⁰ - 83 3/4"	87 3/4"	91 3/4"	8 ⁰ - 95 3/4"
	WIDTH						
	10 11/16"	+100.0 -145.0	+100.0 -145.0	+100.0 -145.0	+100.0 -145.0	+100.0 -145.0	
	13 11/16"	+100.0 -145.0	+100.0 -145.0	+100.0 -145.0	+100.0 -145.0	+100.0 -145.0	
	16 11/16"	+100.0 -145.0	+100.0 -145.0	+100.0 -145.0	+100.0 -145.0	+100.0 -145.0	
	19 11/16"	+100.0 -145.0	+100.0 -145.0	+100.0 -145.0	+100.0 -145.0	+100.0 -145.0	
	21 11/16"	+100.0 -145.0	+100.0 -145.0	+100.0 -145.0	+100.0 -145.0	+100.0 -145.0	
	24 11/16"	+100.0 -145.0	+100.0 -145.0	+100.0 -145.0	+100.0 -144.9	+100.0 -137.9	
	30 11/16"	+100.0 -142.9	+100.0 -135.3	+100.0 -127.8	+100.0 -121.1	+100.0 -115.1	
	33 11/16"	+100.0 -118.6	+100.0 -118.6	+100.0 -118.6	+100.0 -112.5	+100.0 -106.8	
	36 11/16"	+100.0 -100.0	+100.0 -100.0	+100.0 -100.0	+100.0 -100.0	+100.0 -100.0	

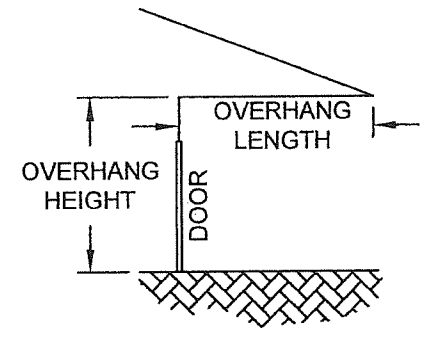


NOTES:
 1. IF USING THE OPTIONAL LOW-RISE SILL (PART 10, SHEET 7 OF 11), THE OVERHANG LENGTH MUST BE GREATER THAN OR EQUAL TO THE OVERHANG HEIGHT (SEE DIAGRAM). IF NOT, THE MAXIMUM POSITIVE (+) DESIGN PRESSURE IS LIMITED TO +50.0 PSF FOR ALL STYLES AND SIZES OF THE DOOR AND ANY ADJOINING SIDELITES.
 2. FOR COMBINED UNITS, THE LOWEST DESIGN PRESSURE OF THE SIDELITE AND THE DOOR GOVERNS THE OVERALL ASSEMBLY DESIGN PRESSURE.

PRODUCT REVIEWED
 as complying with the Florida
 Building Code
 Acceptance No. 20-0427-04
 Expiration Date 3/24/25
 by Anthony L. Miller
 Micael Mack Product Control

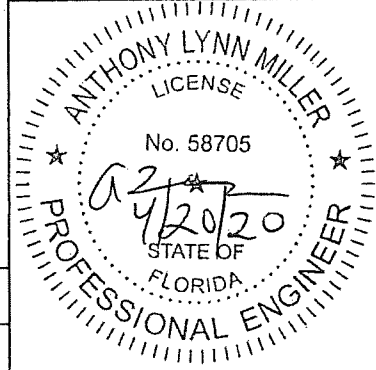


A. LYNN MILLER, P.E.
 FL P.E.# 58705

1070 TECHNOLOGY DRIVE
 N. VENICE, FL 34275
 (941) 480-1600
 REGISTRATION #29296

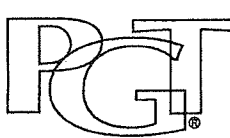

Description: **DESIGN PRESSURES**
 Title: **ALUM. FRENCH DOOR & SIDE LITES, NON-IMPACT**
 Series/Model: FD650 Scale: NA Sheet: 2 of 11 Drawing No.: 8000-12 Rev: G


Revised By: AGK	Date: 04/17/20	Revisions: G	NO CHANGES THIS SHEET.
Drawn By: F.K.	Date: 12/30/04	Checked By:	Date:

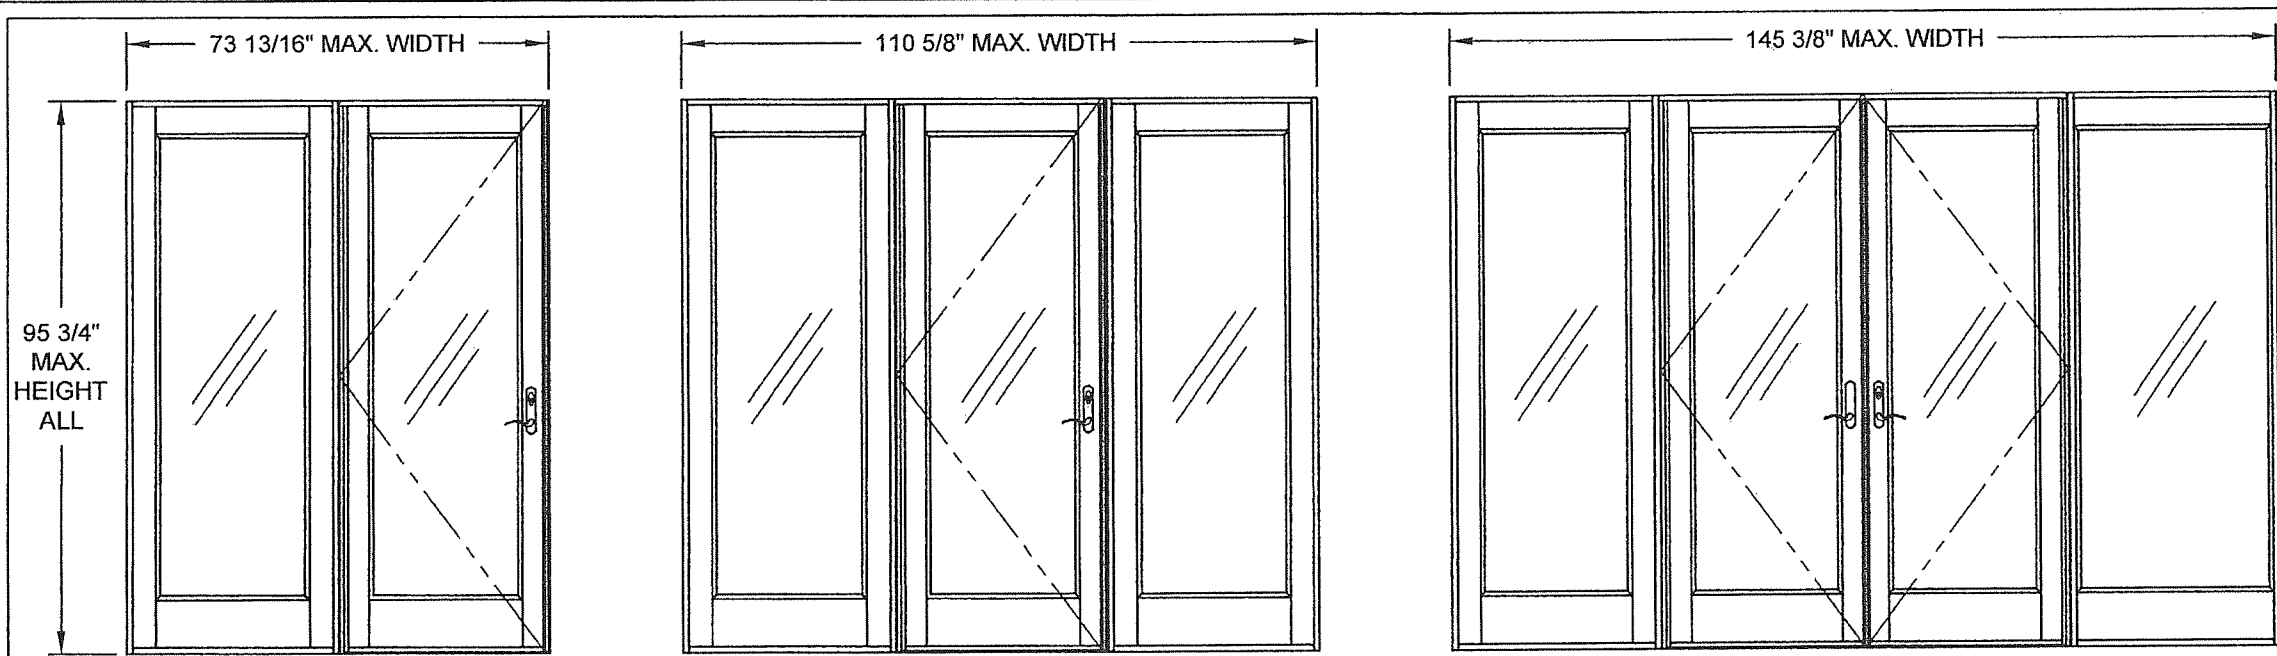


OX OR XO

OXO


OXXO (SHOWING EACH VERSION SIDELITE)

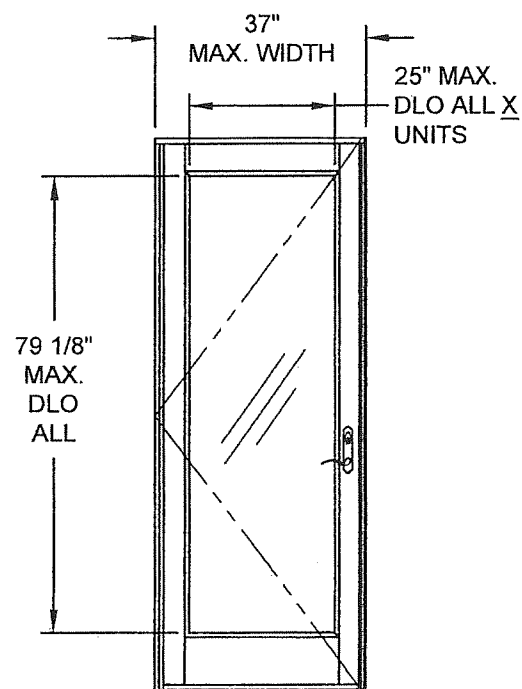


X

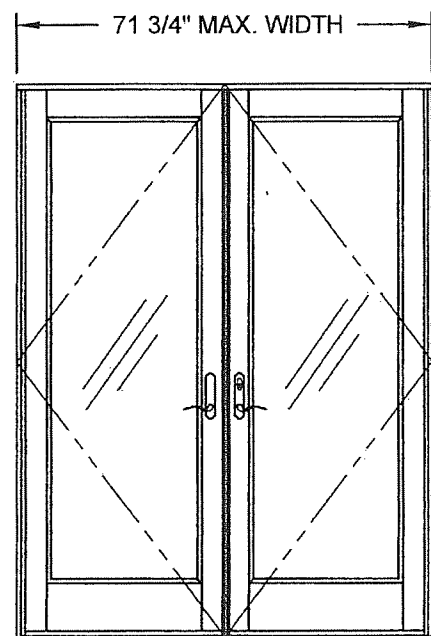

XX

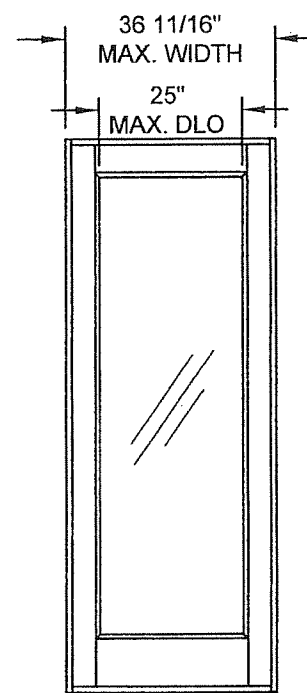

O (FULL JAMB)

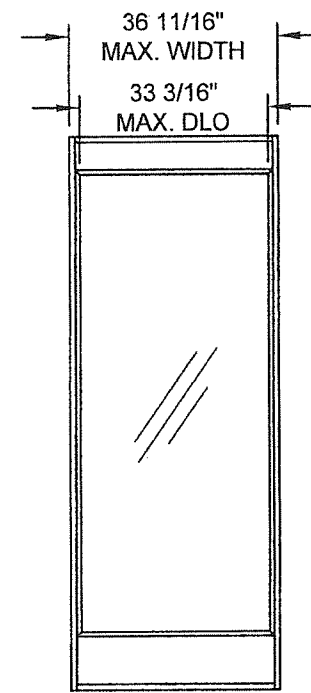


O (NARROW JAMB)

NOTES:

1. CONFIGURATIONS WITH SIDE LITES CAN BE EITHER NARROW JAMB OR FULL JAMB VERSIONS.
2. FOR ANCHOR SPACING AND DETAILS, SEE SHEETS 9 THROUGH 11.
3. FOR VERTICAL SECTIONS SEE SHEET 4 AND FOR HORIZONTAL SECTIONS SEE SHEET 5.

PRODUCT REVISED
 as complying with the Florida
 Building Code
 Acceptance No. 20-042704
 Expiration Date 3/24/25
Anthony L. Miller
 Licensed Product Control

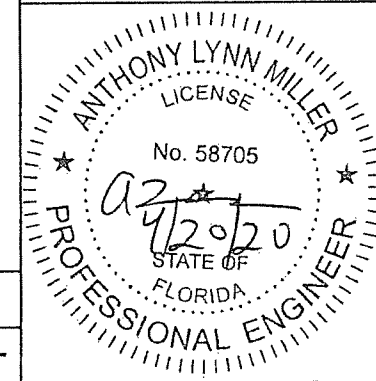

A. LYNN MILLER, P.E.
 FL P.E.# 58705


1070 TECHNOLOGY DRIVE
 N. VENICE, FL 34275
 (941) 480-1600
 REGISTRATION #28296





Description: EXAMPLE ELEVATIONS					
Title: ALUM. FRENCH DOOR & SIDE LITES, NON-IMPACT					
Series/Model: FD850	Scale: NTS	Sheet: 3 of 11	Drawing No. 8000-12	Rev. G	

Revised By: AGK	Date: 04/17/20	Revisions: G	NO CHANGES THIS SHEET.	
Drawn By: F.K.	Date: 12/30/04	Checked By:	Date:	

**VERTICAL SECTION A
NARROW AND FULL
JAMB SIDE LITE HEAD**

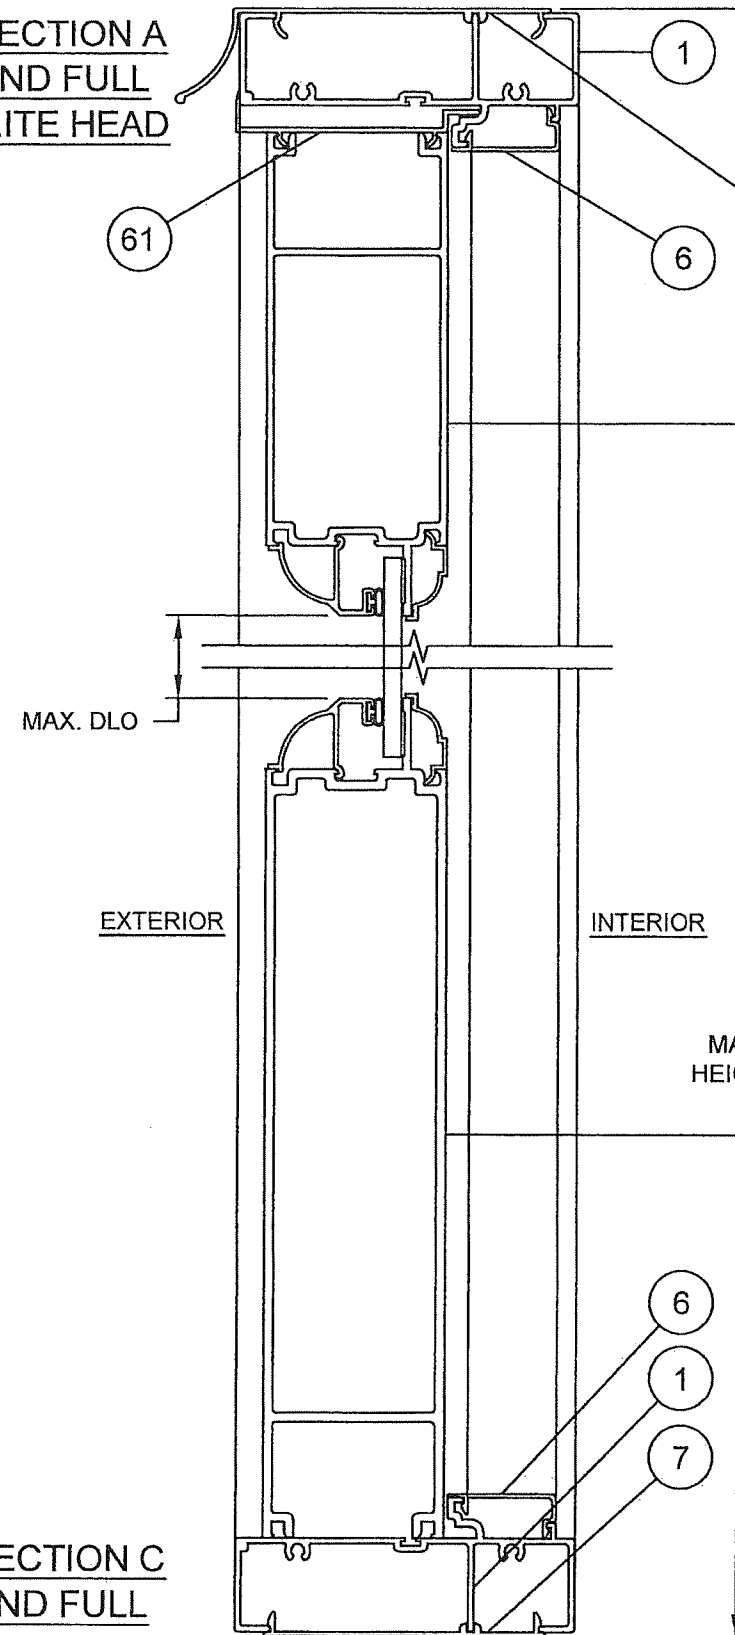

**VERTICAL SECTION B
OUTSWING HEAD**

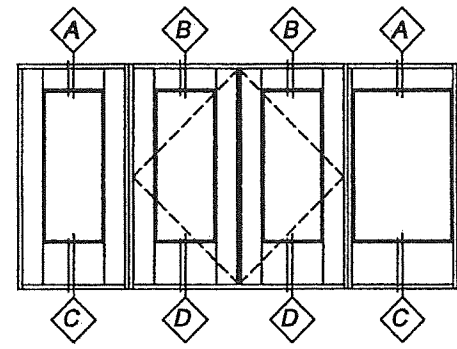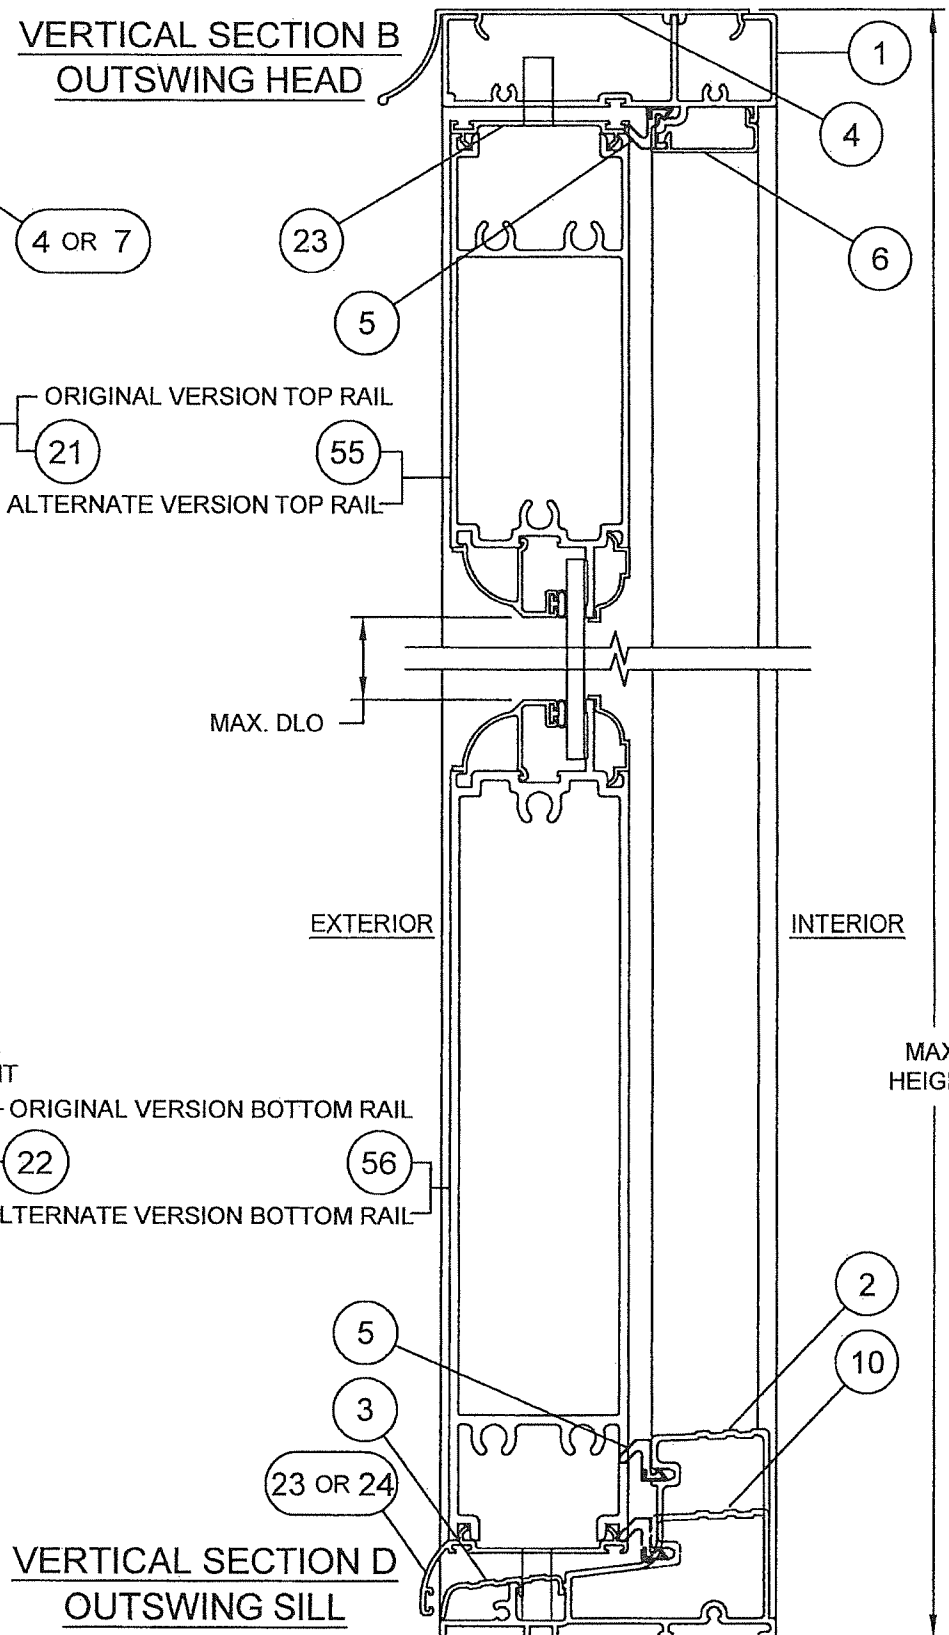

**VERTICAL SECTION C
NARROW AND FULL
JAMB SIDE LITE SILL**

**VERTICAL SECTION D
OUTSWING SILL**


Revised By:	Date:	Revisions:	
AGK	04/17/20	G	NO CHANGES THIS SHEET.
Drawn By:	Date:	Checked By:	Date:
F.K.	12/30/04		

1070 TECHNOLOGY DRIVE
N. VENICE, FL 34275
(841) 480-1600
REGISTRATION #29296





Description: VERTICAL SECTIONS			
Title: ALUM. FRENCH DOOR & SIDE LITES, NON-IMPACT			
Series/Model:	Scale:	Sheet:	Drawing No.:
FD650	1/2	4 of 11	8000-12
Rev:			
G			

PRODUCT REVIEWED
as complying with the Florida
Building Code
Acceptance No. 20-0427-04
Expiration Date 3/24/25
[Signature]
Manager: *[Signature]* Product Control

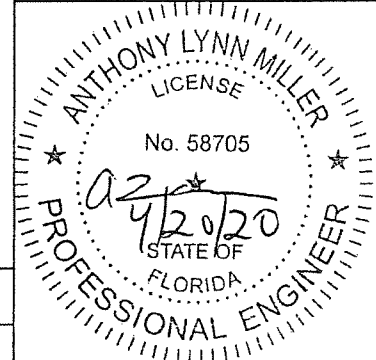


A. LYNN MILLER, P.E.
FL P.E.# 58705


OXXO HORIZONTAL SECTION SHOWING (1) OF EACH SIDE LITE TYPE

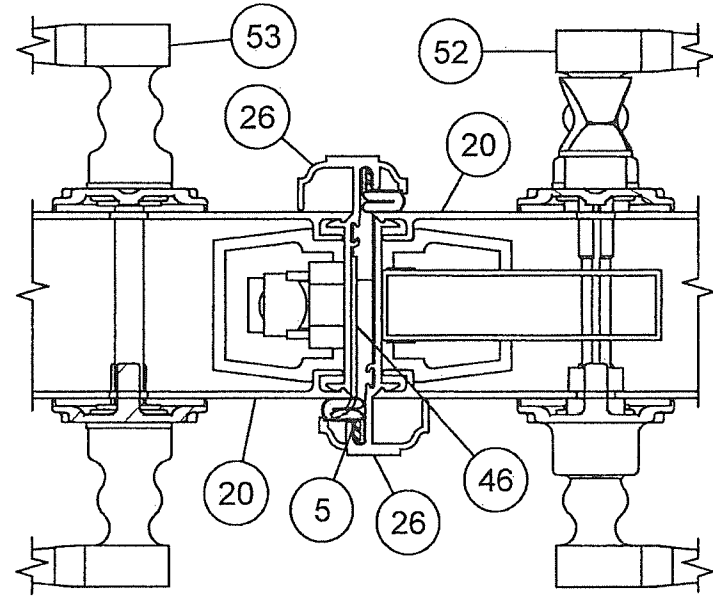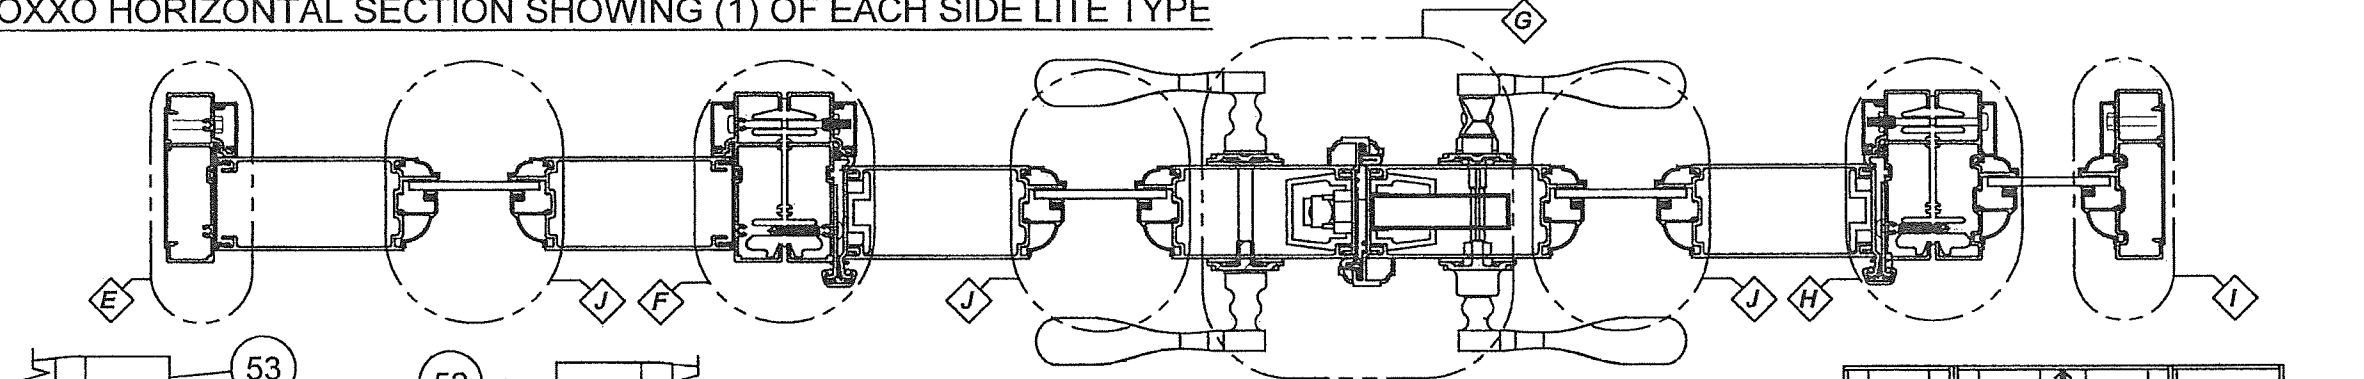


DETAIL G STILES AT ASTRAGAL

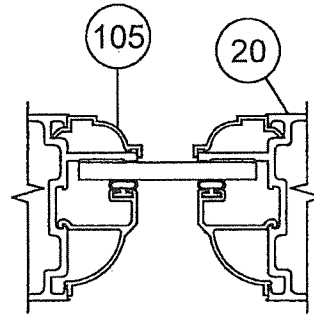

DETAIL J
SLAB AT
GLASS BED

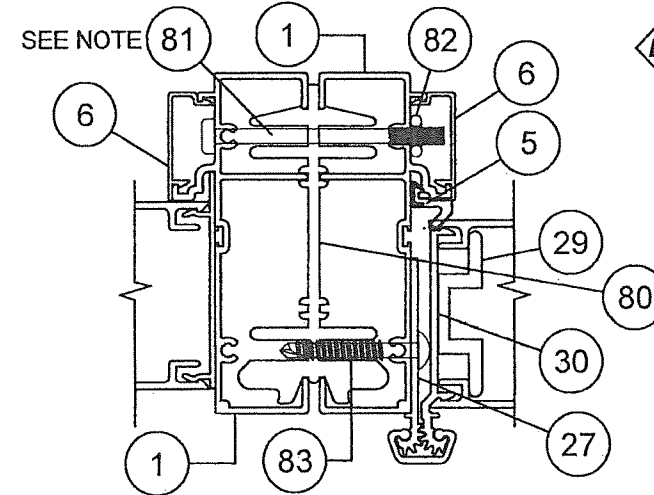


DETAIL F
FULL JAMB SIDE LITE
(AT HINGE JAMB)

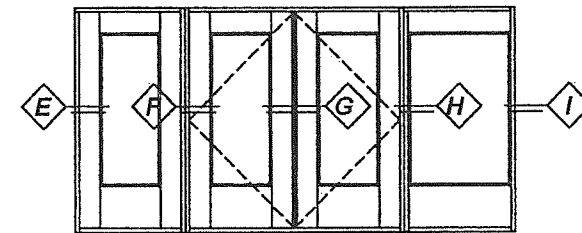


NOTE: ASSEMBLY HARDWARE QTY (3), 11"
FROM TOP & BOTTOM AND ONE AT MIDSPAN


INTERIOR
↑
↓
EXTERIOR

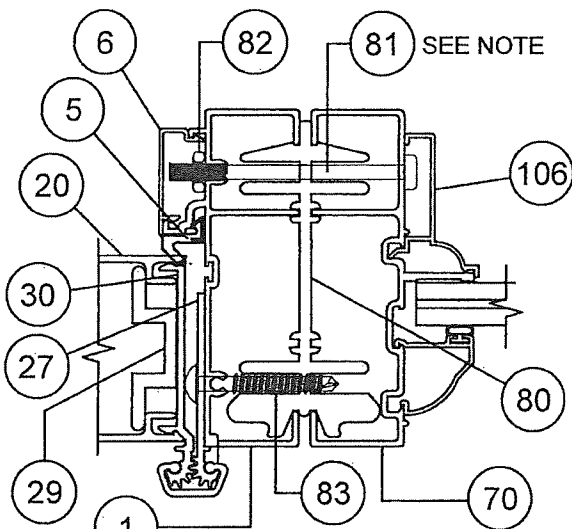


DETAIL H
NARROW JAMB SIDE LITE
(AT HINGE JAMB)

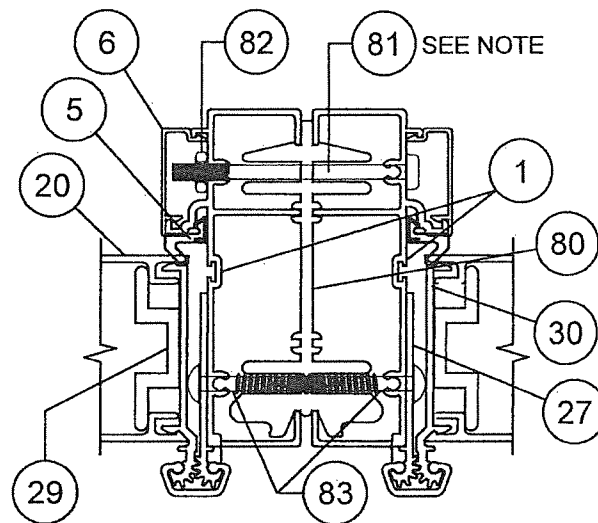

DETAIL K
HINGE JAMB TO HINGE JAMB
(NOT SHOWN ABOVE)

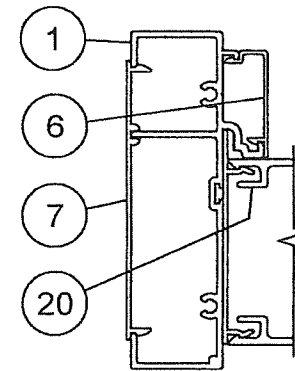

DETAIL E
JAMB, FULL JAMB
SIDE LITE

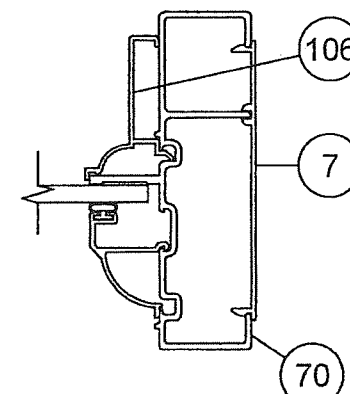

DETAIL I
JAMB, NARROW
JAMB SIDE LITE


Revised By:	Date:	Revisions:	
AGK	04/17/20	G	NO CHANGES THIS SHEET.
Drawn By:	Date:	Checked By:	Date:
F.K.	12/30/04		

1070 TECHNOLOGY DRIVE
N. VENICE, FL 34275
(941) 480-1600
REGISTRATION #29296



Description: HORIZONTAL SECTION DETAILS			
Title: ALUM. FRENCH DOOR & SIDE LITES, NON-IMPACT			
Series/Model: FD650	Scale: 1/2	Sheet: 5 of 11	Drawing No. 8000-12
			Rev. G

PRODUCT REVIEW
as complying with the Florida
Building Code
Acceptance No 20-0427.04
Expiration Date 3/24/25
[Signature]
Mfg. Prod. Control

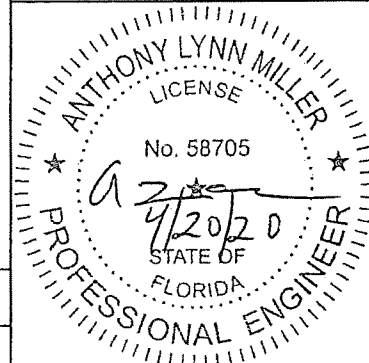

A. LYNN MILLER, P.E.
FL P.E.# 58705

FD650 DOOR(S)

ITEM	DWG#	DESCRIPTION	PGT#
FRAME KIT PARTS			
1	8006	FRAME - HEAD & HINGE JAMB	68006
2	8003C	OUT-SWING SILL	68003A
3	8004C	OUT-SWING SILL COVER	68004C
4	8008	DRIP CAP	68008
5	-----	HEAD, SILL & JAMB WEATHERSTRIP (SCHLEGAL)	U83337T8500
6	8007	SCREW COVER	68007
7	8009	INSTALL PLATE	68009
8	-----	FRAME ASSEMBLY SCREW #8 X 1" PH QUAD	781PQA
9	8032	ASTRAGAL END SEAL	48032
10	8058A	OUT-SWING SILL (LOW RISE)	68058
DOOR PANEL			
5	-----	HEAD, SILL & JAMB WEATHERSTRIP (SCHLEGAL)	U83337T8500
20	8012	STILE	68012
21	8014	TOP RAIL, (THREADED ROD DESIGN)	68014
22	8013	BOTTOM RAIL, (THREADED ROD DESIGN)	68013
23	8017	TOP SWEEP	68017
24	8016	BOTTOM SWEEP	68016
25	-----	SWEEP SCREWS, #4 X 1/2" PHIL PH	
26	8015	ASTRAGAL, ACTIVE & INACTIVE	68015
27	8021B	GEAR HINGE, JAMB SIDE	68021B
28	8020A	GEAR HINGE, COVER	68020A
29	8018	GEAR HINGE, BACK-UP PLATE	68018
30	8019A	GEAR HINGE, DOOR SIDE	68019A
31	8035	GEAR HINGE, BEARING	68035
32	-----	GEAR HINGE, SET-SCREW #6-32 x 1/4"	
33	-----	GEAR HINGE, MTG SCREW #12 x 3/4" TRUSS HD.	
34	-----	GEAR HINGE, MTG SCREW #12 x 1 1/2" TRUSS HD.	
35	-----	THREADED ROD 5/16-18 X 36"	6TRODA
36	-----	FLANGED HEX NUT 5/16-18	7990NUTA
37	8039	TRUSS CLAMP	60378M
38	8043	S/S GEAR LATCH MECHANISM (ASHLAND)	
39	8030	LOCK BLOCK	48030
40	-----	LATCH ASS'Y SCREWS #8 X 2" SS PHILL TR HD	78X2TPAX
41	8037	S/S SHOOT BOLT ROD (SULLIVAN)	
42	8045	STANDARD FLUSH BOLTS W/ SS ROD (SULLIVAN)	
43	8031	SHOOT BOLT GUIDE	48031
44	-----	SHOOT BOLT GUIDE & STRIKE SCREW 8-32 X 3/8" SS PHILL TR HD	78X38PFTX
45	8038R	RIGHT - STRIKE PLATE AT ASTRAGAL (ACTIVE HINGED LEFT)	W5110-43S1
46	8038L	LEFT - STRIKE PLATE AT ASTRAGAL (ACTIVE HINGED RIGHT)	W5110-44S1
47	-----	STRIKE PLATE SCREWS 8-32 X 3/8" SS PHILL TR HD	78X38PFTX
48	-----	STRIKE PLATE MIDDLE SCREW 6-24 X 1/2" FH	7612FPTX
49	8036	STRIKE PLATE AT HEAD & SILL	
50	-----	HEAD STRIKE SCREWS SS 8 X 1/2 PHILL FH	7858ZAX
51	-----	STRIKE PLATE SCREWS @SILL SS 8 X 1/2 PHILL UNDERCUT FH	78X12PFHUX
52	8041	ACTIVE TRIM SET (ASHLAND)	
53	8042	PASSIVE TRIM SET (ASHLAND)	
54	8044	STAINLESS STEEL PASSIVE LOCK GEAR (ASHLAND)	
55	8014A	TOP RAIL (LAGBOLT DESIGN)	68014A
56	8013A	BOTTOM RAIL (LAGBOLT DESIGN)	68013A

FD650 FULL JAMB SIDE LITE

ITEM	DWG#	DESCRIPTION	PGT#
1	8006	FRAME - HEAD, SILL & JAMB	68006
4	8008	DRIP CAP	68008
6	8007	SCREW COVER	68007
7	8009	INSTALL PLATE	68009
8	-----	FRAME ASSEMBLY SCREW #8 X 1" PH QUAD	781PQA
20	8012	STILE	68012
21	8014	TOP RAIL	68014
22	8013	BOTTOM RAIL	68013
35	-----	THREADED ROD 5/16-18 X 36"	6TRODA
36	-----	FLANGED HEX NUT 5/16-18	7990NUTA
37	8039	TRUSS CLAMP	60378M
60	-----	#8 X 3/4" PH SQ DRIVE TEK SCREW	78X34PSTW
61	8028	SIDE LITE HEAD TRIM	68028
62	8029	SIDE LITE JAMB TRIM	68029

FD650 NARROW JAMB SIDE LITE

ITEM	DWG#	DESCRIPTION	PGT#
1	8006	FRAME - HEAD & SILL	68006
4	8008	DRIP CAP	68008
6	8007	SCREW COVER	68007
7	8009	INSTALL PLATE	68009
8	-----	FRAME ASSEMBLY SCREW #8 X 1" PH QUAD	781PQA
21	8014	TOP RAIL	68014
22	8013	BOTTOM RAIL	68013
35	-----	THREADED ROD 5/16-18 X 36"	6TRODA
36	-----	FLANGED HEX NUT 5/16-18	7990NUTA
37	8039	TRUSS CLAMP	60378M
60	-----	#8 X 3/4" PH SQ DRIVE TEK SCREW	78X34PSTW
61	8028	SIDE LITE HEAD TRIM	68028
70	8010	FRAME, JAMB	68010

ASSEMBLY KIT

ITEM	DWG#	DESCRIPTION	PGT#
80	8033B	FRENCH DOOR ASSEMBLY BEAM	68033B
81	-----	#10-24 X 2 1/2" PH SCREW	
82	-----	#10-24 HEX NUT	
83	-----	#12 X 1 1/2" TR HD TEK SCREW	
84	8056	SUBSILL (OPTIONAL)	68056

GLASS, BEADS & SILICONE

ITEM	DWG#	DESCRIPTION	PGT#
90	-----	GLAZING SEALANT, DOW CORNING 791, 899, 983 OR 995	
100	-----	3/16" TEMPERED GLASS	
101	-----	7/8" I.G GLASS (3/16" T, 1/2" AIR SPACE, 3/16" T)	
102	8025	3/16" BEAD	68025
105	8022	BACK BEAD	68022
106	8026A	SL BACK BEAD	68026A
108	8024A	7/8" IG BEAD	68024A
109	1224	VINYL BULB WSTP (THICK)	6TP247

ANCHOR/SUBSTRATE MATERIAL PROPERTIES:

Material	Min. F _y	Min. F _u
#12 Steel Screw	92 ksi	120 ksi
#12 18-8 Screw	60 ksi	95 ksi
#12 410 Screw	90 ksi	110 ksi
1/4" Elco UltraCon®	155 ksi	177 ksi
1/4" DeWalt UltraCon+®	148 ksi	164 ksi
1/4" 410 SS Elco/Dewalt CreteFlex®	127.4 ksi	189.7 ksi
6063-T5 Aluminum	16 ksi	22 ksi
A36 Steel	36 ksi	58 ksi
Gr. 33 Steel Stud	33 ksi	45 ksi


Revised By:	Date:	Revisions:	
AGK	04/17/20	G	ADDED BACKBEDDING
Drawn By:	Date:	Checked By:	Date:
F.K.	12/30/04		

1070 TECHNOLOGY DRIVE
N. VENICE, FL 34275
(941) 480-1600
REGISTRATION #29296




Description:
PARTS LIST
Title:
ALUM. FRENCH DOOR & SIDE LITES, NON-IMPACT
Series/Model: FD650
Scale: NA
Sheet: 6 of 11
Drawing No. 8000-12
Rev: G


PRODUCT REVIEWED
as complying with the Florida
Building Code
Acceptance No. 20-0427-04
Expiration Date 3/24/25
A. Lynn Miller
Walter Reed Product Control

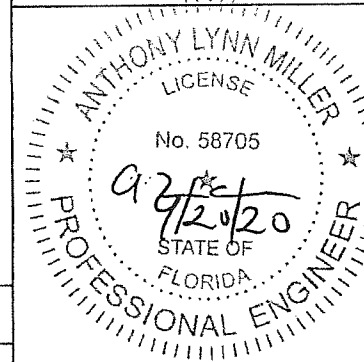

A. LYNN MILLER, P.E.
FL P.E.# 58705

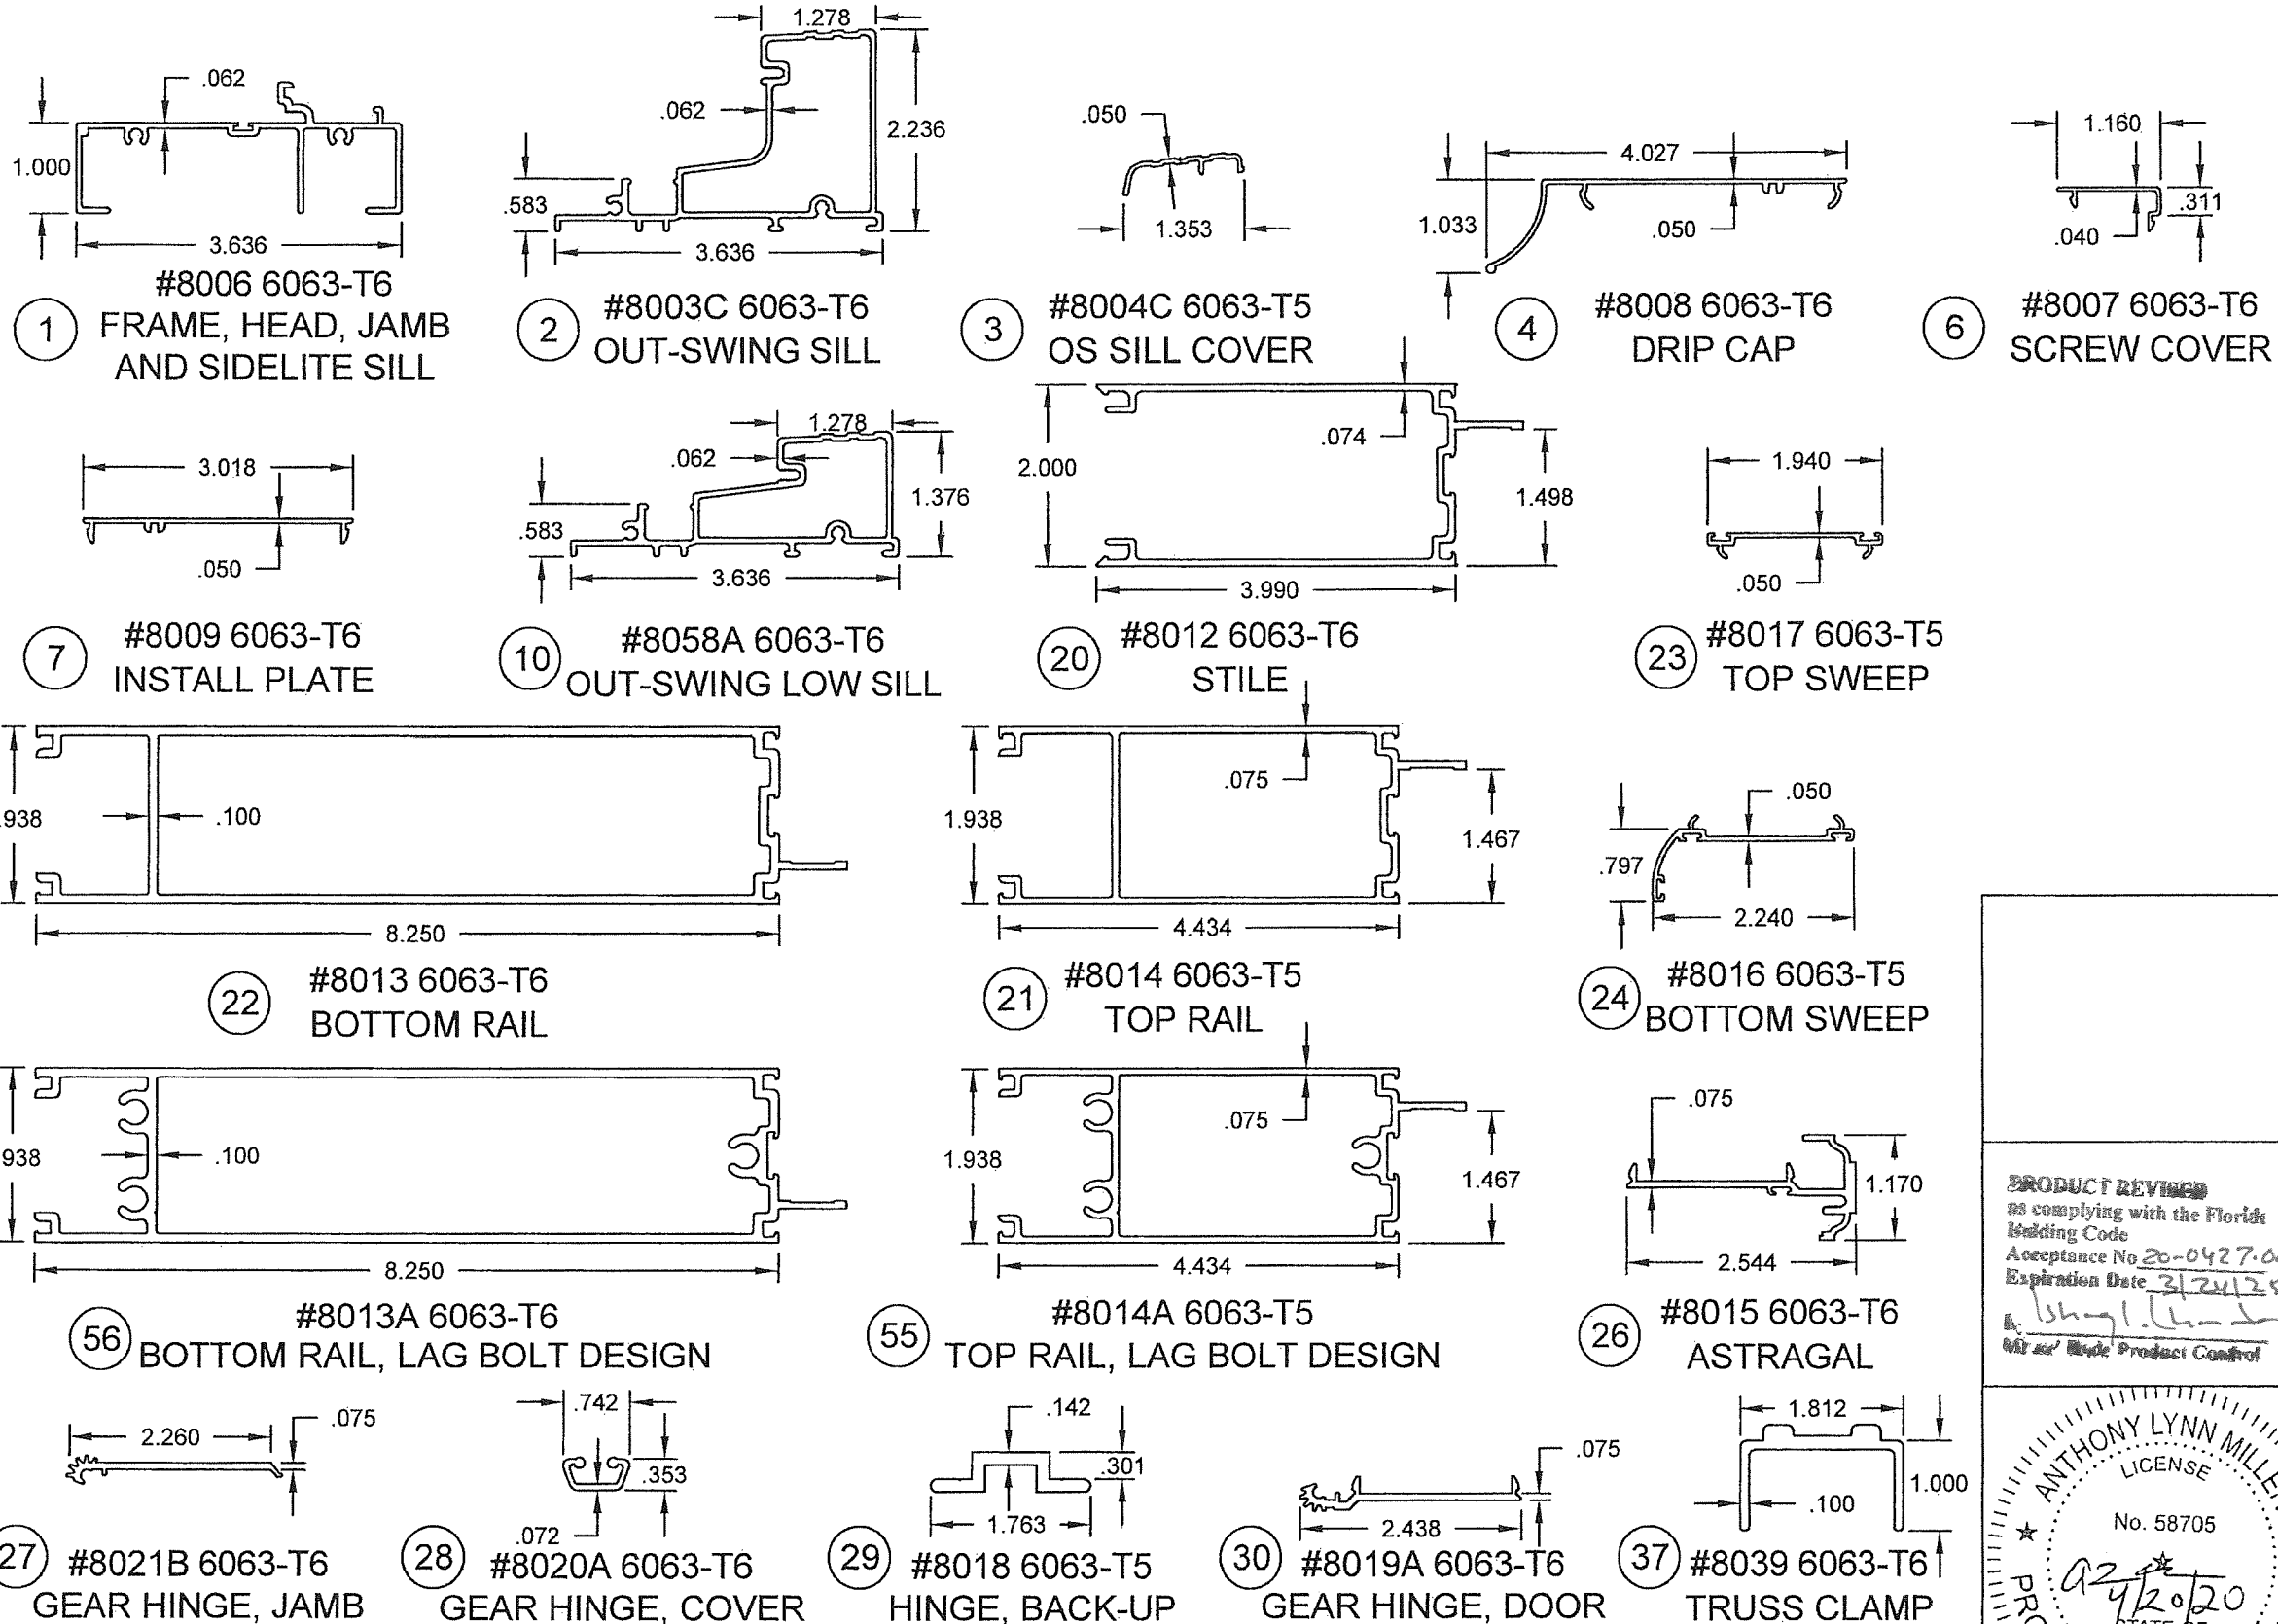


PRODUCT REVIEWED
 as complying with the Florida
 Building Code
 Acceptance No. 20-0427.04
 Expiration Date 3/24/25
 A. Lynn Miller
 Millers' Made Product Control

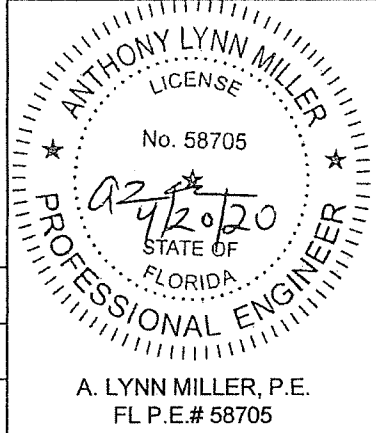


Revised By:	Date:	Revisions:	NO CHANGES THIS SHEET.
AGK	04/17/20	G	
Drawn By:	Date:	Checked By:	Date:
F.K.	12/30/04		

1070 TECHNOLOGY DRIVE
 N. VENICE, FL 34275
 (941) 480-1600
 REGISTRATION #29296

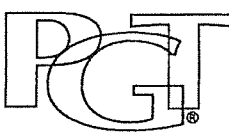


Description: EXTRUSION PROFILES				
Title: ALUM. FRENCH DOOR & SIDE LITES, NON-IMPACT				
Series/Model:	Scale:	Sheet:	Drawing No.:	Rev.:
FD650	1/2	7 of 11	8000-12	G


A. LYNN MILLER, P.E.
 FL P.E.# 58705

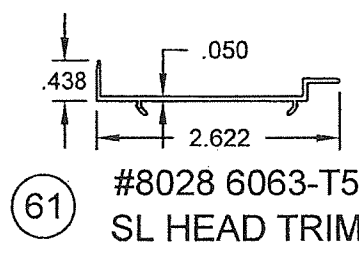


61 #8028 6063-T5
SL HEAD TRIM

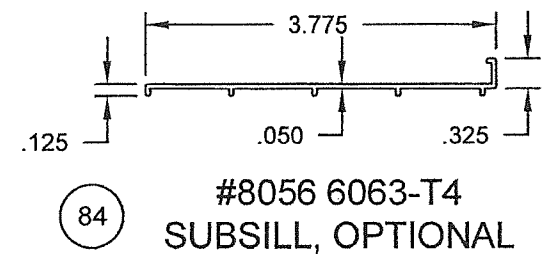


84 #8056 6063-T4
SUBSILL, OPTIONAL

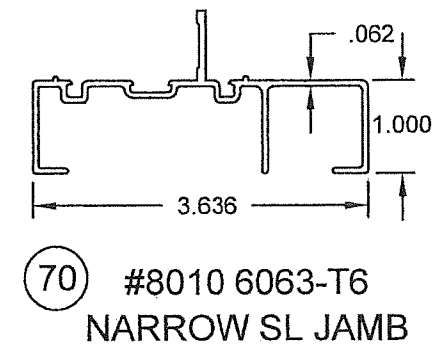


70 #8010 6063-T6
NARROW SL JAMB

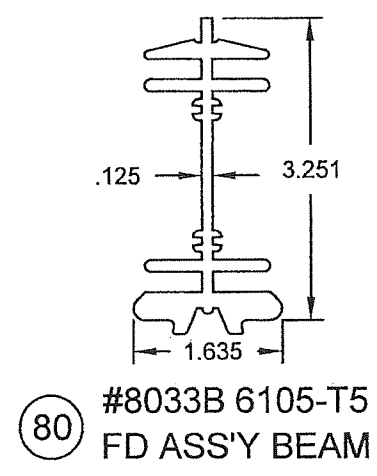


80 #8033B 6105-T5
FD ASS'Y BEAM

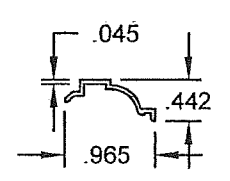


105 #8022 6063-T5
BACKBEAD

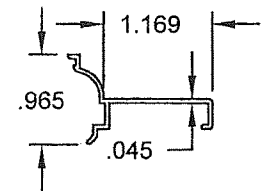


106 #8026A 6063-T5
SL BACKBEAD

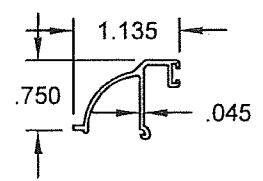


102 #8025 6063-T5
3/16" BEAD

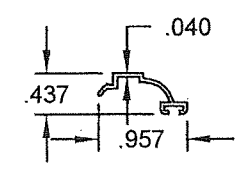


108 #8024A 6063-T5
I.G. BEAD

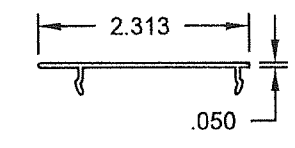


62 #8029 6063-T5
SL JAMB TRIM

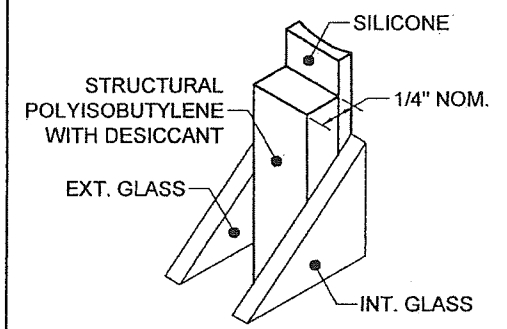


110 KODISPACE
4SG TPS

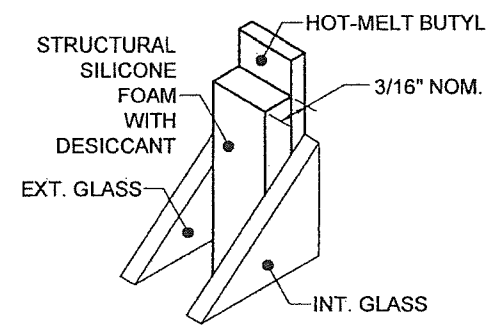

111 SUPER
SPACER[®] NXT[™]

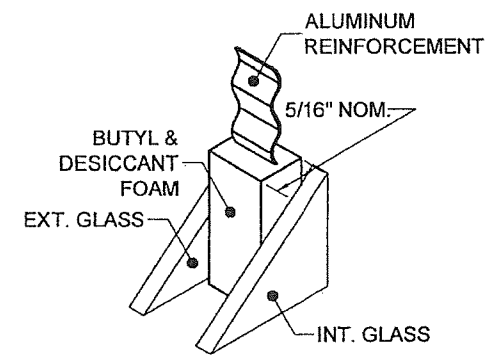

112 DURASEAL[®]
SPACER

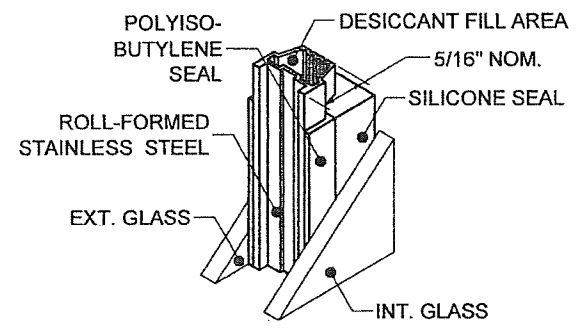


113 XL EDGE[™]
SPACER

Part #	Description	Material
110	Kommerling 4SG TPS Spacer System	See this Sheet for Materials
111	Quanex Super Spacer nXT with Hot Melt Butyl	
112	Quanex Duraseal Spacer	
113	Cardinal XL Edge Spacer	

REFERENCE TEST REPORTS: FTL-8717, 8968 & 8970


Revised By:	Date:	Revisions:	NO CHANGES THIS SHEET.
AGK	04/17/20	G	
Drawn By:	Date:	Checked By:	Date:
F.K.	12/30/04		

1070 TECHNOLOGY DRIVE
N. VENICE, FL 34275
(941) 480-1800
REGISTRATION #29296

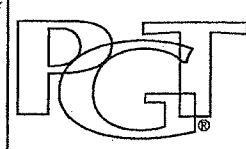


Description: EXTRUSION PROFILES (CONT.)				
Title: ALUM. FRENCH DOOR & SIDE LITES, NON-IMPACT				
Series/Model: FD650	Scale: 1/2	Sheet: 8 of 11	Drawing No. 8000-12	Rev. G

PRODUCT REVIEWED
as complying with the Florida
Building Code
Acceptance No. 20-0427.04
Expiration Date 3/24/25
Anthony Lynn Miller
Product Control

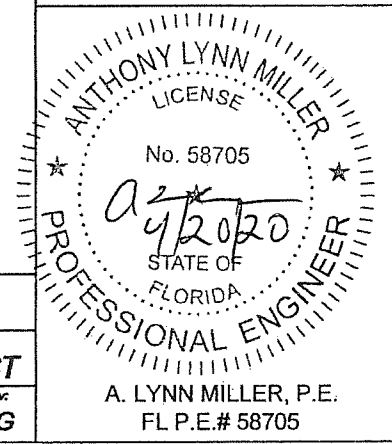

A. LYNN MILLER, P.E.
FL P.E.# 58705

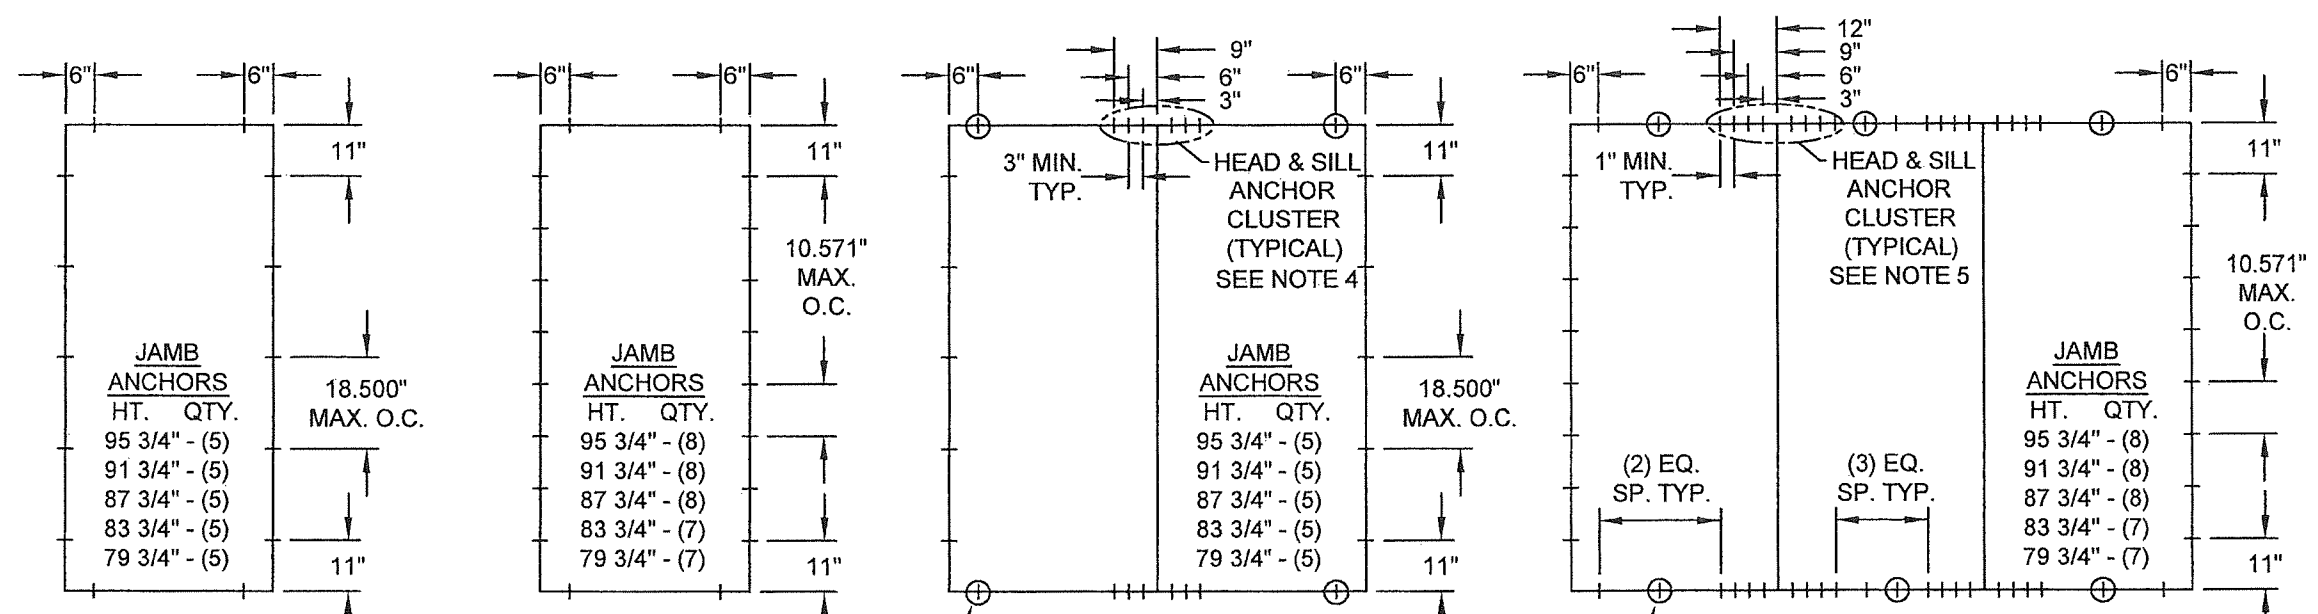

DETAIL A (CONCRETE)
(SINGLE PANEL)
ANCHOR TYPES:
B OR C

DETAIL B (WOOD/ALUM.)
(SINGLE PANEL)
ANCHOR TYPES:
C OR A

DETAIL C (CONCRETE)
(2 OR MORE PANELS)
ANCHOR TYPES:
B OR C

DETAIL D (WOOD/ALUM.)
(2 OR MORE PANELS)
ANCHOR TYPES:
C OR A

SEE NOTE 5 REGARDING APPLICABILITY OF CIRCLED ANCHOR LOCATIONS

SEE NOTE 4 REGARDING APPLICABILITY OF CIRCLED ANCHOR LOCATIONS

ANCHORAGE SPACING REQUIREMENTS:

1. DETAILS A AND B ABOVE REPRESENT ANCHORING OF SINGLE X DOORS, OR INDIVIDUAL SIDE LITE O PANELS WITH FULL OR NARROW WIDTH JAMBS. DETAILS C AND D ABOVE REPRESENT ANCHORING OF ANY MIXTURE OF DOUBLE XX DOORS, SINGLE X DOORS, NARROW JAMB OR FULL JAMB SIDE LITE PANELS, FOR MULTIPLE-PANEL INSTALLATIONS OF TWO OR MORE PANELS. UNLESS OTHERWISE STATED, DIMENSIONS OF DETAILS A THROUGH D ARE MAXIMUMS.

2. ANCHOR TYPES: SEE TABLE A, SHEET 1 FOR ANCHOR TYPES, SUBSTRATES AND LIMITATIONS.

3. SINGLE PANEL CONFIGURATIONS: (DETAIL A, CONCRETE SUBSTRATE. DETAIL B, WOOD/ALUM. SUBSTRATE)

HEAD AND SILL.....6" MAX. FROM FRAME CORNERS.
JAMBS.....11" MAX. FROM FRAME CORNERS, 18.500" MAX. O.C. CONCRETE SUBSTRATE (DETAIL A) AND 10.571" MAX. O.C. WOOD SUBSTRATE (DETAIL B).

4. TWO OR MORE PANEL CONFIGURATIONS: (DETAIL C, CONCRETE SUBSTRATE)

HEAD AND SILL: 6" MAX. FROM FRAME CORNERS IF PANEL WIDTH IS 15" OR GREATER AND AT 3", 6" AND 9" MAX. ON EACH SIDE OF ASSEMBLY BEAM AND/OR ASTRAGAL LOCATIONS (CLUSTER OF 6).


JAMBS: 11" MAX. FROM FRAME CORNERS AND 18.500" MAX. O.C

5. TWO OR MORE PANEL CONFIGURATIONS: (DETAIL D, WOOD/ALUM. SUBSTRATE)

HEAD AND SILL: 6" MAX. FROM FRAME CORNERS AND AT 3", 6", 9" AND 12" MAX. ON EACH SIDE OF ASSEMBLY BEAM AND/OR ASTRAGAL LOCATIONS (CLUSTER OF 8). CIRCLED ANCHOR OUTSIDE CLUSTER REQUIRED IF PANEL WIDTH IS OVER 27-3/4".

JAMBS: 11" MAX. FROM FRAME CORNERS AND 10.571" MAX. O.C

PRODUCT REVIEWED
as complying with the Florida
Building Code
Acceptance No 20-0427.04
Expiration Date 3/24/25
by Lynn Miller
Manufacturer Product Control

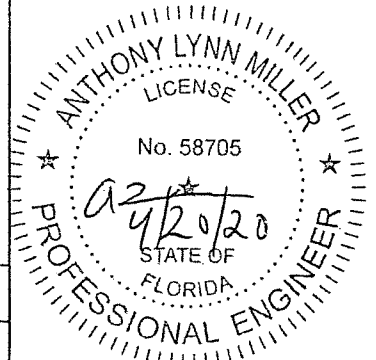


A. LYNN MILLER, P.E.
FL P.E.# 58705

1070 TECHNOLOGY DRIVE
N. VENICE, FL 34275
(941) 480-1600
REGISTRATION #29296




Description: ANCHORAGE SPACING		Title: ALUM. FRENCH DOOR & SIDE LITES, NON-IMPACT	
Series/Model: FD650	Scale: NTS	Sheet: 9 of 11	Drawing No.: 8000-12
Revised By: AGK		Date: 04/17/20	Revised By: G
Drawn By: F.K.		Date: 12/30/04	Checked By: Date:

NO CHANGES THIS SHEET.

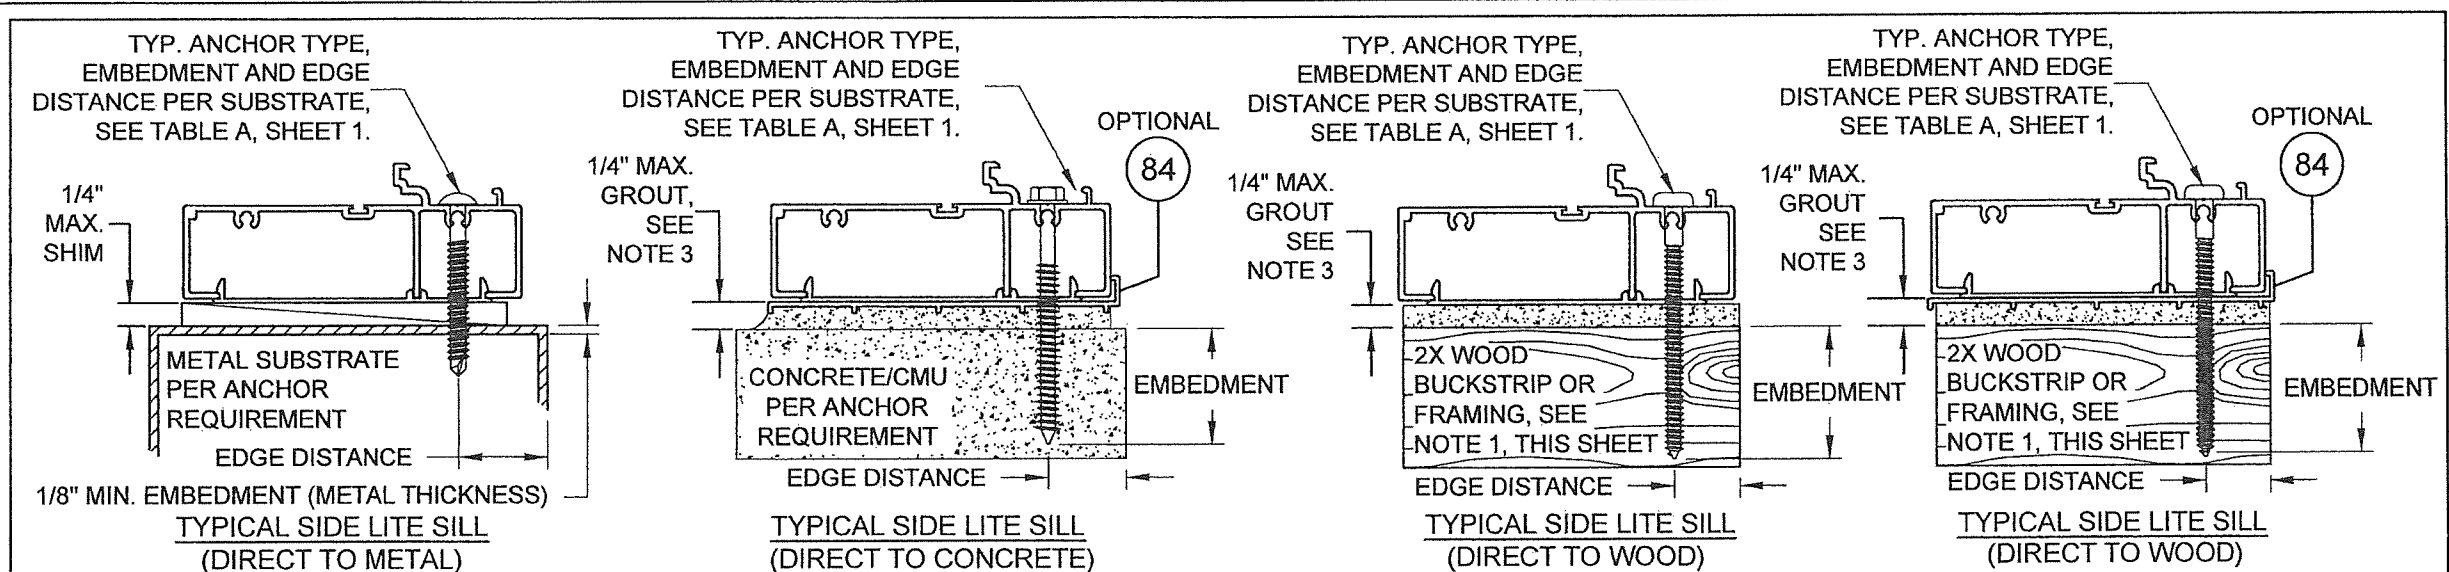

← EXTERIOR INTERIOR →
(ALL HEAD & SILL SECTIONS)

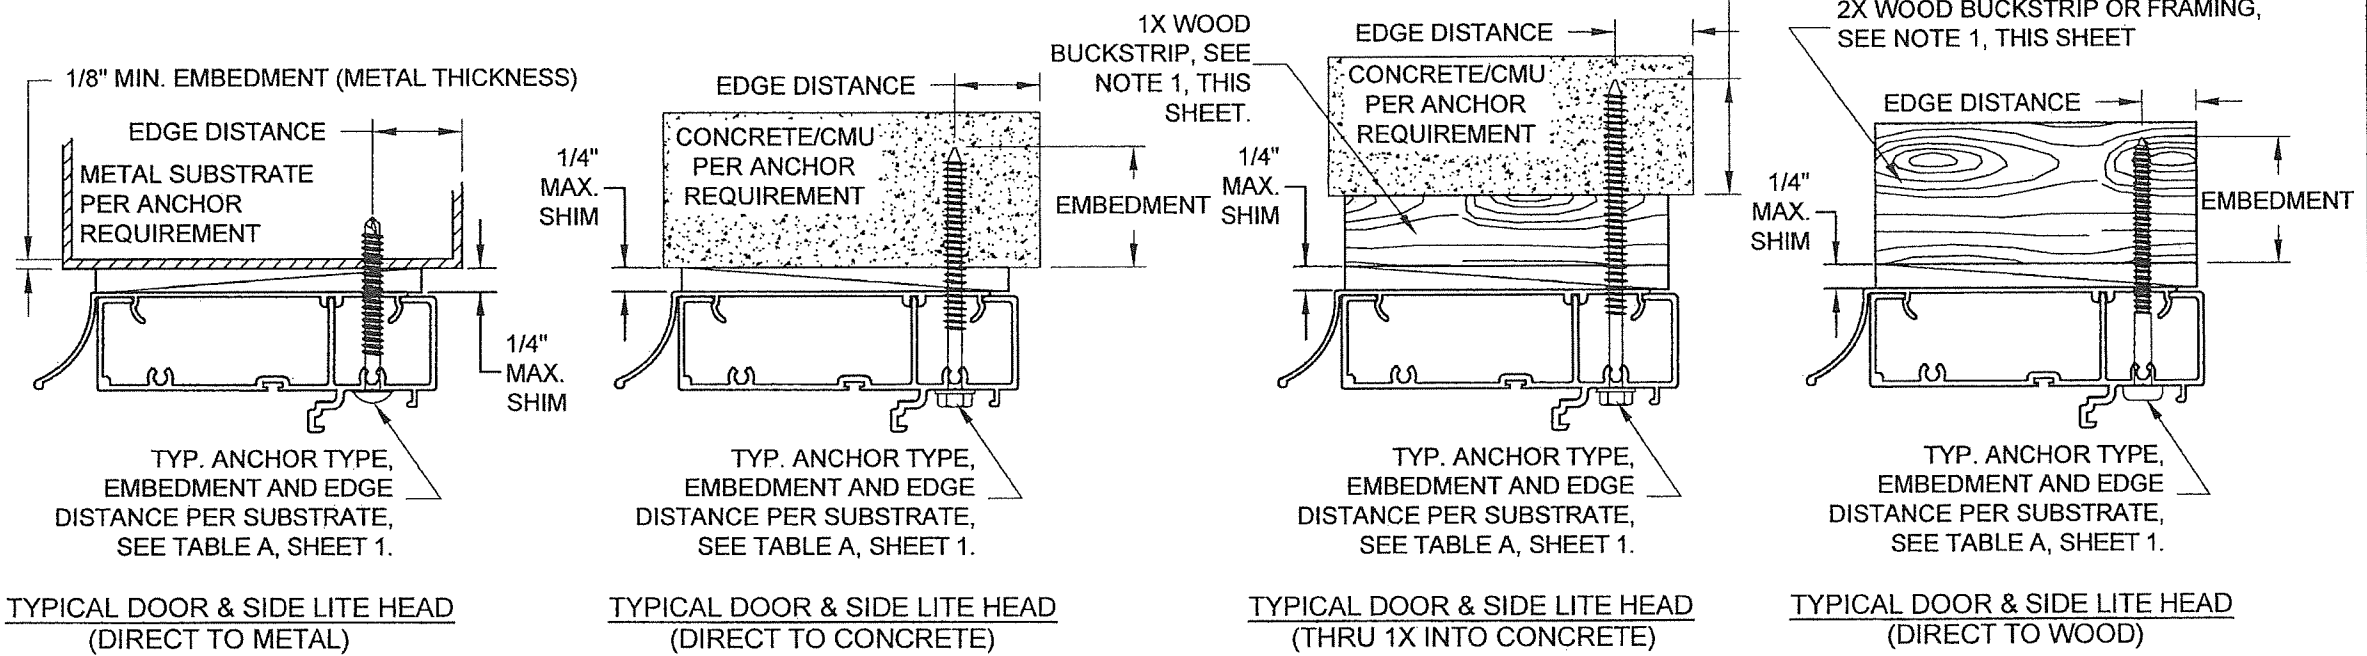


- NOTES:**
- WOOD BUCKS DEPICTED AS 1x ARE LESS THAN 1-1/2" THICK. 1x WOOD BUCKS ARE OPTIONAL IF UNIT IS INSTALLED DIRECTLY TO SOLID CONCRETE. WOOD BUCKS DEPICTED AS 2x ARE 1-1/2" THICK OR GREATER. INSTALLATION TO THE SUBSTRATE OF WOOD BUCKS TO BE ENGINEERED BY OTHERS OR AS APPROVED BY THE AUTHORITY HAVING JURISDICTION (AHJ).
 - FOR ATTACHMENT TO ALUM: THE MAT'L SHALL BE A MIN. STRENGTH OF 6063-T5 AND A MIN. OF 1/8" THICK. THE ALUM. STRUCTURAL MEMBER SHALL BE OF A SIZE TO PROVIDE FULL SUPPORT TO THE DOOR FRAME SIMILAR TO THAT SHOWN IN THE DETAILS ON THIS SHEET FOR 2x WOOD BUCKS. THE ANCHOR SHALL BE A #12 SMS WITH FULL ENGAGEMENT INTO THE ALUM. IF THESE CRITERIA ARE MET, THE PRESSURES SHOWN ON SHEET 2 AND ANCHORAGE SPACING FOR WOOD SHOWN ON SHEET 10 MAY BE USED.
 - IF SILL IS TIGHT TO SUBSTRATE, GROUT OR OTHER MATERIAL IS NOT REQUIRED. IF USED, NON-SHRINK, NON-METALLIC GROUT, 3400 PSI MIN., (DONE BY OTHERS) MUST FULLY SUPPORT THE ENTIRE LENGTH OF THE SILL THAT IS NOT TIGHT TO THE SUBSTRATE, AND TRANSFER SHEAR LOAD TO SUBSTRATE.


<p>PRODUCT REVIEWED as complying with the Florida Building Code Acceptance No. 20-0427.04 Expiration Date 3/24/25</p> <p><i>[Signature]</i> Manufactured Product Control</p>	<p>1070 TECHNOLOGY DRIVE N. VENICE, FL 34275 (941) 480-1600</p> <p>CERT. OF AUTH. #29296</p>			<p>Description: ANCHORAGE DETAILS</p> <p>Title: ALUM. FRENCH DOOR & SIDE LITES, NON-IMPACT</p>			
	<p>Revised By: AGK Date: 04/17/20</p>	<p>Date: 04/17/20</p>		<p>Revisions: G</p>	<p>Series/Model: FD-650</p>	<p>Scale: 1/4</p>	<p>Sheet: 10 of 11</p>
<p>NO CHANGES THIS SHEET.</p>			<p>Drawn By: F.K. Date: 12/30/04</p>	<p>Checked By: [Blank] Date: [Blank]</p>			

ANTHONY LYNN MILLER
LICENSE
No. 58705
4/20/20
STATE OF
FLORIDA
PROFESSIONAL ENGINEER


A. LYNN MILLER, P.E.
FL P.E.# 58705

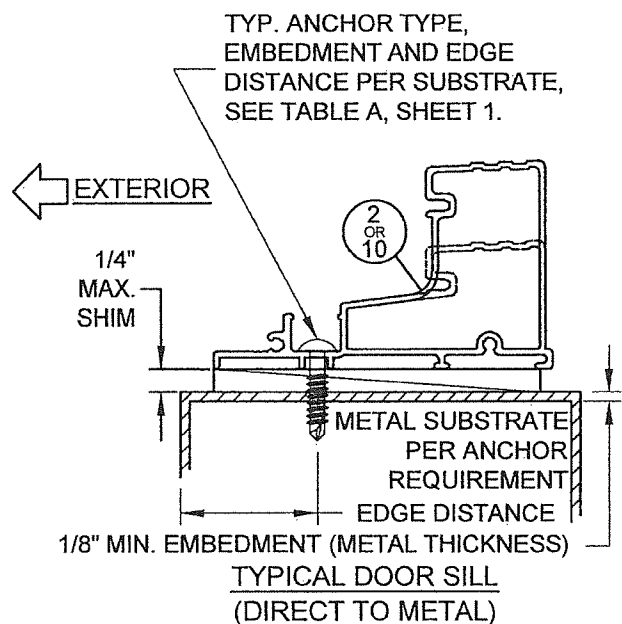


TYPICAL DOOR SILL
(DIRECT TO METAL)

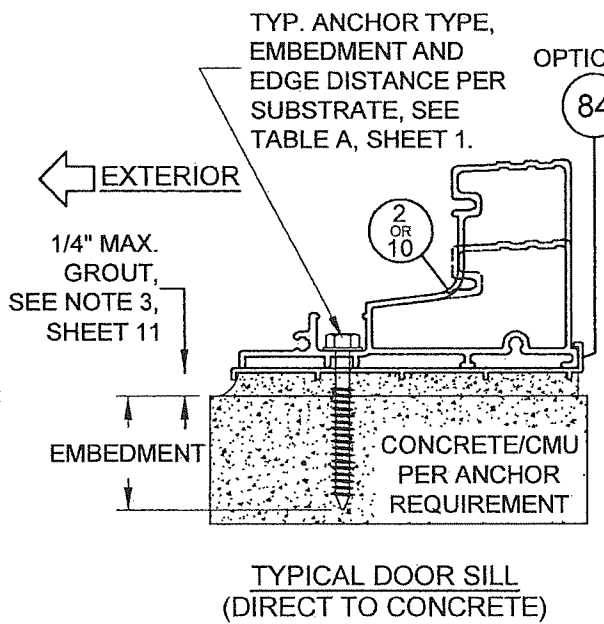


TYPICAL DOOR SILL
(DIRECT TO CONCRETE)

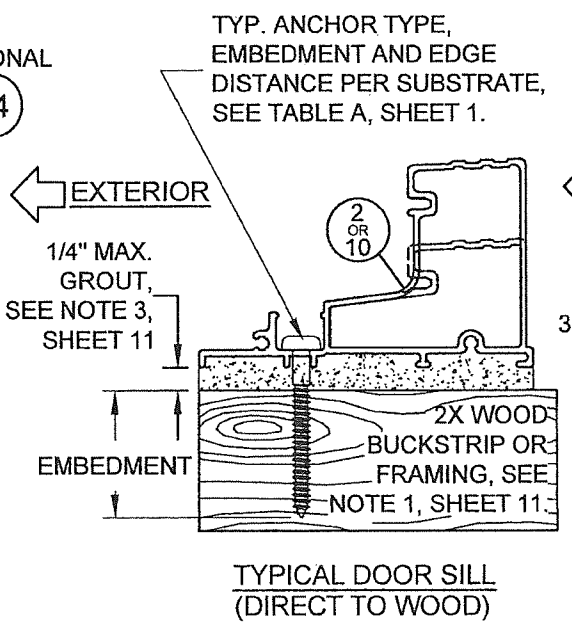


TYPICAL DOOR SILL
(DIRECT TO WOOD)

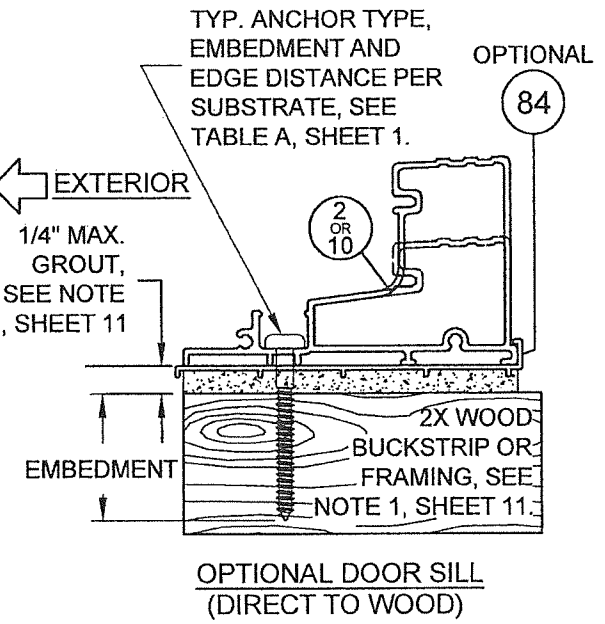


OPTIONAL DOOR SILL
(DIRECT TO WOOD)

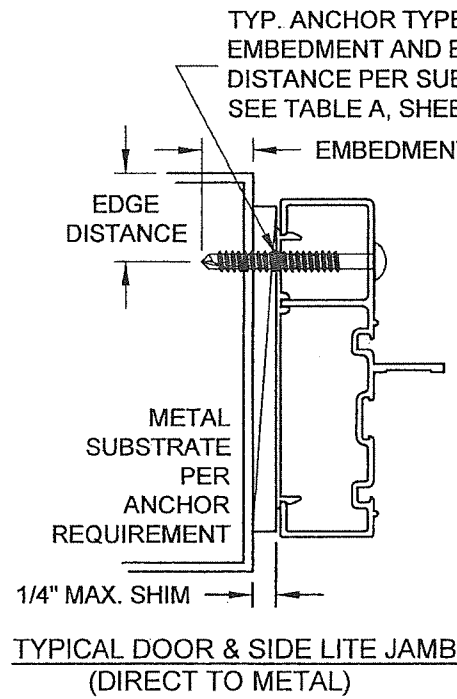


TYPICAL DOOR & SIDE LITE JAMB
(DIRECT TO METAL)

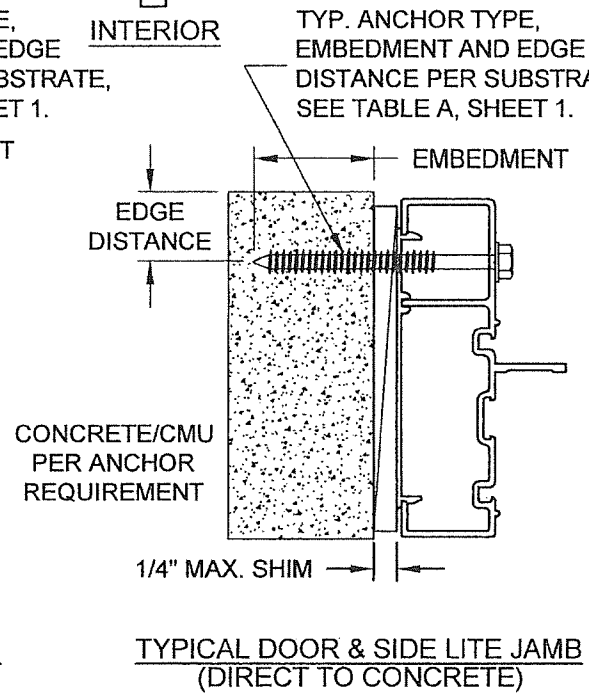

TYPICAL DOOR & SIDE LITE JAMB
(DIRECT TO CONCRETE)

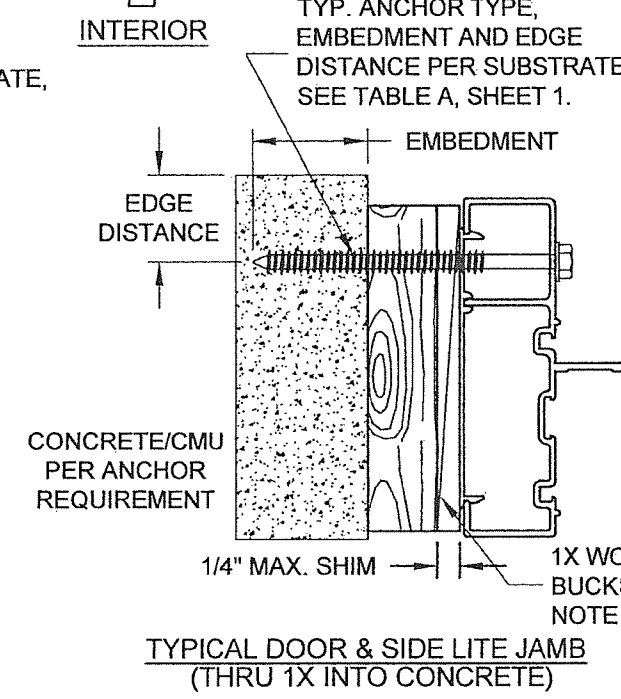


TYPICAL DOOR & SIDE LITE JAMB
(THRU 1X INTO CONCRETE)

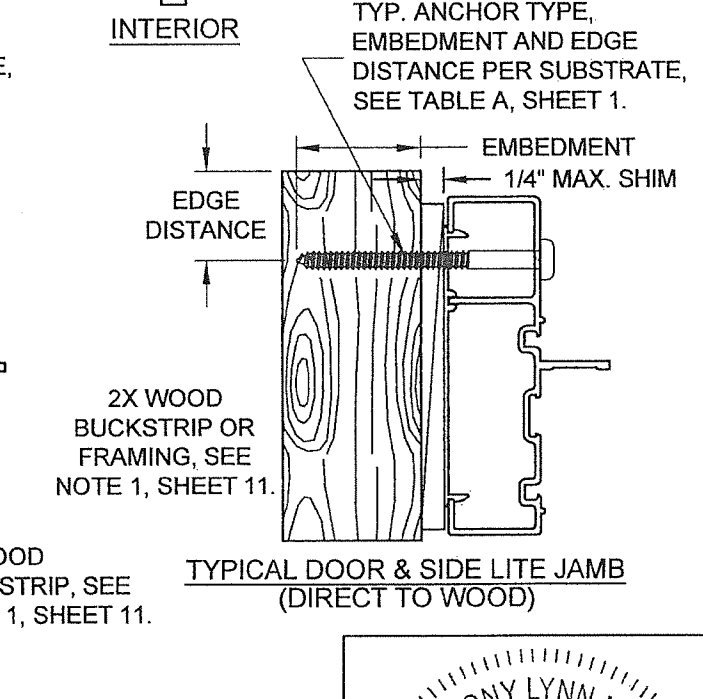

TYPICAL DOOR & SIDE LITE JAMB
(DIRECT TO WOOD)

PRODUCT REVISED
as complying with the Florida
Building Code
Acceptance No. 20-0427-04
Expiration Date 11/24/2025
A. Lynn Miller
Professional Engineer

1070 TECHNOLOGY DRIVE
N. VENICE, FL 34275
(941) 480-1600
CERT. OF AUTH. #29296

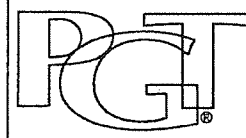

Description:
ANCHORAGE DETAILS
This:
ALUM. FRENCH DOOR & SIDE LITES, NON-IMPACT
Series/Model: **FD-650** Scale: **1/4** Sheet: **11 of 11** Drawing No.: **8000-12**

Revised By: **AGK** Date: **04/17/20** Revisions: **G** NO CHANGES THIS SHEET. Drawn By: **F.K.** Date: **12/30/04** Checked By: _____ Date: _____

