

B-193

SW 24TH ST

CORAL GABLES

SW 24TH ST

WAY 38-27

SEC. 14

TWP. 54

RGE. 40

NOTE THIS DRAWING, MAP OR RECORD DOCUMENT IS PROVIDED AS A GUIDE ONLY. FLORIDA CITY GAS DOES NOT WARRANT THE ACCURACY OF THIS DOCUMENT. THIS DOCUMENT IS NOT A MEANS FOR LOCATING UNDERGROUND FACILITIES. UNDER FLORIDA LAW, YOU MUST CONTACT THE SUNSHINE STATE ONE CALL OF FLORIDA AT 811 PRIOR TO ANY EXCAVATIONS.



4B-228

AB-211

AB-211


AB-29

AB-29

AB-29

SOUTH MIAMI

Sec. 2
Twp. 54
Rge. 40

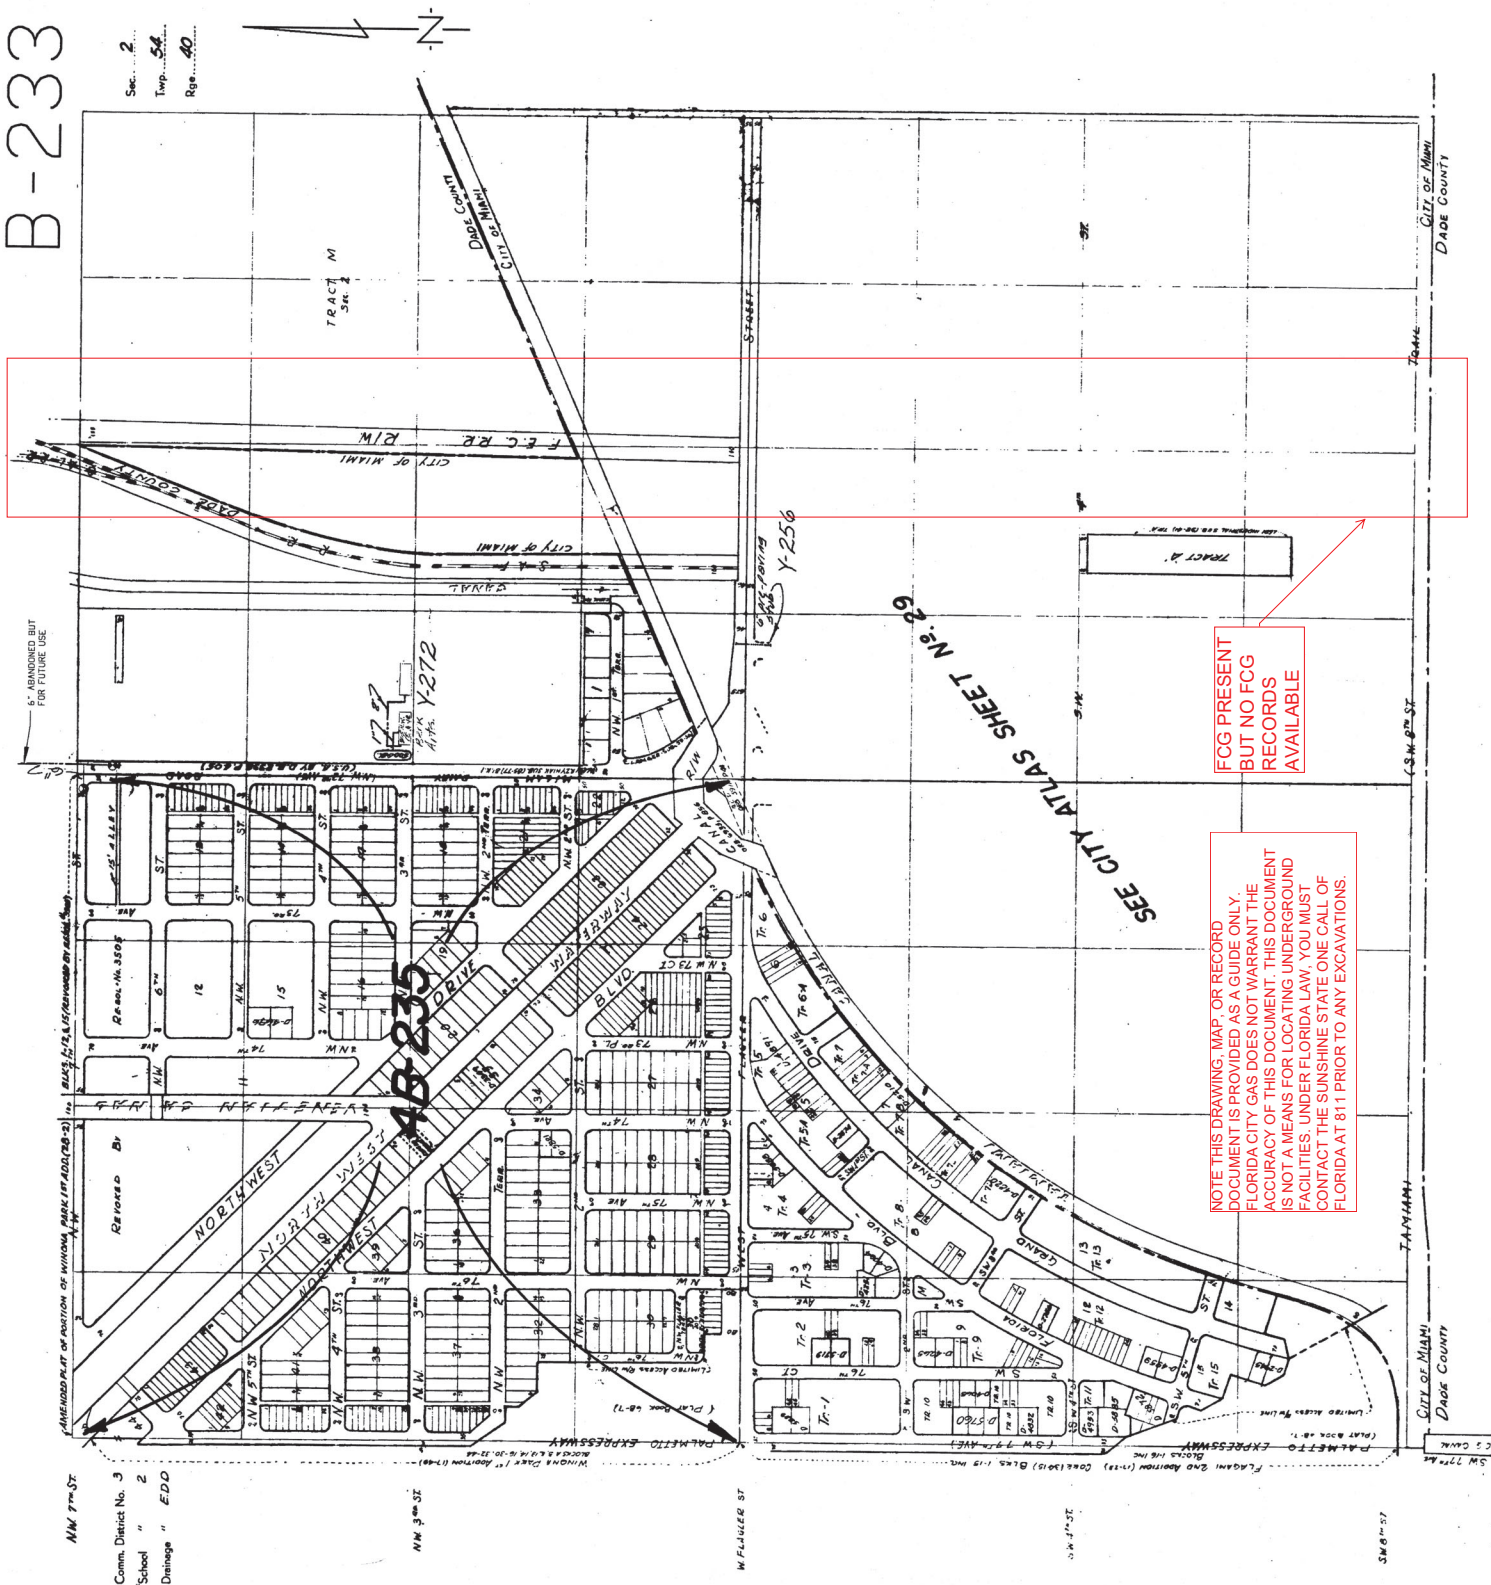

FCG PRESENT
BUT NO FCG
RECORDS
AVAILABLE

NOTE THIS DRAWING, MAP, OR RECORD DOCUMENT IS PROVIDED AS A GUIDE ONLY. FLORIDA CITY GAS DOES NOT WARRANT THE ACCURACY OF THIS DOCUMENT. THIS DOCUMENT IS NOT A MEANS FOR LOCATING UNDERGROUND FACILITIES. UNDER FLORIDA LAW, YOU MUST CONTACT THE SUNSHINE STATE ONE CALL OF FLORIDA AT 811 PRIOR TO ANY EXCAVATIONS.

Appendix C – Mark Ups from:

AT&T FL

AT&T Corp

Atlantic Broadband

CenturyLink Level 3 (Lumen)

Comcast

Crown Castle

Fiberlight (Atlantic Broadband)

Florida City Gas

Florida Gas Transmission

FPL Distribution

FPL Transmission

Hotwire

MCI/Verizon


Miami-Dade County Public Schools

Miami-Dade DTPW

Miami-Dade ITD



Miami-Dade Traffic Signals Dept

Miami-Dade WASD

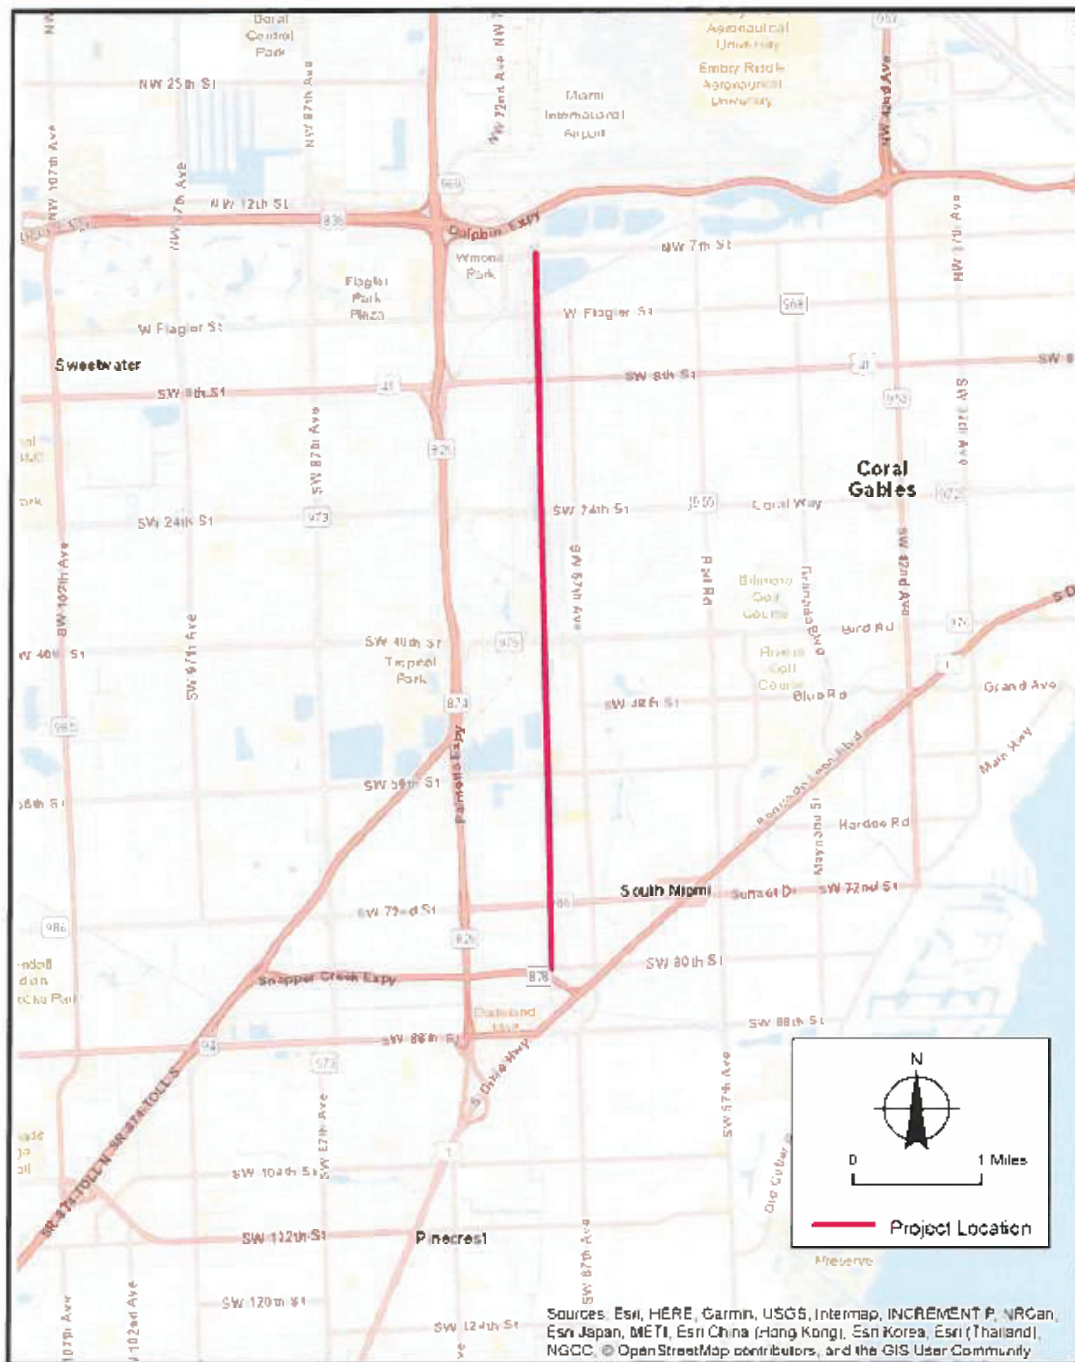

Project Location

Ludlam Trail from SW 80th Street to NW 7th Street, Miami-Dade County, Florida

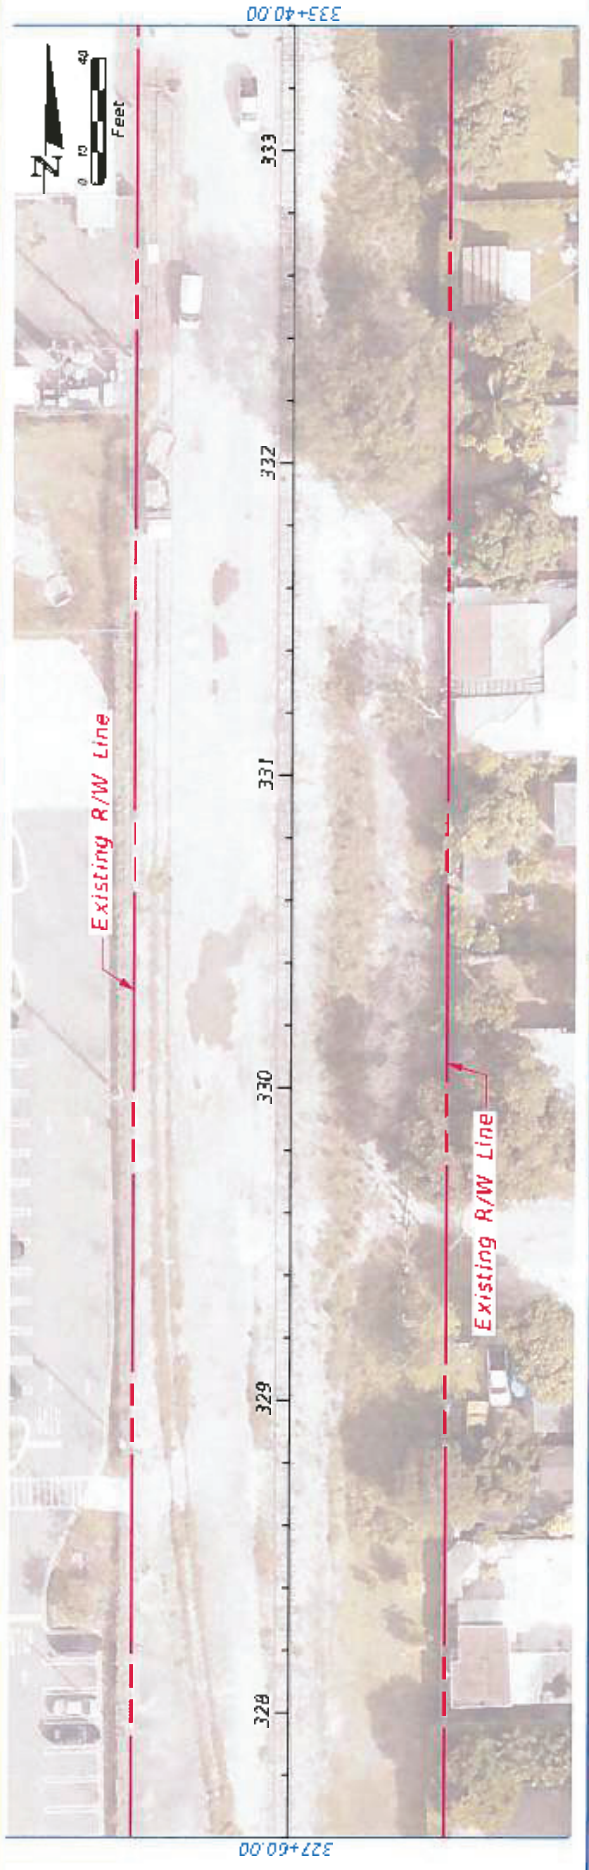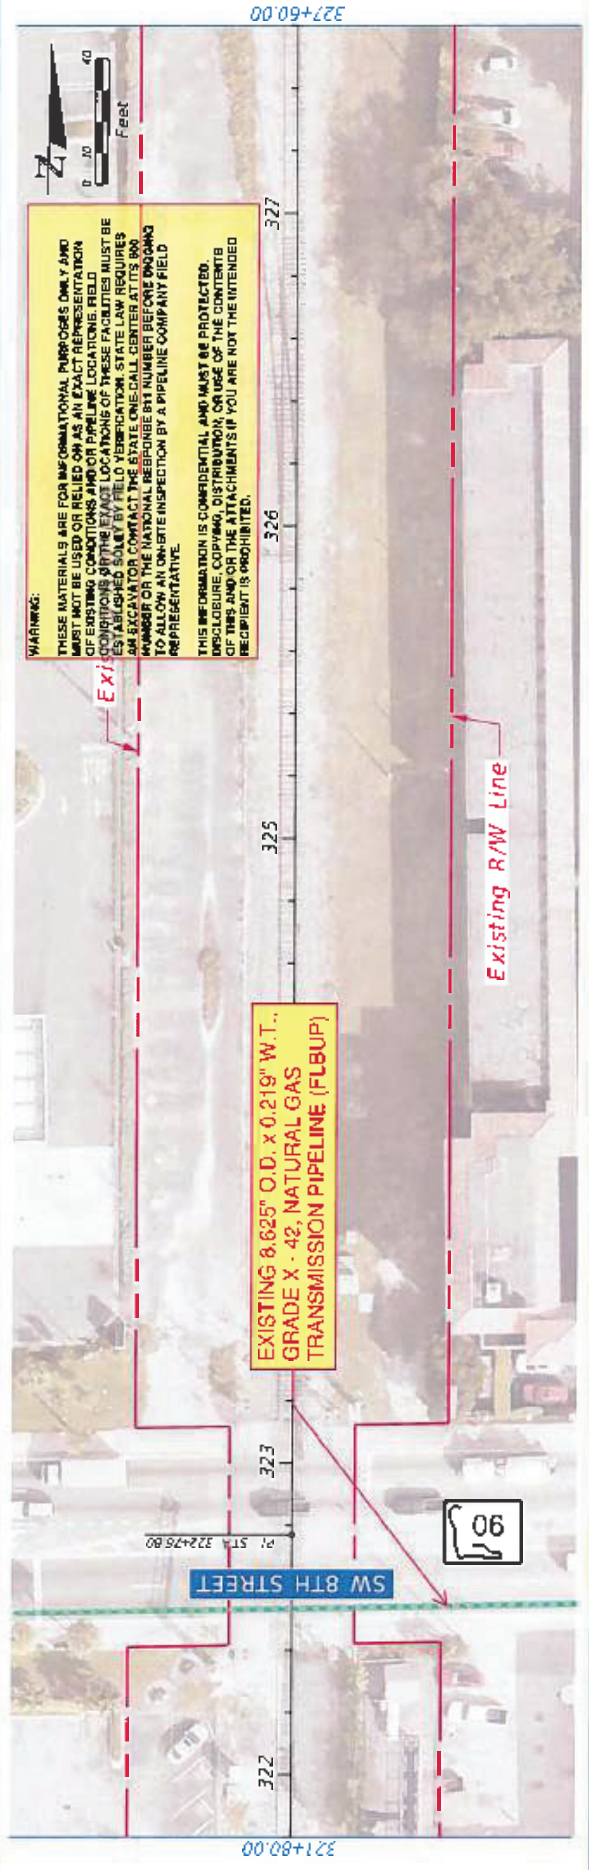

REVISIONS		DESCRIPTION	
DATE	DESCRIPTION	DATE	DESCRIPTION

MIAMI-DADE COUNTY		BASE MAP	
Miami-Dade County Parks, Recreation, & Open Spaces DIVISION	LUDLAM TRAIL CURNISH POLE STUDY	PLAN CONTRACT NO. REG. NO. 1828	SHEET NO. 22
275 NW 2nd Street Miami, FL 33136 305-355-7800	4500-17-001-148-008	REG. PROJECT NO. 4500-17-001-148-008	4500-17-001-148-008

Appendix C – Mark Ups from:

AT&T FL

AT&T Corp

Atlantic Broadband

CenturyLink Level 3 (Lumen)

Comcast

Crown Castle

Fiberlight (Atlantic Broadband)

Florida City Gas

Florida Gas Transmission

FPL Distribution

FPL Transmission

Hotwire

MCI/Verizon



Miami-Dade County Public Schools

Miami-Dade DTPW



Miami-Dade ITD

Miami-Dade Traffic Signals Dept

Miami-Dade WASD

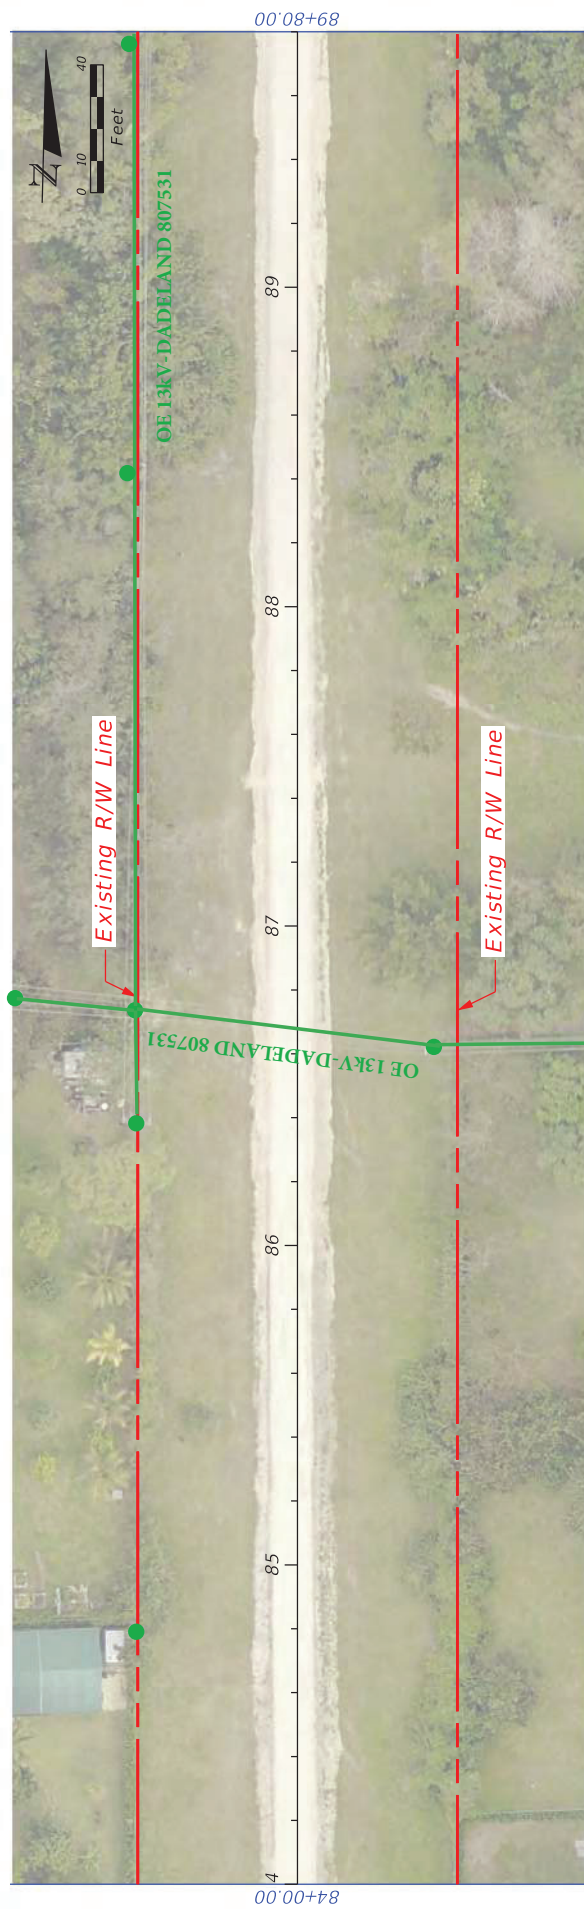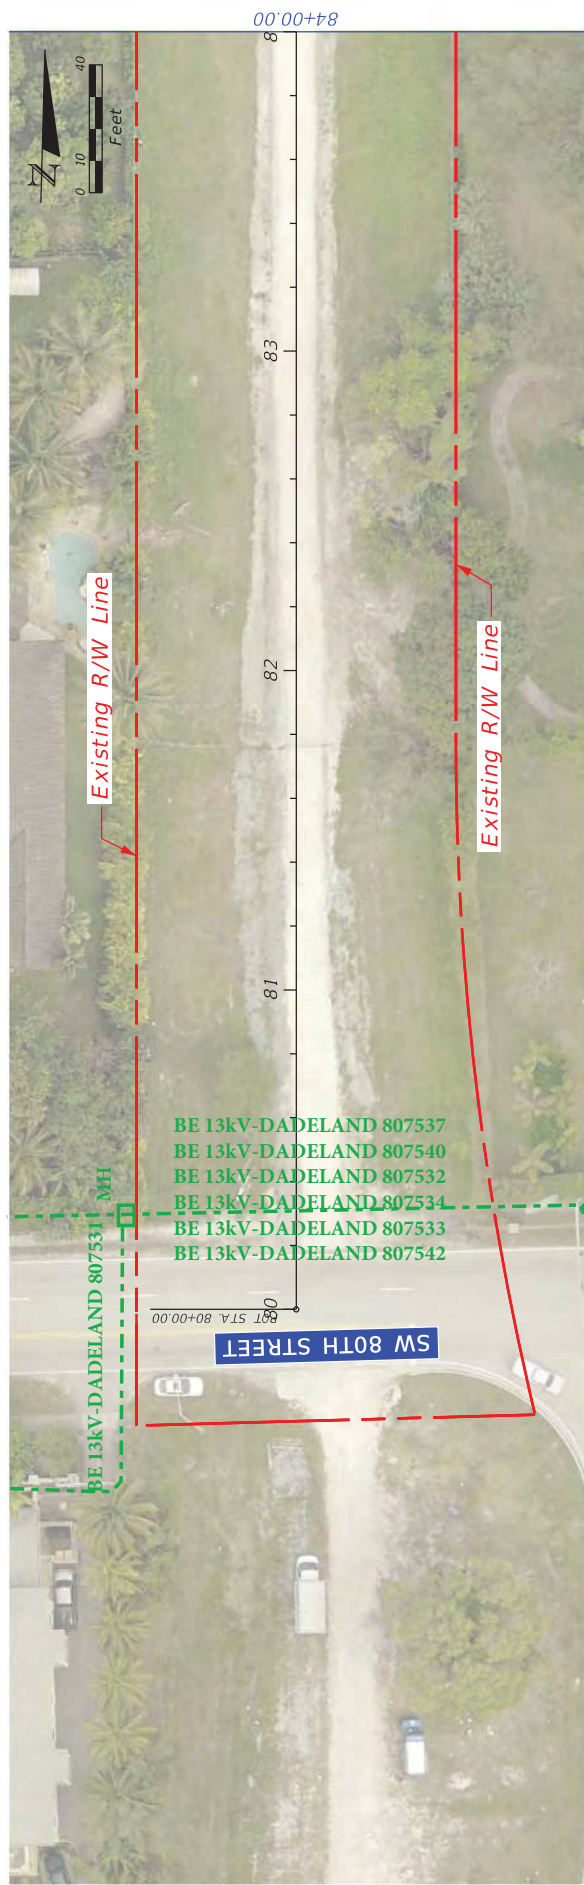

REVISIONS		LUDLAM TRAIL CORRIDOR PD&E STUDY		SHEET NO.
DATE	DESCRIPTION	DATE	DESCRIPTION	
		Miami-Dade County Parks, Recreation, and Open Spaces (MDPROS)		BASE MAP
		Hickman Building 275 NW 2nd Street Miami, FL 33128		
		P&R CONTRACT NO. RFQ 786B		
		P&R PROJECT NO. 43502-15-001-14470619		
01				

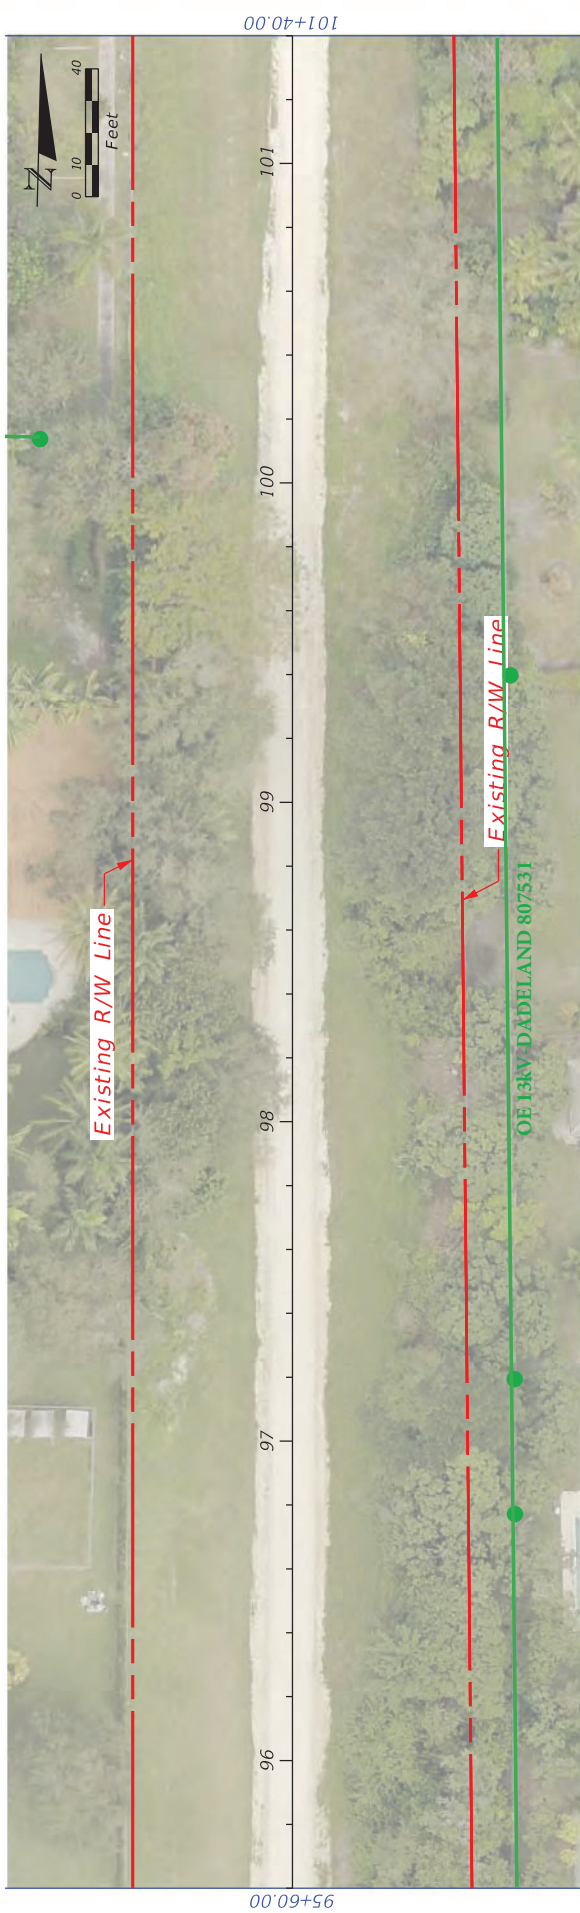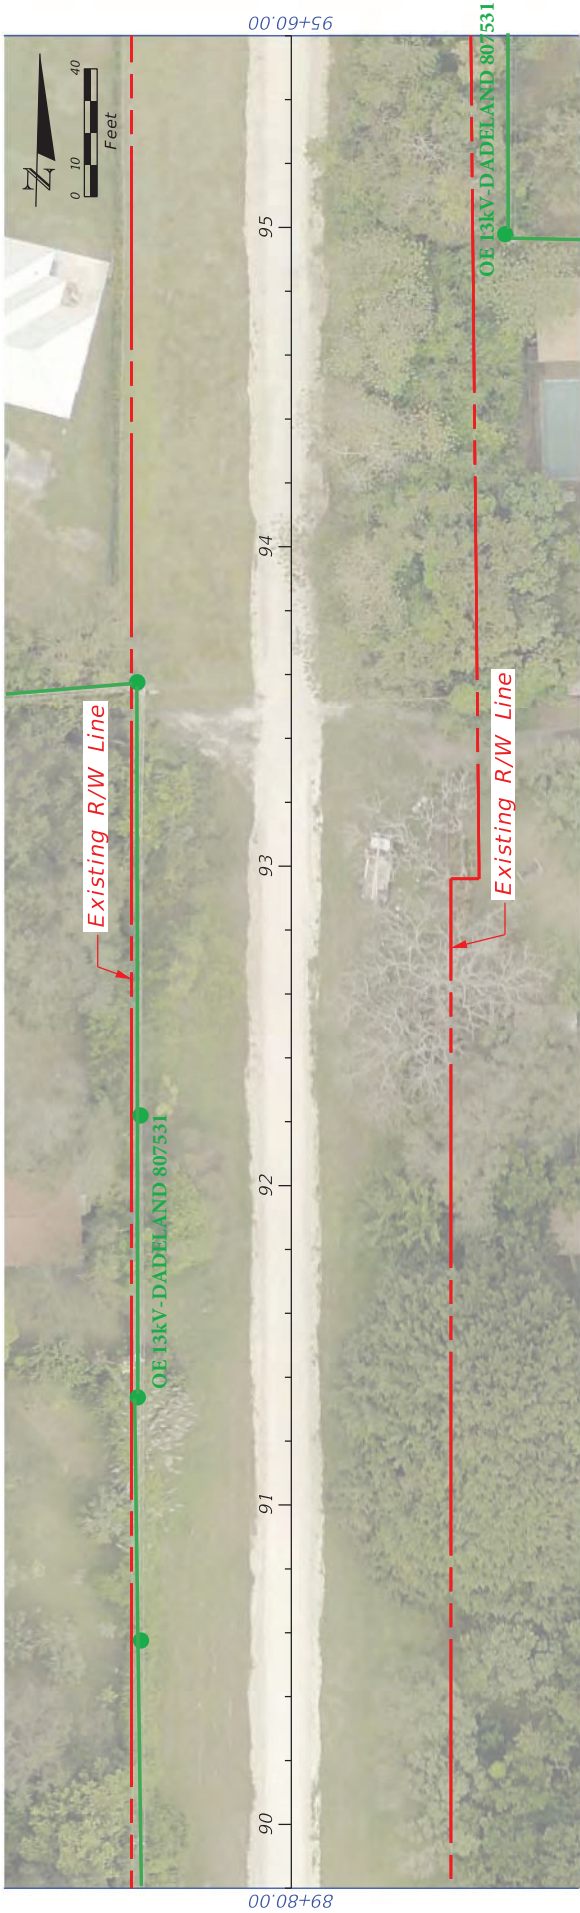

			LUDLAM TRAIL CORRIDOR PD&E STUDY		BASE MAP		SHEET NO.	
			Miami-Dade County Parks, Recreation, and Open Spaces (MDPROS)		Hickman Building 275 NW 2nd Street Miami, FL 33128 305-755-7800		P&R CONTRACT NO. RFO 7868 P&R PROJECT NO. 43502-15-001-14470619	
			MIAMI-DADE COUNTY				02	
			DESCRIPTION		DATE		REVISIONS	
			DESCRIPTION		DATE			



DATE	DESCRIPTION	DATE	DESCRIPTION



Miami-Dade County
 Parks, Recreation, and
 Open Spaces
 (MDPROS)

Hickman Building
 275 NW 2nd Street
 Miami, FL 33128
 305-355-7800


P&R CONTRACT NO.
 4350215-001-14470619

P&R PROJECT NO.
 4350215-001-14470619



BASE MAP

SHEET NO.

06

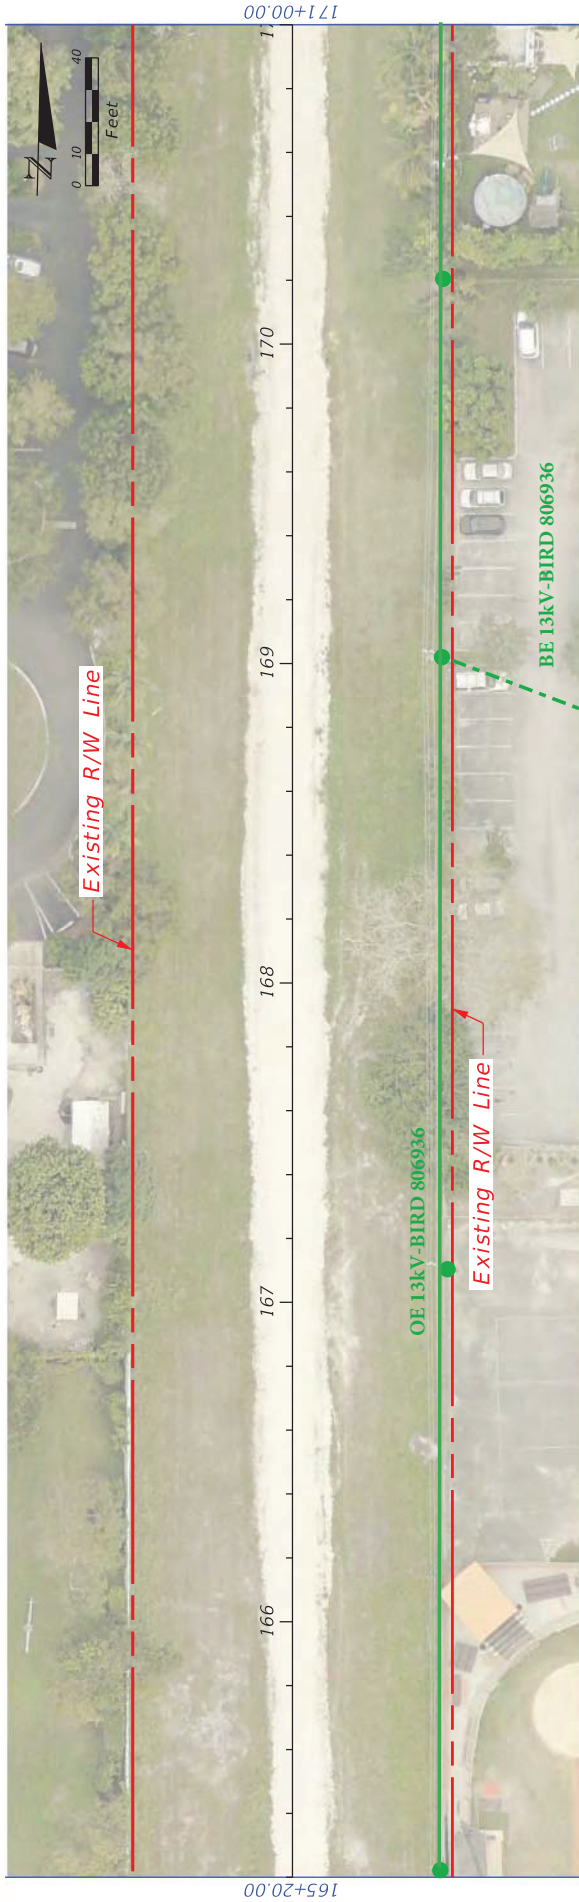

REVISIONS		LUDLAM TRAIL CORRIDOR P&E STUDY		BASE MAP		SHEET NO.
DATE	DESCRIPTION	DATE	DESCRIPTION	MIAMI-DADE COUNTY		
				Miami-Dade County Parks, Recreation, and Open Spaces (MDPROS)	Hickman Building 275 NW 2nd Street Miami, FL 33128 305-755-7800	08
					P&E CONTRACT NO. 43502-15-001-14470619	
					DESIGN NO. P&E PROJ. NO.	

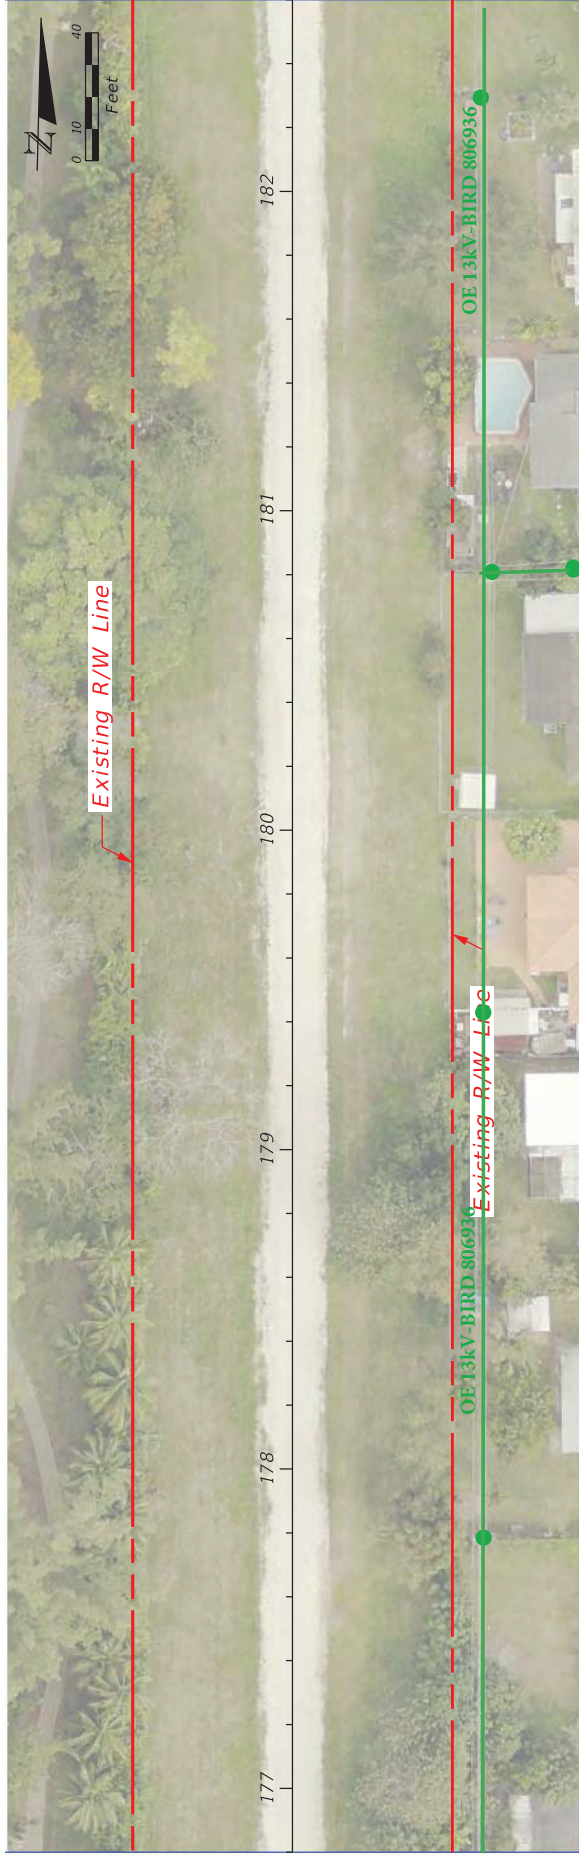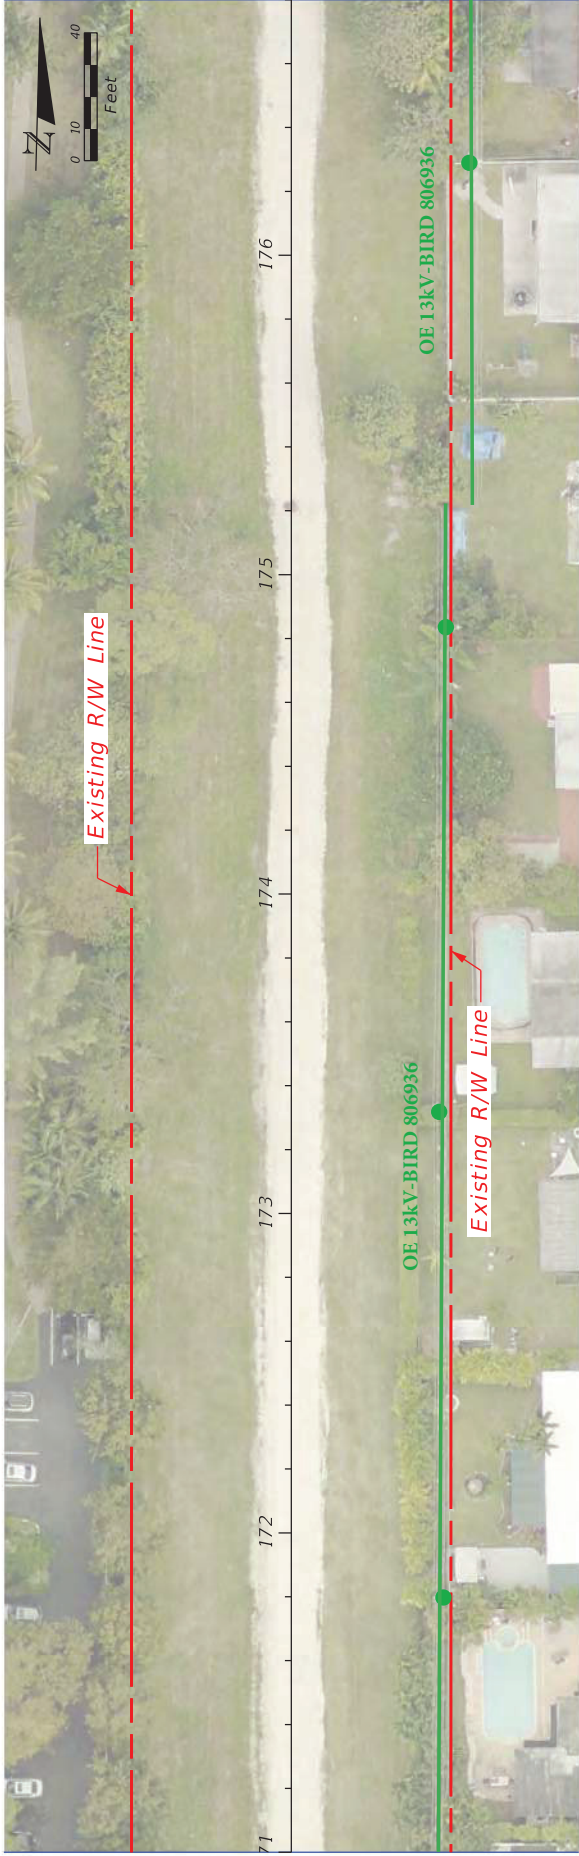

DATE	DESCRIPTION	REVISIONS	DATE	DESCRIPTION





Ludlam Trail Corridor P&E Study
 Miami-Dade County
 Parks, Recreation, and
 Open Spaces
 (MDPROS)
 Hickman Building
 275 NW 2nd Street
 Miami, FL 33128
 305-755-7800

P&E CONTRACT NO.	4350215-001-14470619
PROJECT NO.	4350215-001-14470619
P&E PROJECT NO.	4350215-001-14470619

BASE MAP

SHEET NO.

09

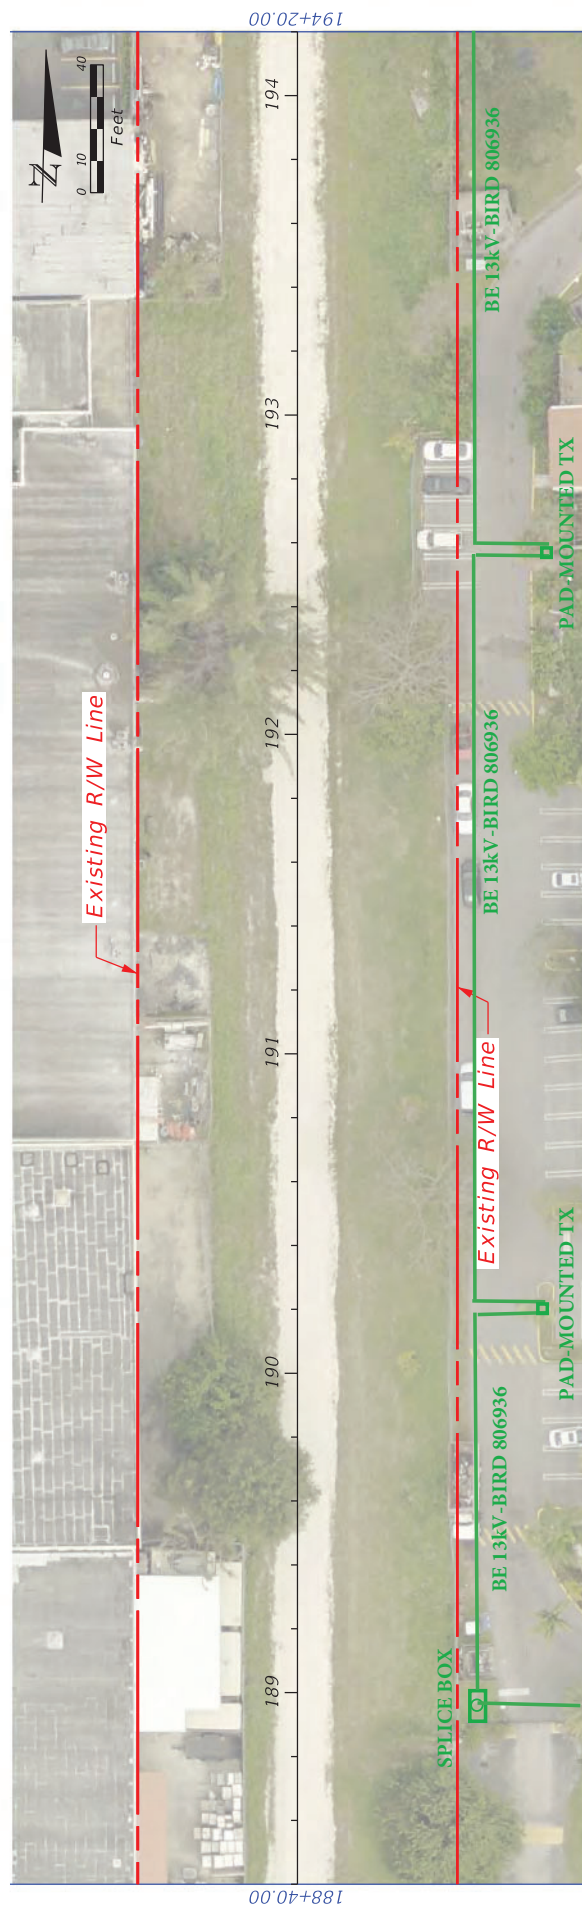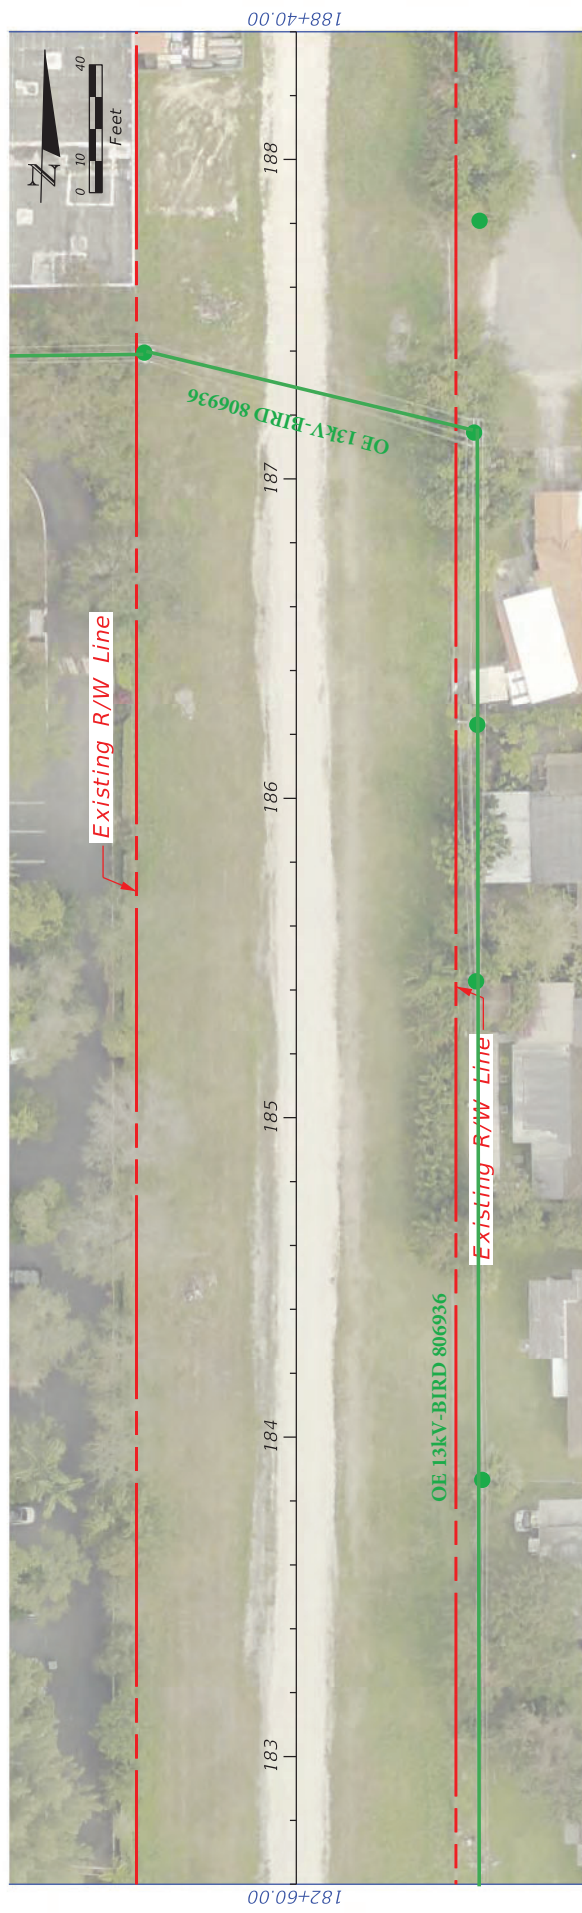


REVISIONS		LUDLAM TRAIL CORRIDOR PDE STUDY		SHEET NO.
DATE	DESCRIPTION	DATE	DESCRIPTION	



 MIAMI-DADE COUNTY	Miami-Dade County Parks, Recreation, and Open Spaces (MDPROS)	Hickman Building 275 NW 2nd Street Miami, FL 33128 305-755-7800	P&R CONTRACT NO. RFQ 786B
			P&R PROJECT NO. 43502-15-001-14470619

BASE MAP

10

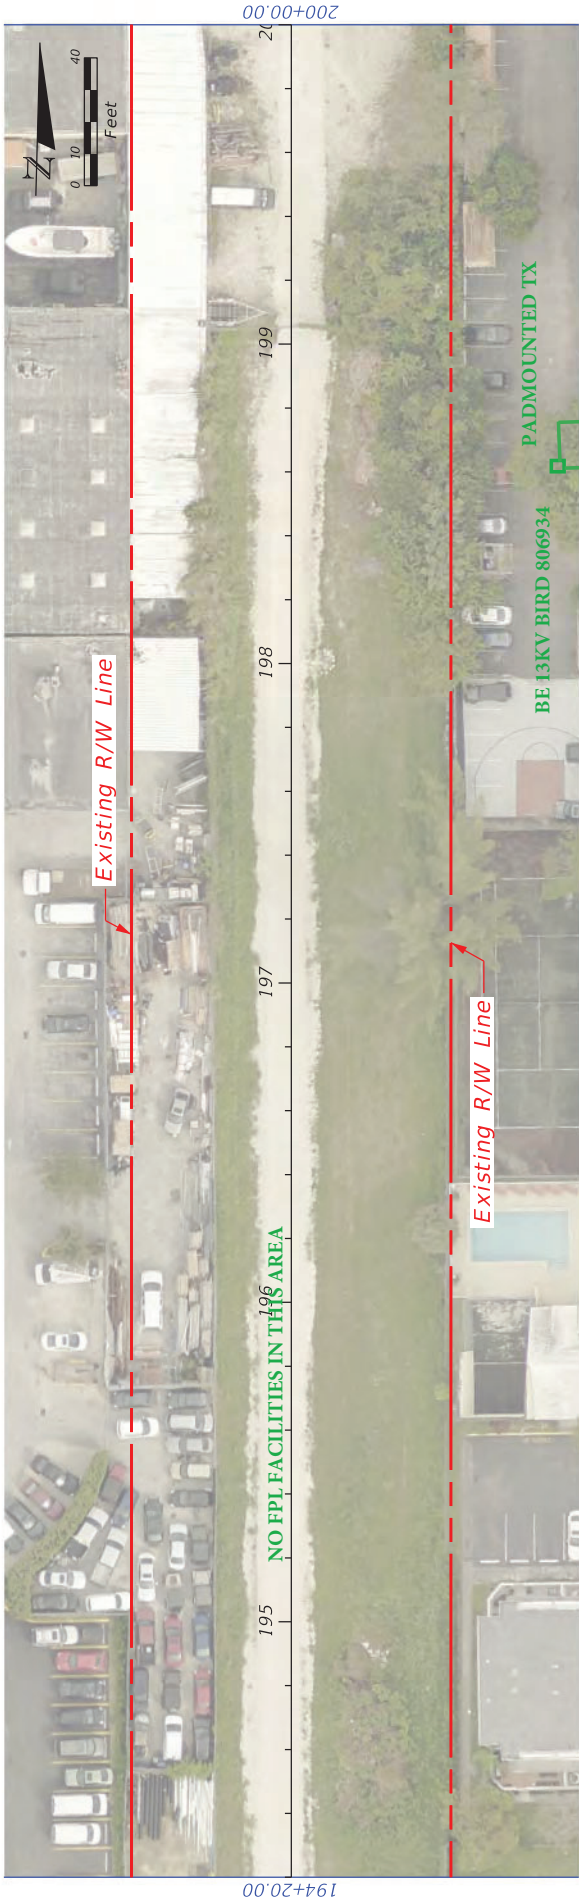

REVISIONS		LUDLAM TRAIL CORRIDOR PHASE STUDY		BASE MAP		SHEET NO.
DATE	DESCRIPTION	DATE	DESCRIPTION	MIAMI-DADE COUNTY		
				Miami-Dade County Parks, Recreation, and Open Spaces (MDPROS)	Hickman Building 275 NW 2nd Street Miami, FL 33128 305-755-7800	11
					P&E CONTRACT NO. P&E PROJECT NO. P&E PROJECT NO.	
					43502-15-001-14470619	

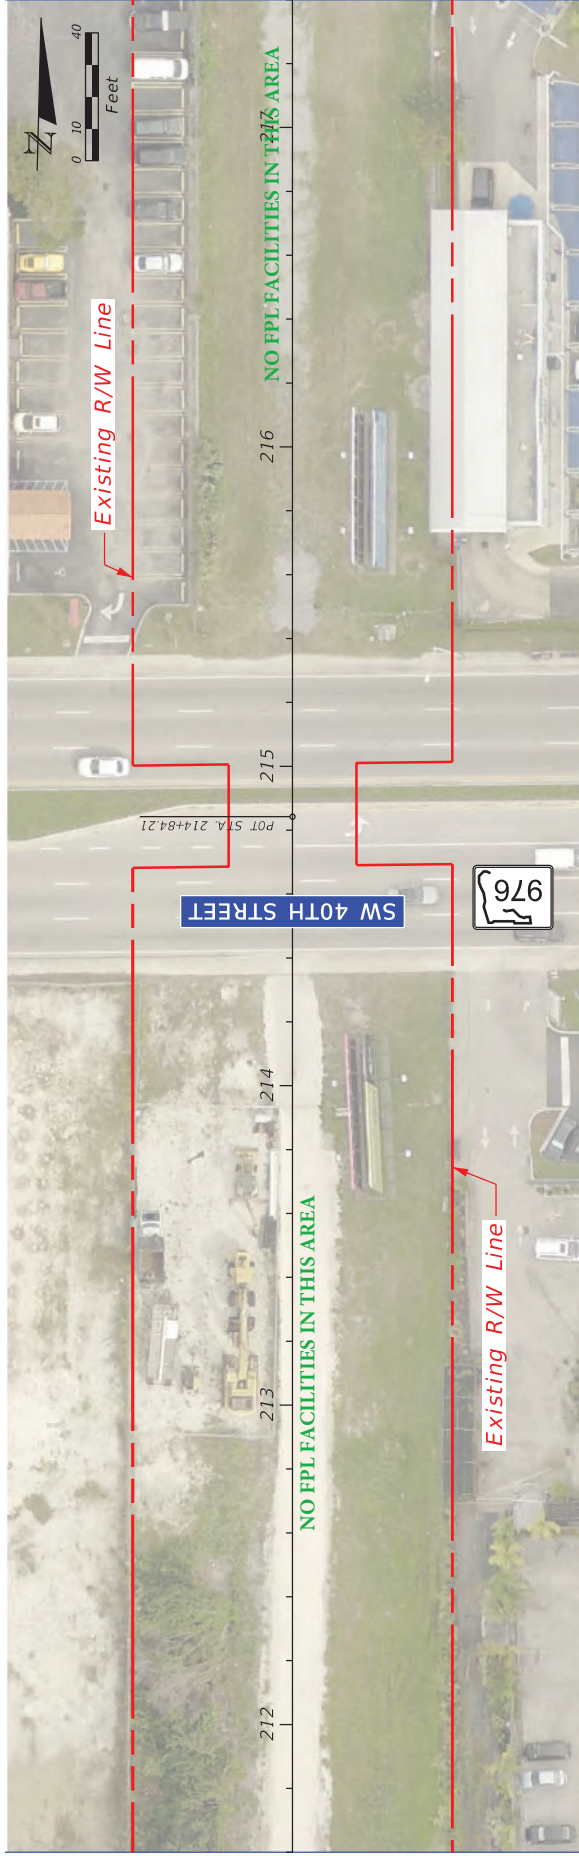
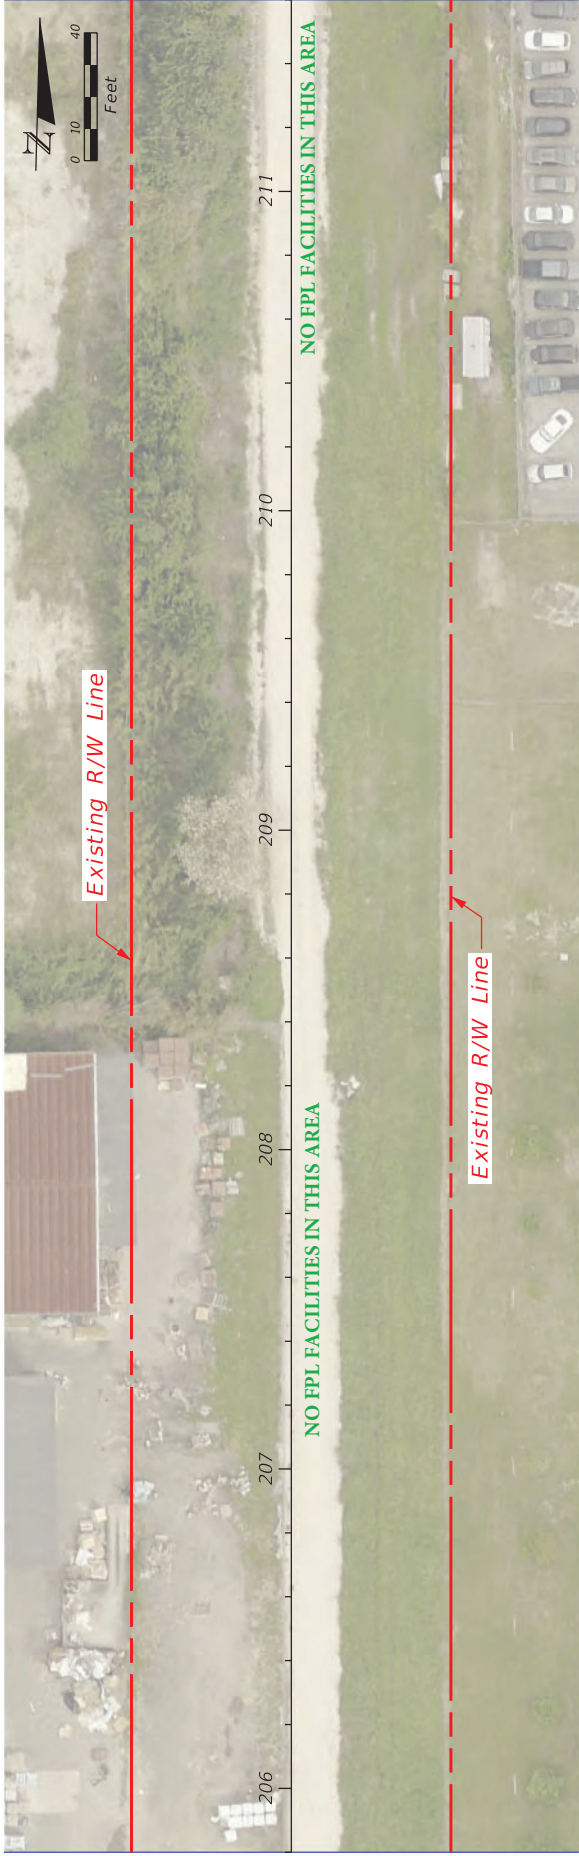


DATE	DESCRIPTION	REVISIONS	DATE	DESCRIPTION




LUDLAM TRAIL CORRIDOR PD&E STUDY		
Miami-Dade County Parks, Recreation, and Open Spaces (MDPROS)	Hickman Building 275 NW 2nd Street Miami, FL 33128 305/755-7800	P&R CONTRACT NO.
		RFQ 7868
		P&R PROJECT NO.
		43502-15-001-14470619

BASE MAP	
SHEET NO.	12

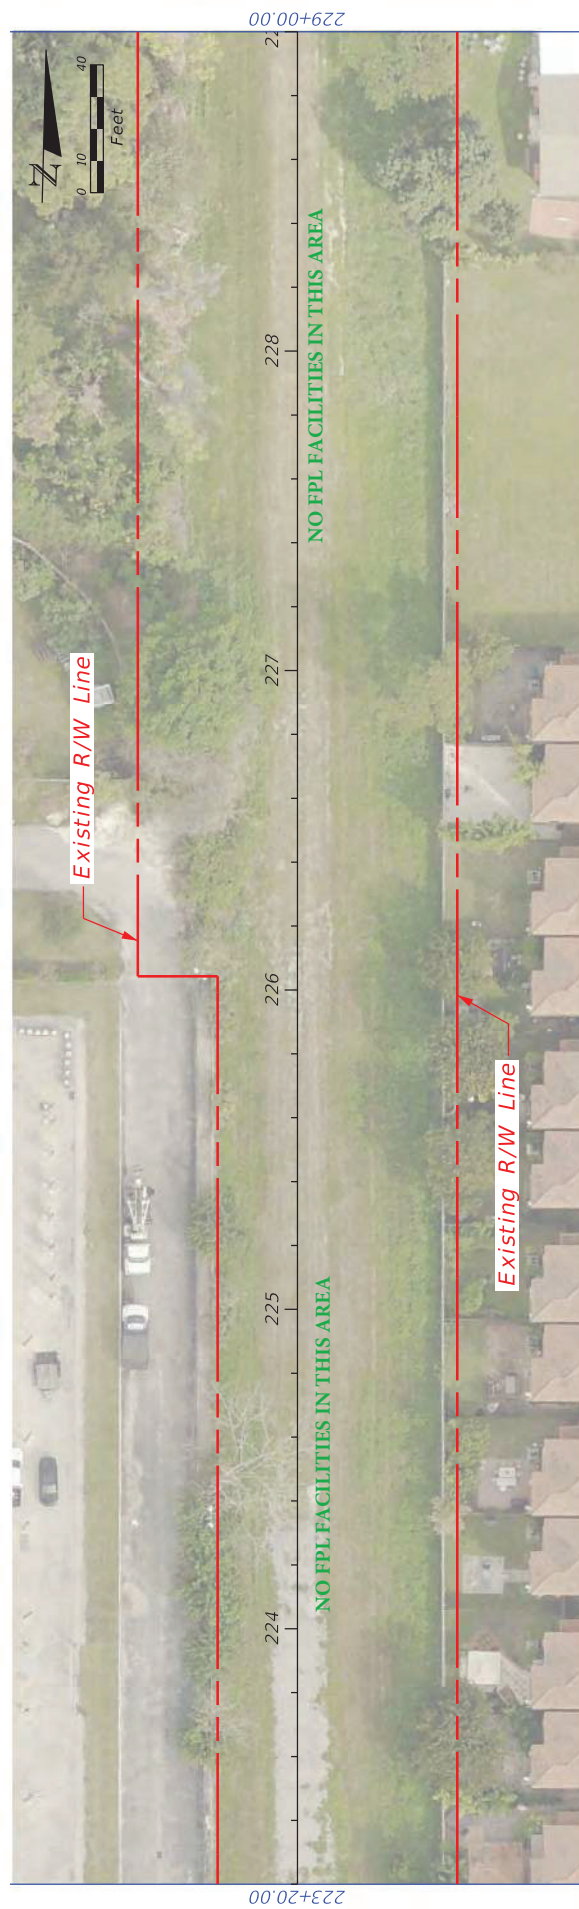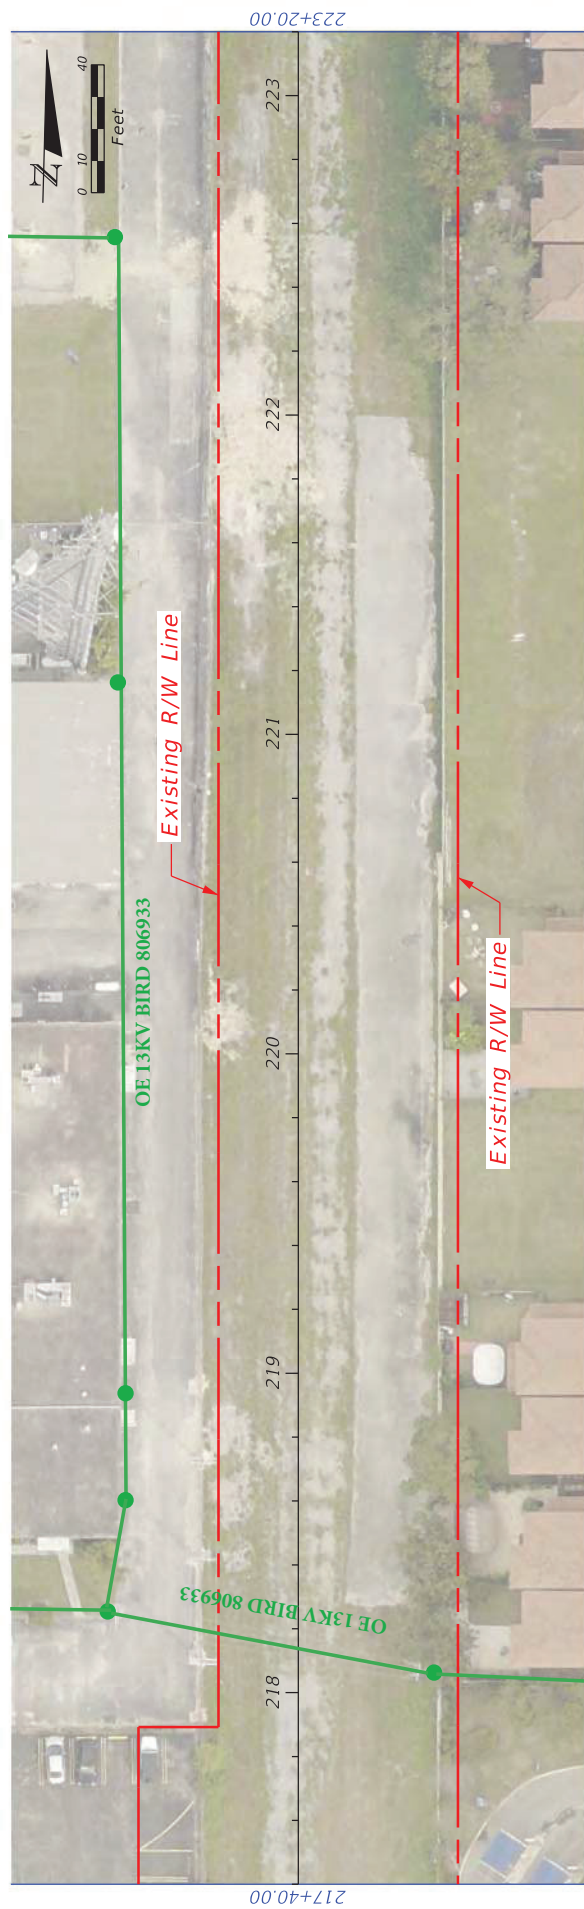

					<i>LUDLAM TRAIL CORRIDOR PD&E STUDY</i>		<i>BASE MAP</i>		SHEET NO.
DATE	DESCRIPTION	DATE	DESCRIPTION	Miami-Dade County Parks, Recreation, and Open Spaces		Hickman Building 275 NW 2nd Street Miami, FL 33128		P&R CONTRACT NO. RFQ 786B	13
								P&R PROJECT NO.	

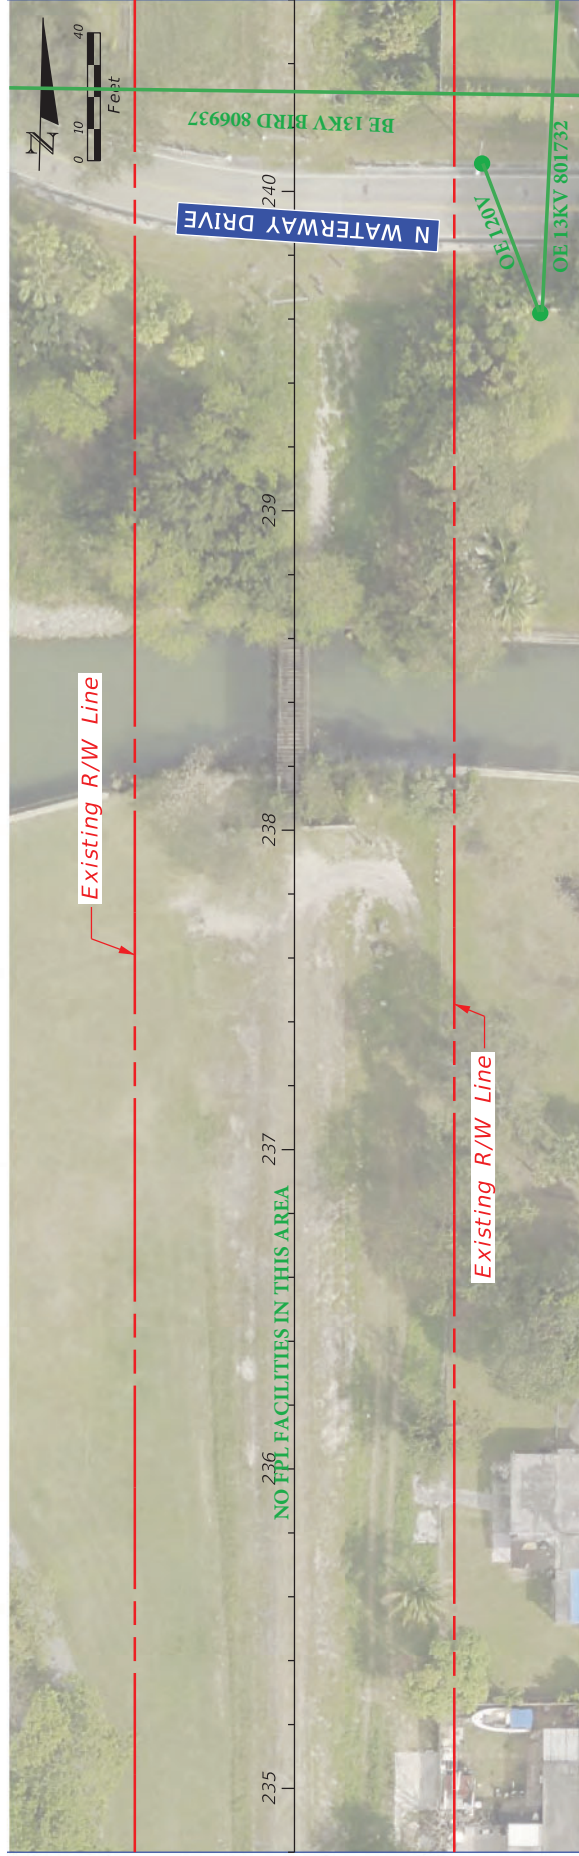

DATE	DESCRIPTION	REVISIONS	DATE	DESCRIPTION



MIAMI-DADE COUNTY

LUDLAM TRAIL CORRIDOR PD&E STUDY

Miami-Dade County
Parks, Recreation, and
Open Spaces
(MDPROS)


Hickman Building
275 NW 2nd Street
Miami, FL 33128
305/755-7800

P&E CONTRACT NO.	4350215-001-14470619
PROJECT NO.	305/755-7800
P&E PROJECT NO.	4350215-001-14470619


BASE MAP

SHEET NO.



14

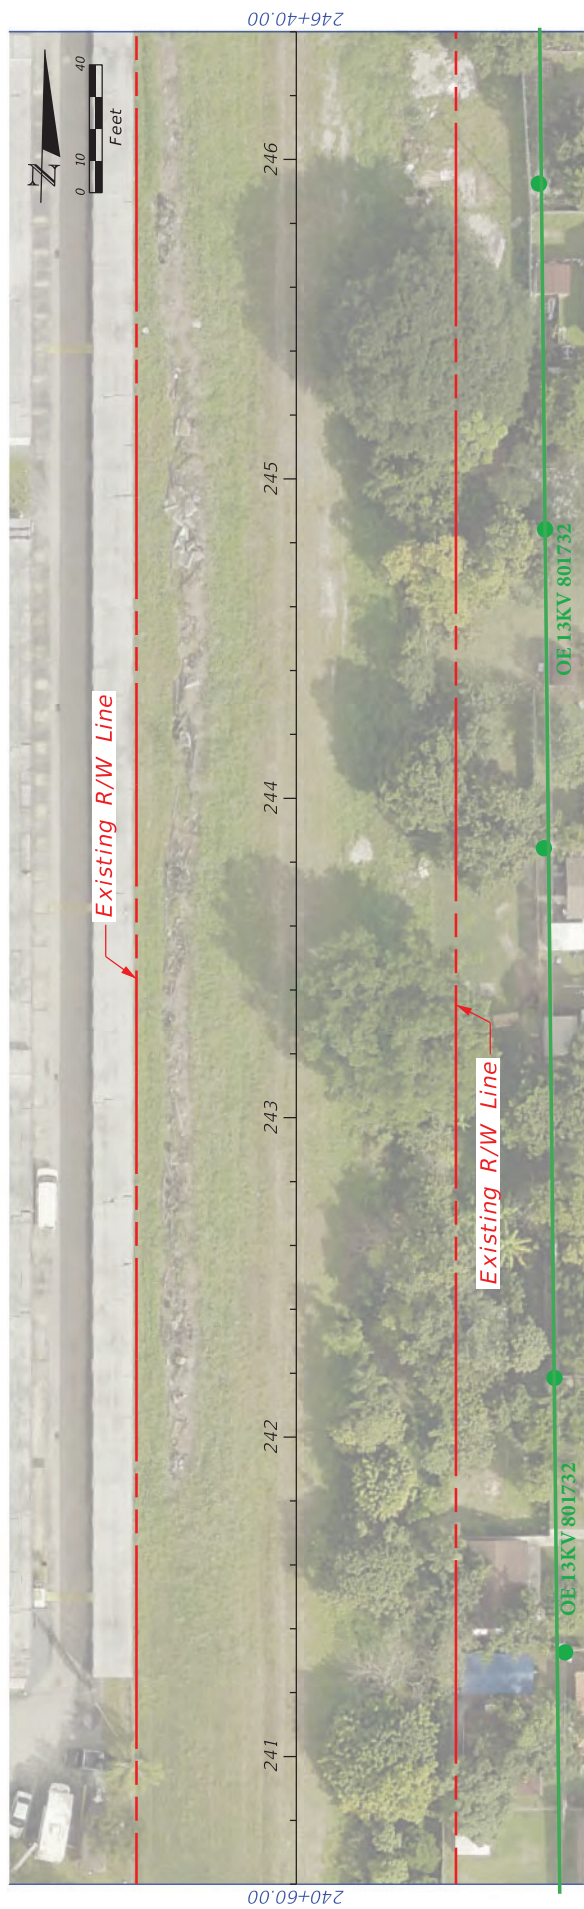



REVISIONS		LUDLAM TRAIL CORRIDOR PD&E STUDY		SHEET NO.		
DATE	DESCRIPTION	DATE	DESCRIPTION			
				15		
 MIAMI-DADE COUNTY						
		Miami-Dade County Parks, Recreation, and Open Spaces (MDPROS)	Hickman Building 275 NW 2nd Street Miami, FL 33128	P&R CONTRACT NO. RFQ 786B P&R PROJECT NO. 43502-15-001-14470619		
BASE MAP						

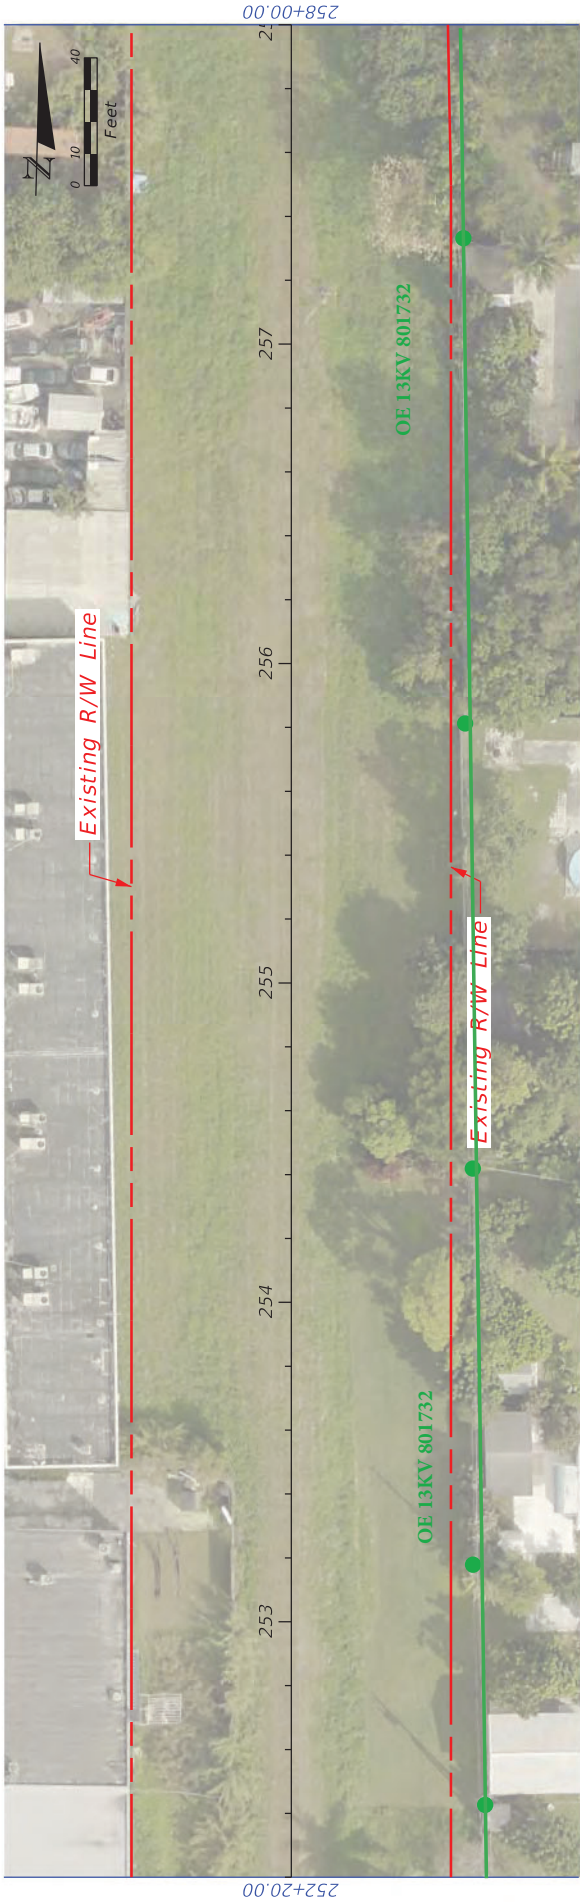


REVISIONS		DESCRIPTION	
DATE	DESCRIPTION	DATE	DESCRIPTION
MIAMI-DADE COUNTY			
Miami-Dade County Parks, Recreation, and Open Spaces (MDPROS) Hickman Building 275 NW 2nd Street Miami, FL 33128 305-755-7800 4350215-001-14470619 P&R CONTRACT NO. P&R PROJECT NO.			
LUDLAM TRAIL CORRIDOR P&R STUDY BASE MAP			
SHEET NO.			16

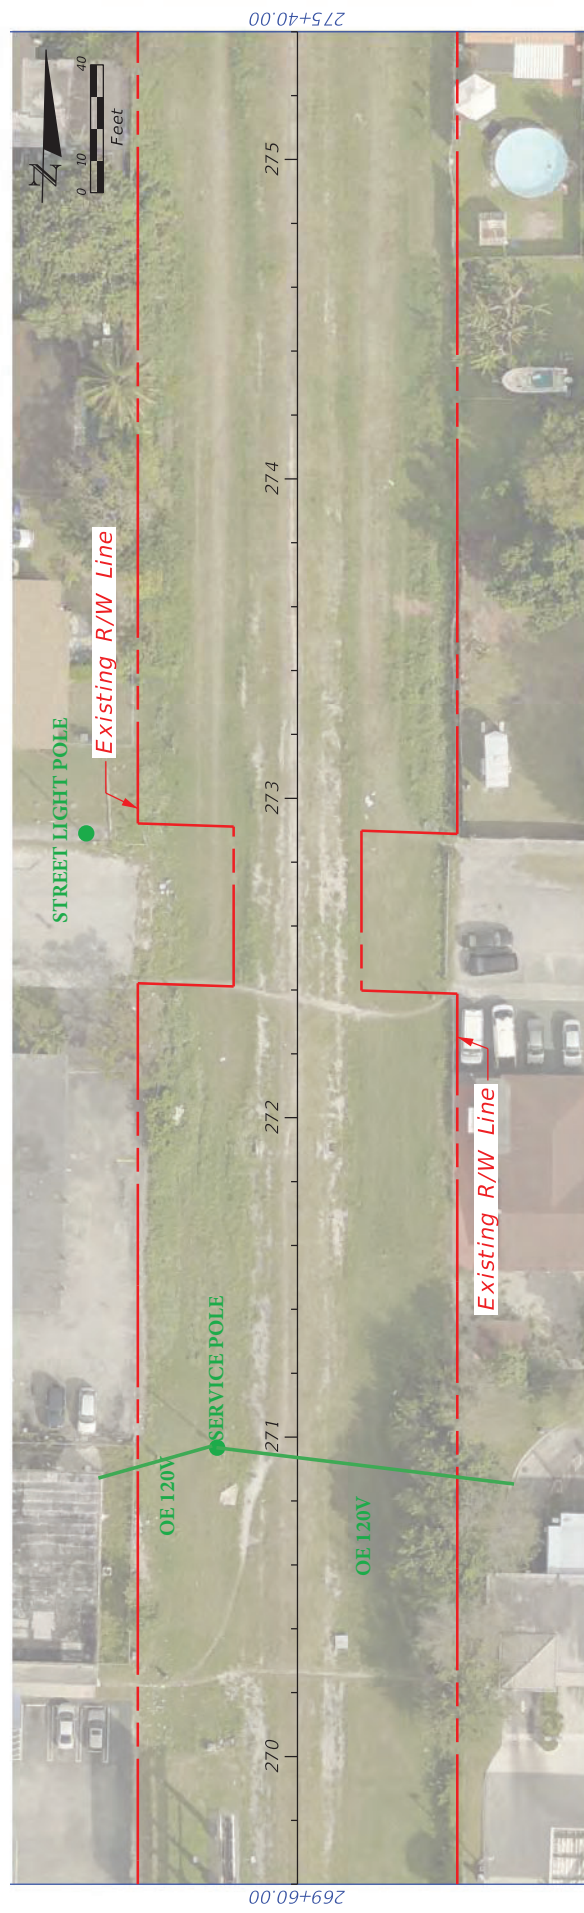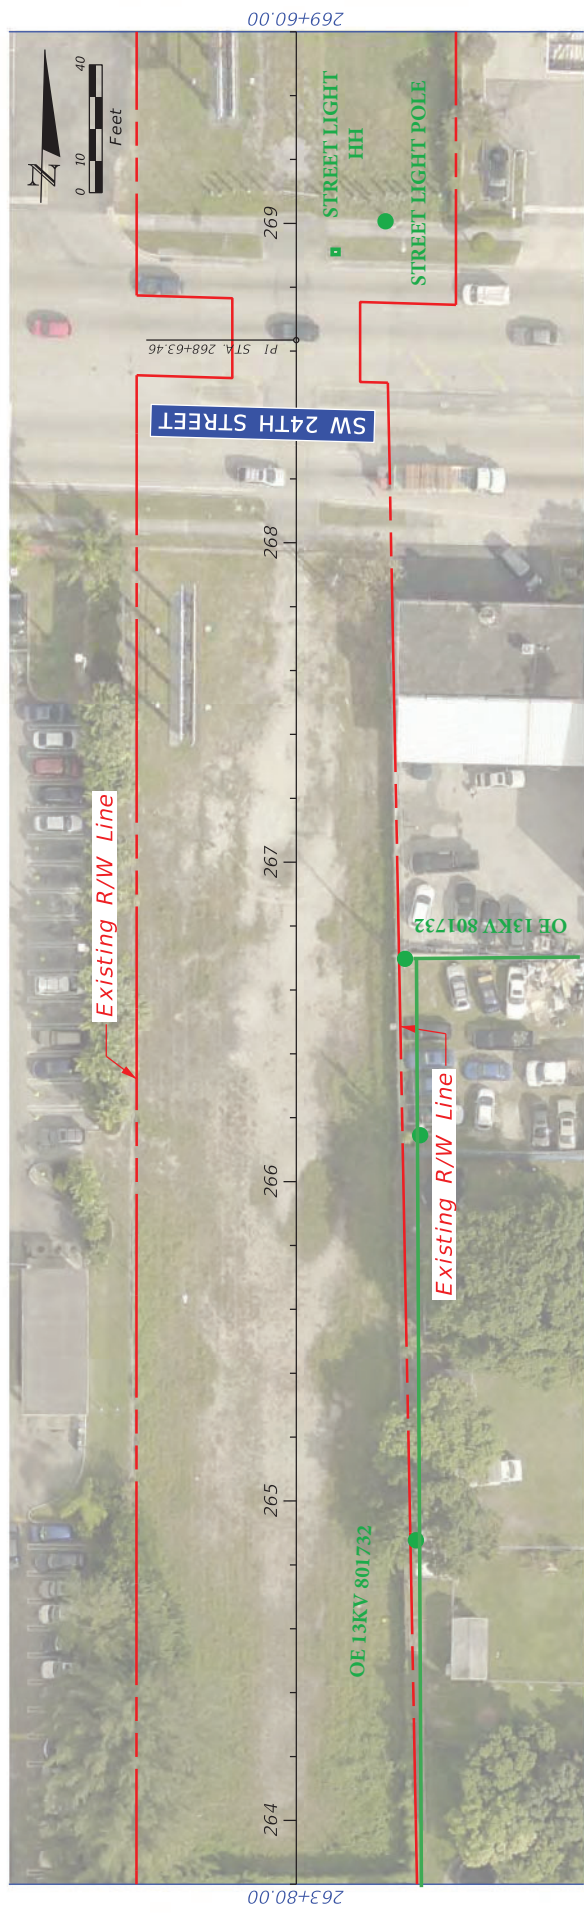

REVISIONS		LUDLAM TRAIL CORRIDOR PDE STUDY		SHEET NO.
DATE	DESCRIPTION	DATE	DESCRIPTION	
 MIAMI-DADE COUNTY Miami-Dade County Parks, Recreation, and Open Spaces (MDPROS) Hickman Building 275 NW 2nd Street Miami, FL 33128 305-755-7800 43502-15-001-14470619 P&R CONTRACT NO. RFQ 786B P&R PROJECT NO. 43502-15-001-14470619				BASE MAP

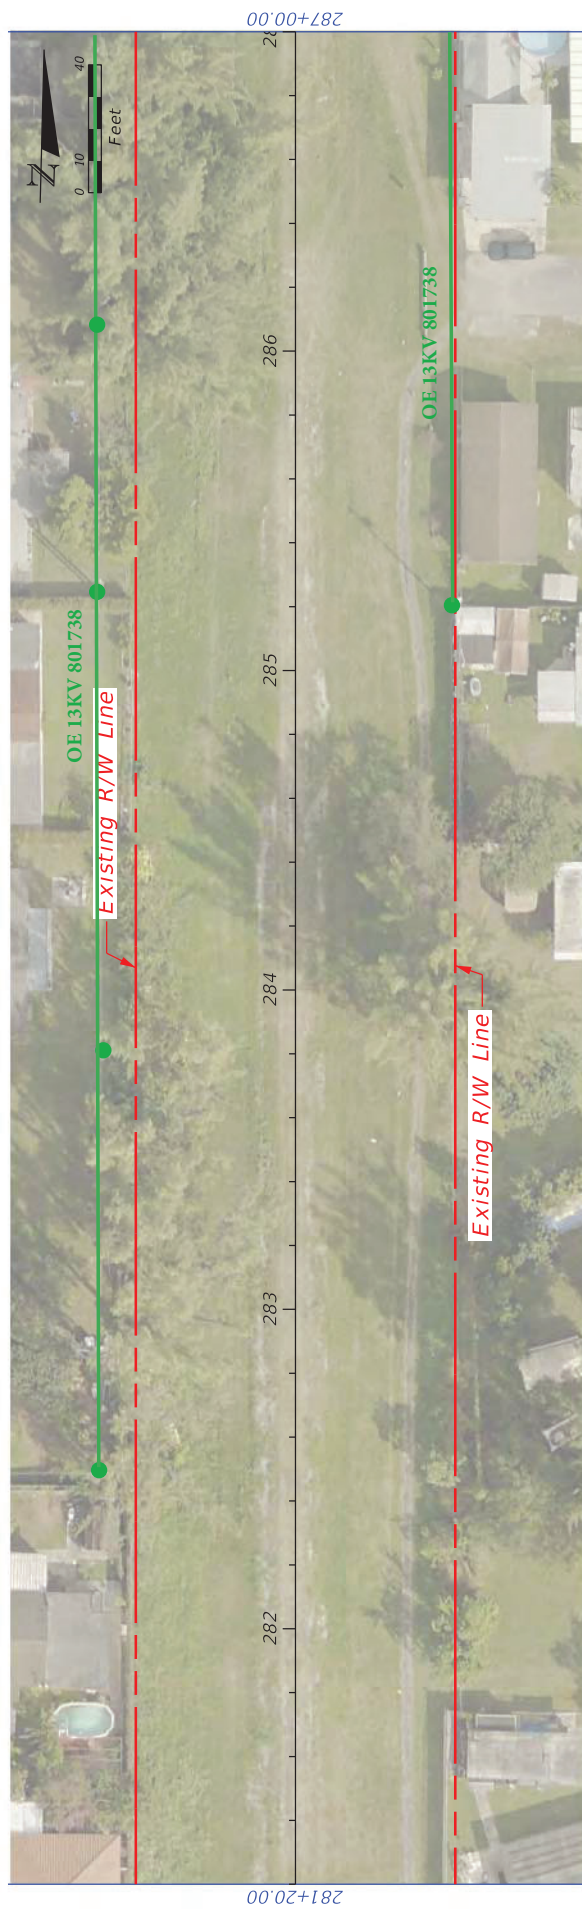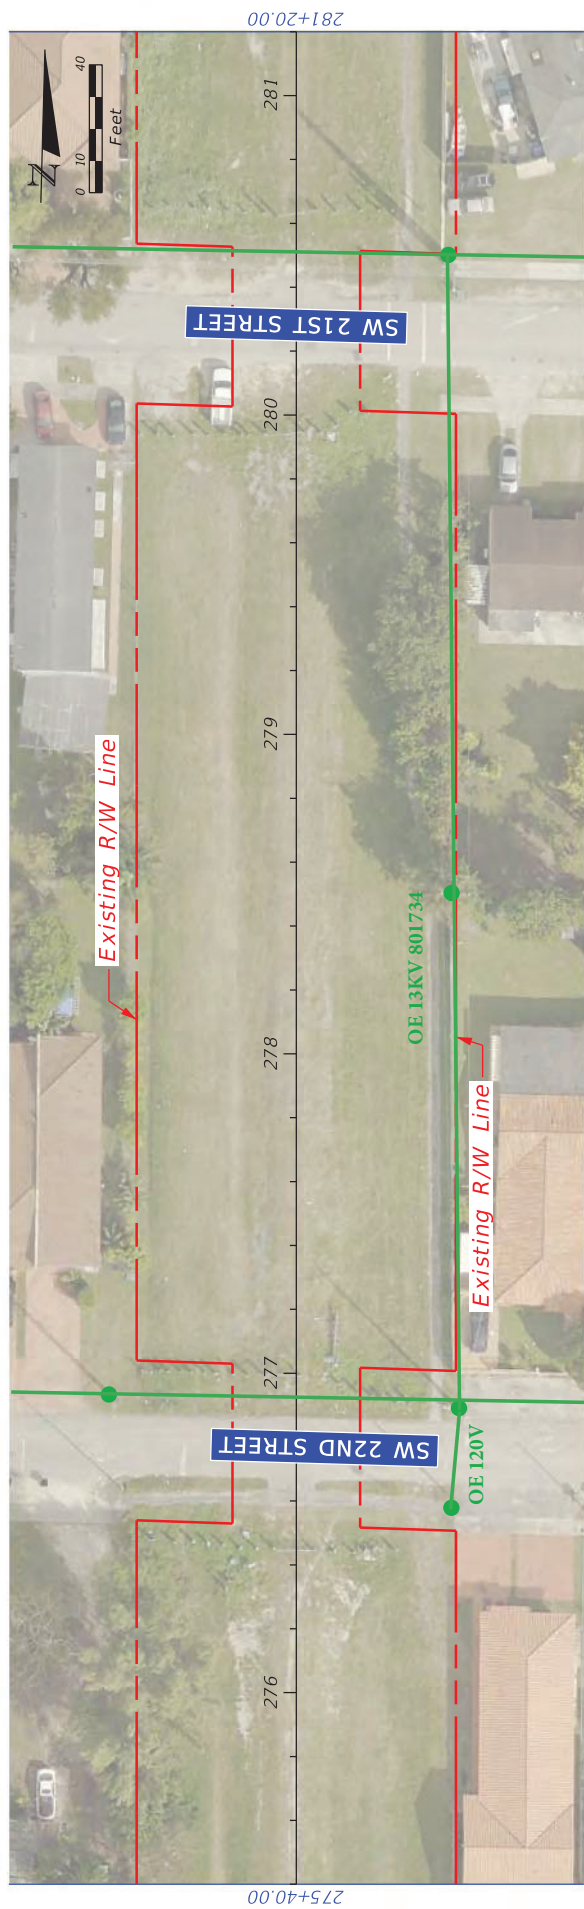

REVISIONS			DESCRIPTION		LUDLAM TRAIL CORRIDOR PD&E STUDY		BASE MAP	SHEET NO.
DATE	DESCRIPTION	DATE	DESCRIPTION	Miami-Dade County Parks, Recreation, and Open Spaces (MDPROS)	Hickman Building 275 NW 2nd Street Miami, FL 33128 305-7557800 43502-15-001-14470619	P&R CONTRACT NO. RFQ 786B		
						P&R PROJECT NO. 43502-15-001-14470619		

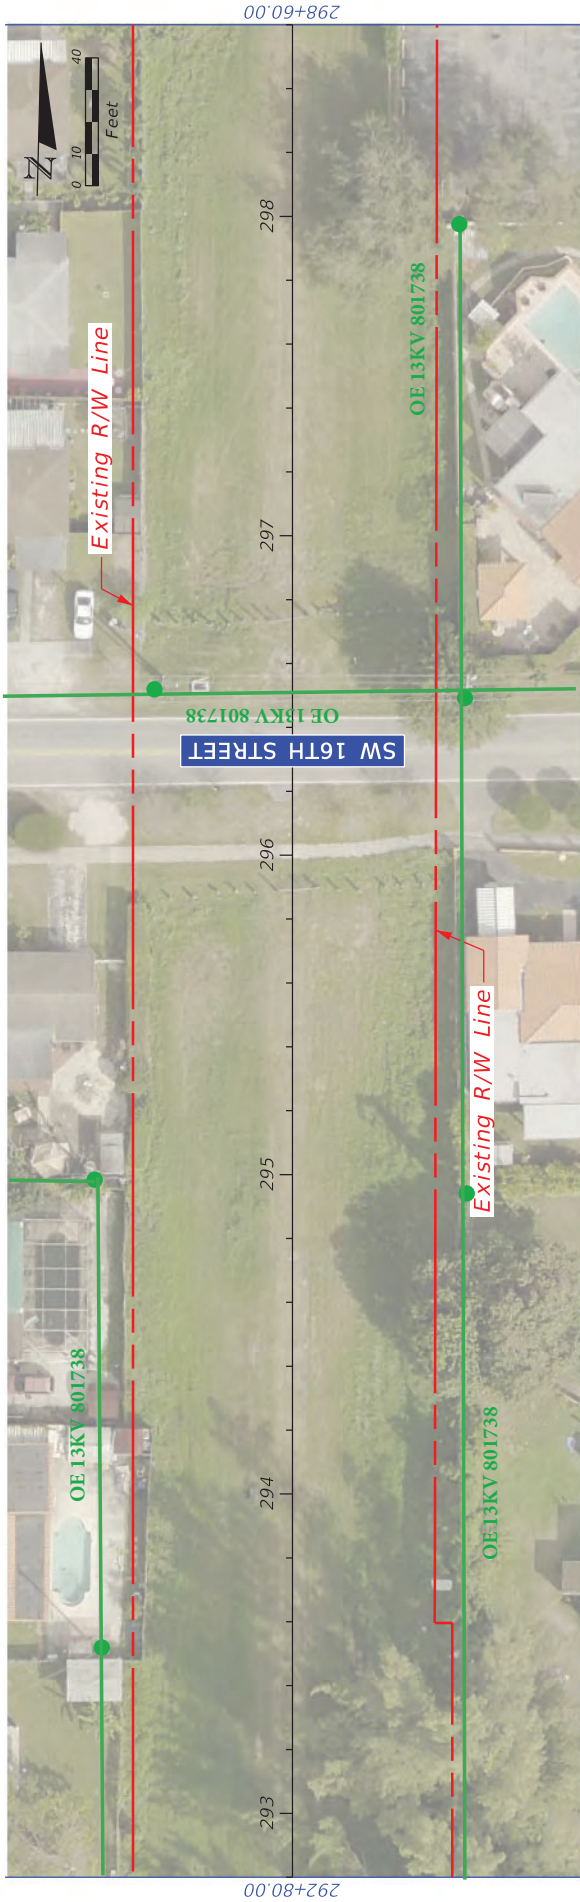


DATE	REVISIONS		DESCRIPTION
	DESCRIPTION	DATE	



Miami-Dade County Parks, Recreation, and Open Spaces (MDPROS)	Hickman Building 275 NW 2nd Street Miami, FL 33128 305-755-7800 4350215-001-14470619	LUDLAM TRAIL CORRIDOR PD&E STUDY	
		P&E CONTRACT NO.	CONTRACT NO.
		P&E PROJECT NO.	PROJECT NO.
		P&E PROPOSAL NO.	PROPOSAL NO.

<i>BASE MAP</i>	SHEET NO.
	19

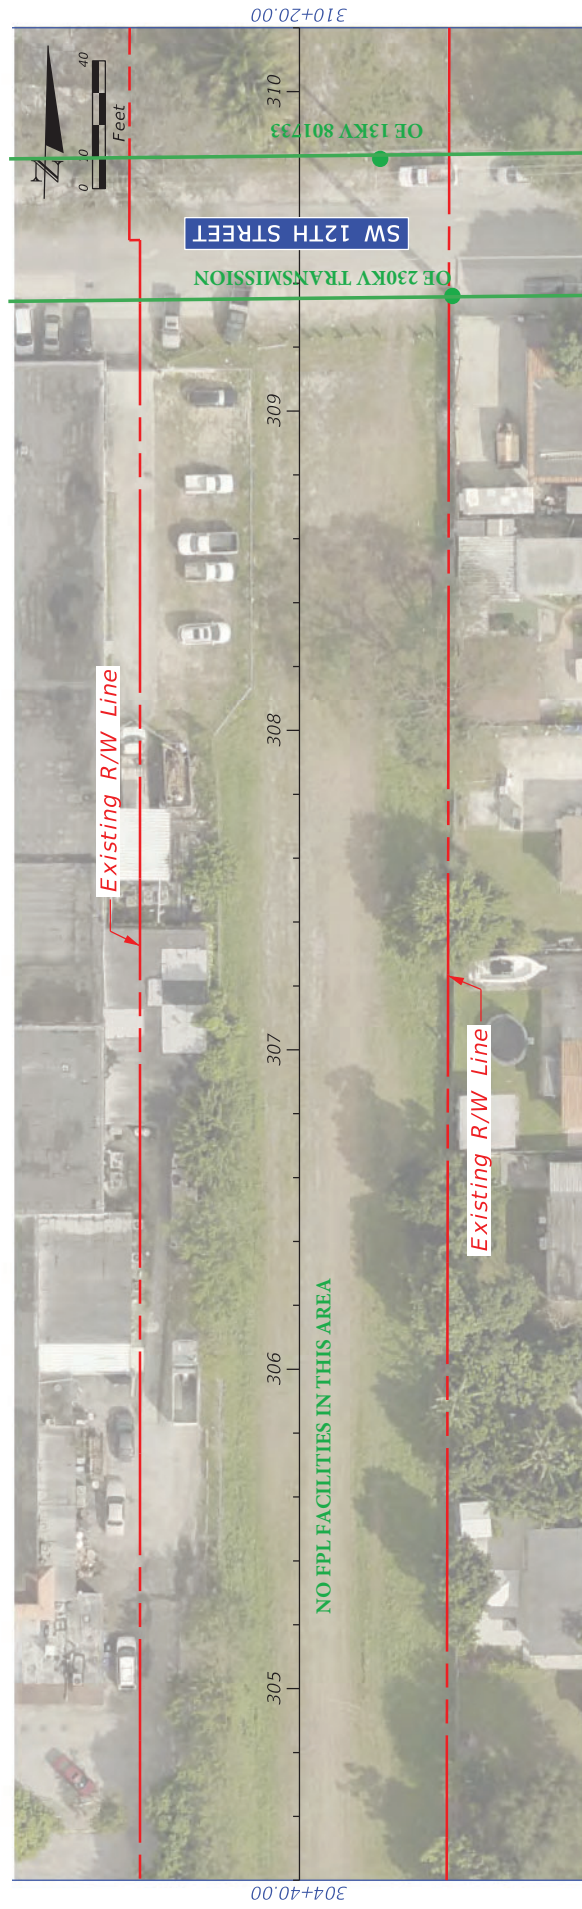

						<i>LUDLAM TRAIL CORRIDOR PD&E STUDY</i>		<i>BASE MAP</i>		SHEET NO. 20
DATE	DESCRIPTION	DATE	DESCRIPTION	Miami-Dade County Parks, Recreation, and Open Spaces (MDPROS)		Hickman Building 275 NW 2nd Street Miami, FL 33128 305-755-7800		P&R CONTRACT NO. RFQ 786B		
								P&R PROJECT NO. 43502-15-001-14470619		