MIAMI-DADE COUNTY

BUILDING CODE COMPLIANCE OFFICE (BCCO)
PRODUCT CONTROL DIVISION

MIAMI-DADE COUNTY, FLORIDA
METRO-DADE FLAGLER BUILDING
140 WEST FLAGLER STREET, SUITE 1603
MIAMI, FLORIDA 33130-1563
(305) 375-2901 FAX (305) 372-6339
www.miamidade.gov/buildingcode

NOTICE OF ACCEPTANCE (NOA)

Wayne Dalton Corporation
3395 Addison Drive
Pensacola, FL 32514

SCOPE: This NOA is being issued under the applicable rules and regulations governing the use of construction materials. The documentation submitted has been reviewed by Miami-Dade County Product Control Division and accepted by the board of Rules and Appeals (BORA) to be used in Miami Dade County and other areas where allowed by the Authority Having Jurisdiction (AHJ).

This NOA shall not be valid after the expiration date stated below. The Miami-Dade County Product Control Division (in Miami Dade County) and/or the AHJ (in areas other than Miami-Dade County) reserve the right to have this product or material tested for quality assurance purposes. If this product or material fails to perform in the accepted manner, the manufacturer will incur the expense of such testing and the AHJ may immediately revoke, modify, or suspend the use of such product or material within their jurisdiction. BORA reserves the right to revoke this acceptance, if it is determined by Miami-Dade County Product Control Division that this product or material fails to meet the requirements of the applicable building code.

This product is approved as described herein, and has been designed to comply with the Florida Building Code, including the High Velocity Hurricane Zone.

DESCRIPTION: Models 8024/8124 Code 1340 Garage Door.

APPROVAL DOCUMENT: Drawing No. **329930**, titled "Models 8024/8124, Windload Specification Option Code 1340", sheets 1 through 4 of 4, dated 05/04/07, with last revision P4 dated 05/19/08, prepared by Wayne Dalton Corporation, signed and sealed by Mark R. Barrow, P.E., bearing the Miami-Dade County Product Control revision stamp with the NOA number and expiration date by the Miami-Dade County Product Control Division.

MISSILE IMPACT RATING: Large & Small Missile Impact Resistant

LABELING: Each unit shall bear a permanent label with the manufacturer's name:

Wayne Dalton Co.	Wayne Dalton Co.
3395 Addison Drive	One Door Drive
Pensacola, FL 32514	Mt. Hope, Ohio 44660

and following statement: "Miami-Dade County Product Control Approved", unless otherwise noted herein.

RENEWAL of this NOA shall be considered after a renewal application has been filed and there has been no change in the applicable building code negatively affecting the performance of this product.

TERMINATION of this NOA will occur after the expiration date or if there has been a revision or change in the materials, use, and/or manufacture of the product or process. Misuse of this NOA as an endorsement of any product, for sales, advertising or any other purposes shall automatically terminate this NOA. Failure to comply with any section of this NOA shall be cause for termination and removal of NOA.

ADVERTISEMENT: The NOA number preceded by the words Miami-Dade County, Florida, and followed by the expiration date may be displayed in advertising literature. If any portion of the NOA is displayed, then it shall be done in its entirety.

INSPECTION: A copy of this entire NOA shall be provided to the user by the manufacturer or its distributors and shall be available for inspection at the job site at the request of the Building Official.

This NOA **revises NOA # 08-0630.05** and consists of this page 1, evidence pages E-1 and E-2, as well as approval document mentioned above.

The submitted documentation was reviewed by **Carlos M. Utrera, P.E.**

MIAMI-DADE COUNTY APPROVED

3/16/09

NOA No: 09-0225.03
Expiration Date: September 27, 2012
Approval Date: April 8, 2009

NOTICE OF ACCEPTANCE: EVIDENCE SUBMITTED

A. DRAWINGS

1. Drawing No. **329930**, titled "Models 8024/8124, Windload Specification Option Code 1340", sheets 1 through 4 of 4, dated 05/04/07, with last revision P4 dated 05/19/08, prepared by Wayne Dalton Corporation, signed and sealed by Mark R. Barrow, P.E.

B. TESTS

1. Test report on: 1) Uniform Static Air Pressure Test, per FBC, TAS 202-94
   2) Large Missile Impact Test, per FBC, TAS 201-94
   3) Cyclic Wind Pressure Loading Test, per FBC, TAS 203-94,
   along with marked-up drawings of an 18'x 7' Model 8024/8124 Galvanized Steel Sectional Door System with an Aluminum Windload Post, prepared by Certified Testing Laboratories, Inc., Report # **CTLA 1672W-1R**, dated 05/17/07, signed and sealed by Ramesh Patel, P.E.
2. Test report on: 1) Uniform Static Air Pressure Test, per FBC, TAS 202-94
   2) Large Missile Impact Test, per FBC, TAS 201-94
   3) Cyclic Wind Pressure Loading Test, per FBC, TAS 203-94,
   along with marked-up drawings of an 18'x 7' Model 8024/8124 Galvanized Steel Sectional Door System with an Aluminum Windload Post and Impact Resistant Glazing, prepared by Certified Testing Laboratories, Inc., Report # **CTLA 1734WR**, dated 11/09/07, signed and sealed by Ramesh Patel, P.E.
3. Test report on: 1) Uniform Static Air Pressure Test, per FBC, TAS 202-94
   2) Test report on Tensile Test, per ASTM E8
   along with marked-up drawings, prepared by Certified Testing Laboratories, Inc., Report # **CTLA 1672W**, dated 05/17/07 and 05/22/07, signed and sealed by Ramesh Patel, P.E
   (Evidence Submitted under NOA # 07-0808.01)

C. CALCULATIONS

1. Jambs anchoring calculations prepared by Wayne Dalton Corporation, dated 07/23/07, signed and sealed by Mark R. Barrow, P.E.
   (Evidence Submitted under NOA # 07-0808.01)
2. Fastening calculations prepared by Wayne Dalton Corporation, dated 10/24/07, signed and sealed by Mark R. Barrow, P.E.
   (Evidence Submitted under NOA # 07-1105.03)

3/16/09

Carlos M. Utrera, P.E.
Product Control Examiner
NOA No 09-0225.03
Expiration Date: September 27, 2012
Approval Date: April 8, 2009

NOTICE OF ACCEPTANCE: EVIDENCE SUBMITTED

D. MATERIAL CERTIFICATIONS

1. Notice of Acceptance No. **07-0313.04,** issued to Sheffield Plastic, Inc., for their HYZOD Polycarbonate Sheets, approved on 04/26/07 and expiring on 08/27/08.

E. QUALITY ASSURANCE

1. Miami Dade Building Code Compliance Office (BCCO).

F. STATEMENTS

1. Code compliance letter issued by Wayne Dalton Corporation, dated 07/23/07, signed and sealed by Mark R. Barrow, P.E.
2. No financial interest letter issued by Wayne Dalton Corporation, dated 07/23/07, signed and sealed by Mark R. Barrow, P.E.
   (Evidence Submitted under NOA # 07-0808.01)
3. Revision request letter issued by Wayne Dalton Corporation, dated 01/23/09, signed by Mark R. Barrow, P.E.

G. OTHER

1. Notice of Acceptance No. **08-0630.05**, issued to Wayne Dalton Corporation, approved on 08/14/08 and expiring on 09/27/12.

3/16/09

Carlos M. Utrera, P.E.
Product Control Examiner
NOA No 09-0225.03
Expiration Date: September 27, 2012
Approval Date: April 8, 2009

NOTES:

1. IMPACT RESISTANT GLAZING SYSTEM MAY BE INSTALLED IN TOP OR INTERMEDIATE SECTION (WITH OR WITHOUT DECORATIVE INSERTS). GLAZING SHALL BE 1/4" MAKROLON-AR POLYCARBONATE (MIAMI-DADE NOA #07-0313.04) OR EQUAL. MAXIMUM GLAZING DIMENSIONS SHALL BE 18.56" x 12.26". SEE DETAIL E ON SHEET 2 FOR ASSEMBLY DETAILS. P3

2. VINYL OR WOOD DOOR STOP NAILED A MAXIMUM OF 6" O.C. MUST OVERLAP TOP AND BOTH ENDS OF PANELS MINIMUM 7/16" TO MEET NEGATIVE PRESSURES.

3. KEY LOCK OR SLIDE LOCKS REQUIRED.

4. SECTION STEEL TO HAVE A MINIMUM 24 GA THICKNESS WITH A MINIMUM G90 COATING AND A MINIMUM YIELD STRENGTH OF 33.8 KSI.

5. THE DESIGN OF THE SUPPORTING STRUCTURAL ELEMENTS SHALL BE THE RESPONSIBILITY OF THE PROFESSIONAL OF RECORD FOR THE BUILDING OR STRUCTURE AND IN ACCORDANCE WITH CURRENT BUILDING CODES FOR THE LOADS LISTED ON THIS DRAWING.

6. WOOD SUBSTRATE FOR DOOR JAMB IS TO BE MINIMUM 2x6 NO. 3 SOUTHERN PINE. REFER TO SHEET 4 FOR ATTACHMENT TO SUPPORTING STRUCTURE. FOR MOUNTING OF CONTINOUS WALL ANGLE, SEE CONTINOUS WALL ANGLE DETAIL SHEET 4. P2

7. FOR LOW HEAD ROOM LIFT CONDITIONS, TOP BRACKET SHALL BE A 13 GA LHR 7/4 TOP BRACKET WITH A MINIMUM OF (3) 1/4-14x7/8" SELF DRILLING CRIMPTITE SCREWS IN LIEU OF THE BRACKET SHOWN ON THIS DRAWING. U-BAR ON TOP SECTION SHALL BE INSTALLED ON TOP OF LHR TOP BRACKETS.

8. LOUVERS MAY BE INSTALLED ON THE DOOR IF THE TOTAL AREA OF THE LOUVER DOES NOT EXCEED 120 SQUARE INCHES. P1

9. DOOR WITHOUT POST SYSTEM HAS BEEN TESTED TO WITHSTAND DESIGN PRESSURES CORRESPONDING TO A 75 MPH WIND SPEED (+/-14.40 PSF). POST SYSTEM SHALL BE INSTALLED WHEN WIND SPEEDS ARE EXPECTED TO EXCEED 75 MPH. P4

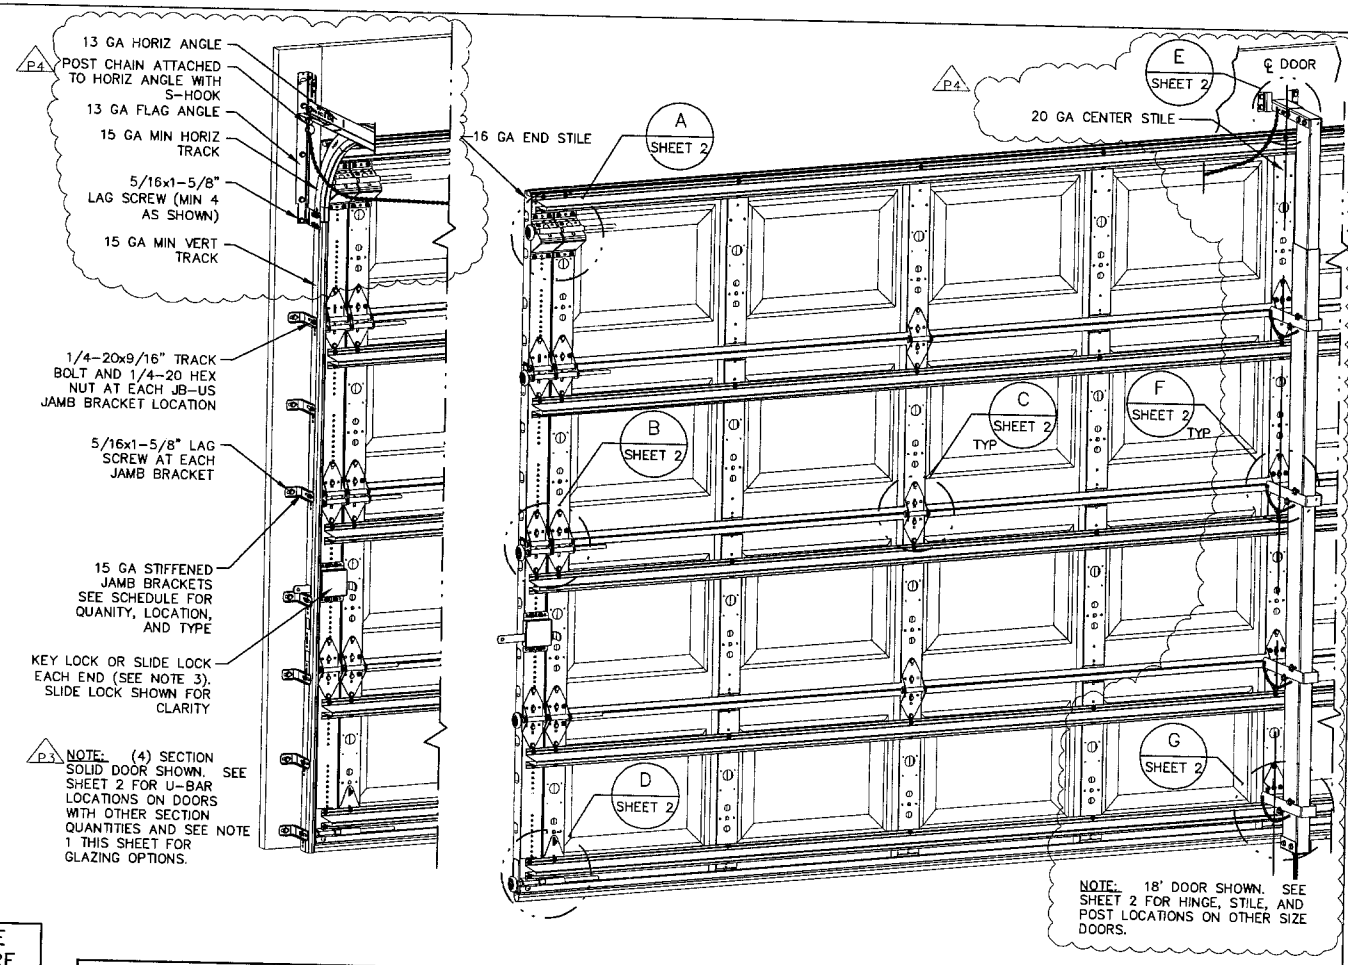

REVISIONS

P1 ADDED POST COMPONENT DETAILS TO SHEET 3. MOVED JAMB DETAIL TO SHEET 4. REMOVED CONCRETE SPECIFICATION FROM NOTES AND ADDED DETAIL H SHEET 2 FOR CONCRETE SPECIFICATION. GRT 9/13/07

P2 MODIFIED TRACK NOTE FOR DOORS WITH DECORATIVE OVERLAYS. ADDED PAN LAYOUTS FOR 14'2" THRDUGH 16' DOOR WIDTHS. ADDED CONTINUOUS WALL ANGLE DETAIL SHEET 4. UPDATED NOTES FOR CONTINOUS WALL ANGLE MOUNTING. GRT 10/1/07

P3 ADDED IMPACT RESISTANT GLAZING. MODIFIED NOTES SHEET 1 FOR GLAZING. ADDED DETAIL J SHEET 2 FOR GLAZING. GRT 11/10/07

P4 ADDED CHAIN TO ATTACH POST TO TRACK AND HITCH PINS TO POST SYSTEM. UPDATED DRAWINGS ON SHEET 1, AND DETAILS E, F, AND G ON SHEET 2. ADDED NOTE 9 ON SHEET 1. ADDED POST STORAGE SHEET 3. GRT 5/19/08

SUPERIMPOSED DESIGN PRESSURE LOADS ON SUPPORTING STRUCTURE

MAX DOOR WIDTH	MAX DOOR HEIGHT	UNIFORM LOAD EACH JAMB (PLF)	POINT LOAD AT HEADER AND SLAB AT EACH POST LOCATION (LBS)
17'-0"	7'-0"	+185.5/-209.6	+1507.4/-1712.9
	8'-0"	+185.5/-209.6	+1704.0/-1936.3
18'-0"	7'-0"	+190.7/-215.7	+1637.0/-1850.5
	8'-0"	+190.7/-215.7	+1860.3/-2102.9

JAMB BRACKET SCHEDULE

DOOR HEIGHT	NO. OF SECTIONS	NO. OF JAMB BRACKETS (EACH JAMB)	LOCATION OF CENTERLINE OF JAMB BRACKETS MEASURED FROM BOTTOM OF TRACK (ALL DIMENSIONS ± 2")
6'-6"	4	7	2" (JB-US), 10" (JB-US), 21-3/4" (JB-US), 29-3/4" (JB-US), 39" (JB-US), 48" (JB-US), 57-1/4" (JB-US)
7'-0"	4	7	2" (JB-US), 10" (JB-US), 21-3/4" (JB-US), 29-3/4" (JB-US), 42" (JB-US), 52-1/2" (JB-US), 63-1/4" (JB-US)
7'-6"	5	8	2" (JB-US), 10" (JB-US), 18-3/4" (JB-US), 26-3/4" (JB-US), 36" (JB-US), 45" (JB-US), 54-1/4" (JB-US), 74-1/2" (JB-US)
8'-0"	5	8	2" (JB-US), 10" (JB-US), 21-3/4" (JB-US), 29-3/4" (JB-US), 39" (JB-US), 48" (JB-US), 57-1/2" (JB-US), 75-1/2" (JB-US)

NOTE:
(JB-US) FOLLOWING DIMENSION DENOTES SLOTTED JAMB BRACKET ATTACHED TO TRACK WITH 1/4-20x9/16" TRACK BOLT AND NUT AS SHOWN ABOVE.

ALL DOORS WITH DECORATIVE OVERLAY REQUIRE USE OF CONTINUOUS WALL ANGLE. SEE SHEET 4 FOR DETAILS. P2

6/25/08

MARK R. BARROW, PE
FLORIDA LICENSE NO. 57389

PRODUCT REVISED
as complying with the Florida Building Code
Acceptance No 08-0630.05
Expiration Date 09/27/2012
By
Miami Dade Product Control Division

Wayne® Dalton
3395 ADDISON DRIVE
PENSACOLA, FLORIDA 32514
(850) 474-9890

STATIC PRESSURE RATINGS		APPROVED SIZES		SCALE: N.T.S.		SIZE:
DESIGN (PSF):	+46.00/-52.00	MAX WIDTH:	18'-0"		DATE	NAME
TEST (PSF):	+69.00/-78.00	MAX HEIGHT:	8'-0"	DRAWN	2/22/07	GRT
IMPACT/CYCLIC RATED (YES/NO):	YES	MAX SECTION HEIGHT:	21"	CHECKED	5/4/07	MRB

MODELS 8024/8124

WINDLOAD SPECIFICATION OPTION CODE 1340

SHEET 1 OF 4

DRAWING PART NO. 329930

REV. P4

PRODUCT REVISED
as complying with the Florida Building Code
Acceptance No 09-0225.03
Expiration Date 09/27/2012
By
Miami Dade Product Control Division

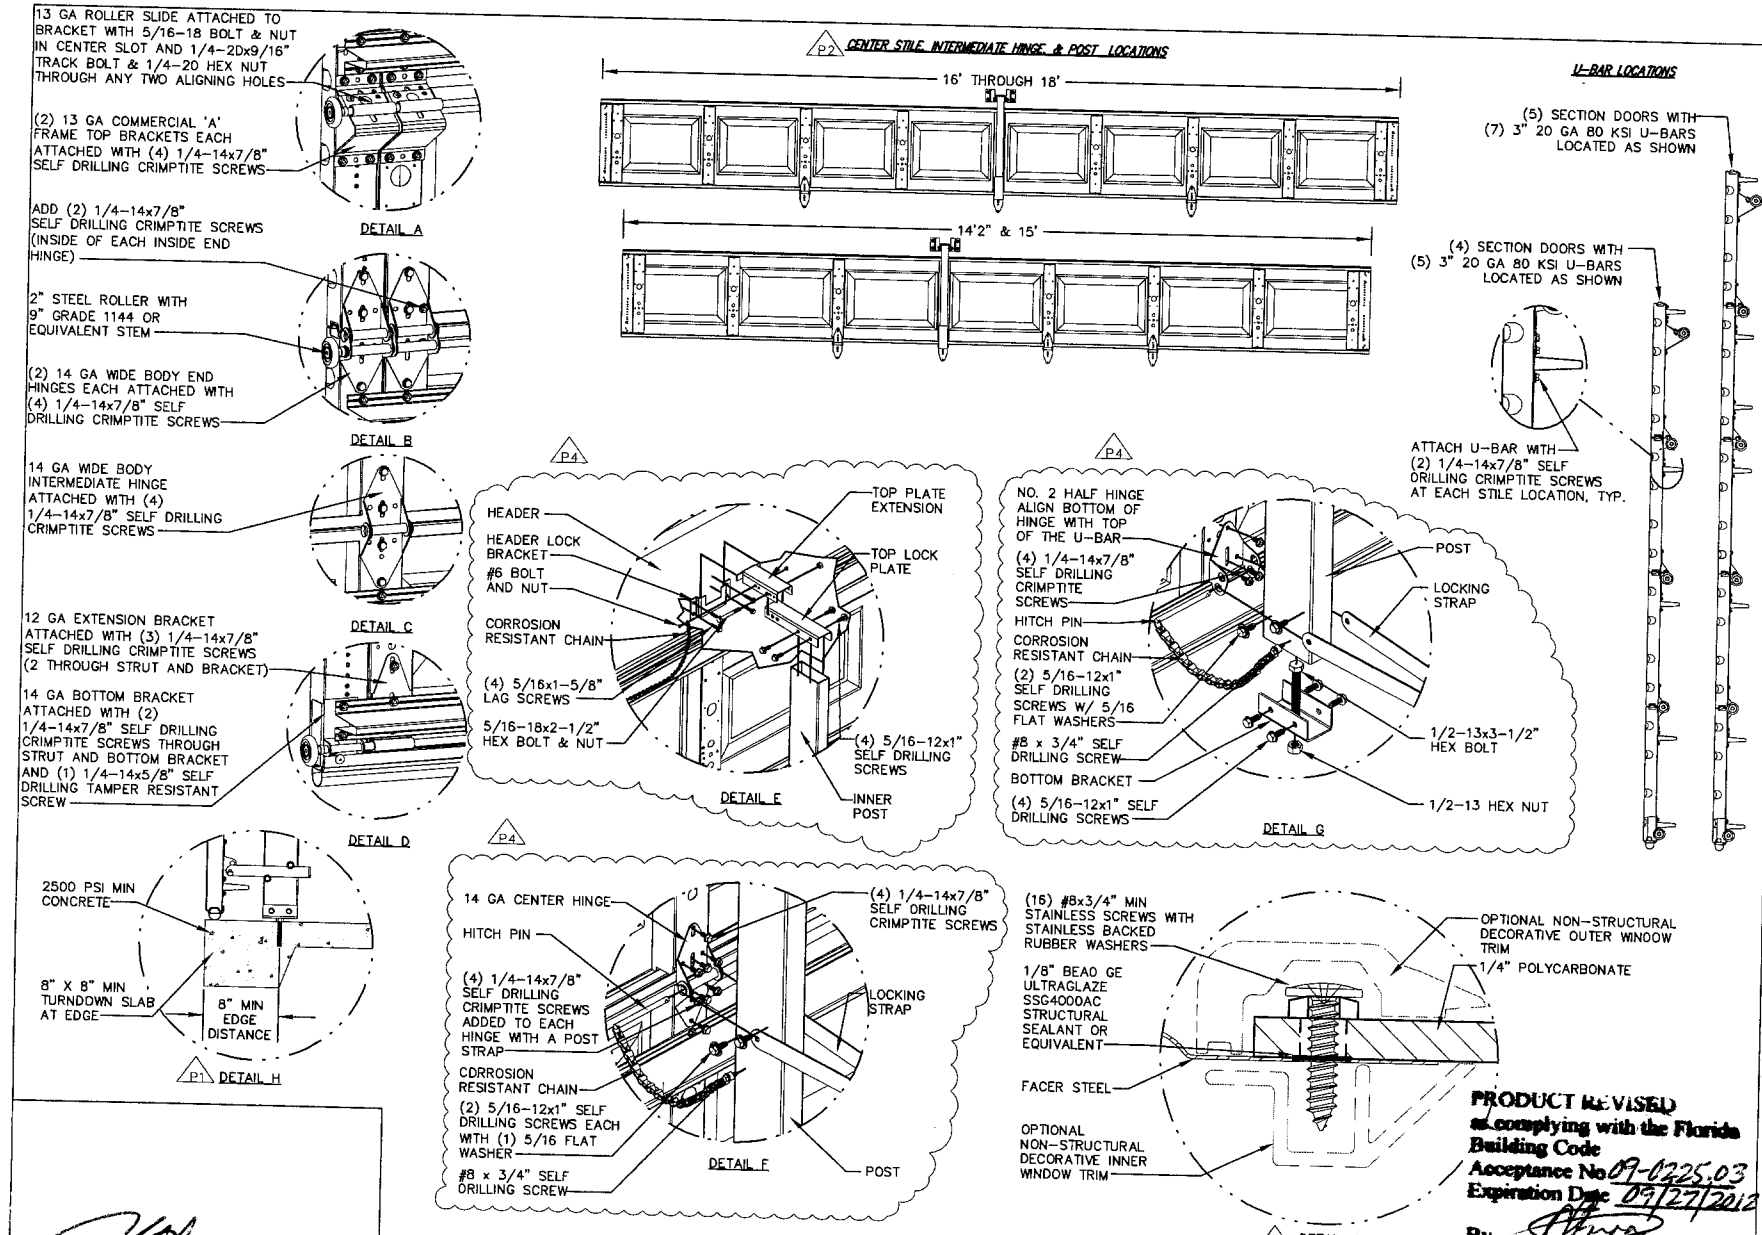

REVISIONS

P1 ADDED POST COMPONENT DETAILS TO SHEET 3. MOVED JAMB DETAIL TO SHEET 4. REMOVED CONCRETE SPECIFICATION FROM NOTES AND ADDED DETAIL H SHEET 2 FOR CONCRETE SPECIFICATION.
GRT 9/13/07

P2 MODIFIED TRACK NOTE FOR DOORS WITH DECORATIVE OVERLAYS. ADDED PAN LAYOUTS FOR 14'2" THRDUGH 16' DOOR WIDTHS. ADDED CONTINUOUS WALL ANGLE DETAIL SHEET 4. UPDATED NOTES FOR CONTINOUS WALL ANGLE MOUNTING.
GRT 10/1/07

P3 ADDED IMPACT RESISTANT GLAZING. MODIFIED NOTES SHEET 1 FOR GLAZING. ADDED DETAIL J SHEET 2 FOR GLAZING.
GRT 11/10/07

P4 ADDED CHAIN TO ATTACH POST TO TRACK AND HITCH PINS TO POST SYSTEM. UPDATED DRAWINGS ON SHEET 1, AND DETAILS E, F, AND G ON SHEET 2. ADDED NOTE 9 ON SHEET 1. ADDED POST STORAGE SHEET 3.
GRT 5/19/08

6/25/08

MARK R. BARROW, PE
FLORIDA LICENSE NO. 57389

PRODUCT REVISED
as complying with the Florida Building Code
Acceptance No 08-0630.05
Expiration Date 09/27/2012
By _____
Miami Dade Product Control Division

PRODUCT REVISED
as complying with the Florida Building Code
Acceptance No 09-0325.03
Expiration Date 09/27/2012
By _____
Miami Dade Product Control Division

Wayne® Dalton
3395 ADDISON DRIVE
PENSACOLA, FLORIDA 32514
(850) 474-9890

STATIC PRESSURE RATINGS		APPROVED SIZES		SCALE: N.T.S.		SIZE: A
DESIGN (PSF):	+46.00/-52.00	MAX WIDTH:	18'-0"		DATE	NAME
TEST (PSF):	+69.00/-78.00	MAX HEIGHT:	8'-0"	DRAWN	2/22/07	GRT
IMPACT/CYCLIC RATED (YES/NO):	YES	MAX SECTION HEIGHT:	21"	CHECKED	5/4/07	MRB

MODELS 8024/8124

SHEET 2 OF 4

WINDLOAD SPECIFICATION OPTION CODE 1340

DRAWING PART NO. 329930

REV. P4

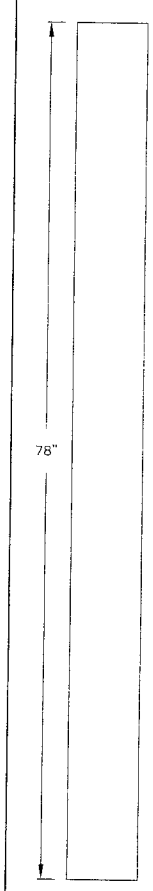

6063 T-6 ALUMINUM OUTER POST

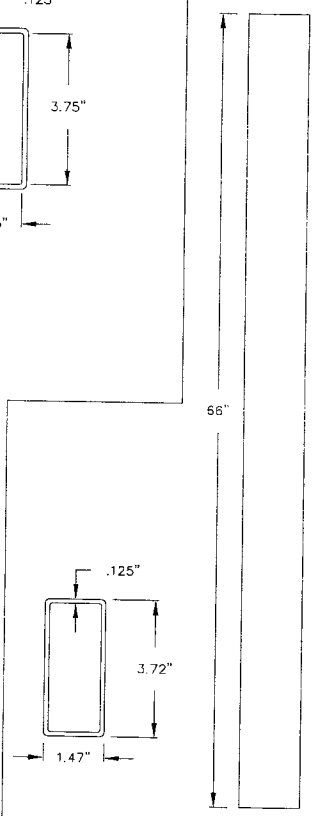

6063 T-6 ALUMINUM INNER POST

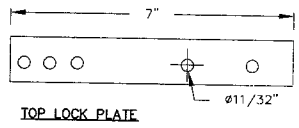

TOP LOCK PLATE

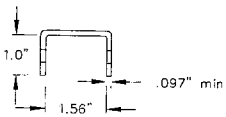

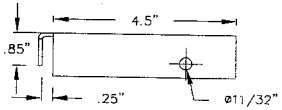

TOP PLATE EXTENSION

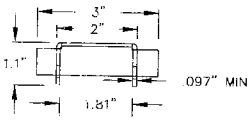

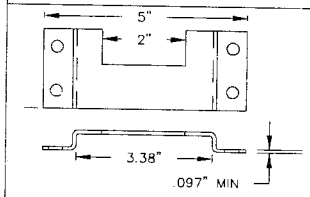

HEADER LOCK BRACKET

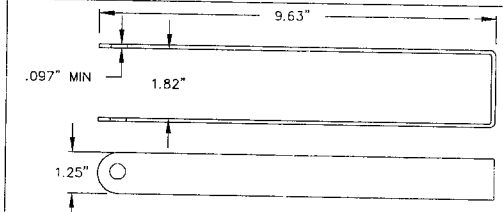

LOCK STRAP

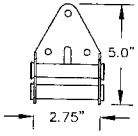

HALF HINGE

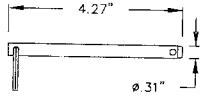

HITCH PIN

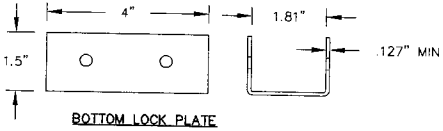

BOTTOM LOCK PLATE

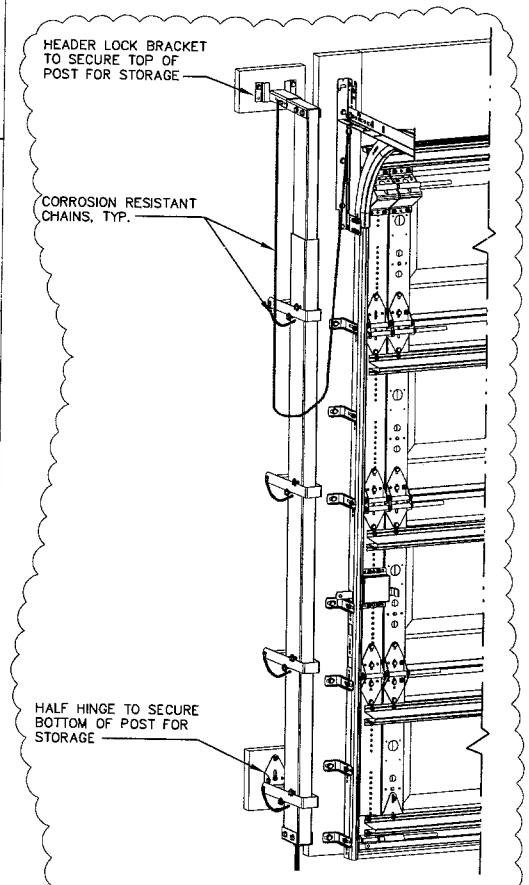

POST SYSTEM STORAGE

NOTE: POST SYSTEM SHALL BE STORED IN A CONVENIENT LOCATION AS CLOSE TO GARAGE DOOR AS POSSIBLE.

P4

PRODUCT REVISED
as complying with the Florida Building Code
Acceptance No 09-0225.03
Expiration Date 09/27/2012
By
Miami Dade Product Control Division

REVISIONS

P1 ADDED POST COMPONENT DETAILS TO SHEET 3. MOVED JAMB DETAIL TO SHEET 4. REMOVED CONCRETE SPECIFICATION FROM NOTES AND ADDED DETAIL H SHEET 2 FOR CONCRETE SPECIFICATION.
GRT 9/13/07

P2 MODIFIED TRACK NOTE FOR DOORS WITH DECORATIVE OVERLAYS. ADDED PAN LAYOUTS FOR 14'2" THROUGH 16' DOOR WIDTHS. ADDED CONTINUOUS WALL ANGLE DETAIL SHEET 4. UPDATED NOTES FOR CONTINOUS WALL ANGLE MOUNTING.
GRT 10/1/07

P3 ADDED IMPACT RESISTANT GLAZING. MODIFIED NOTES SHEET FOR GLAZING. ADDED DETAIL J SHEET 2 FOR GLAZING.
GRT 11/10/07

P4 ADDED CHAIN TO ATTACH POST TO TRACK AND HITCH PINS TO POST SYSTEM. UPDATED DRAWINGS ON SHEET 1, AND DETAILS E, F, AND G ON SHEET 2. ADDED NOTE 9 ON SHEET 1. ADDED POST STORAGE SHEET 3.
GRT 5/19/08

POST SYSTEM COMPONENT DETAILS P1

6/25/08

MARK R. BARROW, PE
FLORIDA LICENSE NO. 57389

PRODUCT REVISED
as complying with the Florida Building Code
Acceptance No 08-0620.05
Expiration Date 09/27/2012
By
Miami Dade Product Control Division

Wayne® Dalton
3395 ADDISON DRIVE
PENSACOLA, FLORIDA 32514
(850) 474-9890

STATIC PRESSURE RATINGS		APPROVED SIZES		SCALE: N.T.S.		SIZE: A
DESIGN (PSF):	+46.00/-52.00	MAX WIDTH:	18'-0"		DATE	NAME
TEST (PSF):	+69.00/-78.00	MAX HEIGHT:	8'-0"	DRAWN	2/22/07	GRT
IMPACT/CYCLIC RATED (YES/NO):	YES	MAX SECTION HEIGHT:	21"	CHECKED	5/4/07	MRB

MODELS 8024/8124

SHEET 3 OF 4

WINDLOAD SPECIFICATION OPTION CODE 1340

DRAWING PART NO. 329930

REV. P4

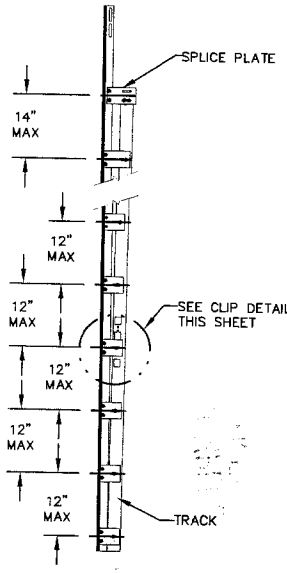

CLIPS TO BE EITHER BOLTED OR WELDED. SEE DETAILS THIS PAGE.

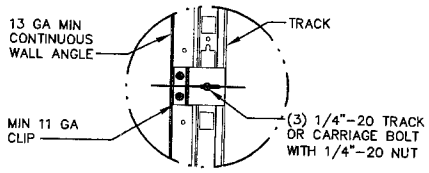

TYPICAL CLIP BOLTING DETAIL

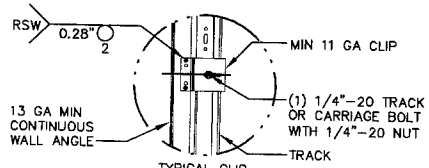

TYPICAL CLIP WELDING DETAIL

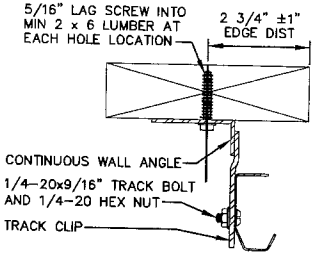

MAX SPACING OF ANCHORS/SCREWS PER JAMB (IN)		
3/8" SIMPSON TITEN HD SCREW ANCHOR TO MINIMUM 2000 PSI CONCRETE NOTE 1	3/8" SIMPSON TITEN HD SCREW ANCHOR TO MINIMUM 2000 PSI GROUT FILLED CMU NOTE 2	3/8" X 3" LONG LAG SCREW NOTE 3
24	24	24

1. BASED ON 3/8" SIMPSON TITEN HEAVY DUTY SCREW ANCHOR WITH A 1" O.D. WASHER INTO CONCRETE WITH A MINIMUM EMBEDMENT DEPTH OF 2-3/4" AND A MINIMUM EDGE DISTANCE OF 2-3/4".
2. BASED ON 3/8" SIMPSON TITEN HEAVY DUTY SCREW ANCHOR WITH A 1" O.D. WASHER INTO GROUT FILLED CMU WITH A MINIMUM EMBEDMENT DEPTH OF 2-3/4", A MINIMUM EDGE DISTANCE OF 4", AND A MINIMUM END DISTANCE OF 4" CONCRETE MASONRY UNITS SHALL CONFORM TO ASTM C90 AND GROUT SHALL CONFORM TO ASTM C476.
3. BASED ON 3/8" DIAMETER x 3" LONG LAG SCREWS WITH 1" O.D. WASHERS WITH A 1-9/32" THREAD PENETRATION INTO SEASONED DRY WOOD SUPPORTING STRUCTURE.
4. PROVIDE QUANTITY OF SCREW ANCHORS OR LAG SCREWS AS REQUIRED TO MAINTAIN MAXIMUM SPACING AS SHOWN IN TABLE WITH A MINIMUM OF THREE (3) SCREW ANCHORS OR LAG SCREWS PER JAMB. SCREW ANCHORS OR LAG SCREWS AT TOP AND BOTTOM OF JAMB SHALL BE PLACED A MAXIMUM OF 6" FROM THE END OF THE JAMB.
5. LOAD PER JAMB CALCULATED TO BE A MAXIMUM OF +190.7/-215.7 LBS PER FOOT.
6. CHART INCLUDES A SAFETY FACTOR OF 4.
7. DOOR JAMB TO BE MINIMUM 2x6 NO. 3 SOUTHERN PINE LUMBER (MIN) MOUNTED DIRECTLY TO SUPPORT STRUCTURE.
8. DESIGN OF THE SUPPORT STRUCTURE SHALL BE THE SOLE RESPONSIBILITY OF THE BUILDING DESIGNER AND SHALL BE DESIGNED FOR THE LOADS LISTED IN NOTE 5.
9. SCREW ANCHORS OR LAG SCREWS SHALL BE INSTALLED PER MANUFACTURER'S WRITTEN INSTRUCTIONS.

REVISIONS

P1 ADDED POST COMPONENT DETAILS TO SHEET 3. MOVED JAMB DETAIL TO SHEET 4. REMOVED CONCRETE SPECIFICATION FROM NOTES AND ADDED DETAIL H SHEET 2 FOR CONCRETE SPECIFICATION.
GRT 9/13/07

P2 MODIFIED TRACK NOTE FOR DOORS WITH DECORATIVE OVERLAYS. ADDED PAN LAYOUTS FOR 14'2" THROUGH 16' DOOR WIDTHS. ADDED CONTINUOUS WALL ANGLE DETAIL SHEET 4. UPDATED NOTES FOR CONTINOUS WALL ANGLE MOUNTING.
GRT 10/1/07

P3 ADDED IMPACT RESISTANT GLAZING. MODIFIED NOTES SHEET FOR GLAZING. ADDED DETAIL J SHEET 2 FOR GLAZING.
GRT 11/10/07

P4 ADDED CHAIN TO ATTACH POST TO TRACK AND HITCH PINS TO POST SYSTEM. UPDATED DRAWINGS ON SHEET 1, AND DETAILS E, F, AND G ON SHEET 2. ADDED NOTE 9 ON SHEET 1. ADDED POST STORAGE SHEET 3.
GRT 5/19/08

P2 CONTINOUS WALL ANGLE DETAILS

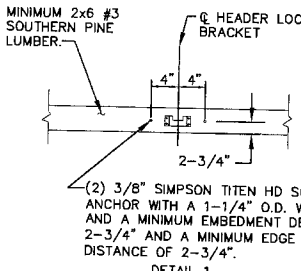

DETAIL 1
MINIMUM 2000 PSI CONCRETE

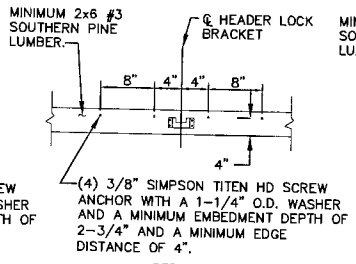

DETAIL 2
MINIMUM 2000 PSI GROUT FILLED CMU

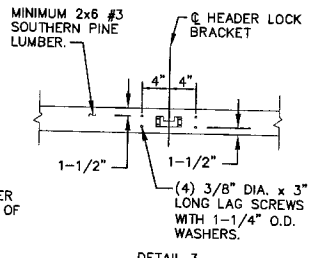

DETAIL 3
WOOD SUPPORT STRUCTURE

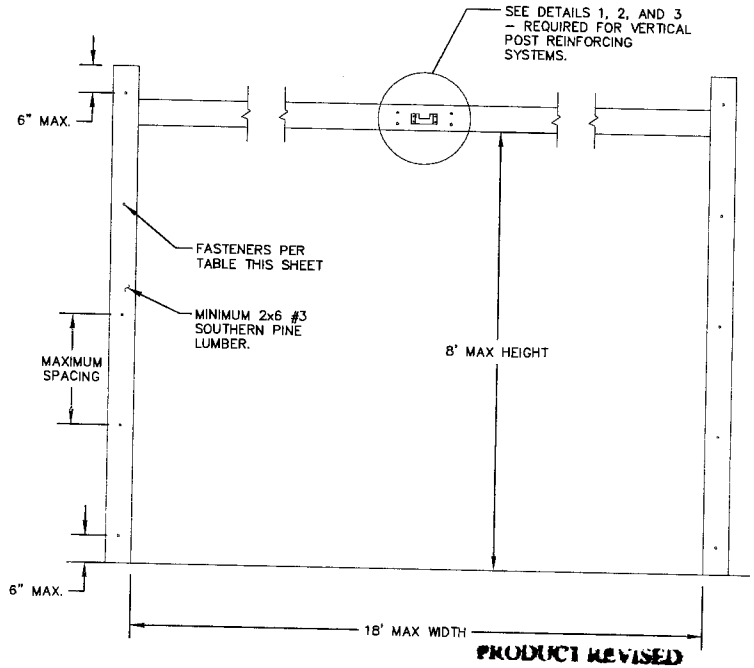

PRODUCT REVISED
as complying with the Florida Building Code
Acceptance No 09-0225.03
Expiration Date 09/27/2012
By
Miami Dade Product Control Division

6/25/08

MARK R. BARROW, PE
FLORIDA LICENSE NO. 57389

PRODUCT REVISED
as complying with the Florida Building Code
Acceptance No 08-0630.05
Expiration Date 09/27/2012
By
Miami Dade Product Control Division

Wayne® Dalton
3395 ADDISON DRIVE
PENSACOLA, FLORIDA 32514
(850) 474-9890

STATIC PRESSURE RATINGS		APPROVED SIZES		SCALE: N.T.S.		SIZE: A
DESIGN (PSF):	+46.00/-52.00	MAX WIDTH:	18'-0"		DATE	NAME
TEST (PSF):	+69.00/-78.00	MAX HEIGHT:	8'-0"	DRAWN	2/22/07	GRT
IMPACT/CYCLIC RATED (YES/NO):	YES	MAX SECTION HEIGHT:	21"	CHECKED	5/4/07	MRB

MODELS 8024/8124

SHEET 4 OF 4

WINDLOAD SPECIFICATION OPTION CODE 1340

DRAWING PART NO. 329930

REV. P4