



DEPARTMENT OF PERMITTING, ENVIRONMENT, AND REGULATORY
 AFFAIRS (PERA)
 BOARD AND CODE ADMINISTRATION DIVISION
NOTICE OF ACCEPTANCE (NOA)

MIAMI-DADE COUNTY
 PRODUCT CONTROL SECTION
 11805 SW 26 Street, Room 208
 Miami, Florida 33175-2474
 T (786) 315-2590 F (786) 315-2599
www.miamidade.gov/pera/

Dorma Automatics, Inc.
 924 Sherwood Drive
 Lake Bluff, IL 60044

SCOPE:

This NOA is being issued under the applicable rules and regulations governing the use of construction materials. The documentation submitted has been reviewed and accepted by Miami-Dade County PERA -Product Control Section to be used in Miami Dade County and other areas where allowed by the Authority Having Jurisdiction (AHJ).

This NOA shall not be valid after the expiration date stated below. The Miami-Dade County Product Control Section (In Miami Dade County) and/or the AHJ (in areas other than Miami Dade County) reserve the right to have this product or material tested for quality assurance purposes. If this product or material fails to perform in the accepted manner, the manufacturer will incur the expense of such testing and the AHJ may immediately revoke, modify, or suspend the use of such product or material within their jurisdiction. PERA reserves the right to revoke this acceptance, if it is determined by Miami-Dade County Product Control Section that this product or material fails to meet the requirements of the applicable building code.

This product is approved as described herein, and has been designed to comply with the Florida Building Code, including the High Velocity Hurricane Zone.

DESCRIPTION: Series "ESA 300" Aluminum Automatic Sliding Glass Door (O-Sx-Sx-O) w/ Breakout

APPROVAL DOCUMENT: Drawing No. **05-DOA-0004**, titled "ESA 300 Series Automatic Sliding Glass Doors (Large Missile-Impact Resistant)", sheets 1 through 4 of 4, prepared by Engineering Express, dated 05/09/06, and last revised on 03/12/12, signed and sealed by Frank L. Bennardo, P.E., bearing the Miami-Dade County Product Control Revision stamp with the Notice of Acceptance number and expiration date by the Miami-Dade County Product Control Section.

MISSILE IMPACT RATING: Large and Small Missile Impact

- Limitation:**
1. Fixed panel top Rails to be secured with #10x 3/4"SMS @6" OC at Head and bottom Rail with #10x 3/4"SMS @6" OC at bottom guide.
 2. Electrical devices are not part of this approval and must be reviewed by corresponding authority.
 3. See applicable Design Pressure rating per glazing type B, C or D in sheet 1.

LABELING: Each unit shall bear a permanent label with the manufacturer's name or logo, city, state and series and following statement: "Miami-Dade County Product Control Approved", unless otherwise noted herein.

RENEWAL of this NOA shall be considered after a renewal application has been filed and there has been no change in the applicable building code negatively affecting the performance of this product.

TERMINATION of this NOA will occur after the expiration date or if there has been a revision or change in the materials, use, and/or manufacture of the product or process. Misuse of this NOA as an endorsement of any product, for sales, advertising or any other purposes shall automatically terminate this NOA. Failure to comply with any section of this NOA shall be cause for termination and removal of NOA.

ADVERTISEMENT: The NOA number preceded by the words Miami-Dade County, Florida, and followed by the expiration date may be displayed in advertising literature. If any portion of the NOA is displayed, then it shall be done in its entirety.

INSPECTION: A copy of this entire NOA shall be provided to the user by the manufacturer or its distributors and shall be available for inspection at the job site at the request of the Building Official.

This NOA **revises & renews** NOA # **09-0415.06** and consists of this page 1 and evidence pages E-1, as well as approval document mentioned above.

The submitted documentation was reviewed by **Ishaq I. Chanda, P.E.**



4/14/12

NOA No 11-1213.06
 Expiration Date: February 01, 2017
 Approval Date: April 12, 2012
 Page 1

NOTICE OF ACCEPTANCE: EVIDENCE SUBMITTED

A. DRAWINGS

1. Manufacturer's die drawings and sections (transferred from file # **09-0415.06**)
2. Drawing No. **05-DOA-0004**, titled "ESA 300 Series Automatic Sliding Glass Doors (Large Missile-Impact Resistant)", sheets 1 through 4 of 4, prepared by Engineering Express, dated 05/09/06, and last revised on 03/12/12, signed and sealed by Frank L. Bennardo, P.E.

Note: This revision consists of FBC 2010 notes only.

B. TESTS (transferred from file # **09-0415.06)**

1. Test reports on:
 - 1) Air Infiltration Test, per FBC, TAS 202-94
 - 2) Uniform Static Air Pressure Test, Loading per FBC TAS 202-94
 - 3) Water Resistance Test, per FBC, TAS 202-94(Not performed)
 - 4) Large Missile Impact Test per FBC, TAS 201-94
 - 5) Cyclic Wind Pressure Loading per FBC, TAS 203-94
 - 6) Forced Entry Test, per FBC 2411 3.2.1, TAS 202-94

Along with marked-up drawings and installation diagram of an automatic aluminum Sliding Glass Door, prepared by Hurricane Test Laboratory, LLC, Test Report No(s). **HTL-0357-0107-06** (Sp#1 &2) dated 01/04/06-03/30/07 and **HTL-0357-0605-05** (Sp#1, 2 &3) dated 08/25/05-09/20/05, signed & sealed by Vinu J. Abraham, P.E.

C. CALCULATIONS

1. Statement letter dated March 09, 2012, stating conformance to FBC 2010, prepared, signed and sealed by Frank L. Bennardo, P. E.
2. Anchor Verification Calculations, complying w/ FBC-2007, 01-26-2009 and last revised on 08/10/09, prepared, signed and sealed by Frank L. Bennardo, P. E. (transferred from file # **09-0415.06**)
3. Glazing complies w/ ASTM E-1300-02 & -04

D. QUALITY ASSURANCE

1. Miami Dade Department of Permitting, Environment, and Regulatory Affairs (PERA).

E. MATERIAL CERTIFICATIONS


1. Notice of Acceptance No. **08-1224.04** issued to issued to Solutia Inc., for "Saflex Composite Glass Interlayer w/ PET core", expiring on 12/11/2013.
2. Notice of Acceptance No. **10-0819.04** issued to E.I. DuPont DeNemours, for "DuPont Spallshield ® interlayer (former Sentry Glass ® 457)", expiring on 01/13/2016.

F. STATEMENTS

1. Statement letter dated 03/09/12, conformance to FBC 2010 and statement of no financial interest and Engineer still in business, prepared, signed and sealed by Frank L. Bennardo, P. E.
2. Statement letter compliance to FBC-2007, dated April 08, 2009, prepared, signed and sealed by Frank L. Bennardo, P. E. (transferred from file # **09-0415.06**).
3. Lab compliance as part of the above referenced test report.

G. OTHER

1. This NOA **revises & renews** NOA # **09-0415.06**, expired on February 01, 2012.

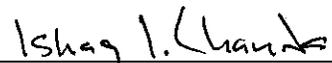


Ishaq I. Chanda, P.E.
Product Control Examiner
NOA No 11-1213.06

Expiration Date: February 01, 2017

Approval Date: April 12, 2012

ESA 300 AUTOMATIC SLIDING GLASS DOOR

LARGE MISSILE IMPACT RESISTANT - FULL BREAKOUT

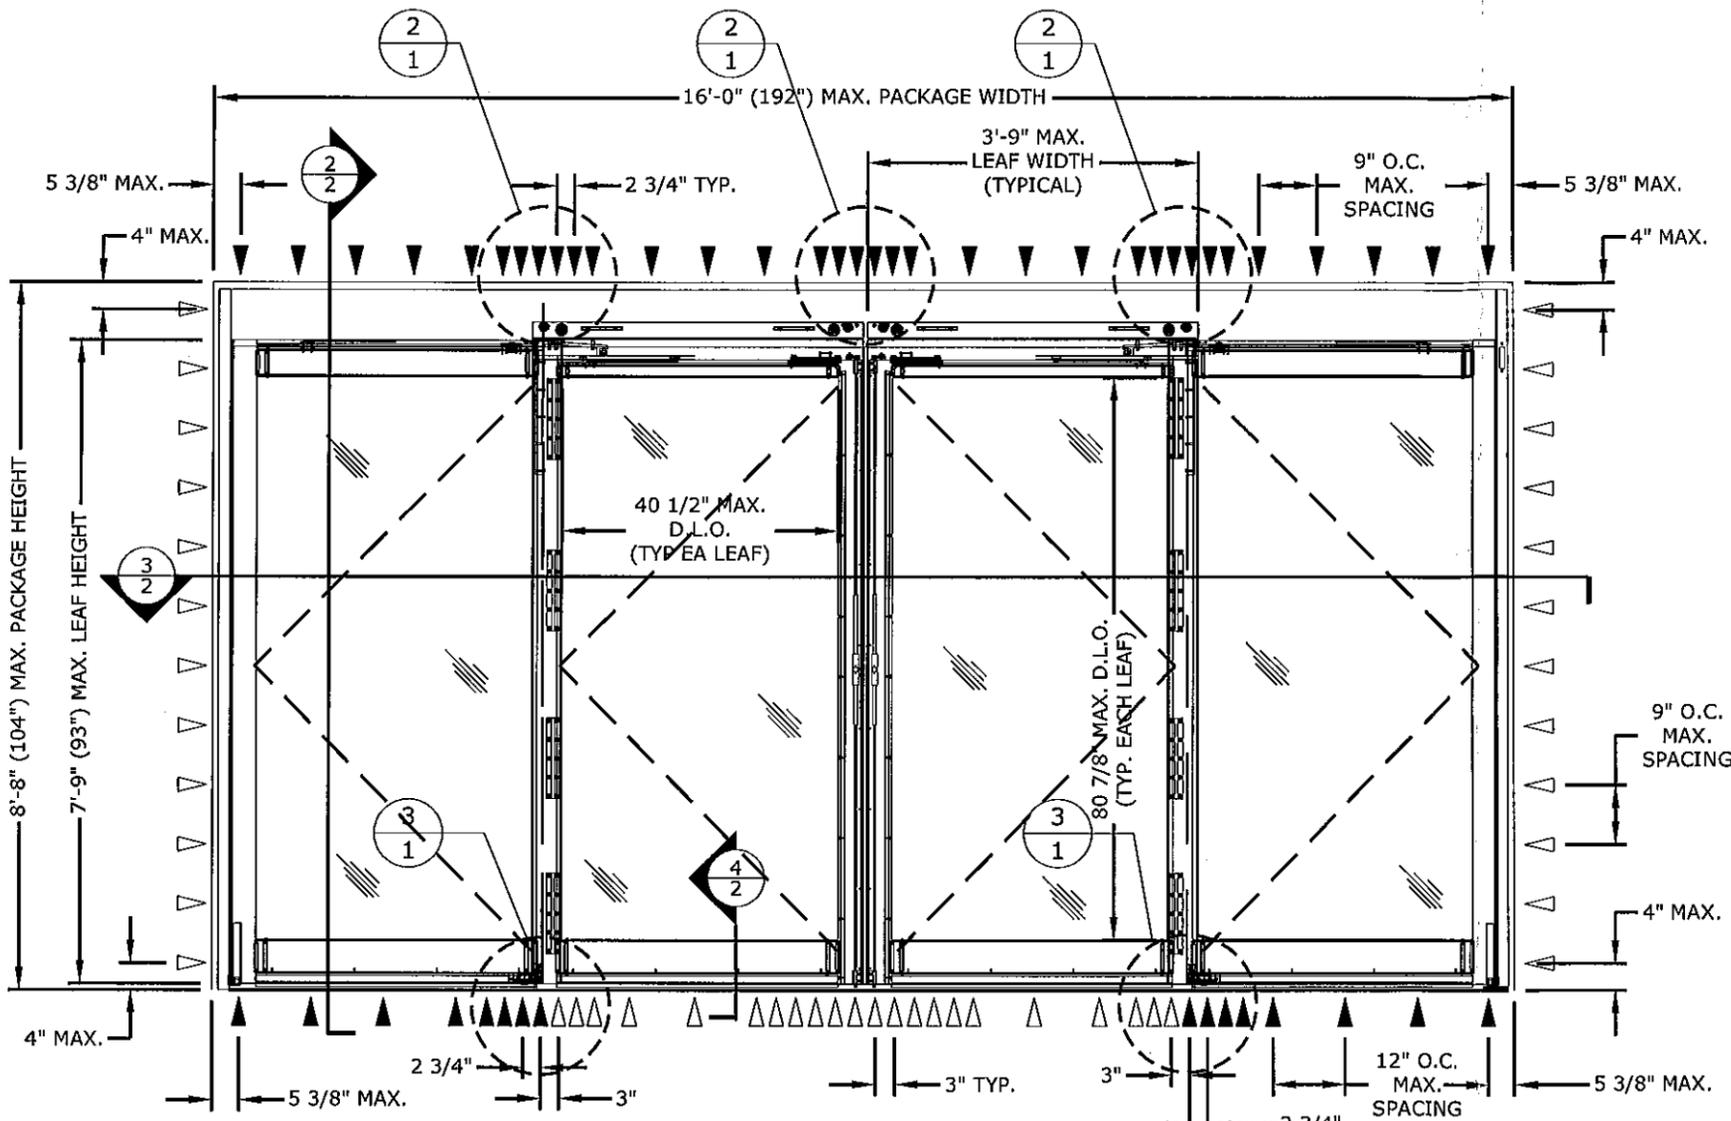


EXTERIOR ELEVATION

1 SO-SX-SX-SO (CONFIGURATION)
1 N.T.S. ELEV.

ANCHOR LEGEND:

▽ INDICATES SINGLE ANCHOR (INLINE)

▼ INDICATES STAGGERED PAIR OF ANCHORS (CENTERLINE SHOWN ON ELEVATION)

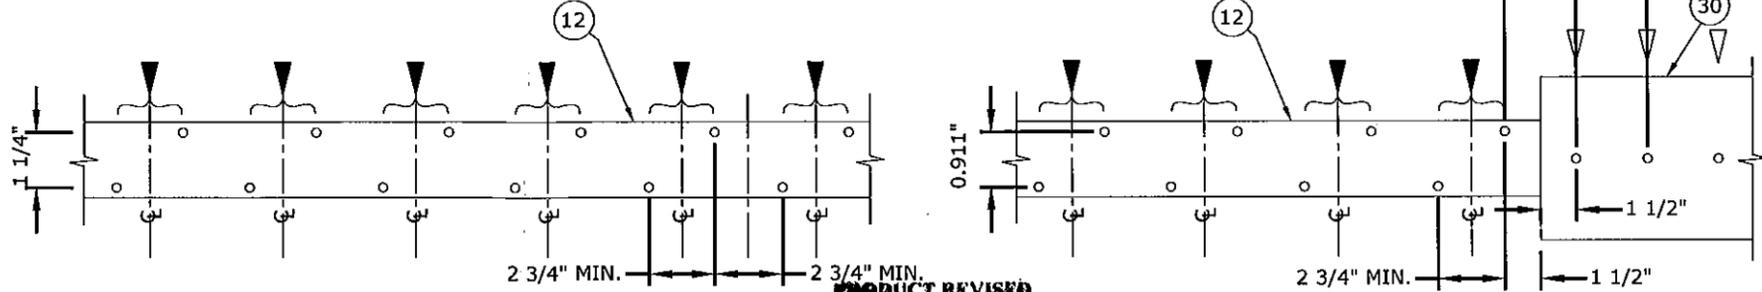

2 HEAD CLUSTER
1 N.T.S. PLAN VIEW

3 SILL CLUSTER
1 N.T.S. PLAN VIEW

DESIGN PRESSURE RATING			
	WHERE WATER INFILTRATION REQUIREMENT IS NEEDED.	WHERE WATER INFILTRATION REQUIREMENT IS NOT NEEDED.	
GLAZING TYPES	"B", "C" OR "D" *	"B" *	"C" OR "D" *
POSITIVE	NOT APPROVED	+ 45.0 PSF	+ 52.4 PSF
NEGATIVE	NOT APPROVED	- 45.0 PSF	- 52.4 PSF

* SEE GLAZING SCHEDULE ON SHEET "2"

GENERAL NOTES:

1. THIS PRODUCT HAS BEEN TESTED & DESIGNED IN ACCORDANCE WITH THE REQUIREMENTS OF THE 2010 FLORIDA BUILDING CODE - HIGH VELOCITY HURRICANE ZONE (HVHZ) - AND HVHZ TEST PROTOCOL TAS 201, 202 & 203 AS LARGE MISSILE IMPACT RESISTANT SYSTEM.
2. NO 33-1/3% INCREASE IN ALLOWABLE STRESS HAS BEEN USED IN THE DESIGN OF THIS SYSTEM. WIND LOAD DURATION FACTOR Cd=1.6 HAS BEEN USED FOR WOOD ANCHOR DESIGN.
3. POSITIVE & NEGATIVE DESIGN PRESSURES CALCULATED FOR USE WITH THIS SYSTEM SHALL BE DETERMINED BY OTHERS ON A JOB-SPECIFIC BASIS IN ACCORDANCE WITH THE GOVERNING CODE.
4. THE SYSTEM DETAILED HEREIN IS GENERIC AND DOES NOT PROVIDE INFORMATION FOR A SPECIFIC SITE. WHERE SITE CONDITIONS DIFFER FROM THE CONDITIONS DETAILED HEREIN, A LICENSED ENGINEER OR REGISTERED ARCHITECT SHALL PREPARE SITE SPECIFIC DOCUMENTS FOR USE IN CONJUNCTION WITH THIS DOCUMENT.
5. PERMIT HOLDER SHALL VERIFY THE ADEQUACY OF THE EXISTING STRUCTURE TO WITHSTAND ADDITIONAL IMPOSED LOADS. WOOD BUCKS NOT BY THIS PRODUCT MANUFACTURER SHALL BE ANCHORED PROPERLY TO TRANSFER LOADS TO THE HOST STRUCTURE.
6. THE PRODUCT DETAILED HEREIN HAS BEEN DESIGNED AND TESTED TO THE MAXIMUM SPANS & LOADS SHOWN ON THESE DRAWINGS.
7. ALL ALUMINUM EXTRUSIONS ARE 6063-T5 OR 6063-T6 ALUMINUM.
8. ALL UNITS ARE LARGE MISSILE IMPACT RESISTANT AND DO NOT REQUIRE IMPACT RESISTANT SHUTTERS FOR ALL EXTERIOR DOOR INSTALLATIONS.
9. ANCHORS SHALL BE INSTALLED PER MANUFACTURER'S SPECIFICATIONS, SPACED AS NOTED HEREIN. ANCHOR EMBEDMENT TO BASE MATERIAL DOES NOT INCLUDE WALL DRESSING OR STUCCO.
10. ALL BOLTS & WASHERS SHALL BE ZINC COATED, GALVANIZED, OR STAINLESS STEEL WITH A MINIMUM TENSILE STRENGTH OF 60 KSI, EXCEPT INSTALLATION ANCHORS.
11. ALL STEEL IN CONTACT WITH ALUMINUM SHALL BE PAINTED OR COATED.
12. STRUCTURAL SILICONE ADHESIVE IS APPLIED ATOP OF HEADER, JAMBS, AND BELOW SIDE GUIDE, SPACER, AND THRESHOLDS.

FRANK L. BERNARDO, P.E.
 LICENSE NO. 15434
 03/12/2011
 No. 46549
 PROFESSIONAL ENGINEER
 STATE OF FLORIDA
 ENGINEERING OR EXPRESS
 160 SW 12th Avenue, #1008
 DEERFIELD BEACH, FL 33442
 Ph: (954) 354-0660 Fax: (954) 354-0443
 WWW.ENGP.ENGEX.P.COM
 CERT. OF AUTH. #9885
 A FRANK L. BERNARDO, P.E., INC. INNOVATIONS

DORMA AUTOMATICS
 924 SHERWOOD DRIVE
 LAKE BLUFF, ILLINOIS 60044
 WWW.DORMA-USA.COM

ESA 300 SERIES
 AUTOMATIC SLIDING GLASS DOORS
 (LARGE MISSILE IMPACT RESISTANT)


REMARKS	DRWN	CHKD	DATE
INT. ISSUE	AML	CL	05/09/06
BCCO COMMENTS	AML	CL	11/06/06
2007 FBC	RKB	CL	01/16/08
2010 FBC	KL	FLB	03/09/12

05-DOA-0004
 SCALE: N.T.S. 03
 PAGE DESCRIPTION:
 1


F:\01 Project Files\Dorma Automatics (DOA)\2005\05-DOA-0004 "ESA300" Full Breakout Auto Sliding Door, LMI (NOA)\05-DOA-0004_03a ESA 300 LMI (NOA).dwg
 03/12/2012 - 4:34pm keithl

BILL OF MATERIALS

ITEM	PART NUMBER	DESCRIPTION	QTY
1	DE0199-03	SO TOP RAIL ASSEMBLY ESA300	2
2	DE0203-01	SO PIVOT ASSEMBLY ESA300	2
3	DE0202-01	SO INTERLOCK / PIVOT RAIL ASSEMBLY ESA300	2
4	DE0186-01	SO BOTTOM RAIL ASSEMBLY ESA300	2
4a	DE0187-02	9 1/4" ALTERNATE O BOTTOM RAIL PANEL	2
5	DE0200-01	JAMB DOUBLE POCKET	1
6	DE0158-03	HEADER FACEPLATE	1
7	DE0155-04	HEADER ASSEMBLY (REGULAR)	1
8	DE0159-02	HEADER ADAPTER	1
9	DS1979-010	SO BTM PIVOT ASSEMBLY	2
10	DF0628-00G	10-24X3/4 PHILPS FL CS.SS	8
11	DE2212-020	WEATHERSTRIP "13.4mm"	16
12	DE0195-010	BOTTOM TRACK	1
13	DE0234-010	TRACK CAP	1
14	DC2185-010	SIDE CARRIER	2
15	DC1498-010	HEADER BACK BLOCK	2
16	DF0728-01Z	1/4-20X1" HX-HD MS GR5 ZINC	10
17	DF0939-01Z	A6.4(M6) SPRING WASHER ZINC	10
18	DC0831-010	COVER HOLDING BAR	1
19	DF0999-01Z	10-24X3/4" PH FL HD UNC ZINC	4
20	DE1767-010	GLASS STOP EXT.	1
21	DE0210-010	GLASS STOP 1/4" SNAP	1
22	DE0148-020	GLAZING BEAD CO-EXTRUSION	1
23	DF0385-010	RIVET NUT 1/4-20 SF UNC IFC STEEL	10
26	DE0201-02	VERTICAL LOCK RAIL	1
27	DS1727-010	SX TOP RAIL ASSEMBLY ESA300	1
28	DE0188-01	SX BOTTOM RAIL ASSEMBLY ESA300	2
28a	DE0187-02	9 1/4" ALTERNATE SX BOTTOM RAIL ASSEMBLY	2
29	DS1724-010	CARRIER ASSEMBLY	1
30	DE0246-01A	THRESHOLD BI-PART (MACHINED)	1
31	DC0837-010	BOTTOM PLATE	1
32	DF0848-01Z	1/4-20X1/2 FL HD SOC SC ZINC	4
34	DS1831-010	SX PIVOT ASSEMBLY ESA300	1
36	DE0162-020	SX TOP RAIL ASSEMBLY ESA300	1
37	DS1833-010	CARRIER ASSEMBLY	1
38	DC0572-00A	LOCK CYLINDER RING CLEAR/DC0572-00B	1
39	DC0571-00A	KEY LOCK CYLINDER -CLEAR/ DC0571-00B	1
40	DC0621-00A	THUMB KEY-CLEAR/ DC0621-00B-DARK BRONZE	1
41	DC2057-010	3 POINTS CONVERTER ADAMS RITE P/N "MS 4016-20-02"	1
42	DC1766-010	ASTRAGAL- L.H	1
43	DC1701-010	ASTRAGAL- R.H	1
44	DC1497-010	LATCH BLOCK	4
45	DC1700-010	PUSH BAR	2
46	DS1827-010	SO-INTERLOCK RAIL ASSEMBLY	1
48	DC2055-010	2 WAY BOLT ADAMS RITE P/N "MS 1880-03-682"	1
49	DC0836-010	BREAKOUT INTERLOCK CLIP	4
50	DC0838-010	ANTI-DERAIL BLOCK	4
51	DC1978-01Z	BREAKOUT STOP	2
52	DC2492-01Z	CATCH PLATE	1
53	DE0152-120	BRUSH	1

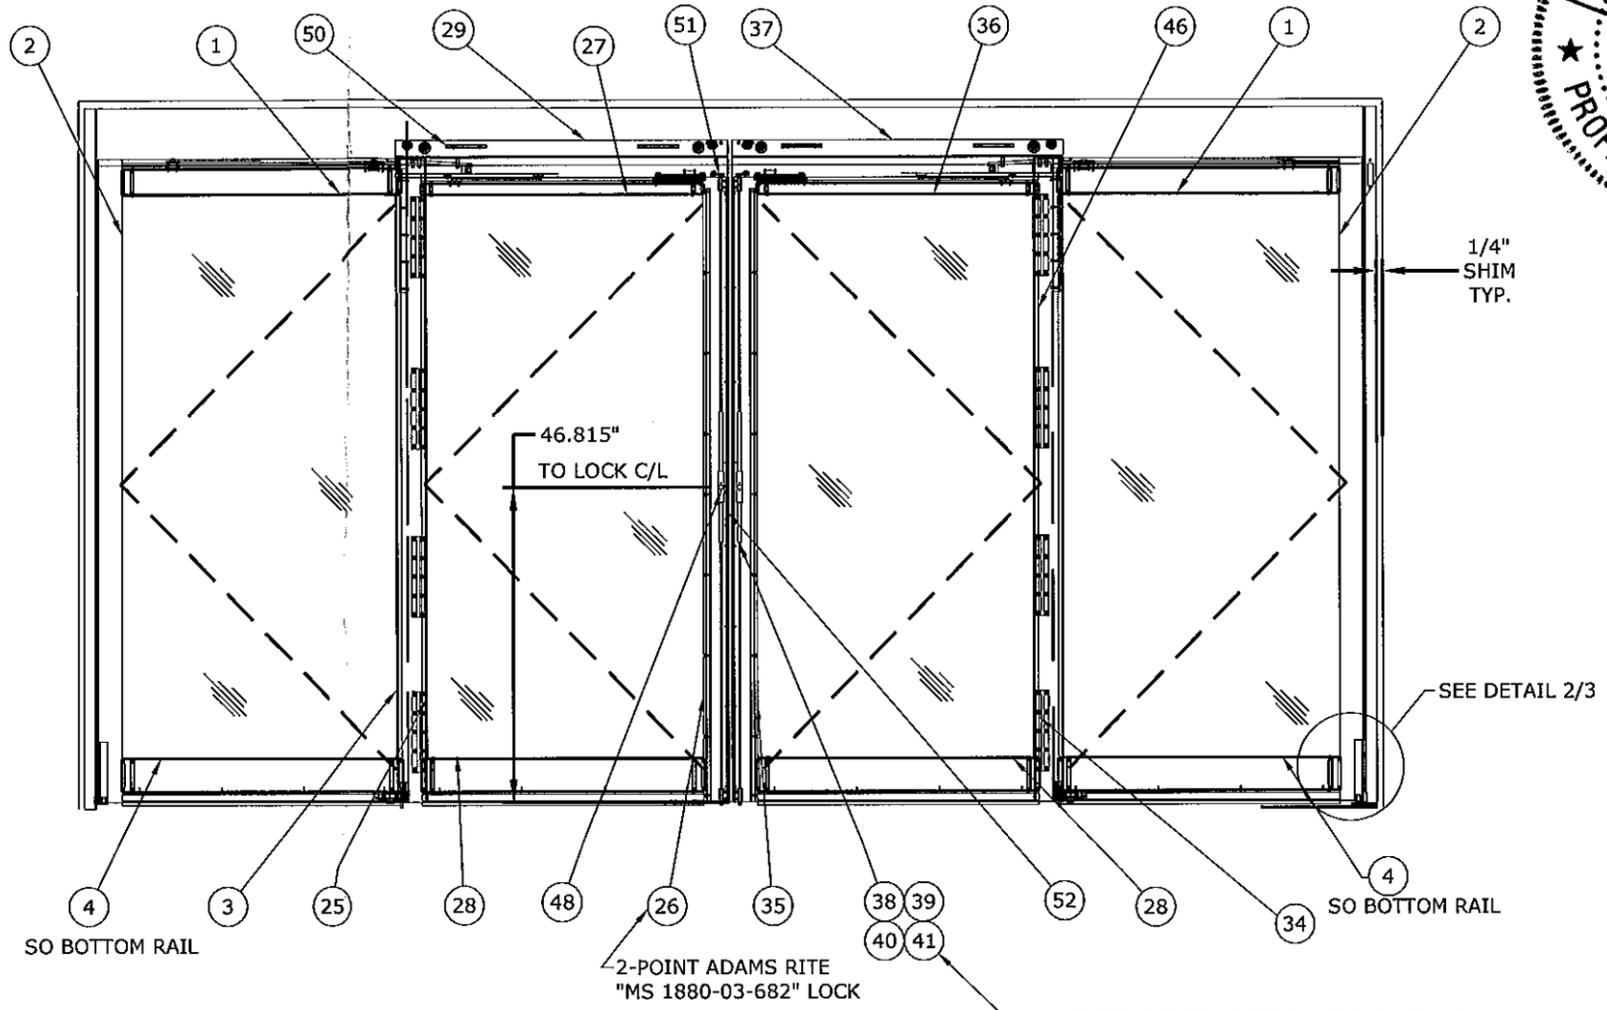

1 EXTERIOR ELEVATION
 3 N.T.S. ELEV.

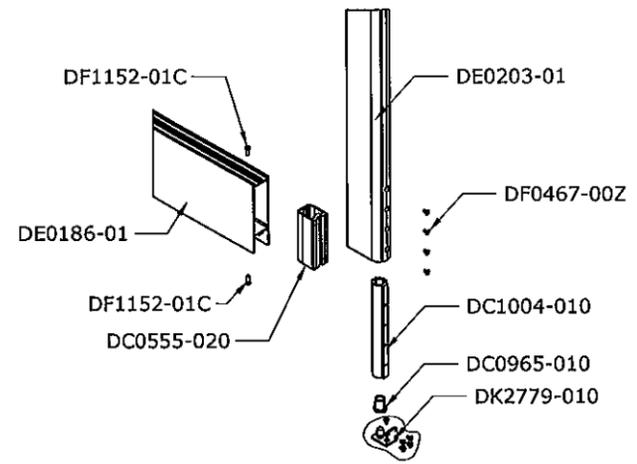

2 CORNER DETAIL
 3 N.T.S. ELEV.

INSTALL 3 POINTS CONVERTER ADAMS RITE P/N "MS 4016-20-02" THUMBTURN TO FACE INTERIOR ONLY.

1/4" SHIM TYP.

SEE DETAIL 2/3

FRANK L. BERNARDO
 LICENSE
 03/12/2012
 No. 46549
 STATE OF
 ENGINEERING
 EXPRESS
 160 SW 12th AVENUE # 116
 DEERFIELD BEACH, FL 33442
 Ph: (954) 354-0660 Fax: (954) 354-0443
 WWW.ENGPX.COM
 CERT. OF AUTH. #9885
 A FRANK L. BERNARDO, P.E., INC. ENGINEER

DORMA AUTOMATICS
 924 SHERWOOD DRIVE
 LAKE BLUFF, ILLINOIS 60044
 WWW.DORMA-USA.COM
 ESA 300 SERIES
 AUTOMATIC SLIDING GLASS DOORS
 (LARGE MISSILE IMPACT RESISTANT)



















DATE	DRWN	CHKD	DATE	REMARKS
05/09/06	AML	CL	05/09/06	INIT ISSUE
11/06/06	AML	CL	11/06/06	RECO COMMENTS
07/16/08	RGB	CL	07/16/08	2007 FBC
03/08/12	KL	FLB	03/08/12	2010 FBC

PRODUCT REVISED
 to comply with the Florida
 Building Code
 Acceptance No. 11-1213.06
 Expiration Date 2/1/17
 [Signature]

05-DOA-0004
 SCALE: N.T.S. 1/3
 PAGE DESCRIPTION:

F:\01 Project Files\Dorma Automatics (DOA)\2005\05-DOA-0004 "ESA300" Full Breakout Auto Sliding Door, LMI (NOA)\05-DOA-0004_03a ESA 300 LMI (NOA).dwg 03/12/2012 - 4:35pm keithl

F:\01 Project Files\Dorma Automatics (DOA)\2005\05-DOA-0004 "ESA300" Full Breakout Auto Sliding Door, LMI (NOA)\05-DOA-0004_03a ESA 300 LMI (NOA).dwg

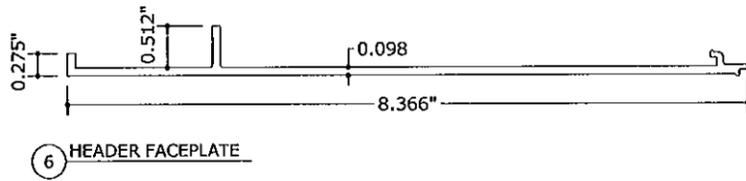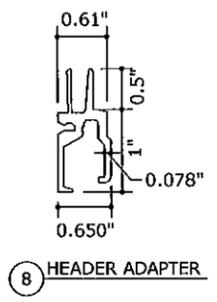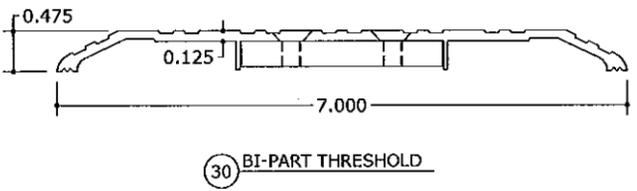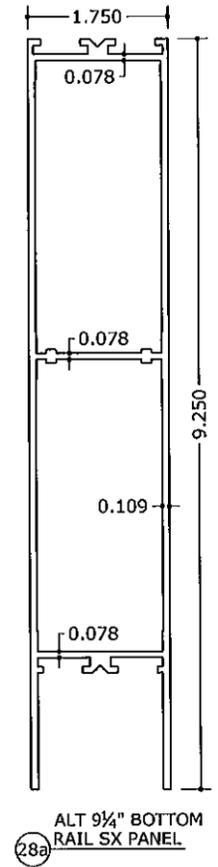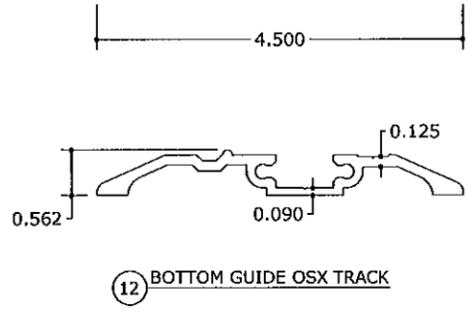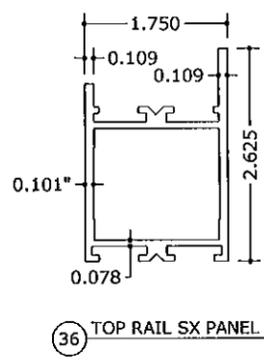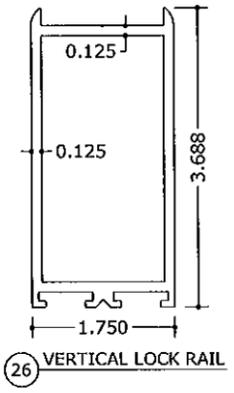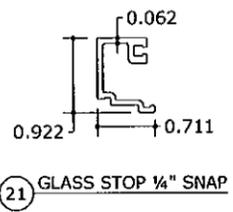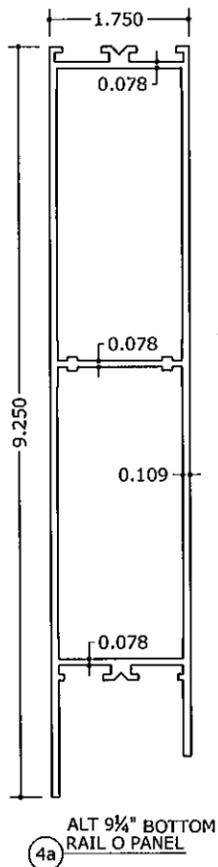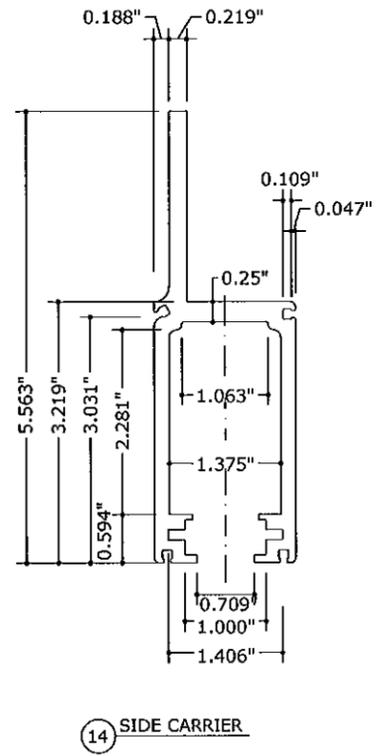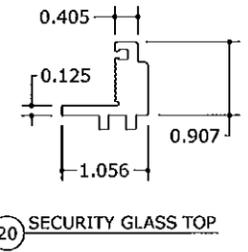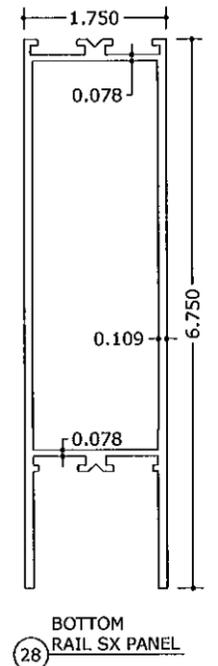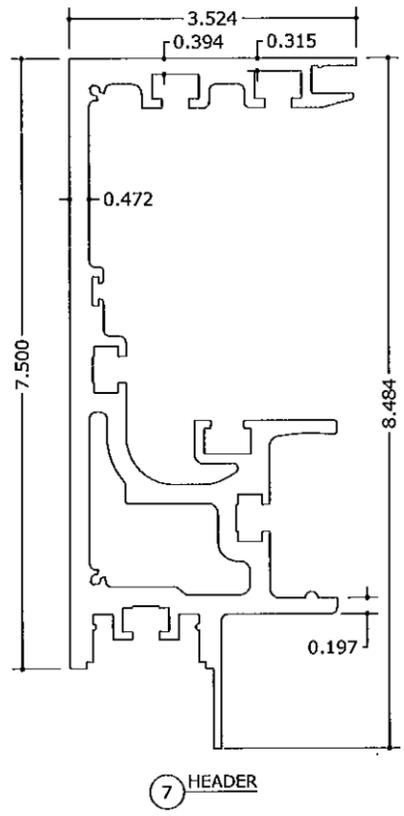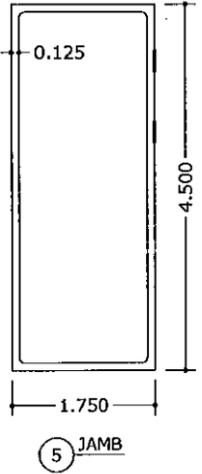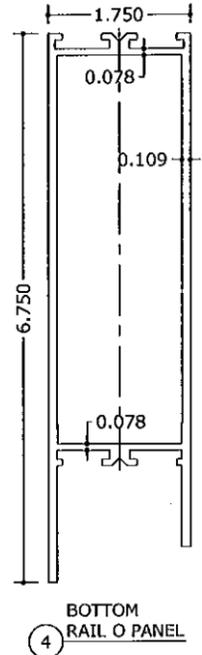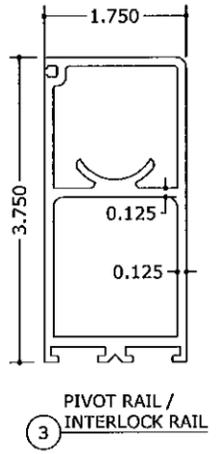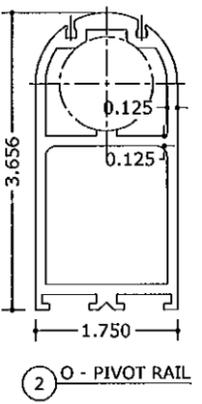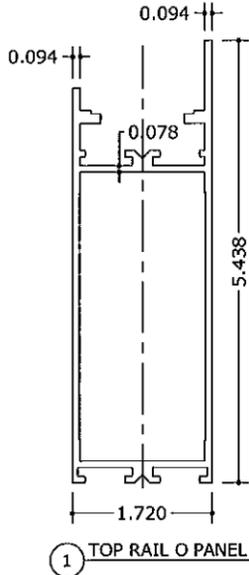

FRANK L. BENNARDO
PROFESSIONAL ENGINEER
 LICENSE NO. 34124/2012
 STATE OF FLORIDA
ENGINEERING EXPRESS
 160 SW 12th Avenue, #1005
 Deerfield Beach, FL 33442
 Ph: (954) 354-0660 Fax: (954) 354-0663
 WWW.ENGP.COM
 CERT. OF AUTH. #8885
 A FRANK L. BENNARDO, P.E., INC. INNOVATION

DORMA AUTOMATICS
 924 SHERWOOD DRIVE
 LAKE BLUFF, ILLINOIS 60044
 WWW.DORMA-USA.COM

ESA 300 SERIES
 AUTOMATIC SLIDING GLASS DOORS
 (LARGE MISSILE IMPACT RESISTANT)

REMARKS	DRWN	CHKD	DATE
INIT ISSUE	AMIL	CL	05/09/06
BCCO COMMENTS	AMIL	CL	11/08/06
2007 FBC	RCB	CL	01/16/08
2010 FBC	KL	FLB	03/09/12

05-DOA-0004
 SCALE: N.T.S. 103
 PAGE DESCRIPTION:
 PRODUCT REVISED
 as complying with the Florida
 Building Code
 Acceptance No. 11-1213.06
 Expiration Date: FEB 01, 2017
Isaac L. Landa
 Project Manager